
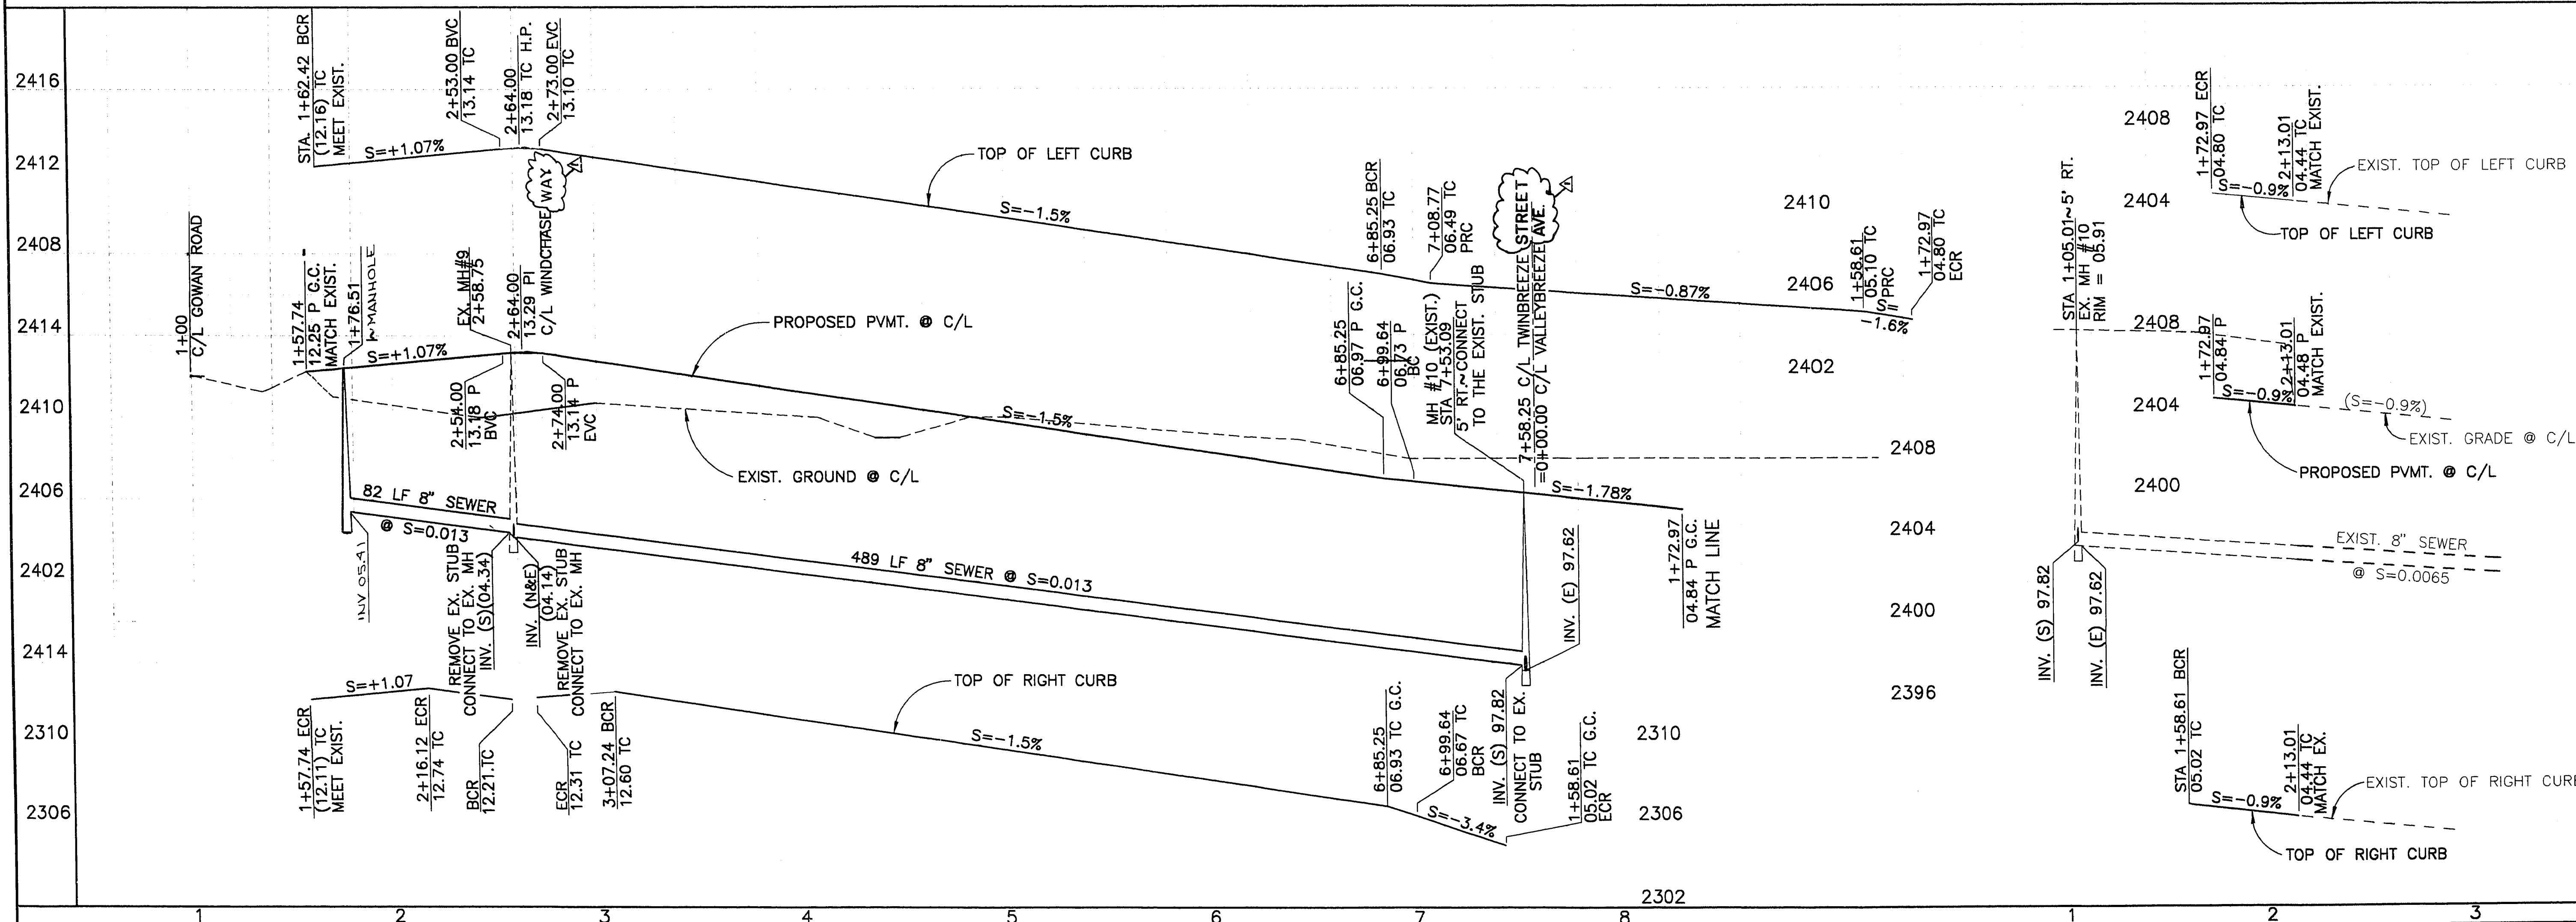
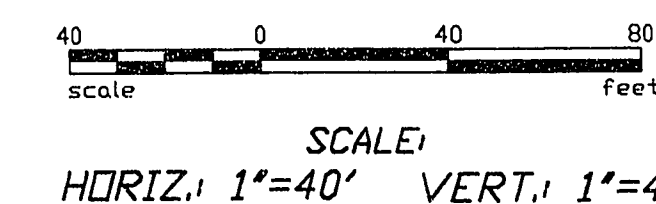


CURVE DATA				
AT BACK OF CURB AND CENTERLINE				
CURVE	DELTA	RADIUS	LENGTH	TANGENT
C1	92°56'38"	25.00'	40.55'	26.32'
C2	87°03'22"	25.00'	37.99'	23.75'
C3	24°30'26"	55.00'	23.53'	11.95'
C4	142°08'05"	56.00'	138.92'	163.26'
C5	93°07'14"	35.00'	56.88'	36.96'

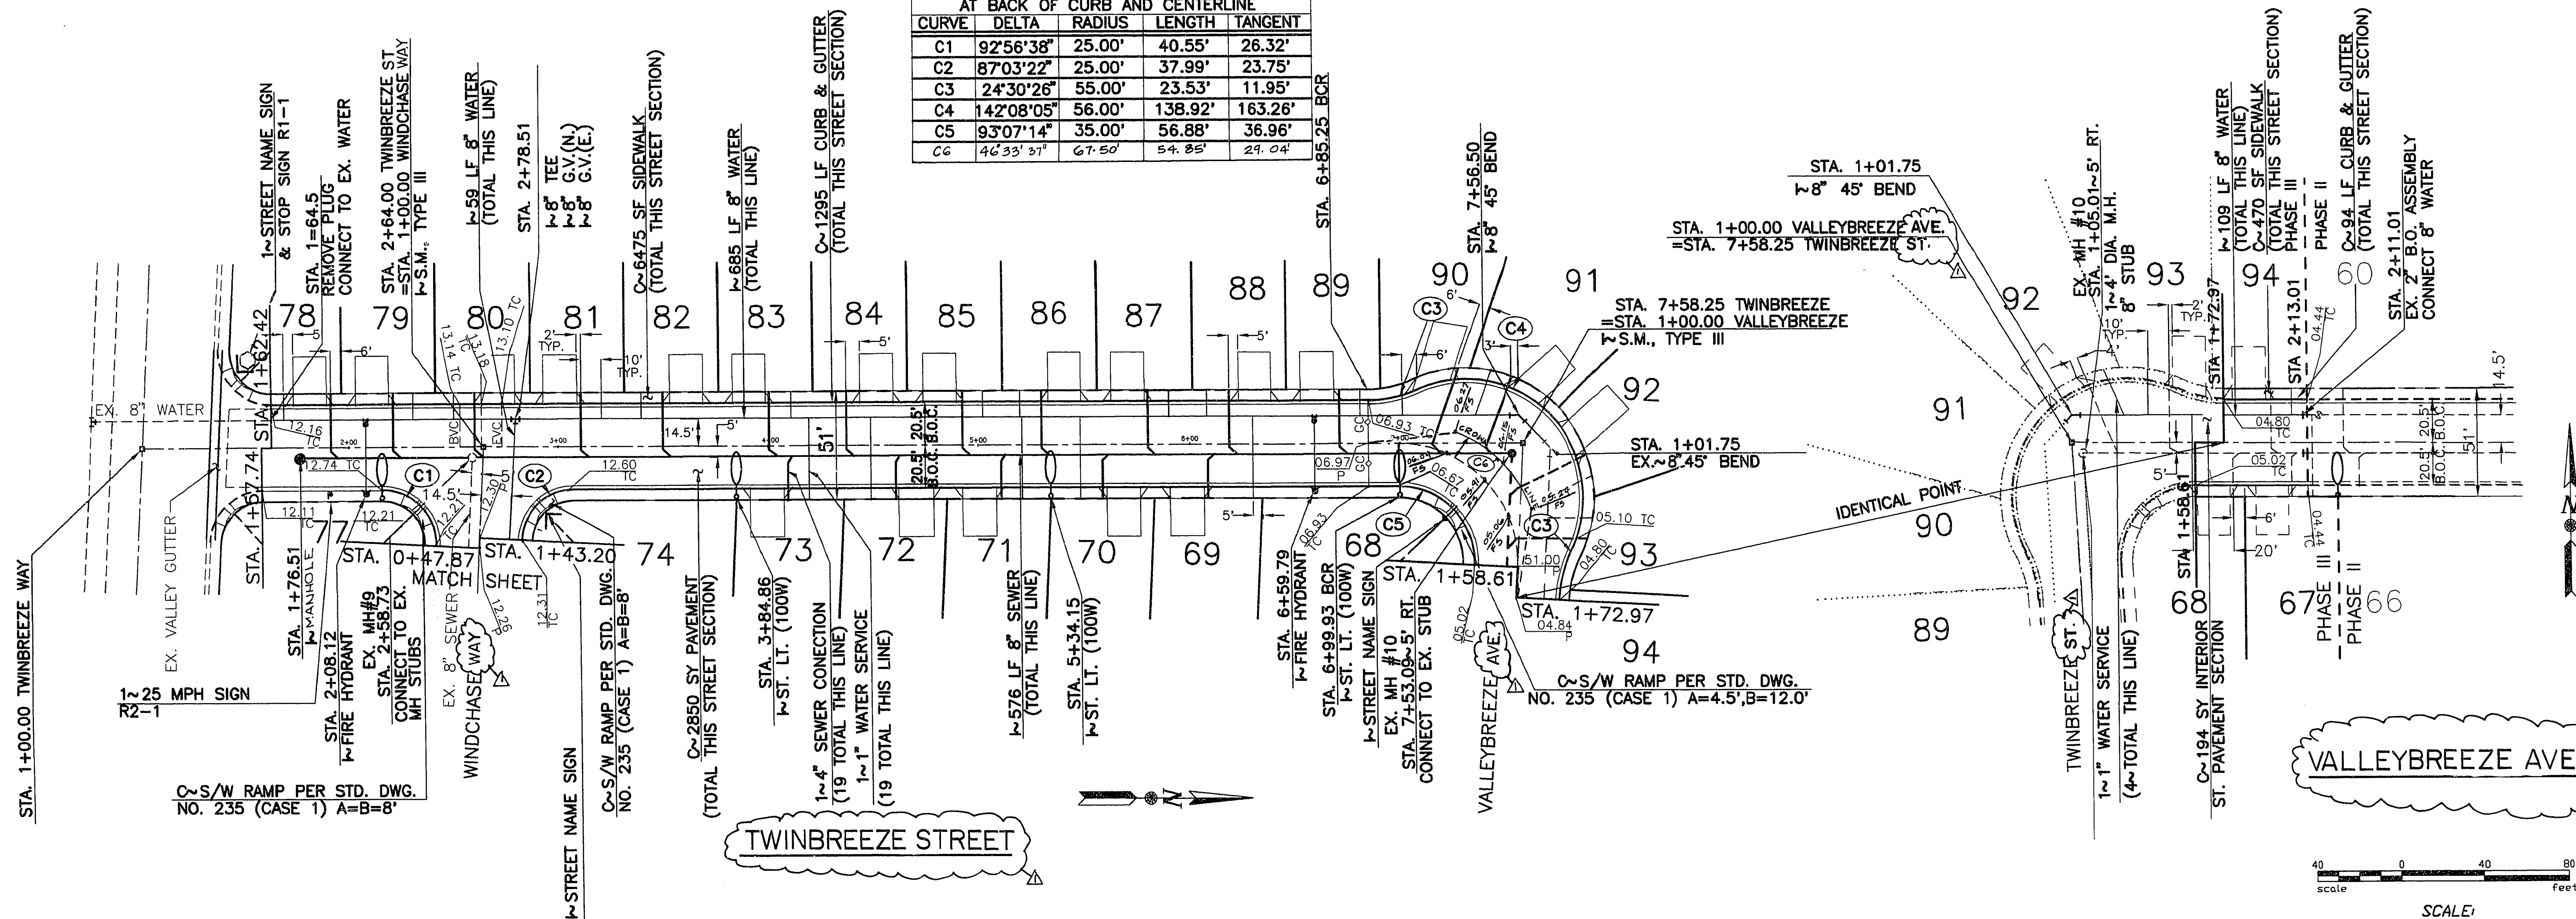

REVISIONS:
Δ 10.31.95 REVISED STREET NAMES.

Standage & Truitt Engineering, Ltd.
CIVIL ENGINEERING AND SURVEYING
6855 W. CHARLESTON BLVD.
LAS VEGAS, NEVADA 89117
PHONE (702) 255-2950

WINDGATE
UNIT III

0

Michael J. Crehan

MICHAEL J. CREHAN
CIVIL
No. 10864

10/6/95

2

DATE: MAY 1994
JOB NO. 94042003
DRAWN BY: AEG

SHEET NO.

4 5

OF