
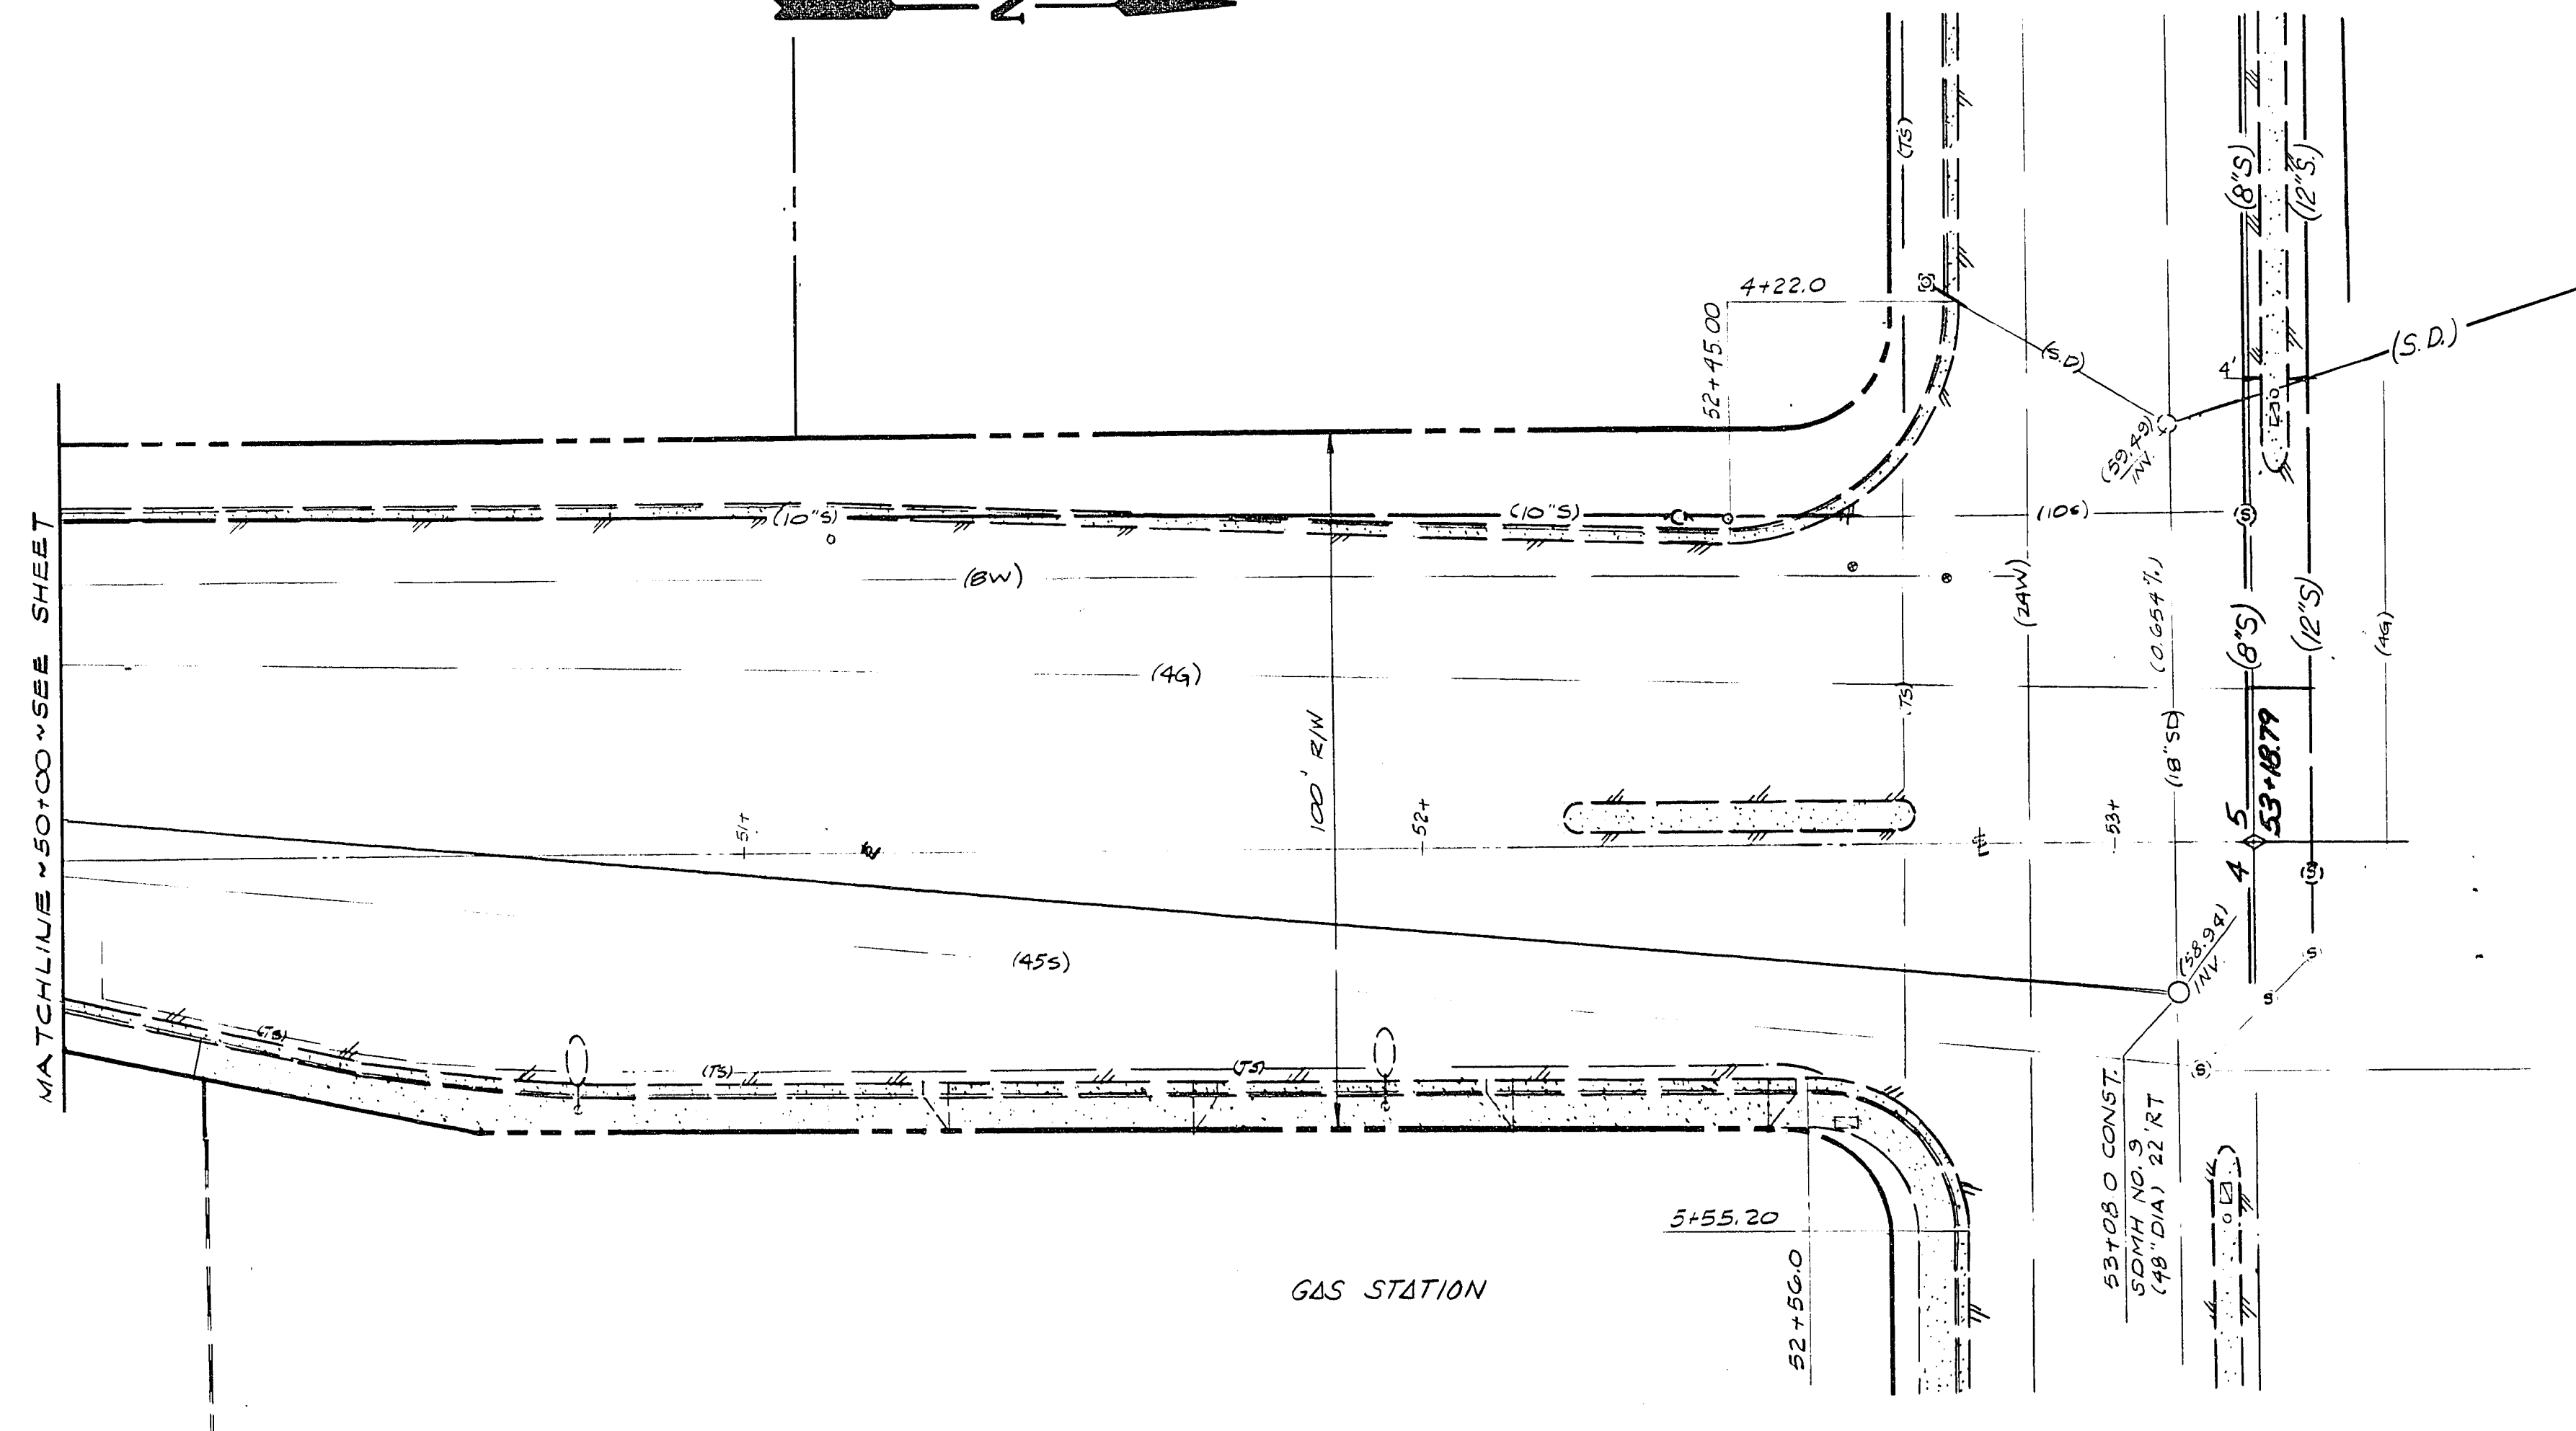


SCALE: 1"=20'

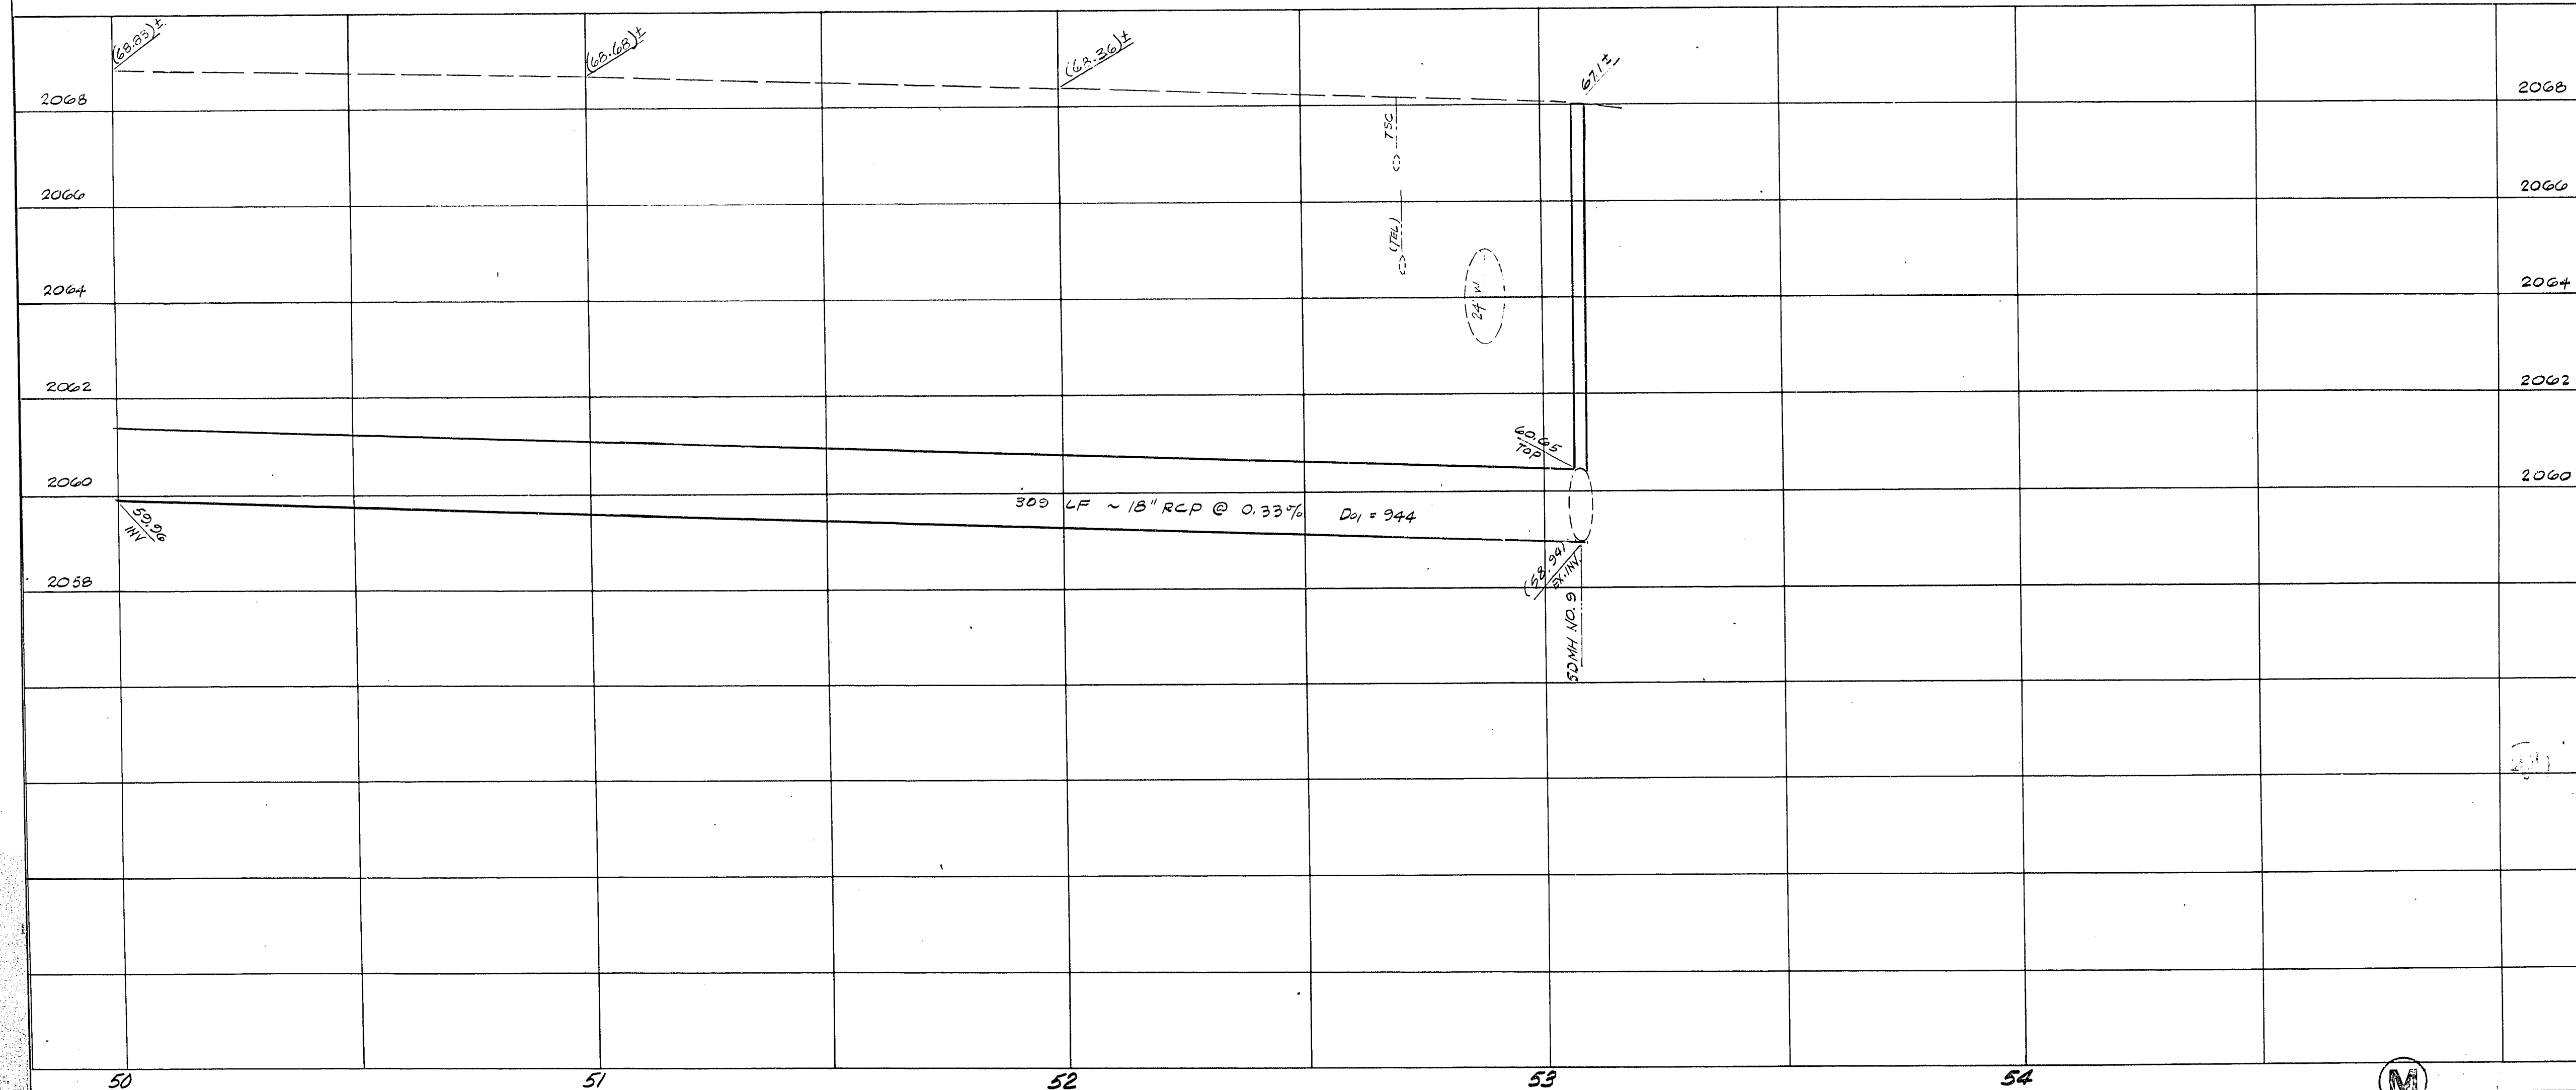

CLV BENCHMARK NO 1614 BI PLATE @ INTERSECTION OF OAKLEY & RANCHO ELEV. = 2066.57

[illegible]

1	GRADE CHANGE	PLL	TMH	1-3-85
REV. NO.	DESCRIPTION	BY	APPROVAL	DATE

RANCHO ROAD
STORM DRAIN PLAN
& PROFILE



ALCA ENGINEERING & SURVEYING INC.
CIVIL ENGINEERING — SURVEYING
2765 SOUTH HIGHLAND DRIVE • SUITE NO. 103
LAS VEGAS, NEVADA 89109 • (702) 732-2105

SCALE (H) 1"=20'	SCALE (V) 1"=2.0'	JOB NO.
DES. R.A.M.		8403-1-1
DR. J.P.		
SECTION 5/4 T.21S., R.61E., M.D.M.		SHEET 21 OF 42
30-4-46		DWG. NO. 107-V 1286 A