


RANCHO SERENO UNIT 2

MONUMENT TIE MAP

CURVE DATA

NO.	Δ	R	L	T
1	90°00'00"	50.00'	23.56'	15.00'
2	50°00'00"	50.00'	47.12'	30.00'
3	90°00'00"	50.00'	23.56'	15.00'
4	50°00'00"	50.00'	47.12'	30.00'
5	17°34'44"	50.00'	27.61'	13.92'
6	23°26'21"	50.00'	36.82'	18.67'
7	2°06'12"	50.00'	5.20'	1.63'
19	74°28'08"	15.00'	19.50'	11.40'
20	105°31'52"	15.00'	23.63'	19.79'
21	4°35'50"	380.00'	30.49'	15.26'
22	91°06'52"	1500'	23.85'	15.30'
23	44°14'57"	2500'	19.31'	10.16'
24	1°43'58"	4350'	1.38'	0.69'
25	50°08'00"	4550'	44.58'	24.26'
26	07°19'08"	547.00'	69.87'	34.98'
27	33°11'27"	4550'	30.33'	15.75'
28	208°29'54"	4550'	213.22'	8'
29	6°00'15"	570.00'	101.68'	50.85'
30	8°35'53"	570.00'	117.45'	53.74'
31	0°27'52"	1870.00'	15.16'	7.58'
32	7°10'40"	1870.00'	234.27'	117.29'
33	6°50'24"	1992.37'	237.33'	119.07'
34	14°57'55"	2262.37'	590.92'	297.15'
35	14°57'55"	2157.37'	563.49'	283.36'
36	14°57'55"	2127.37'	555.66'	279.42'
37	10°54'10"	2127.37'	404.82'	203.02'
38	9°47'18"	2097.37'	358.31'	179.59'
39	4°03'45"	2127.37'	150.84'	75.45'
40	2°56'53"	2097.37'	107.92'	53.97'

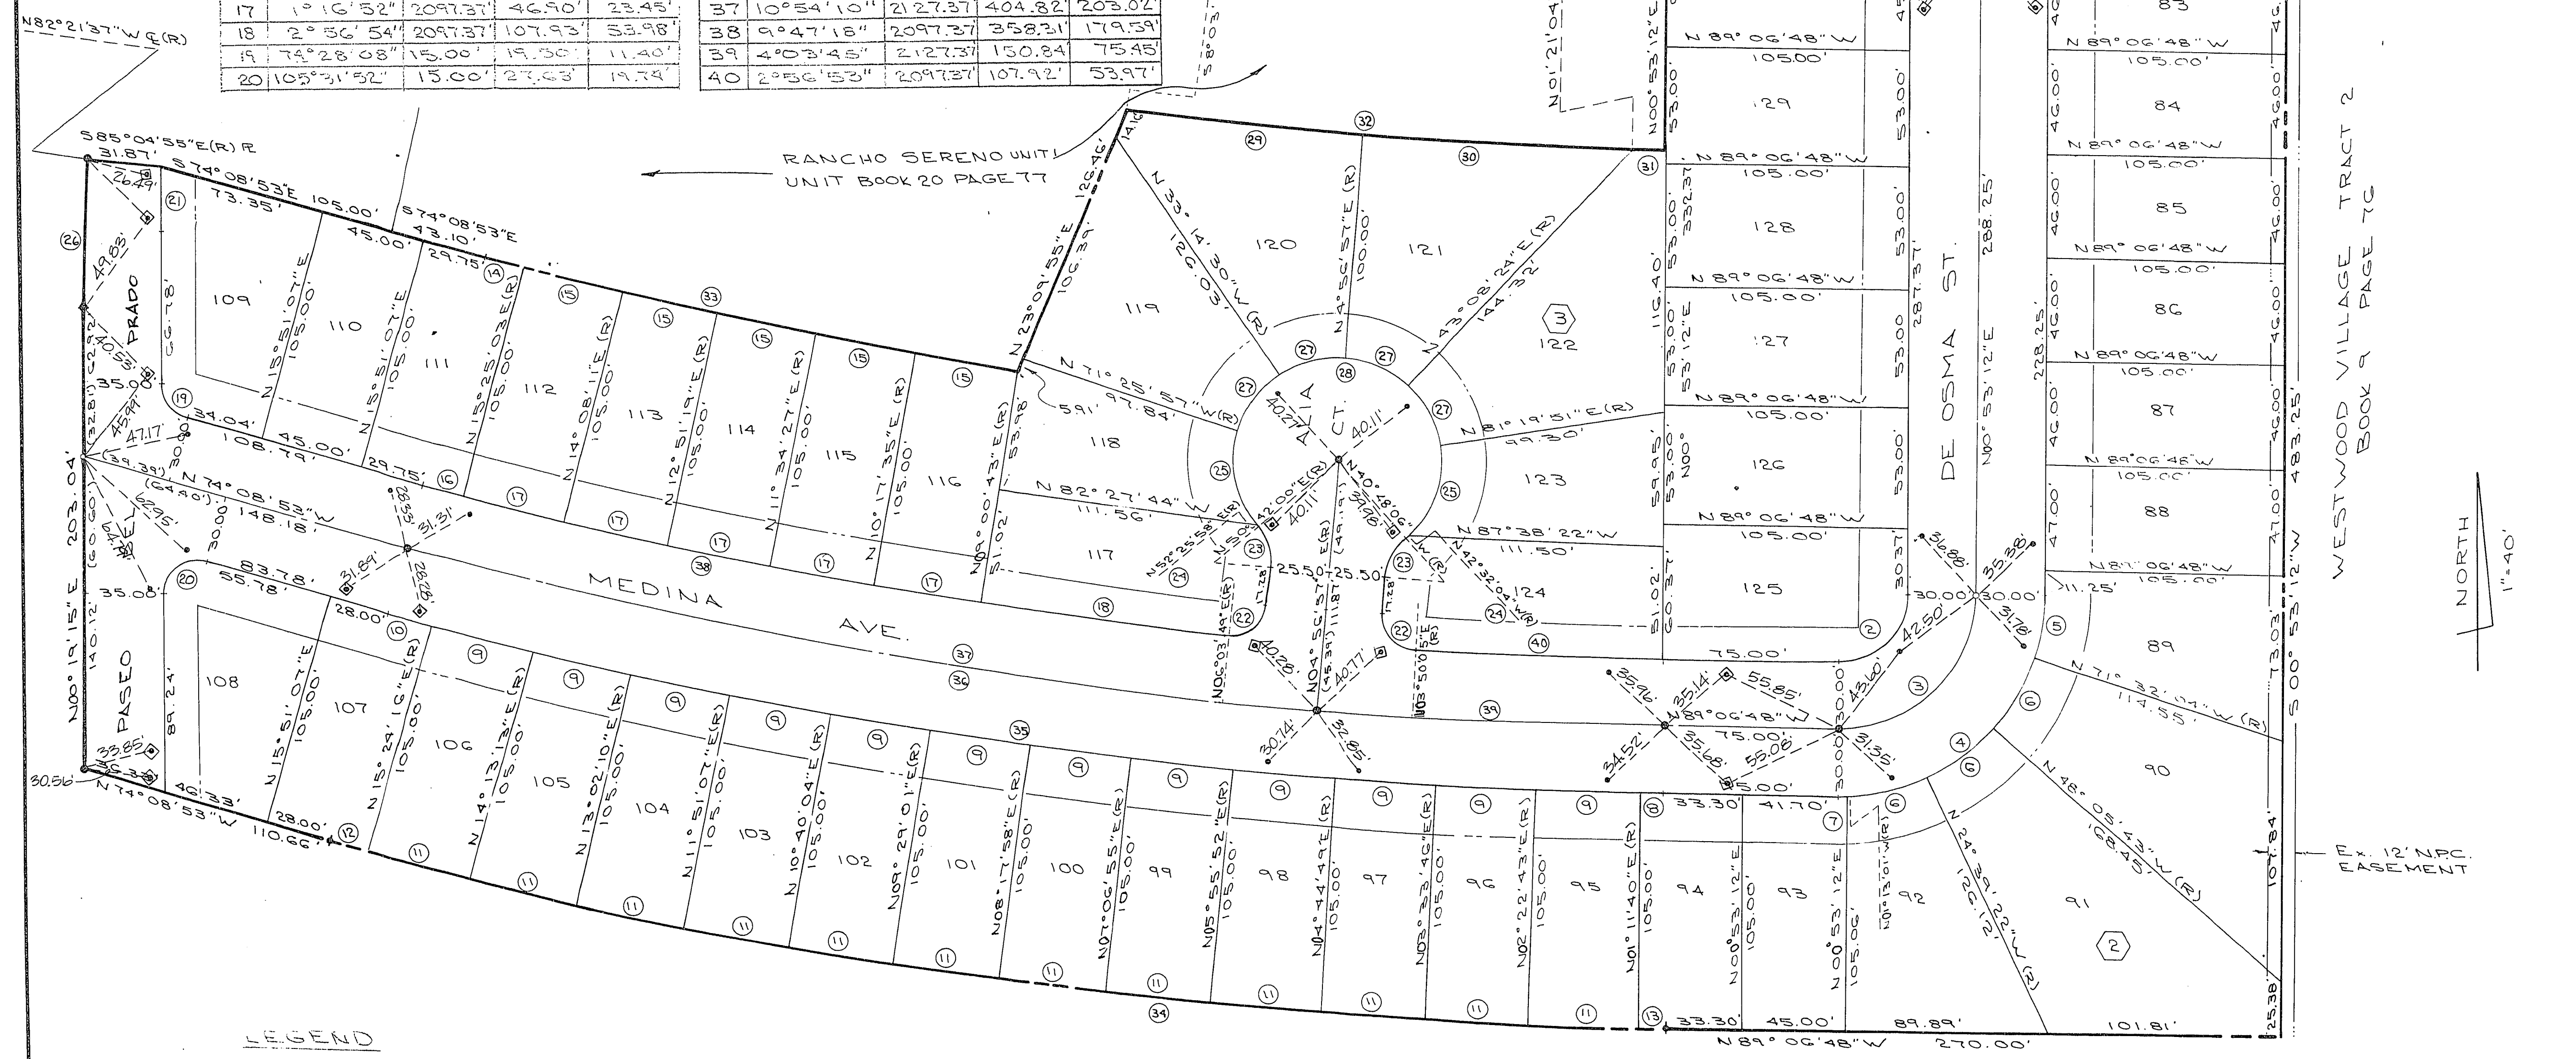

- LEGEND**
- 106 LOT NUMBER
 - 107 BLOCK NUMBER
 - 108 CURVE NUMBER
 - 109 FOUND MONUMENT AS INDICATED
 - 110 SET REBAR W/AL CAP, RLS 4046
 - 111 SET BRASS CAP IN CONC. MON. RLS 4046
 - 112 BUILDING SETBACK LINES
 - 113 20' FRONT 15' SIDE
 - 114 SET LEAD & BRASS NAIL IN T.C. RLS 4046
 - 115 SET BRASS CAP IN T.C.

SURVEYOR'S CERTIFICATE

I, JERRY E. BARNESON, A REGISTERED LAND SURVEYOR, DO HEREBY CERTIFY THAT THE MONUMENTS HAVE BEEN SET AND THE TIES ESTABLISHED AS SHOWN HEREON.

Jerry E. Barneson 4/1/80
 JERRY E. BARNESON DATE
 REG. LAND SURVEYOR
 NEV. CERT. NO. 4046