
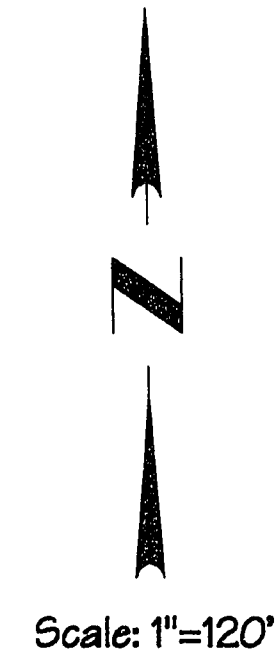


960110

01279


MATCH LINE SEE SHEET 2

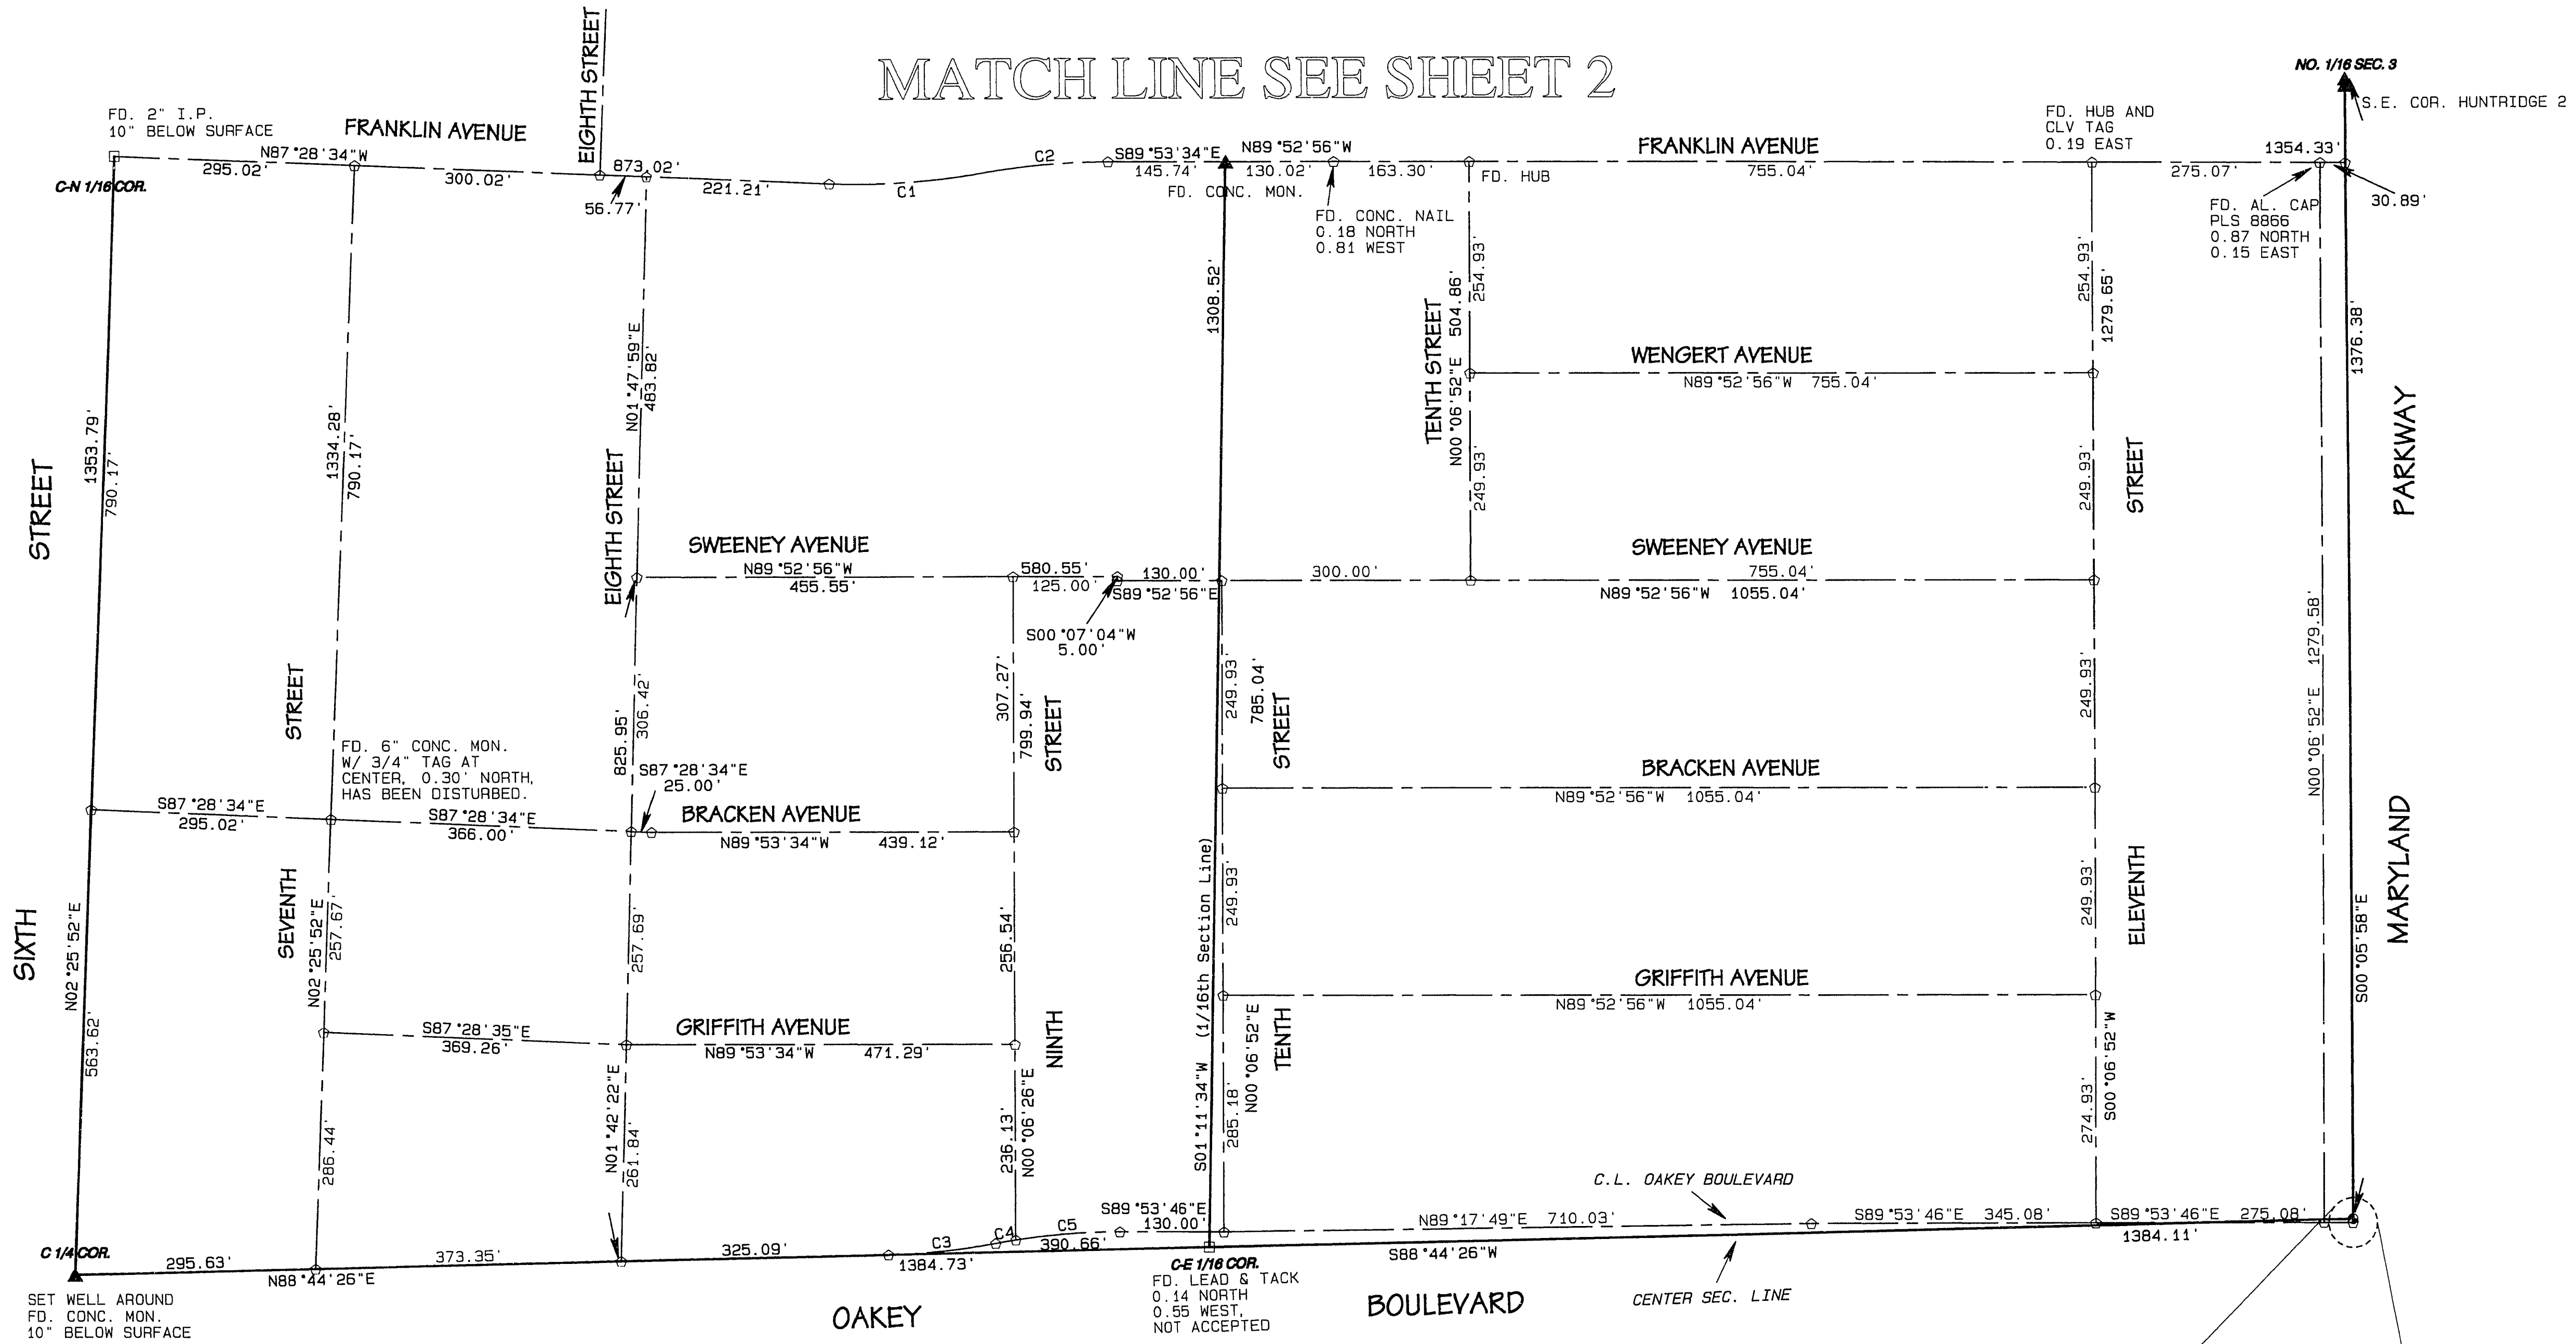

LEGEND

- Set Al Cap PLS 5094
- ▲ Found monument as noted
- Set Brass Cap PLS 5094
- Set Brass Cap PLS 5094 In Well Monument
- Street Centerline
- Section Line

CURVE	DELTA	RADIUS	DISTANCE	TANGENT
C1	12°25'00"	866.02'	187.68'	94.21'
C2	10°00'00"	860.12'	150.12'	75.25'
C3	09°21'10"	800.00'	130.59'	65.44'
C4	07°44'04"	800.00'	24.22'	12.11'
C5	08°58'55"	800.00'	125.41'	62.83'

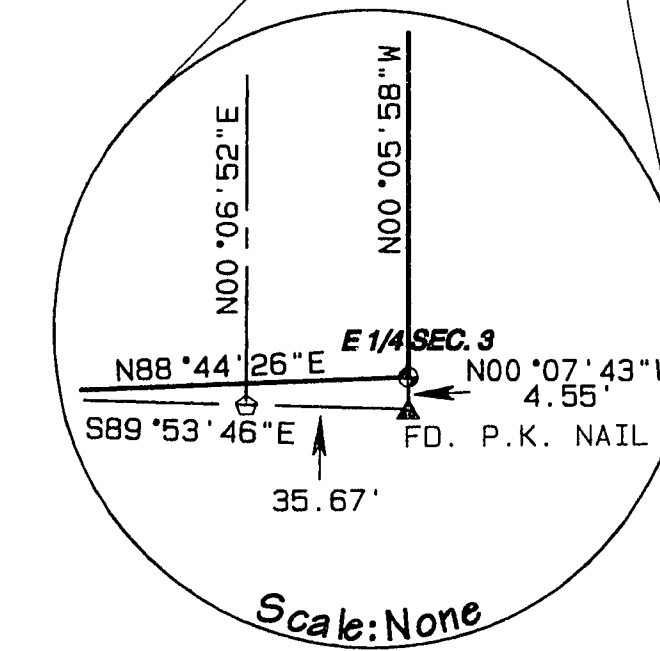

NOTE: ANY SUBSEQUENT CHANGES TO THIS MAP SHOULD BE EXAMINED AND MAY BE DETERMINED BY REFERENCE TO THE COUNTY RECORDERS CUMULATIVE MAP INDEX. (N.R.S. 278.5695)

RECORD OF SURVEY  
FOR  
CITY OF LAS VEGAS  
Section 3, Township 21 South, Range 61 East, M.D.M.,  
City of Las Vegas, Clark County, Nevada

DRAWN BY: Sullivan/Martina  
CHECKED BY: rml  
DATE: January 1996

400 E. STEWART AVENUE, LAS VEGAS, NEVADA 89101 (702) 223-6217

Sheet 3 of 5

File 80 Page 46 055-653