



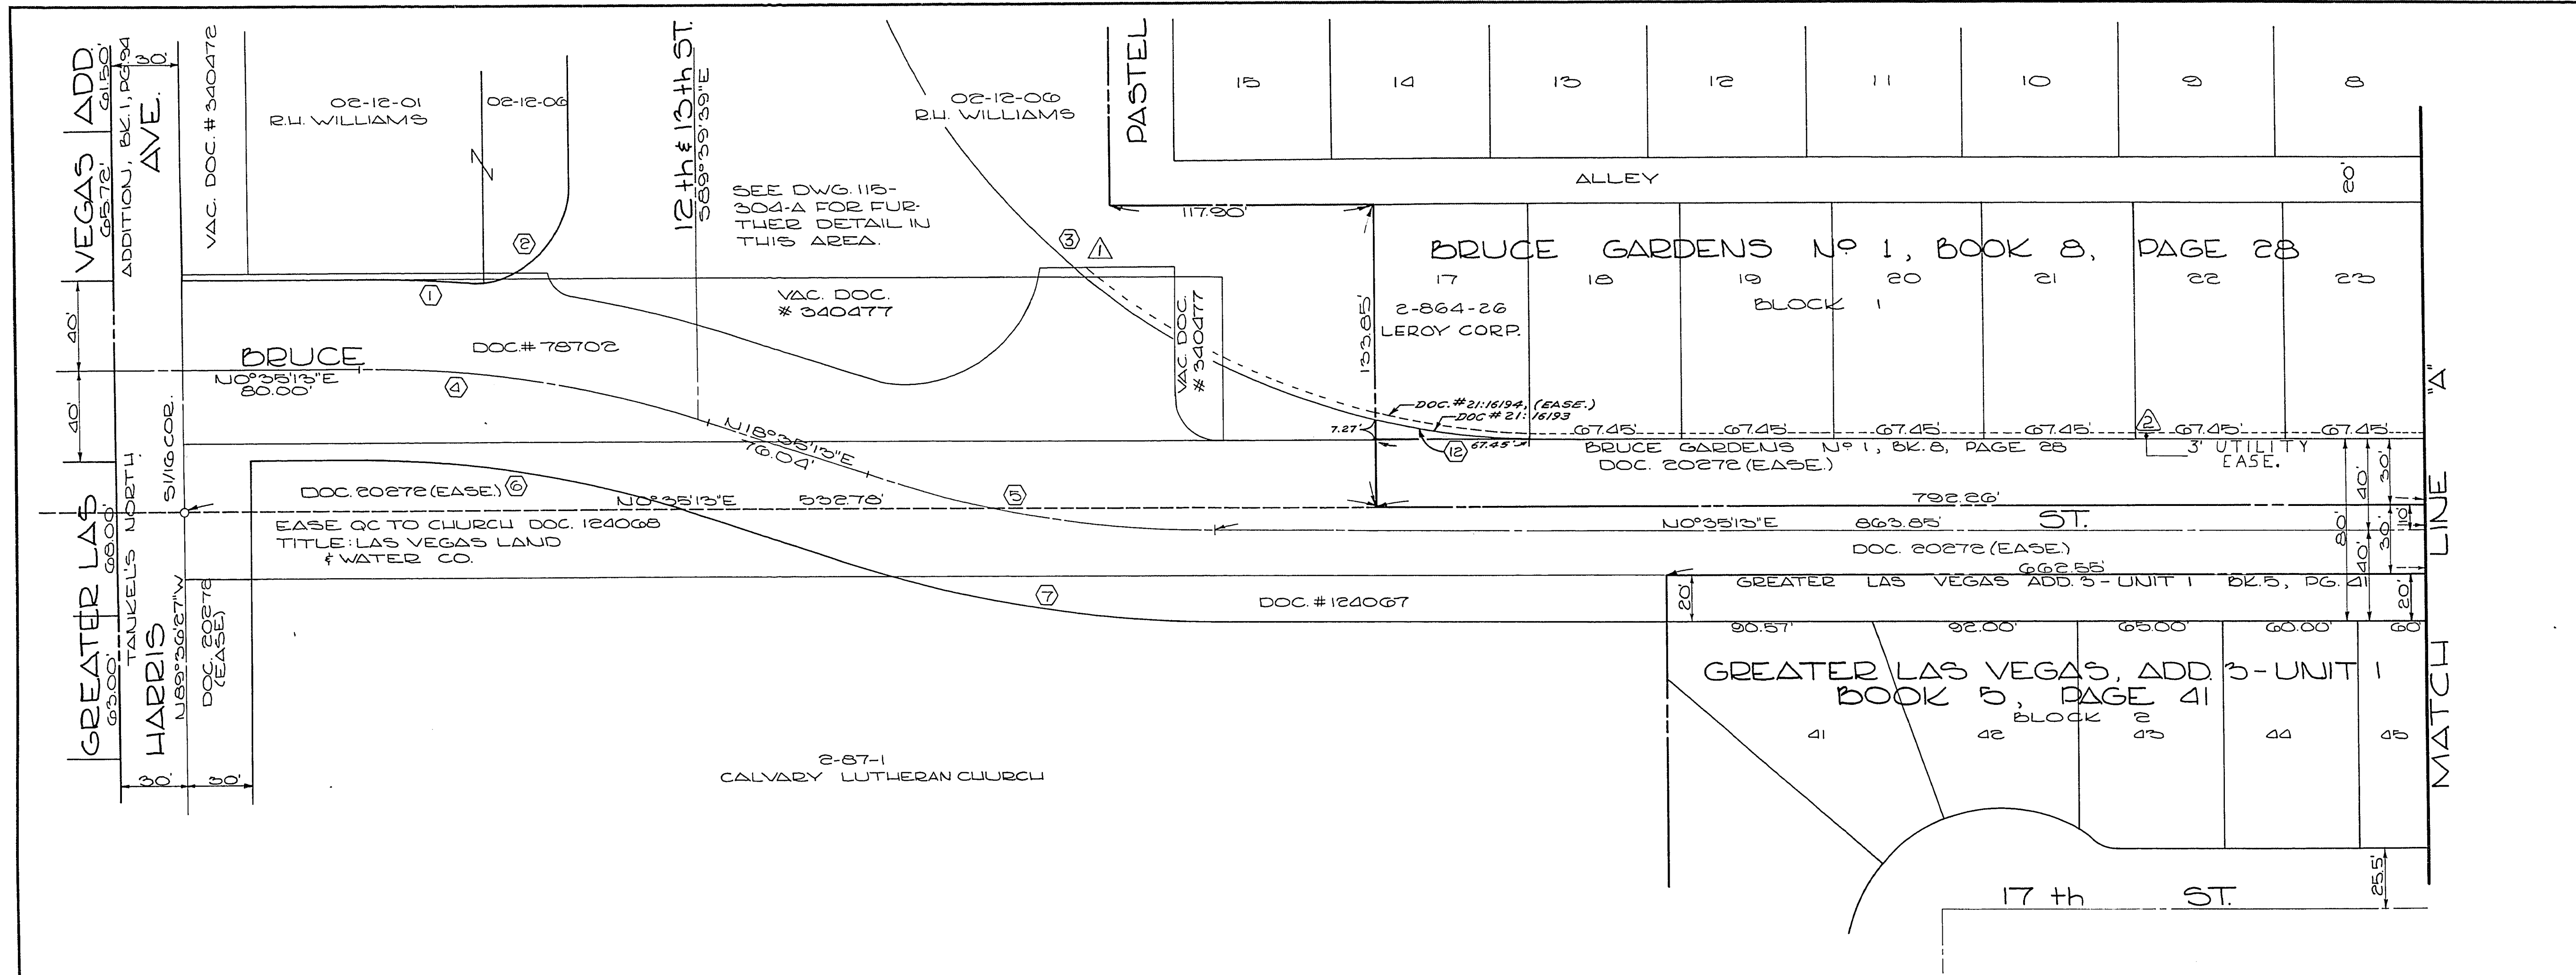

PROPERTY SCHEDULE			
PARCEL NO.	GRANTOR	AREA	DOC. & DATE
2-05-2	FRATERNAL ORDER OF EAGLES LODGE	165 S.F.	18-9782, 2-24-70 EASEMENT
2-864-26	LEROY CORP.	165 S.F.	21/16194, 3-27-70 3' EASE. ALSO 18189 & 18196.
2-864-26	LEROY CORP.	165 S.F.	21/16193, 3-27-70 3' EASE. ALSO 18189 & 18196.
* ANGLES FROM RECORDS OF SURVEY ON FILE IN FILE 9, PAGE 56; FILE 7, PAGE 41; FILE 10, PAGE 52; CLARK COUNTY, NEVADA RECORDS.			

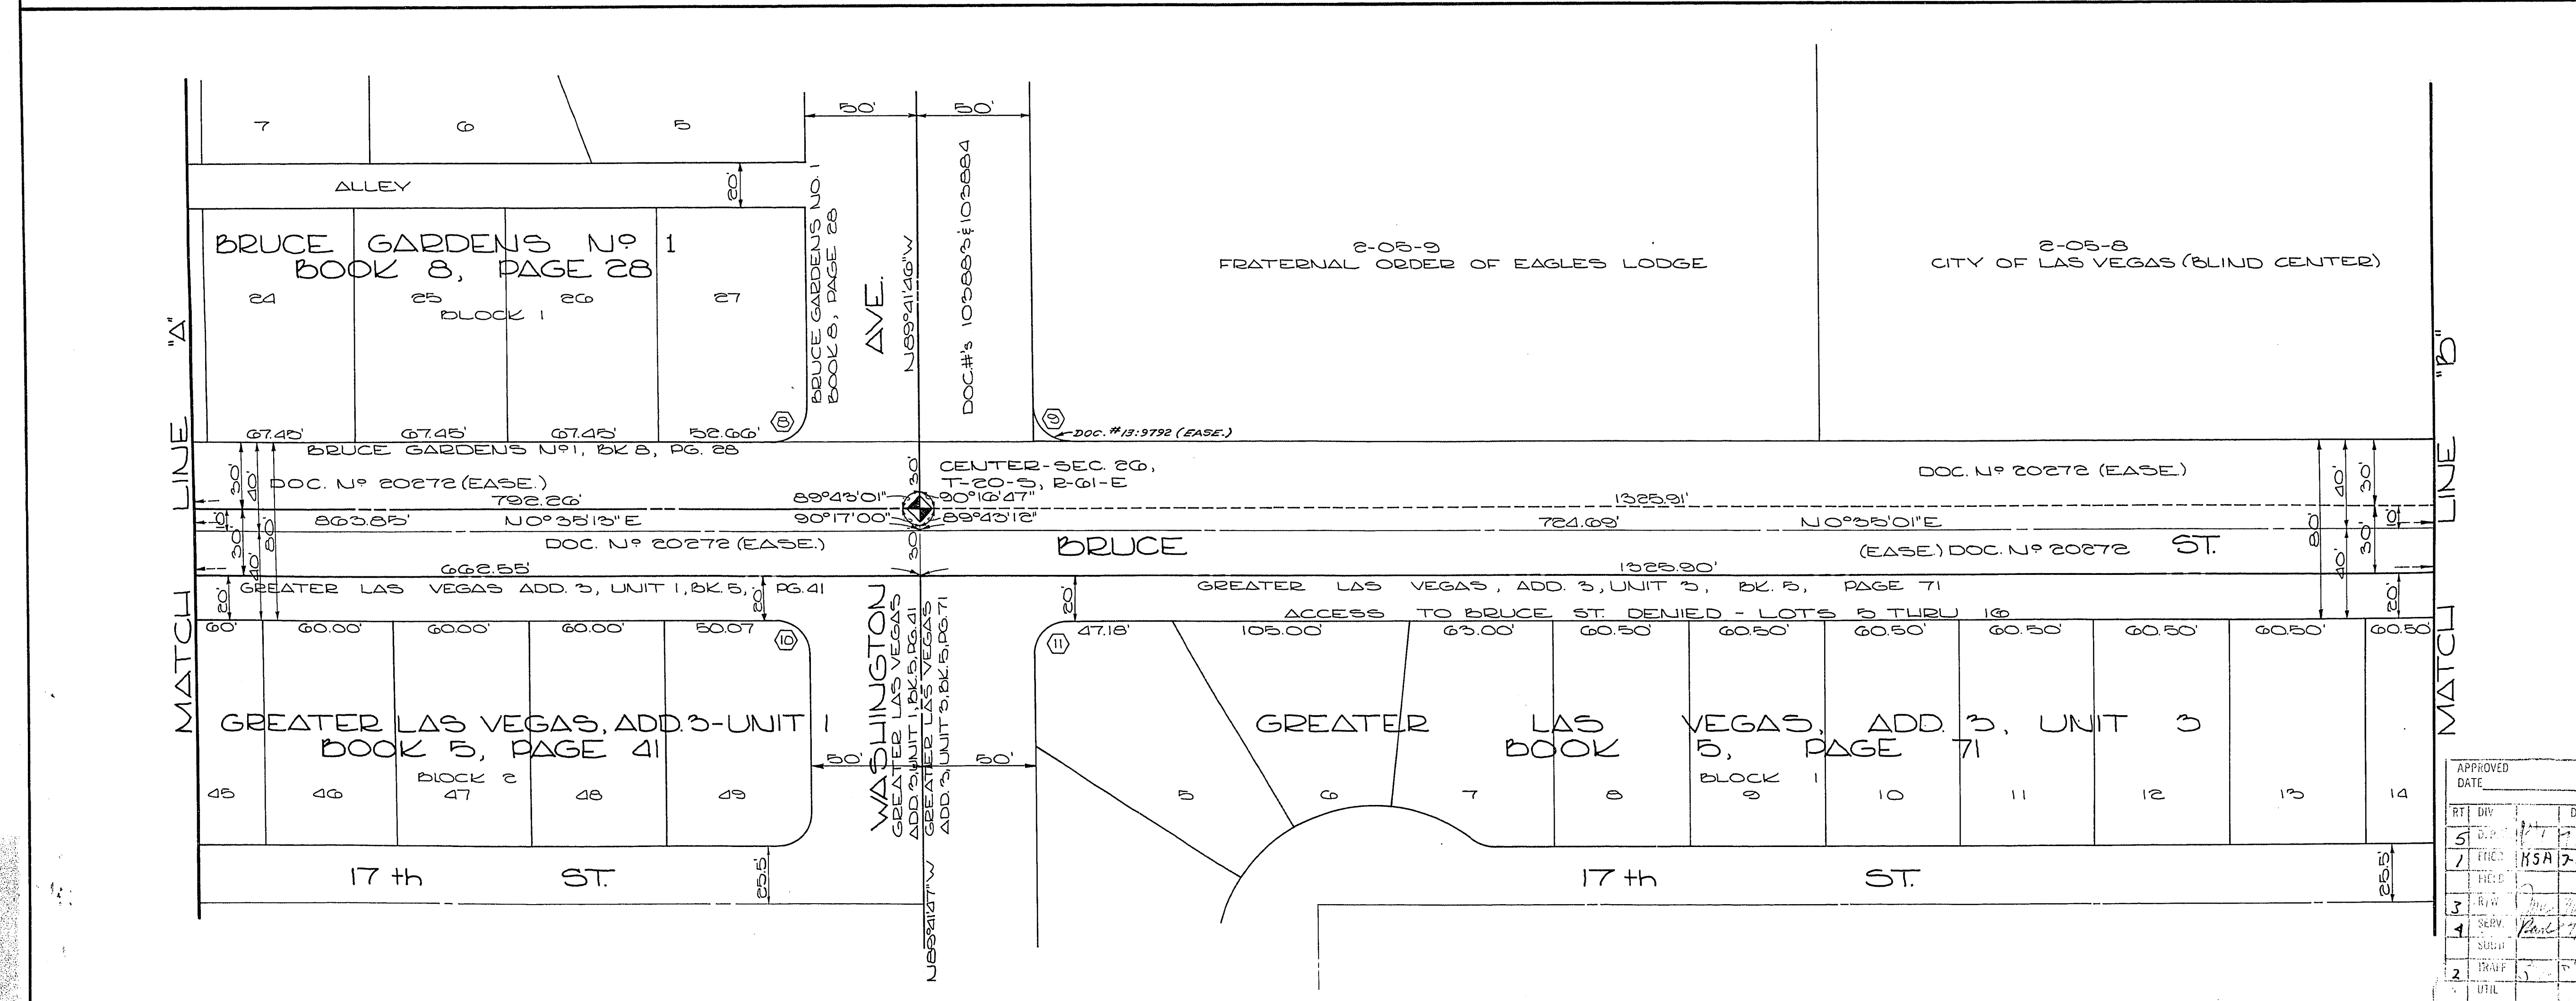

CURVE DATA				
#	Δ	R	T	L
①	4°44'33"	540.00'	22.86'	44.70'
②	24°59'25"	44.00'	48.01'	72.94'
③	89°45'08"	316.73'	315.16'	496.15'
④	18°00'00"	500.00'	79.13'	157.08'
⑤	18°00'00"	500.00'	79.13'	157.08'
⑥	18°00'00"	460.00'	72.86'	144.51'
⑦	18°00'00"	460.00'	72.86'	144.51'
⑧	30°16'58"	15.00'	15.07'	23.64'
⑨	83°43'13"	15.00'	14.93'	23.42'
⑩	83°43'00"	15.00'	14.93'	23.42'
⑪	30°16'48"	15.00'	15.07'	23.64'
⑫	12°18'03"	316.72'	34.13'	68.00'
SEC 26, T-20-S, R-61-E, MDN.				
BASIS OF BEARING IS N0°05'00"E, THE CENTERLINE OF 12TH ST. AS SHOWN BY MAP OF 14TH STREET ADDITION TO THE CITY OF LAS VEGAS ON FILE IN BOOK 1 OF PLATS AT PAGE 82, CLARK COUNTY, NEVADA, RECORDS *				
②	ADD UTILITY EASE.	KWC	1-30-69	11/2/69
③	LENGTHEN CURVE	KWC	1-16-68	11/2/69
REVISION NO.	DESCRIPTION	BY	DATE	APPROVAL
REVISIONS				
CITY OF LAS VEGAS NEVADA				
DEPARTMENT OF PUBLIC WORKS				
SERVICES DIVISION				
RIGHT OF WAY - BRUCE ST. HARRIS AVE. to OWENS AVE.				
W.O. NO. 8620	F.BK. NO.	DATE	DRAWING NO.	
SC. (H) 1"=40'	SC. (V)		115-316	
DES. CADDY	3 M	7/8/68	FILE NO.	
DR. CADDY		7/8/68		
APPROVED BY DIRECTOR OF PUBLIC WORKS				
SHEET 1 OF 2				