


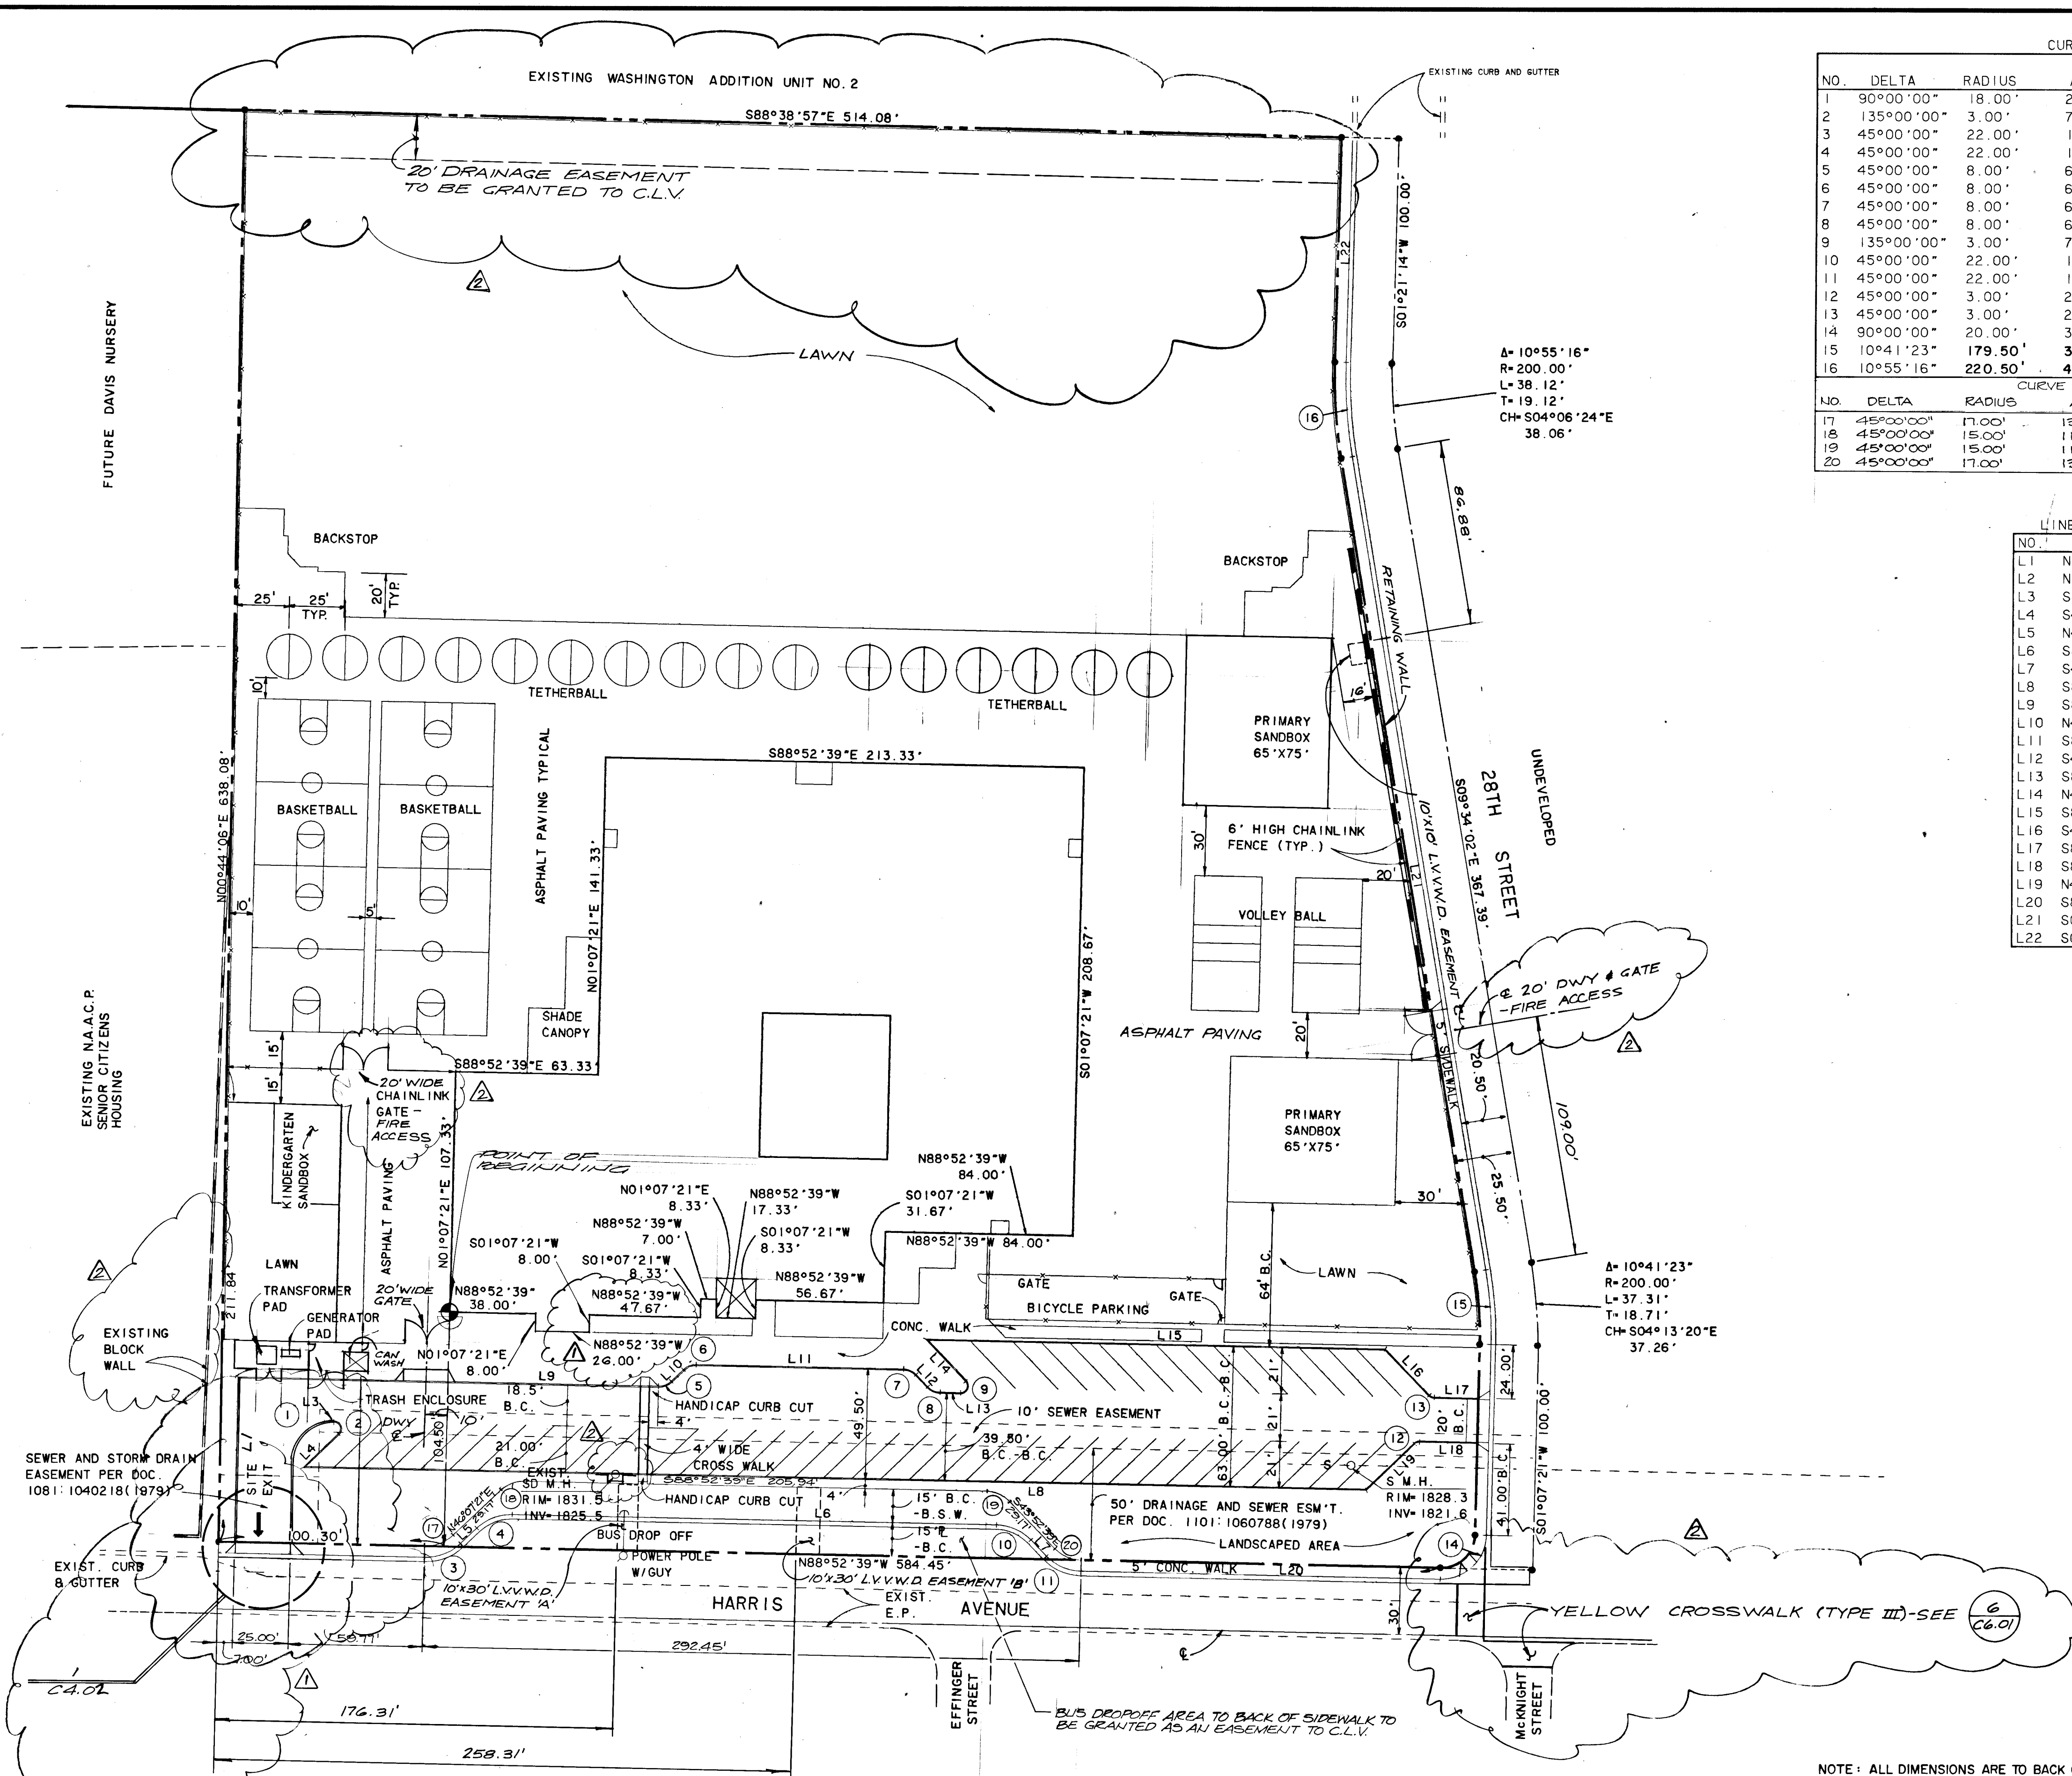


CURVE TABLE B.C.R.					
NO.	DELTA	RADIUS	A.L.	TAN.	CHORD
					BEARING DIST.
1	90°00'00"	18.00'	28.27'	18.00'	N46°07'21"E 25.46'
2	135°00'00"	3.00'	7.07'	7.24'	S21°22'39"E 5.54'
3	45°00'00"	22.00'	17.28'	9.11'	N68°37'21"E 16.84'
4	45°00'00"	22.00'	17.28'	9.11'	N68°37'21"E 16.84'
5	45°00'00"	8.00'	6.28'	3.31'	N68°37'21"E 6.12'
6	45°00'00"	8.00'	6.28'	3.31'	N68°37'21"E 6.12'
7	45°00'00"	8.00'	6.28'	3.31'	S66°22'39"E 6.12'
8	45°00'00"	8.00'	6.28'	3.31'	S66°22'39"E 6.12'
9	135°00'00"	3.00'	7.07'	7.24'	N23°37'21"E 5.54'
10	45°00'00"	22.00'	17.28'	9.11'	S66°22'39"E 16.84'
11	45°00'00"	22.00'	17.28'	9.11'	S66°22'39"E 16.84'
12	45°00'00"	3.00'	2.36'	1.24'	N68°37'21"E 2.30'
13	45°00'00"	3.00'	2.36'	1.24'	S66°22'39"E 2.30'
14	90°00'00"	20.00'	31.42'	20.00'	S46°07'21"W 28.28'
15	10°41'23"	179.50'	33.49'	16.79'	
16	10°55'16"	220.50'	42.03'	21.08'	

CURVE TABLE B.S.W.					
NO.	DELTA	RADIUS	A.L.	TAN.	CHORD
					BEARING DIST.
17	45°00'00"	17.00'	13.35'	7.04'	N66°37'21"E 13.01'
18	45°00'00"	15.00'	11.78'	6.21'	N66°37'21"E 11.48'
19	45°00'00"	15.00'	11.78'	6.21'	S66°22'39"E 11.48'
20	45°00'00"	17.00'	13.35'	7.04'	S66°22'39"E 13.01'

LINE TABLE - B.C.R.		
NO.	BEARING	DIST.
L1	N01°07'21"E	73.50'
L2	N01°07'21"E	36.50'
L3	S88°52'39"E	0.26'
L4	S46°07'21"W	21.75'
L5	N46°07'21"E	10.06'
L6	S88°52'39"E	216.00'
L7	S43°52'39"E	10.06'
L8	S88°52'39"E	473.20'
L9	S88°52'39"E	187.00'
L10	N46°07'21"E	7.51'
L11	S88°52'39"E	92.00'
L12	S43°52'39"E	7.51'
L13	S88°52'39"E	9.15'
L14	N43°52'39"W	25.99'
L15	S88°52'39"E	205.06'
L16	S43°52'39"E	28.46'
L17	S88°52'39"E	19.50'
L18	S88°52'39"E	25.50'
L19	N46°07'21"E	29.87'
L20	S88°52'39"E	159.72'
L21	S09°34'02"E	367.39'
L22	S01°21'14"W	100.00'

NOTE: ALL DIMENSIONS ARE TO BACK OF CURB (BC) UNLESS OTHERWISE NOTED.

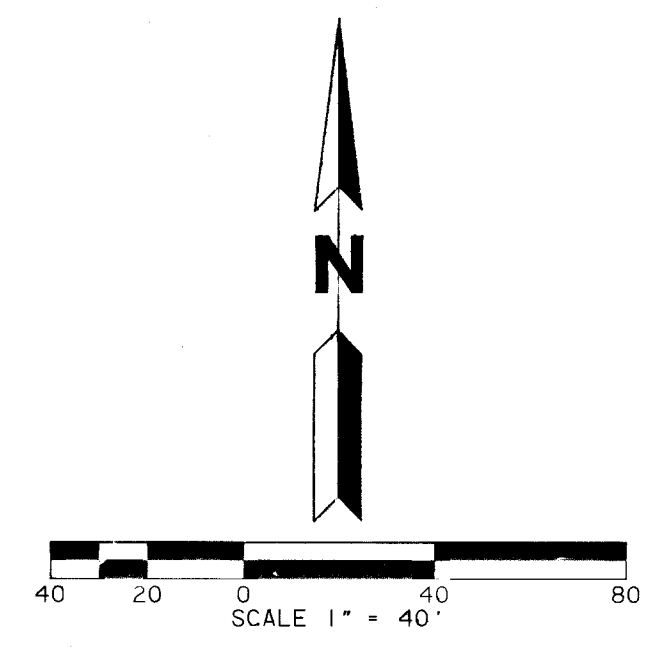

REV

DESCRIPTION

DATE

BY

1	REVISED DIMENSIONS	12-11-89	M.L.H.
2	GENERAL REVISIONS	1-31-90	M.L.H.
3	SIGNATURES	3/15/20	

MARTIN & MARTIN

MARTIN & MARTIN
ARCHITECTS & ENGINEERS, INC.
Architecture and Engineering
Research and Planning
Interior and Graphic Design
Landscape Architecture
4292 S. Maryland Parkway
Las Vegas, Nevada 89119-7530
Ph. (702) 731-2033 Fax 731-2039

CLARK COUNTY SCHOOL DISTRICT

SPECIAL PROJECTS 4280 EUCALYPTUS ANEX 799-5025 LAS VEGAS, NEVADA 89121

ROBERT LUNT ELEMENTARY SCHOOL

DRAWING TITLE HORIZONTAL CONTROL PLAN

SHEET NO.

C2.01

2 OF 8

MARTIN & MARTIN assumes no responsibility for utility locations. The utilities shown on this drawing have been plotted from the best available information. It is, however, the contractors responsibility to field verify the location of all utilities prior to the commencement of any construction.