

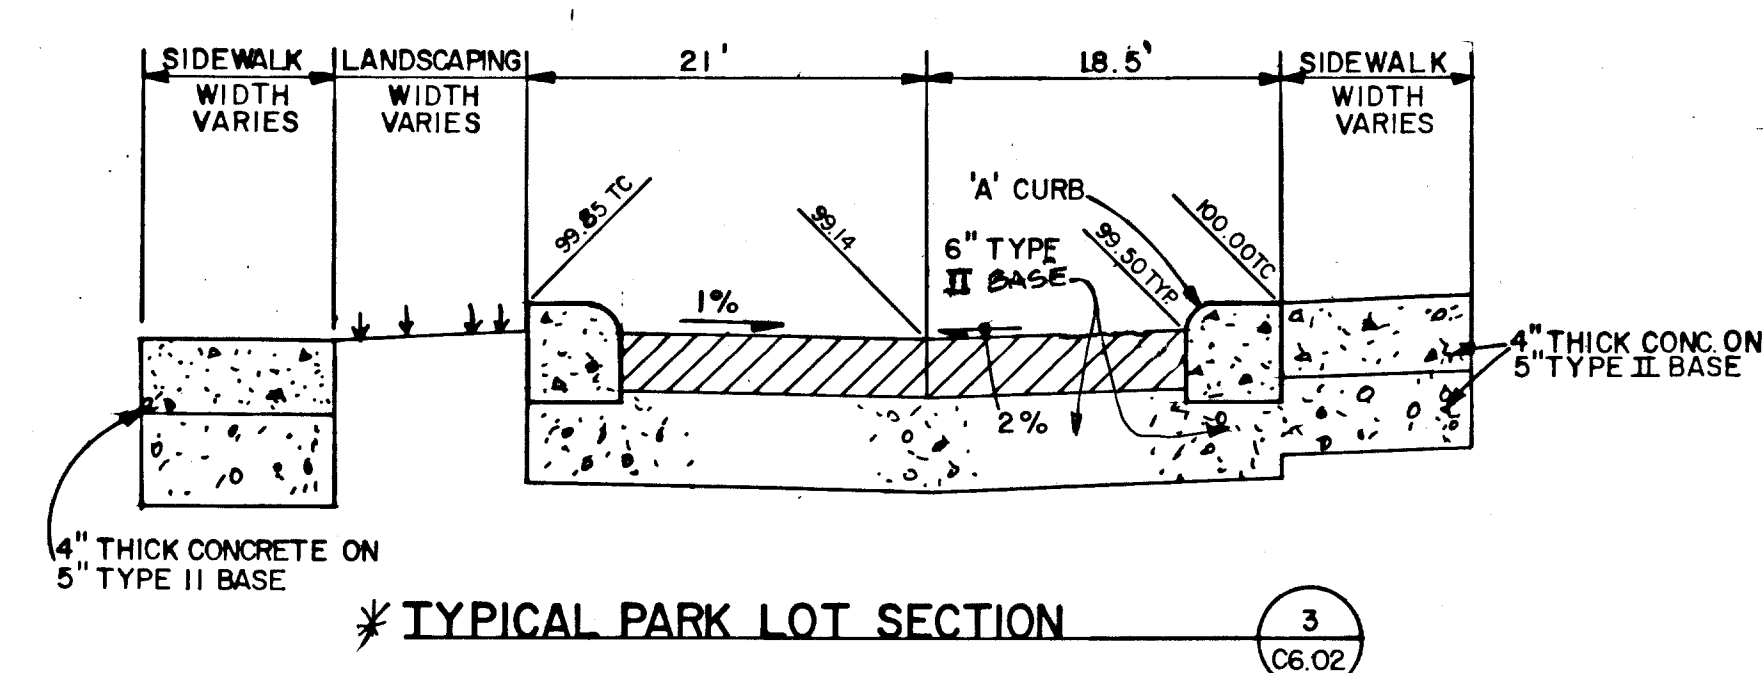
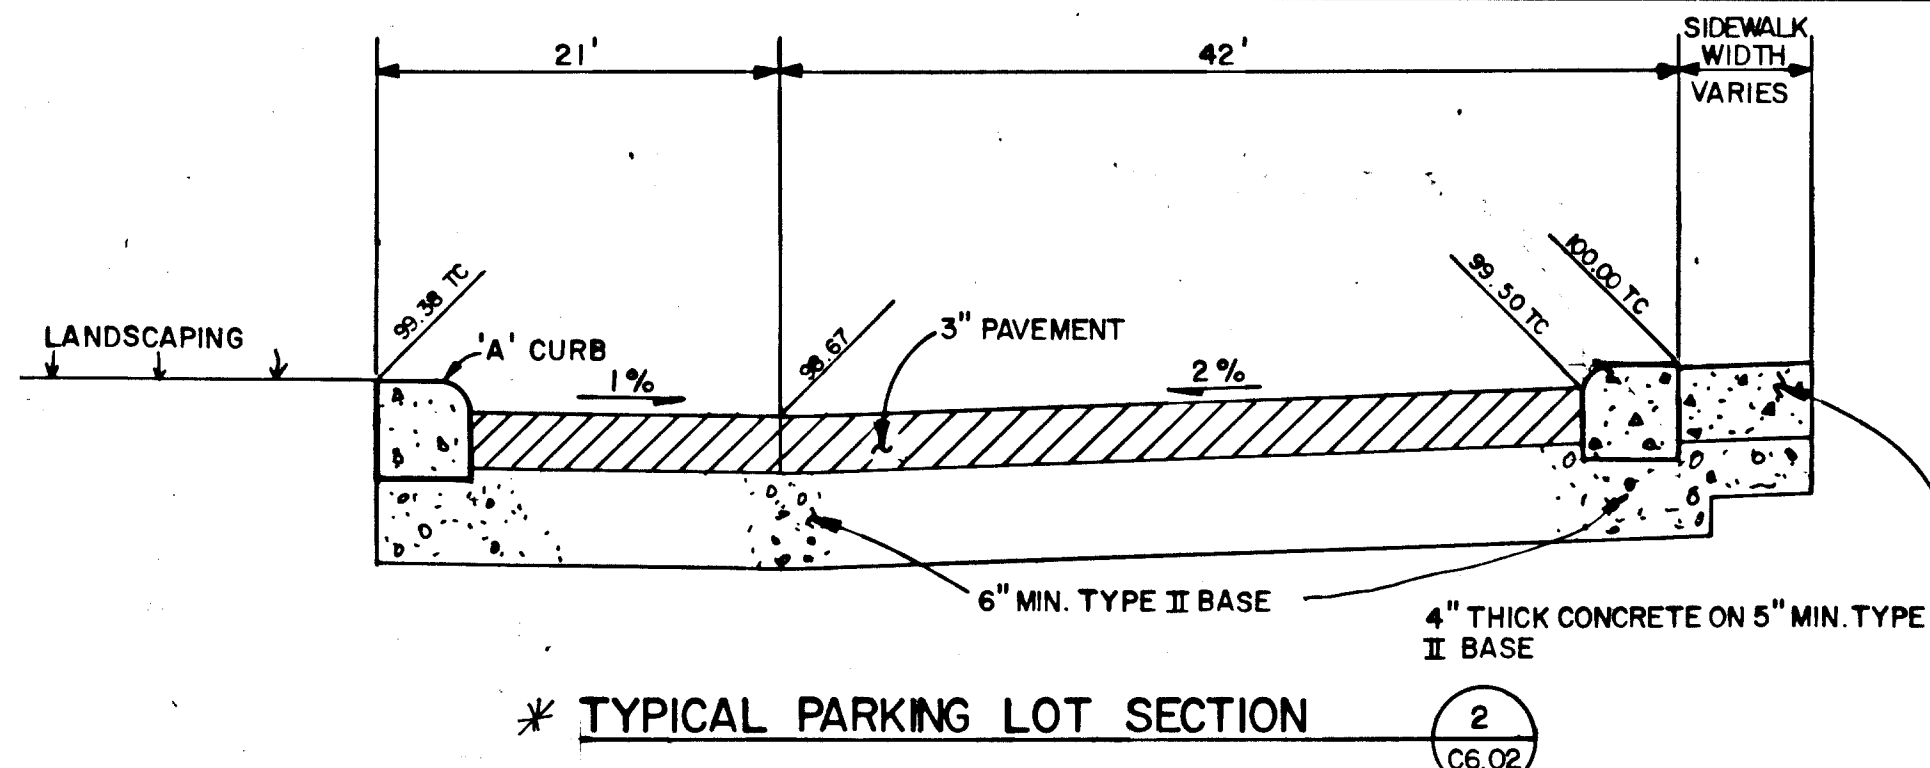
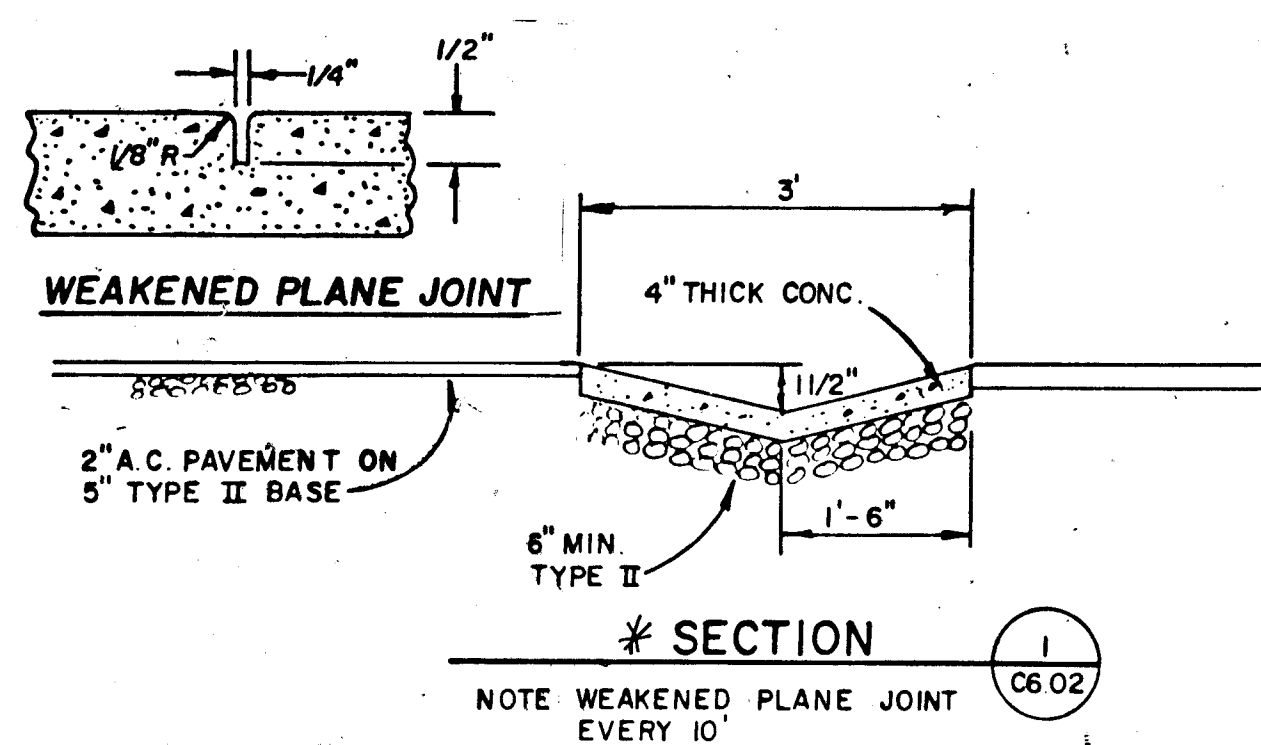
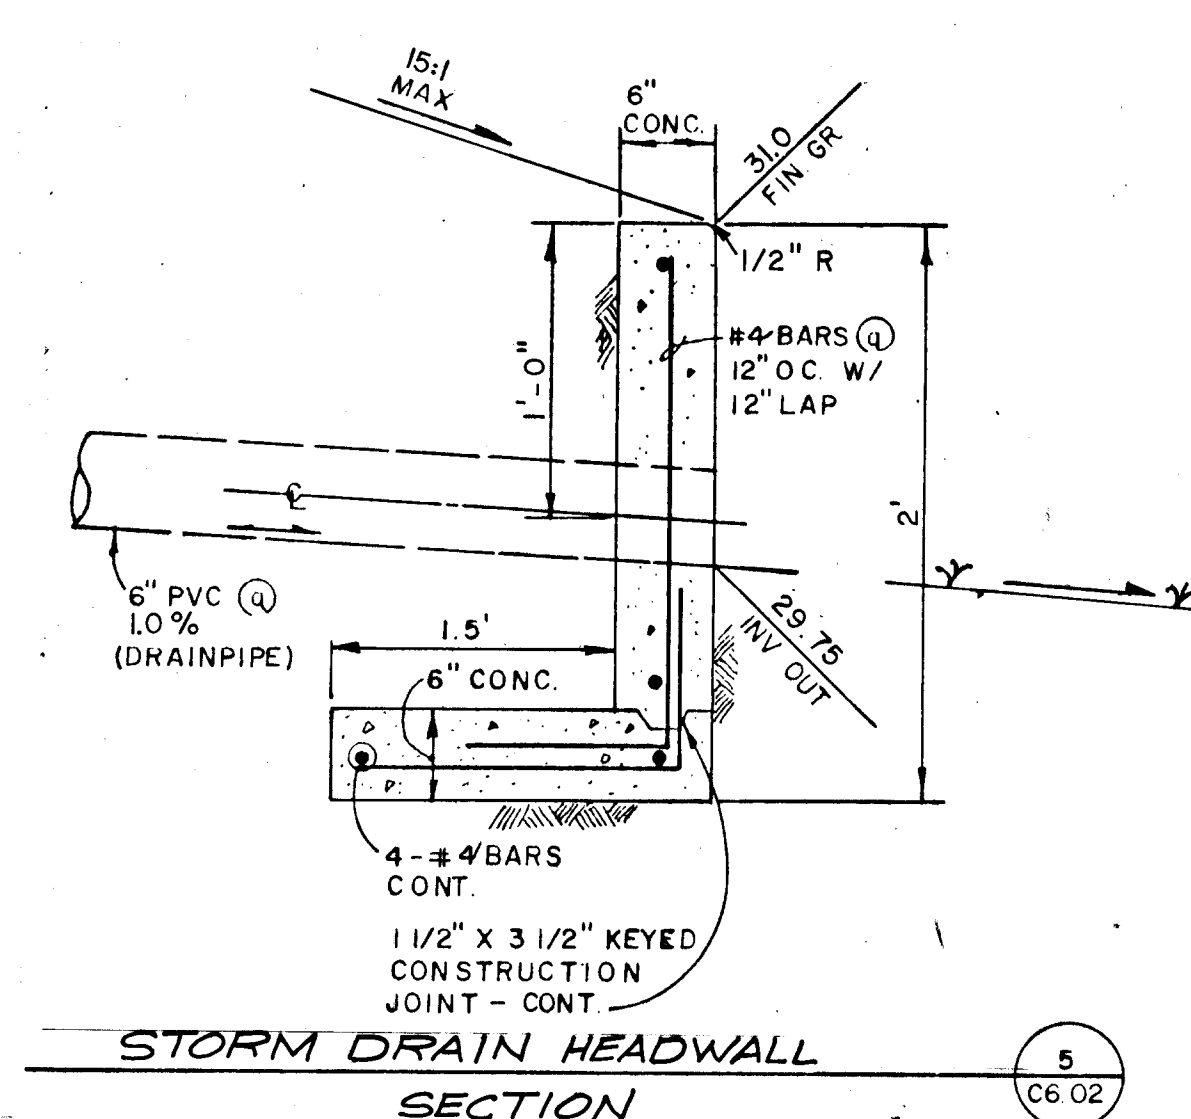
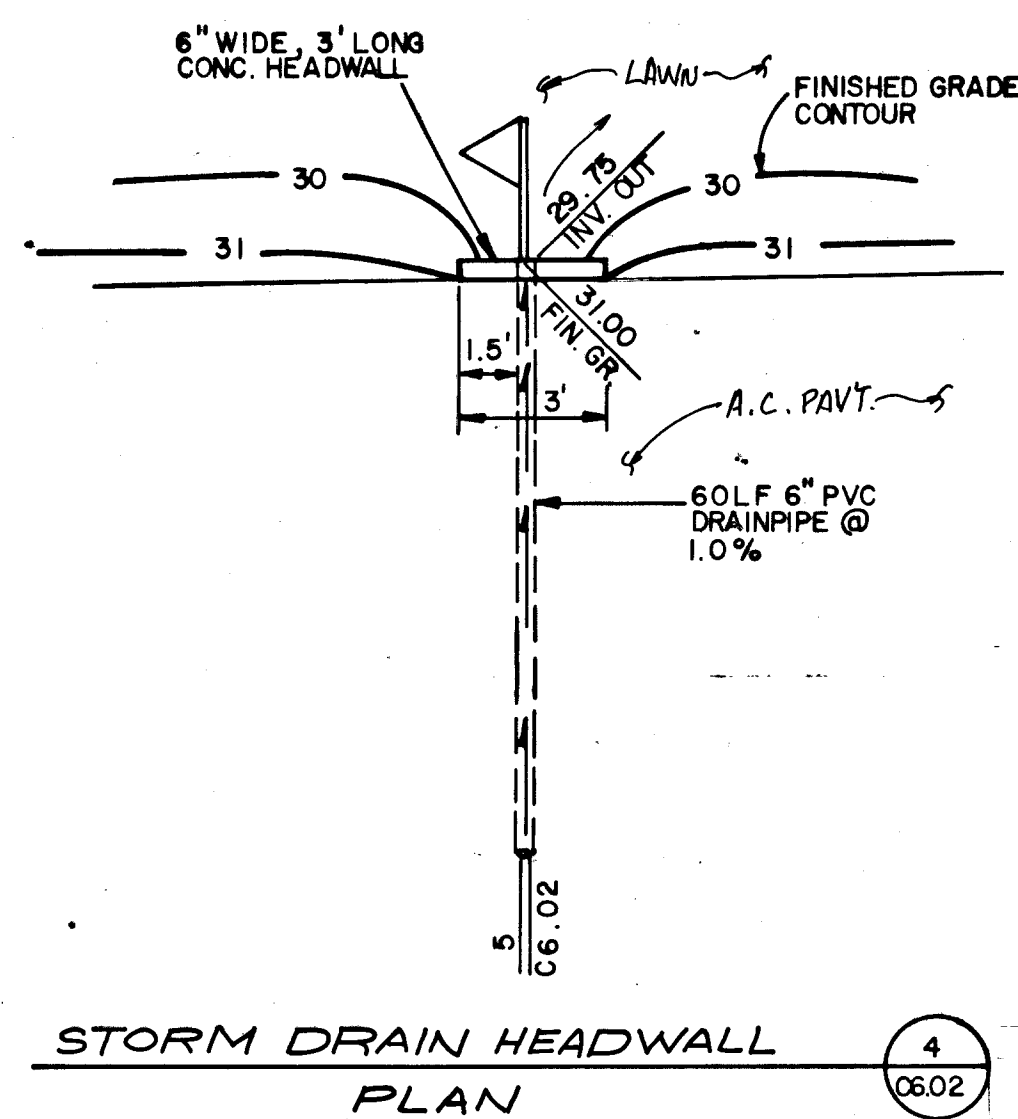
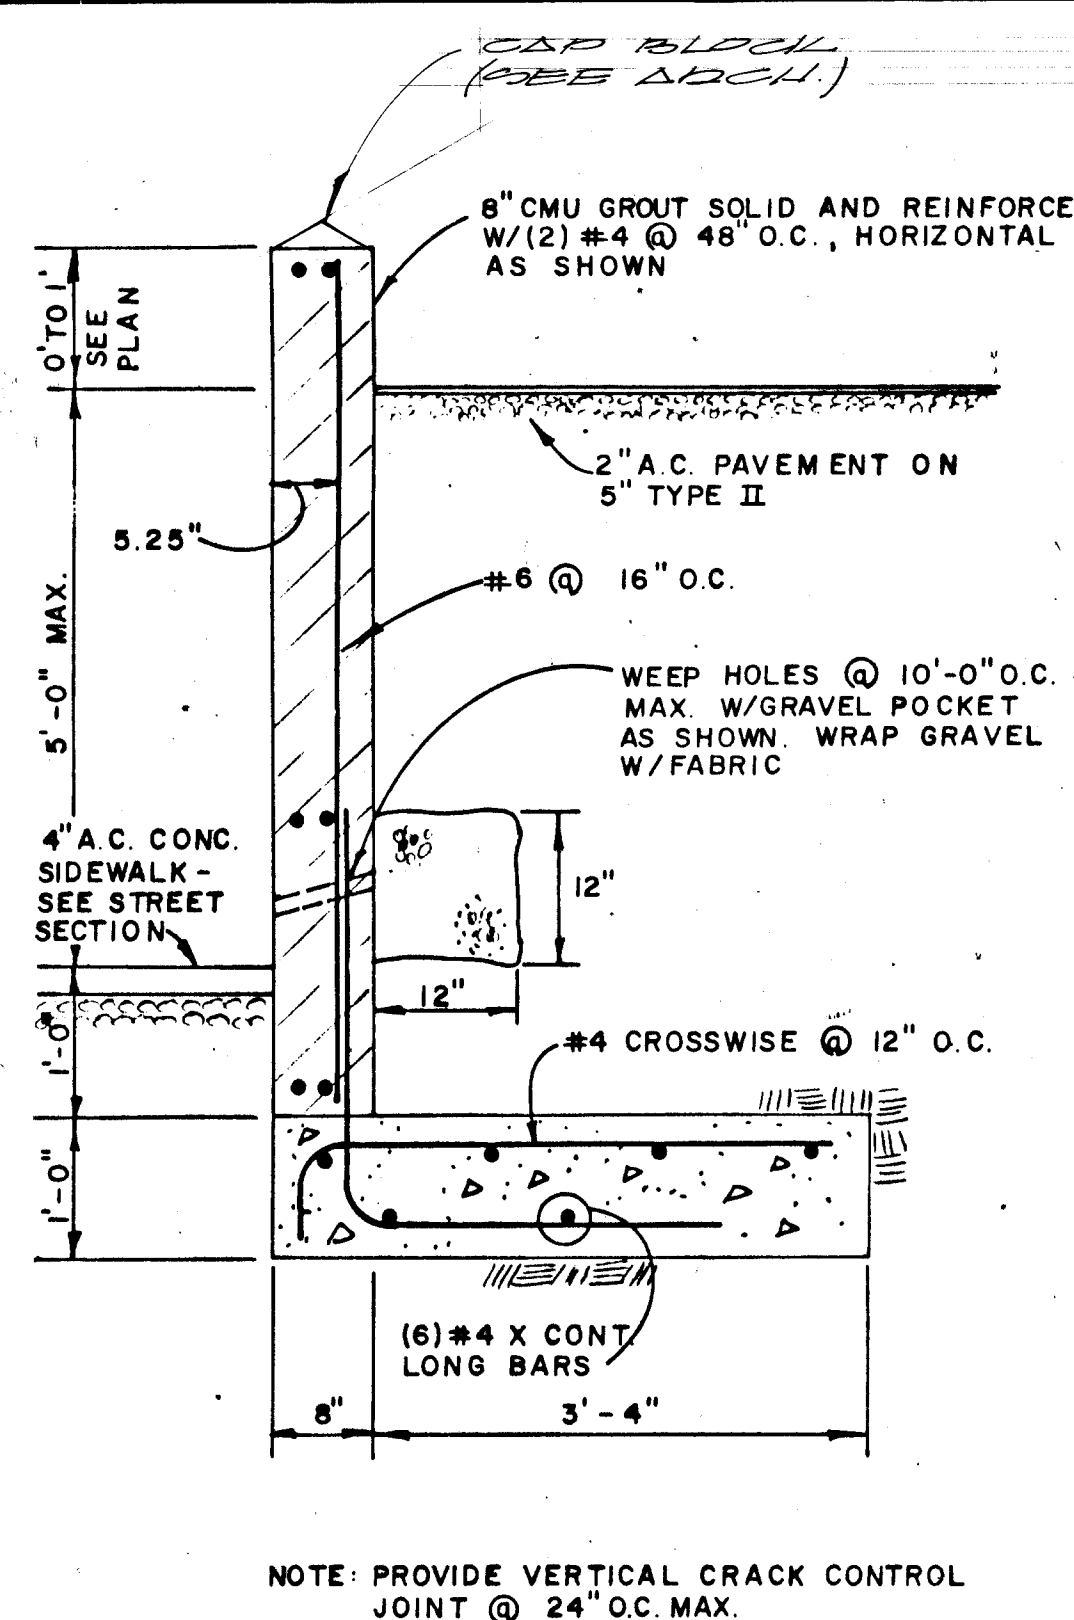
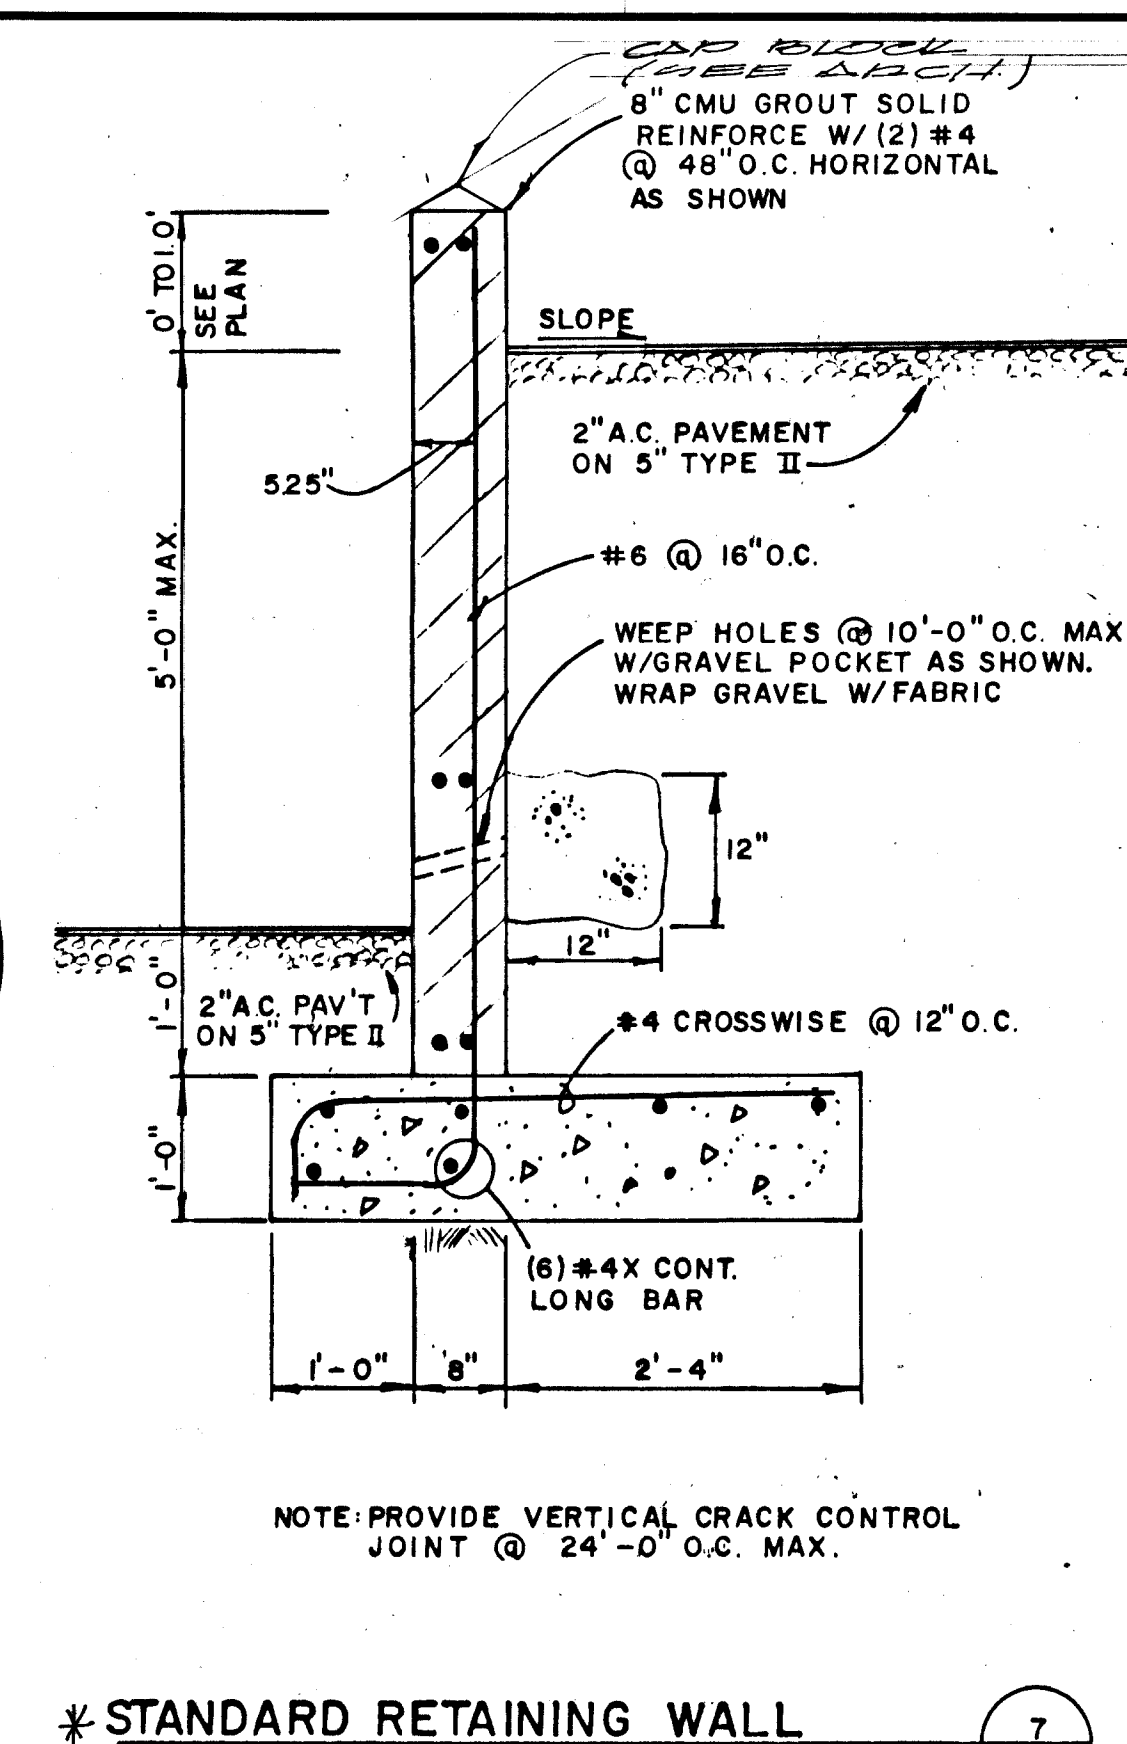


[illegible]

*ALL ONSITE CONSTRUCTION SHALL CONFORM TO
STRUCTURAL AND OTHER STANDARDS AND CODES
OF THE CLV BUILDING DEPARTMENT

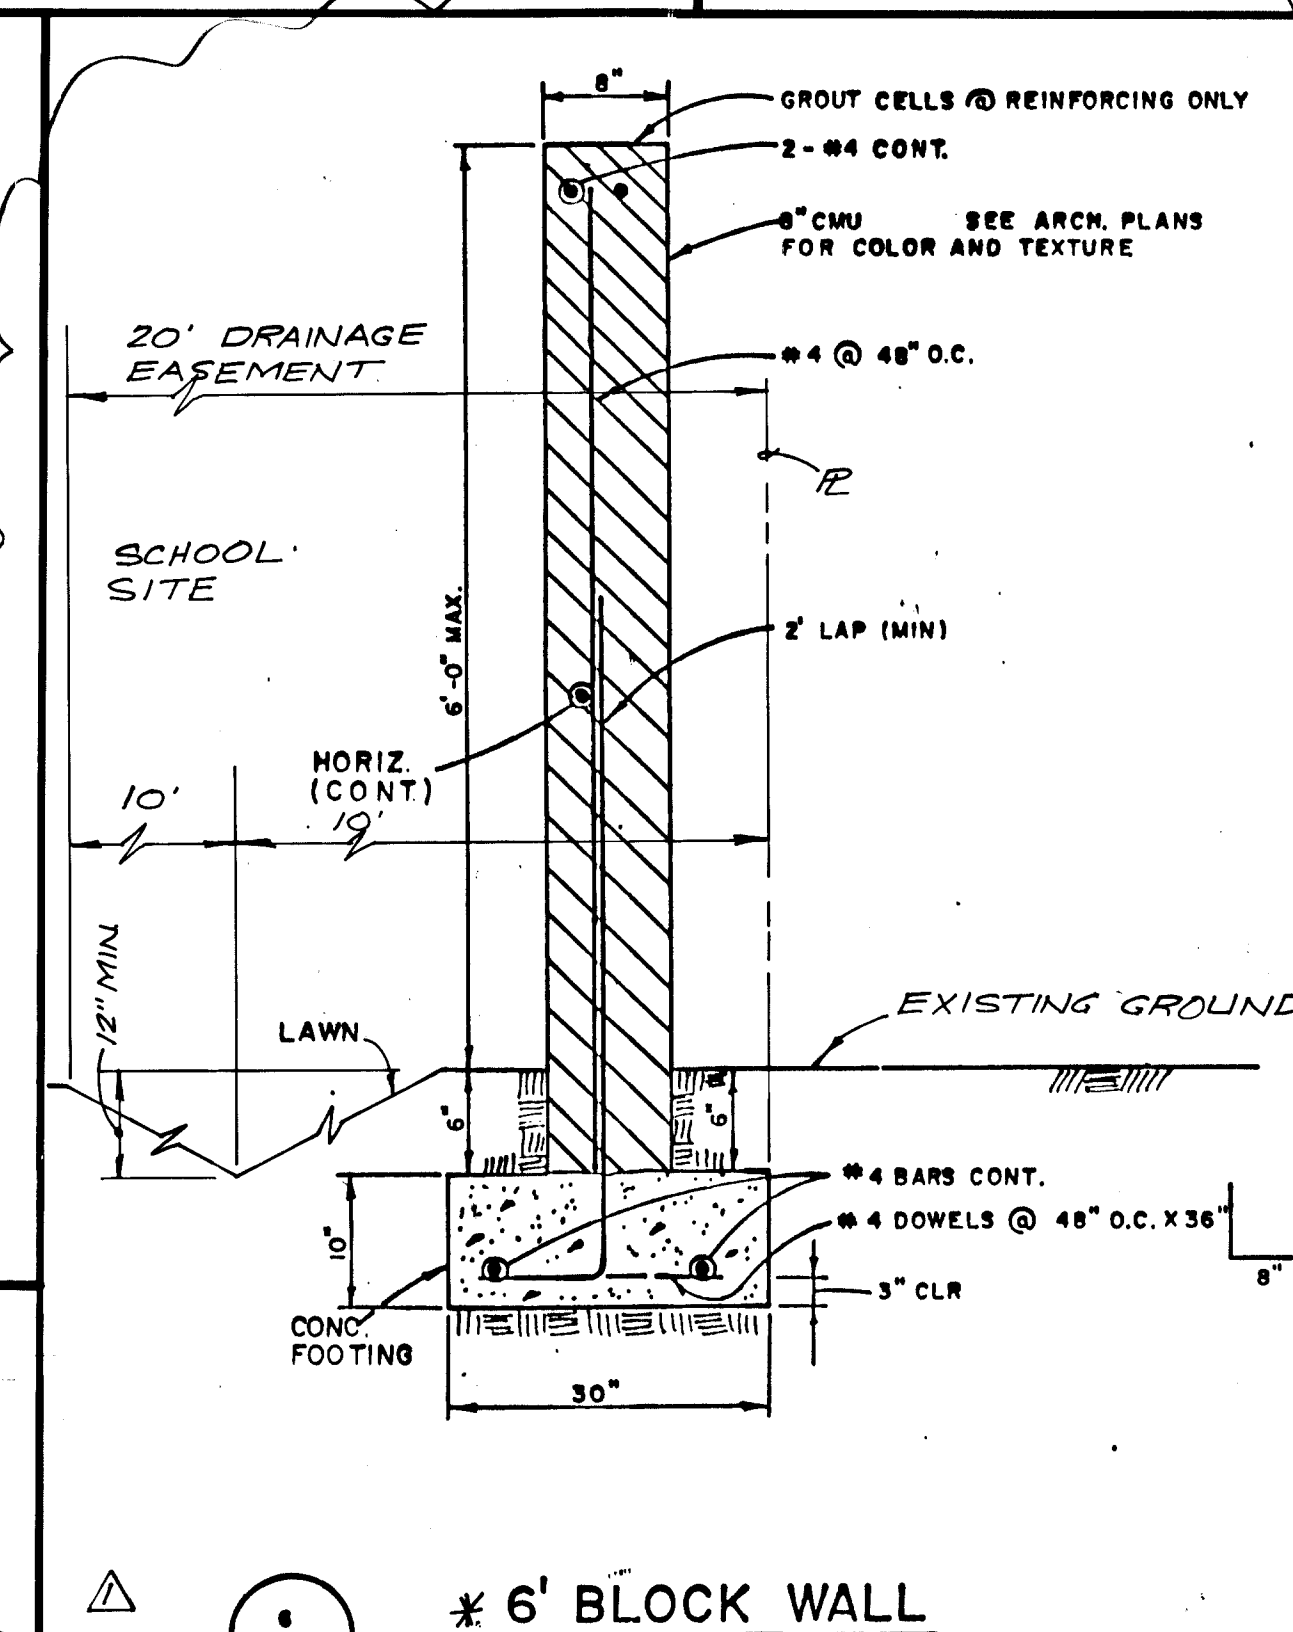

'L' FTG.-RETAINING WALL * 8
C6.02

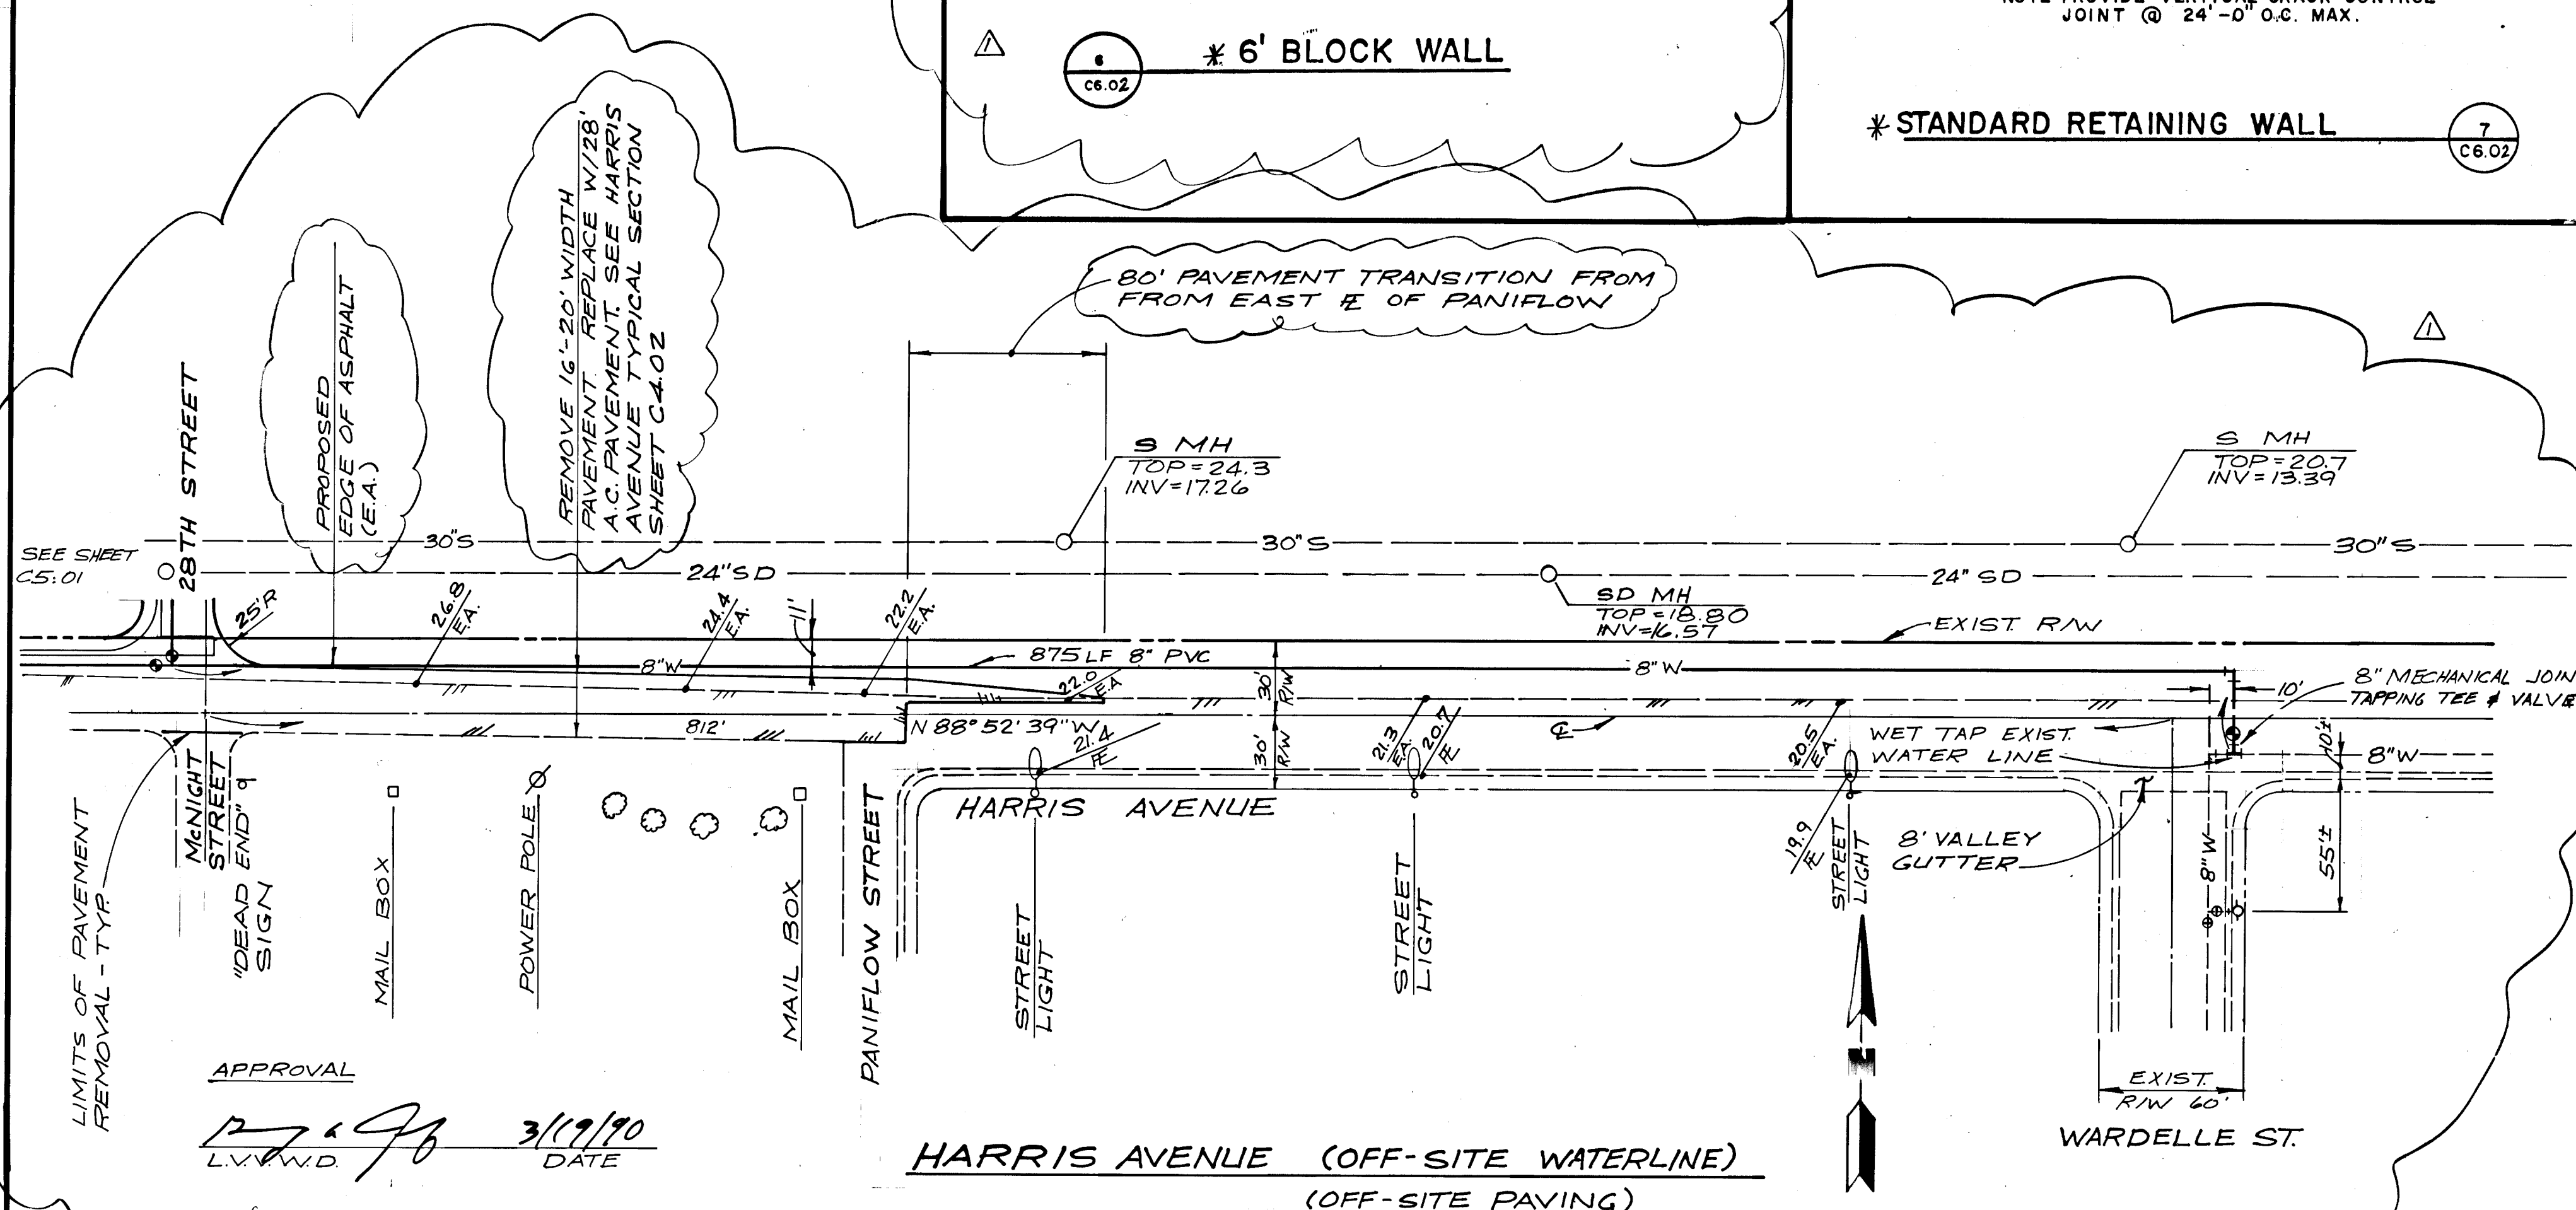

MARTIN & MARTIN
CIVIL ENGINEERS
1701 W. CHARLESTON BLVD.
SUITE 420
LAS VEGAS, NEVADA 89102



JMA ARCHITECTS & ENGINEERS, INC.

Architecture and Engineering
Research and Planning
Interior and Graphic Design
Landscape Architecture

CLARK COUNTY SCHOOL DISTRICT

ROBERT LUNT ELEMENTARY SCHOOL

SECTIONS AND DETAILS

SHEET NO.

C6.02
8 OF 8

41.5 - 70