



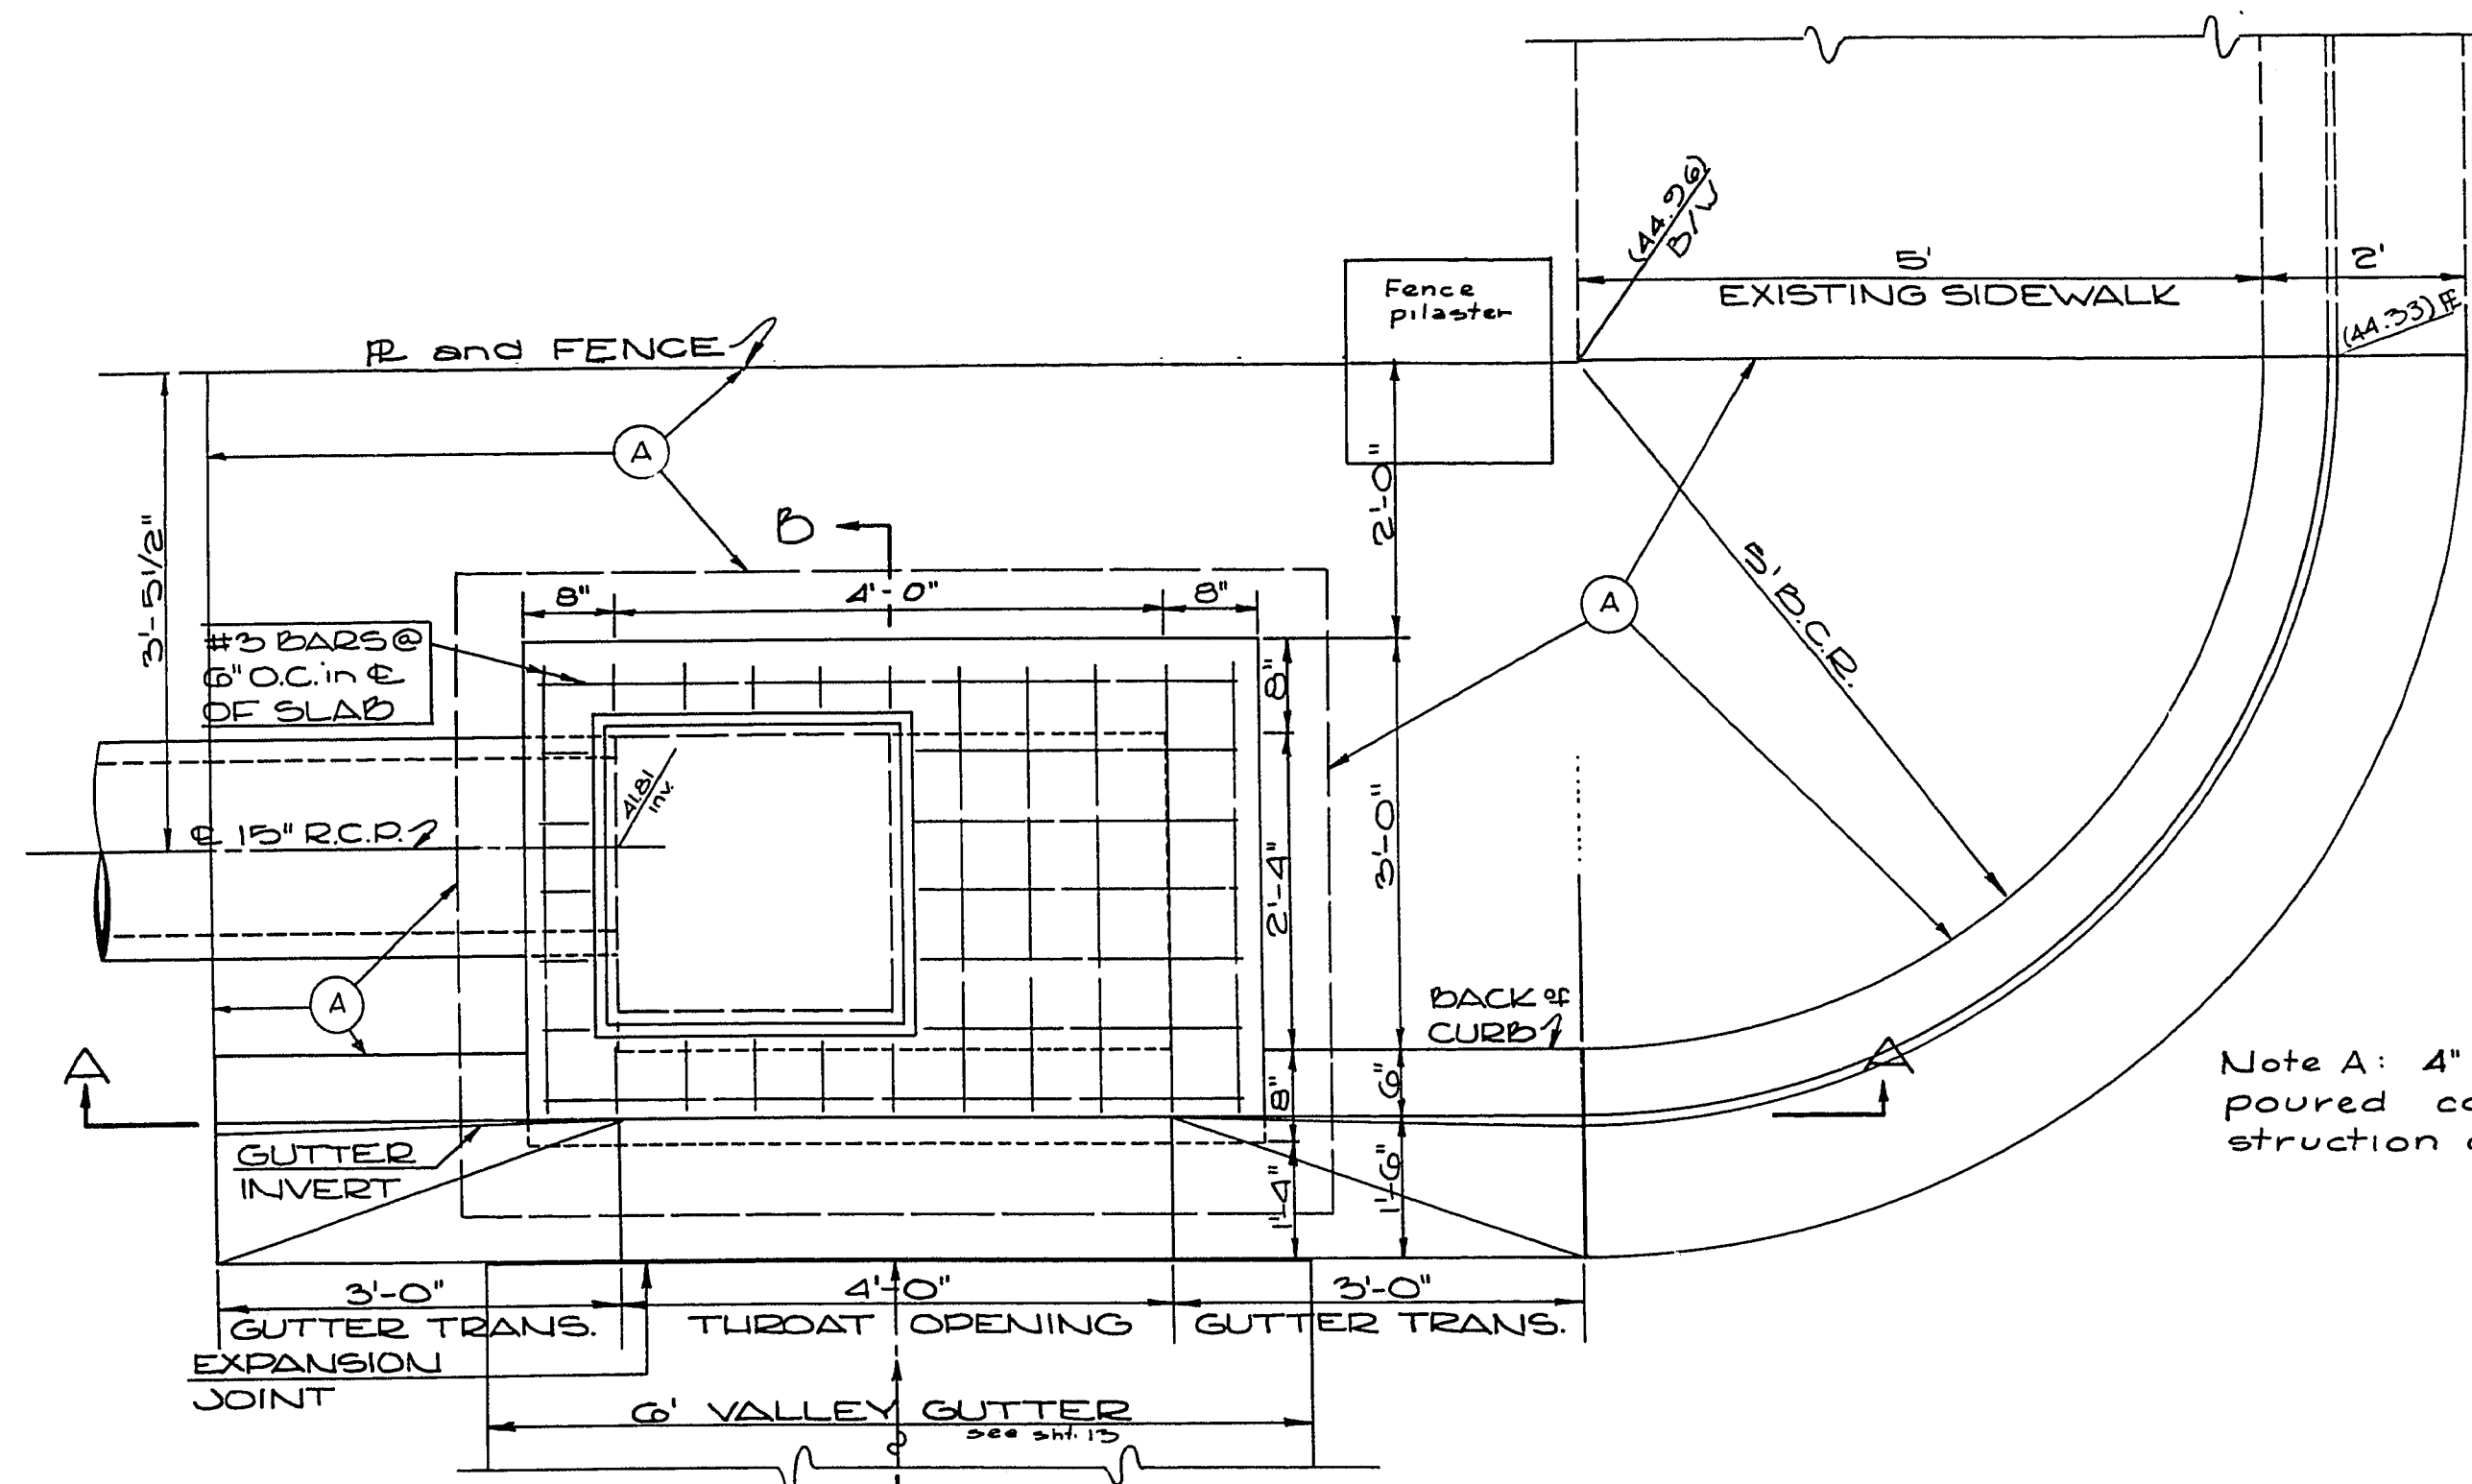


Note A: 4" conc. sidewalk to be poured concurrently with construction of inlet.

PLAN

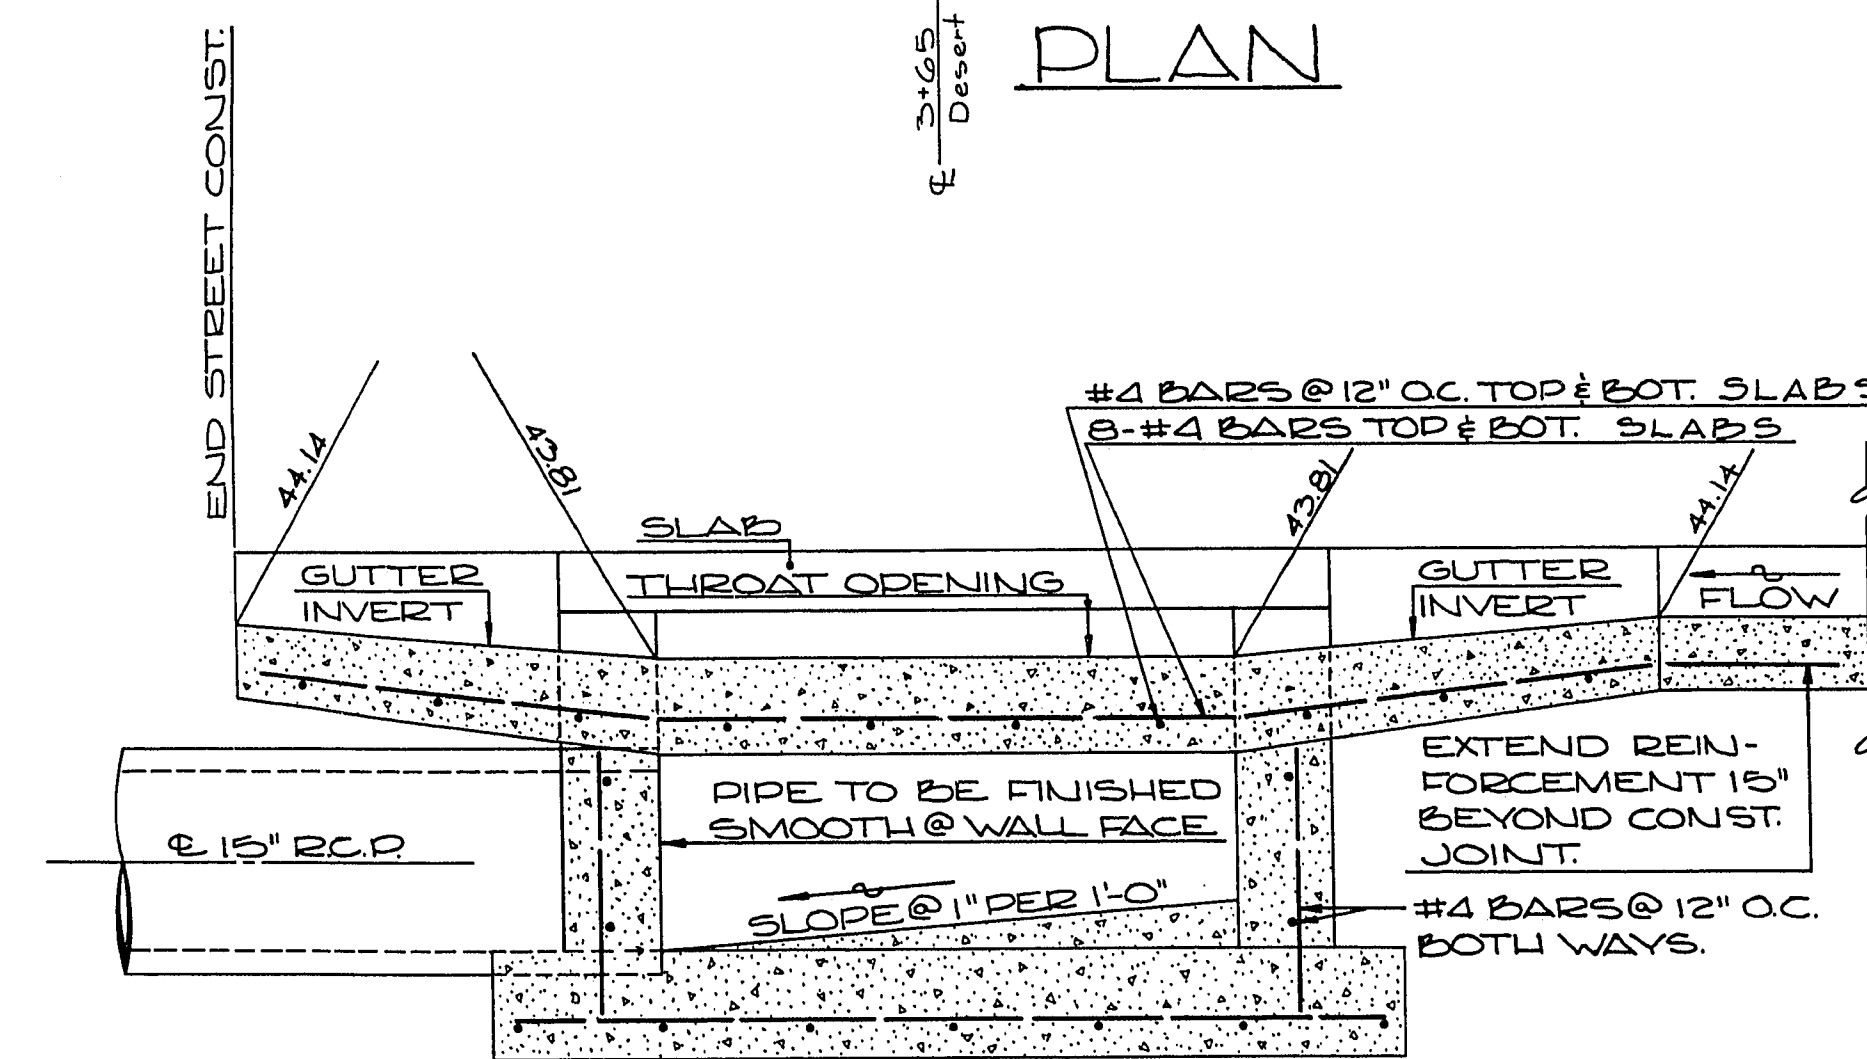


SECTION A-A

NOTE: ALL STEEL TO CLEAR OUTSIDE SURFACE BY MIN. OF 3".

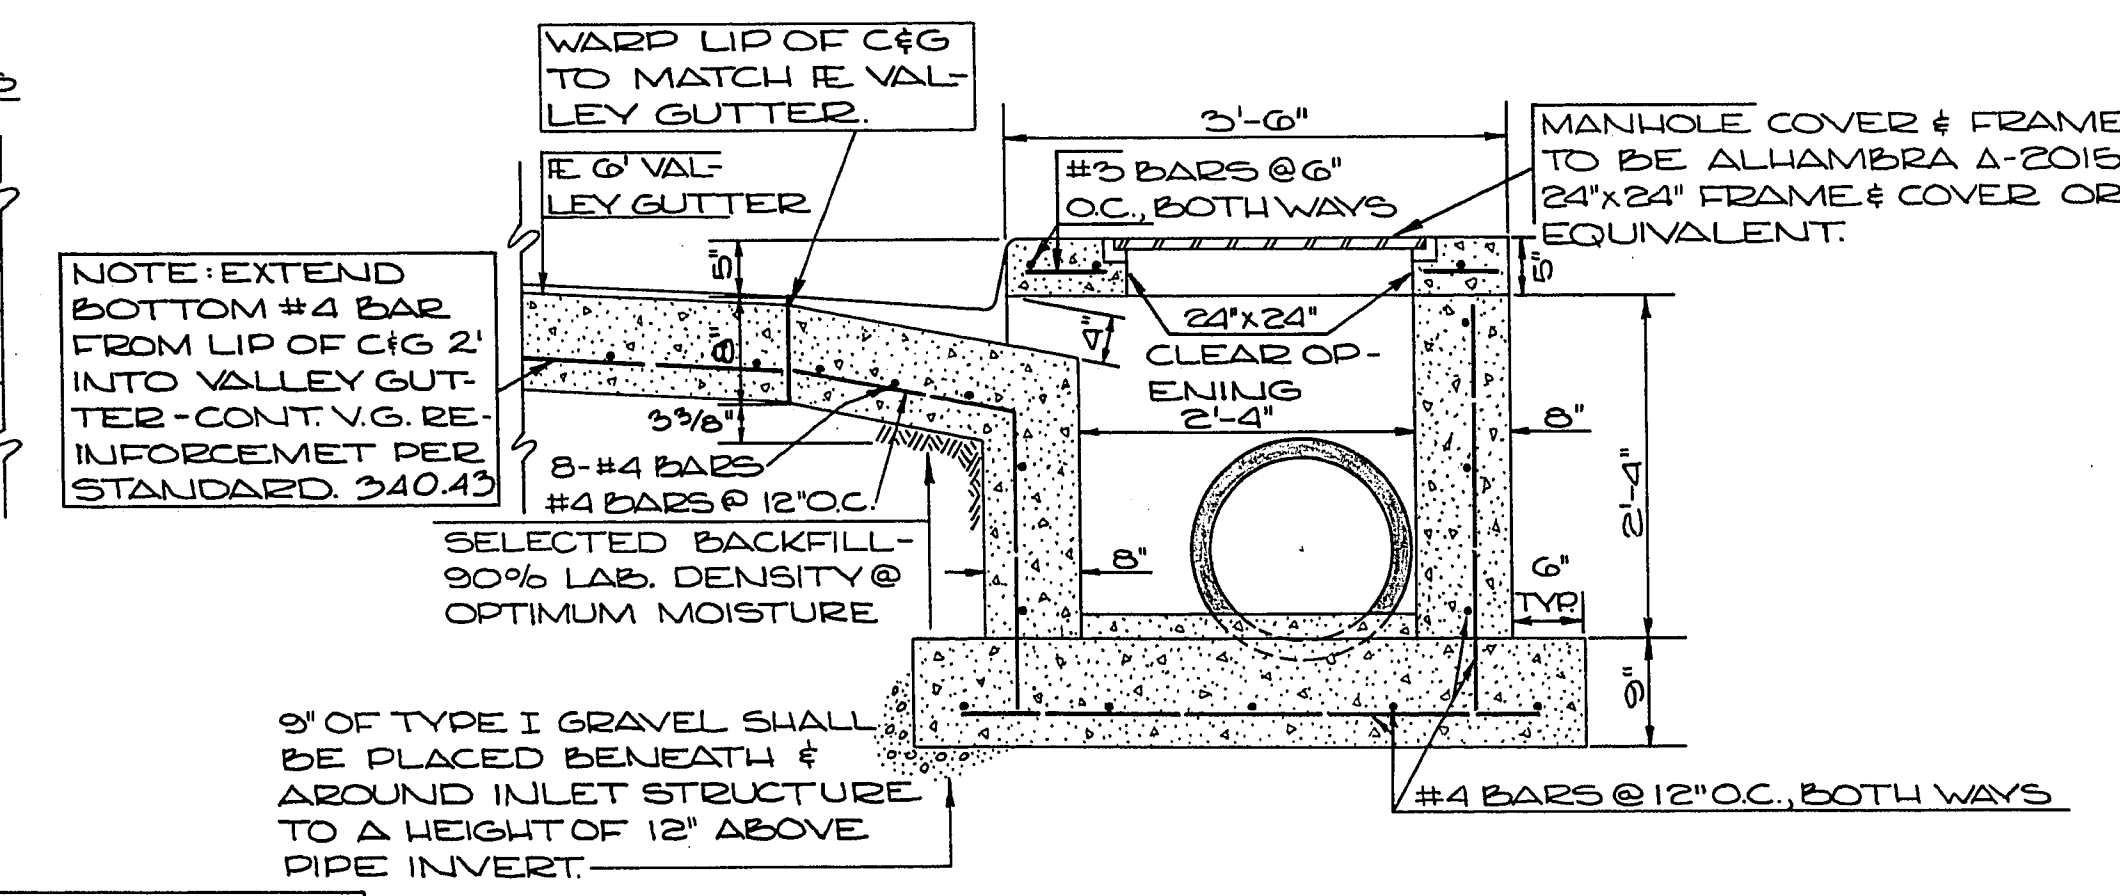


SECTION B-B

DETAIL - DROP INLET - 4' OPENING

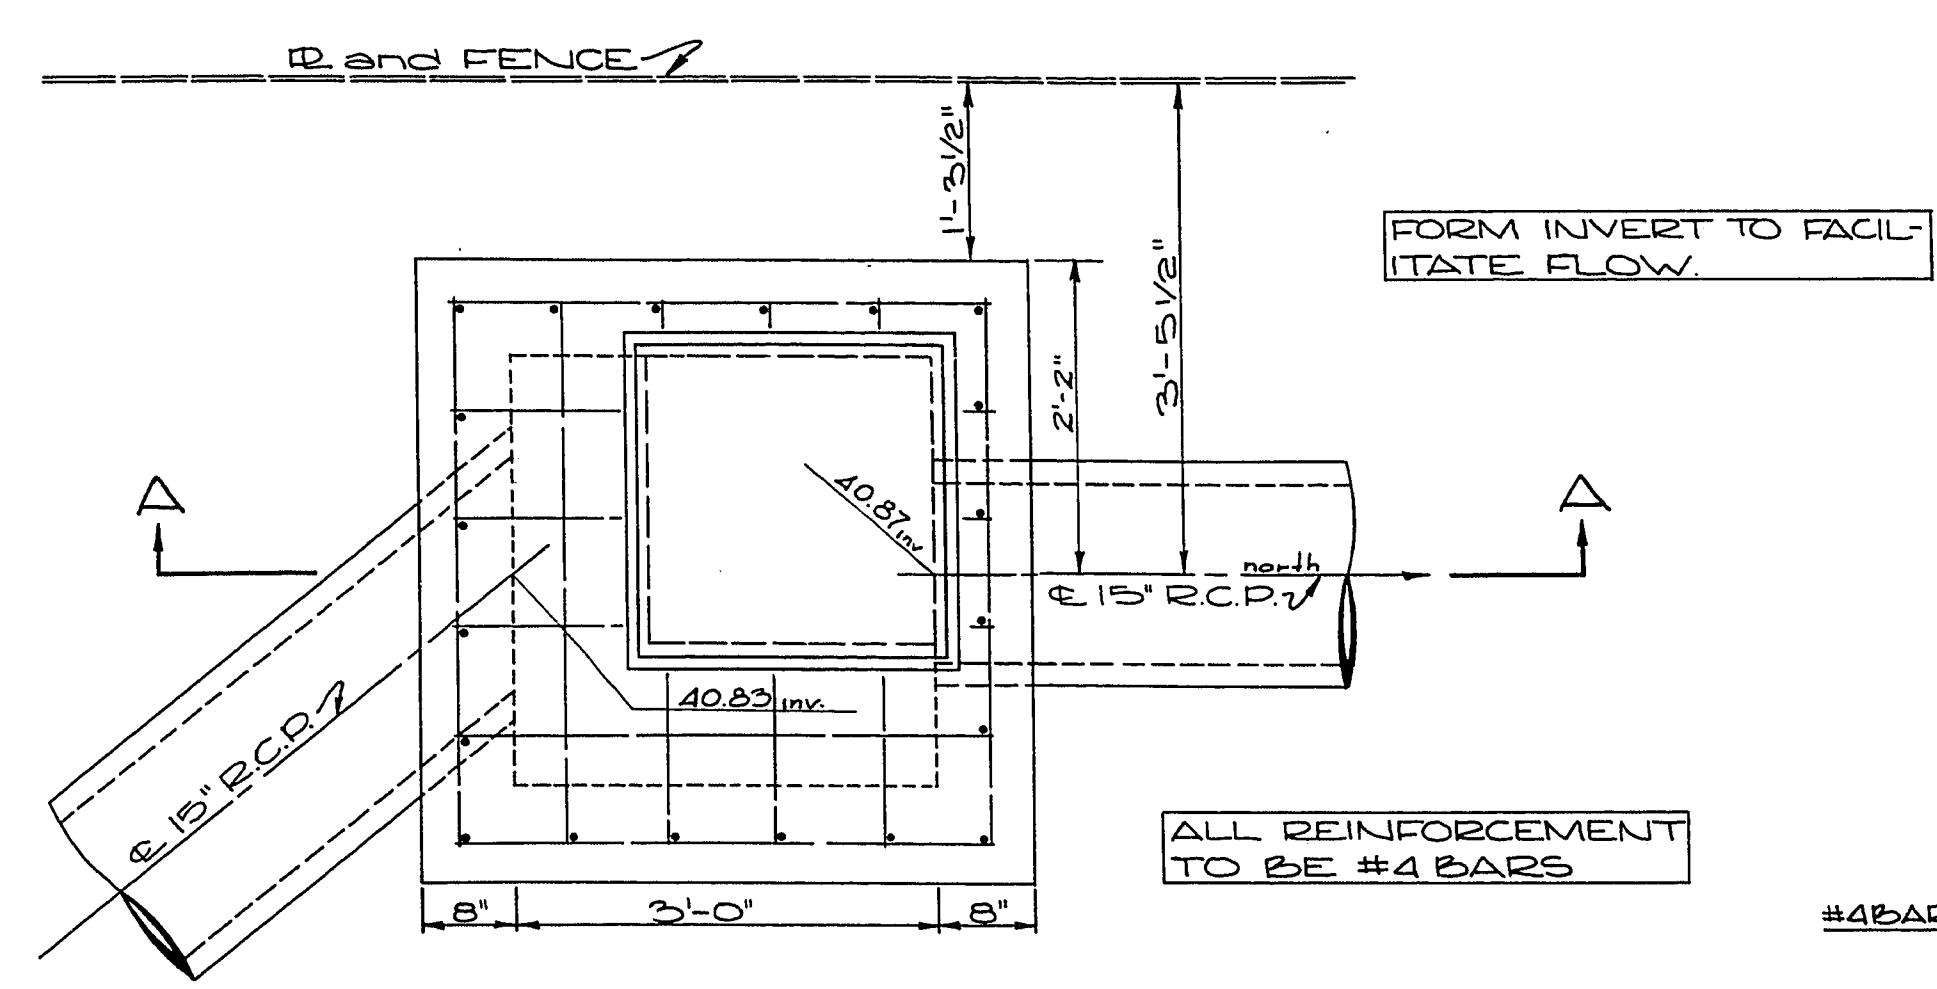


PLAN

NOTE: ALL STEEL TO CLEAR OUTSIDE SURFACE BY MIN. OF 3".

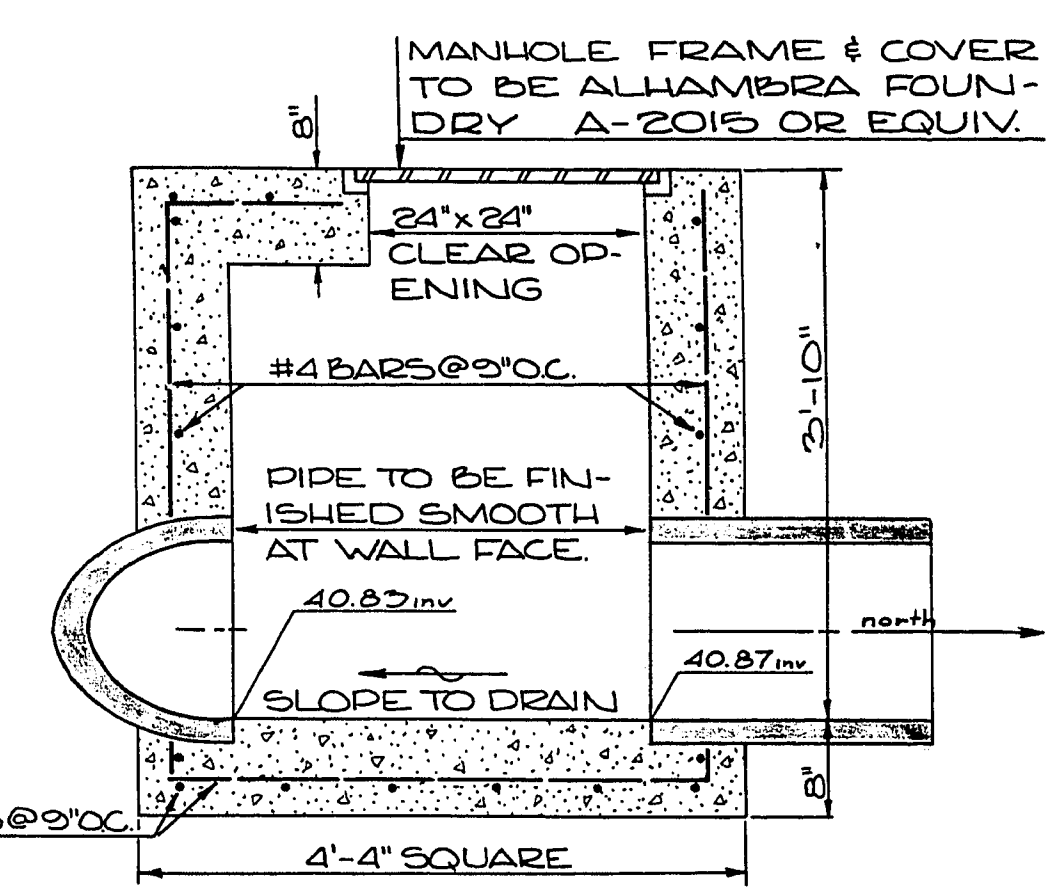


SECTION A-A

DETAIL - JUNCTION BOX

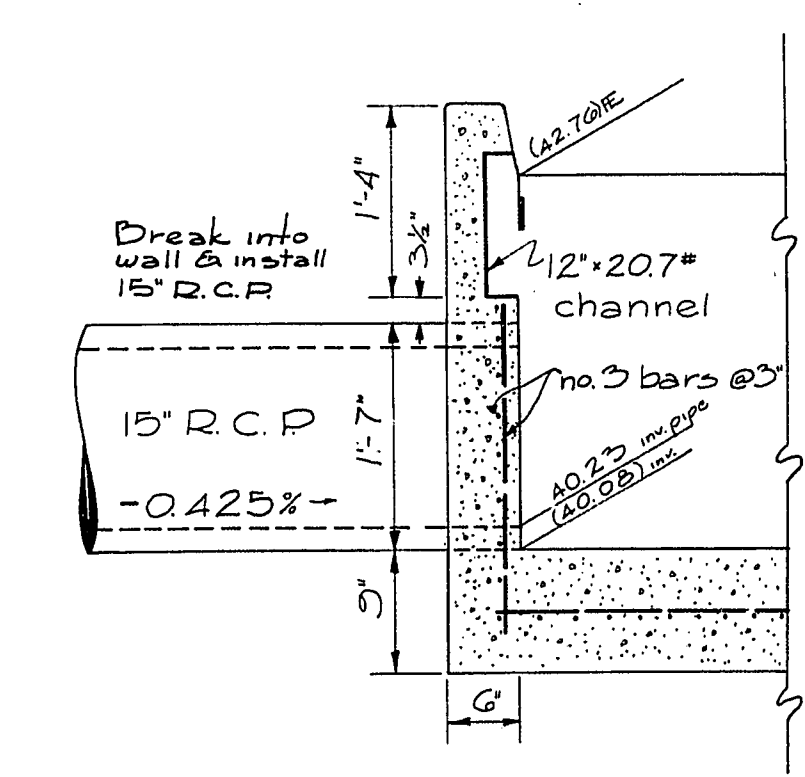

Section A-A

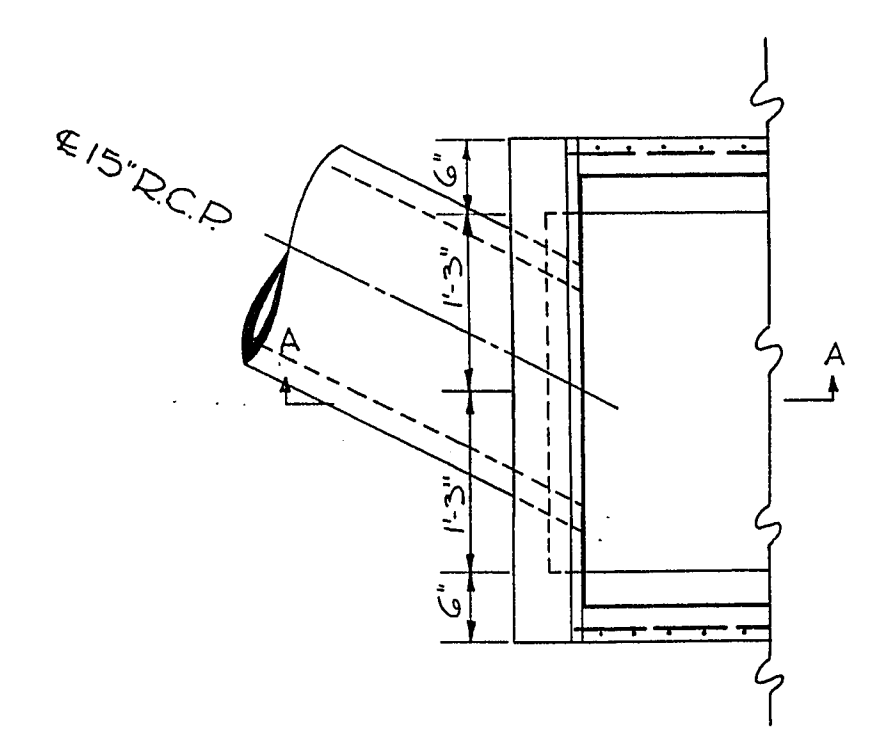

Plan

Detail - Highland Ave. Drop Inlet Revision

I CERTIFY THAT THIS PLAN WAS PREPARED UNDER MY SUPERVISION.
 JAY M. RASLER
 JAY M. RASLER
 R.P.E. 1624
 DATE 12-7-70

CITY OF LAS VEGAS NEVADA			
DEPARTMENT OF PUBLIC WORKS			
SERVICES DIVISION			
Details - S.I.D. 490			
Shadow, Desert, Ellis, & Waldman			
W.O. NO. 4900	F.B.K. NO. 68-6X	DATE	DRAWING NO.
SC. (H) 3/4" = 1'-0"	SC. (V)	02-08-70	107-V-800
DES. BILLINGSLEY			FILE NO.
DR. CAPPY			
APPROVED BY DIRECTOR OF PUBLIC WORKS			SHEET 19 OF 35

15-4-70