



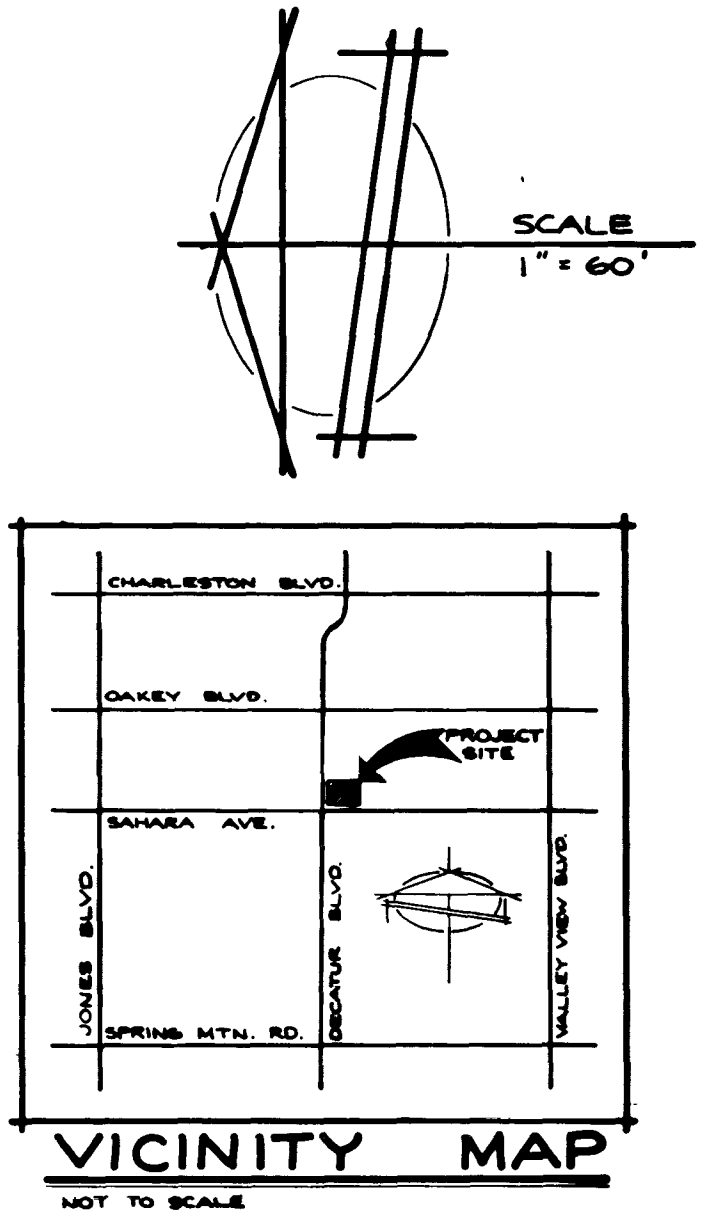

LEGEND

- Property Line
- Street Centerline
- Concrete
- Building Line
- T.G. Top of Grate
- T.C. Top of Curb
- T.W. Top of Walk
- R. Flow Line
- T.M.H. Top of Manhole
- AC AC Pavement
- D.I. Drop Inlet
- INV. Invert
- Exist. Contour Line
- Design Contour Line
- Exist. Elevation
- Design Elevation
- "A" Type Curb
- "I" Type Curb

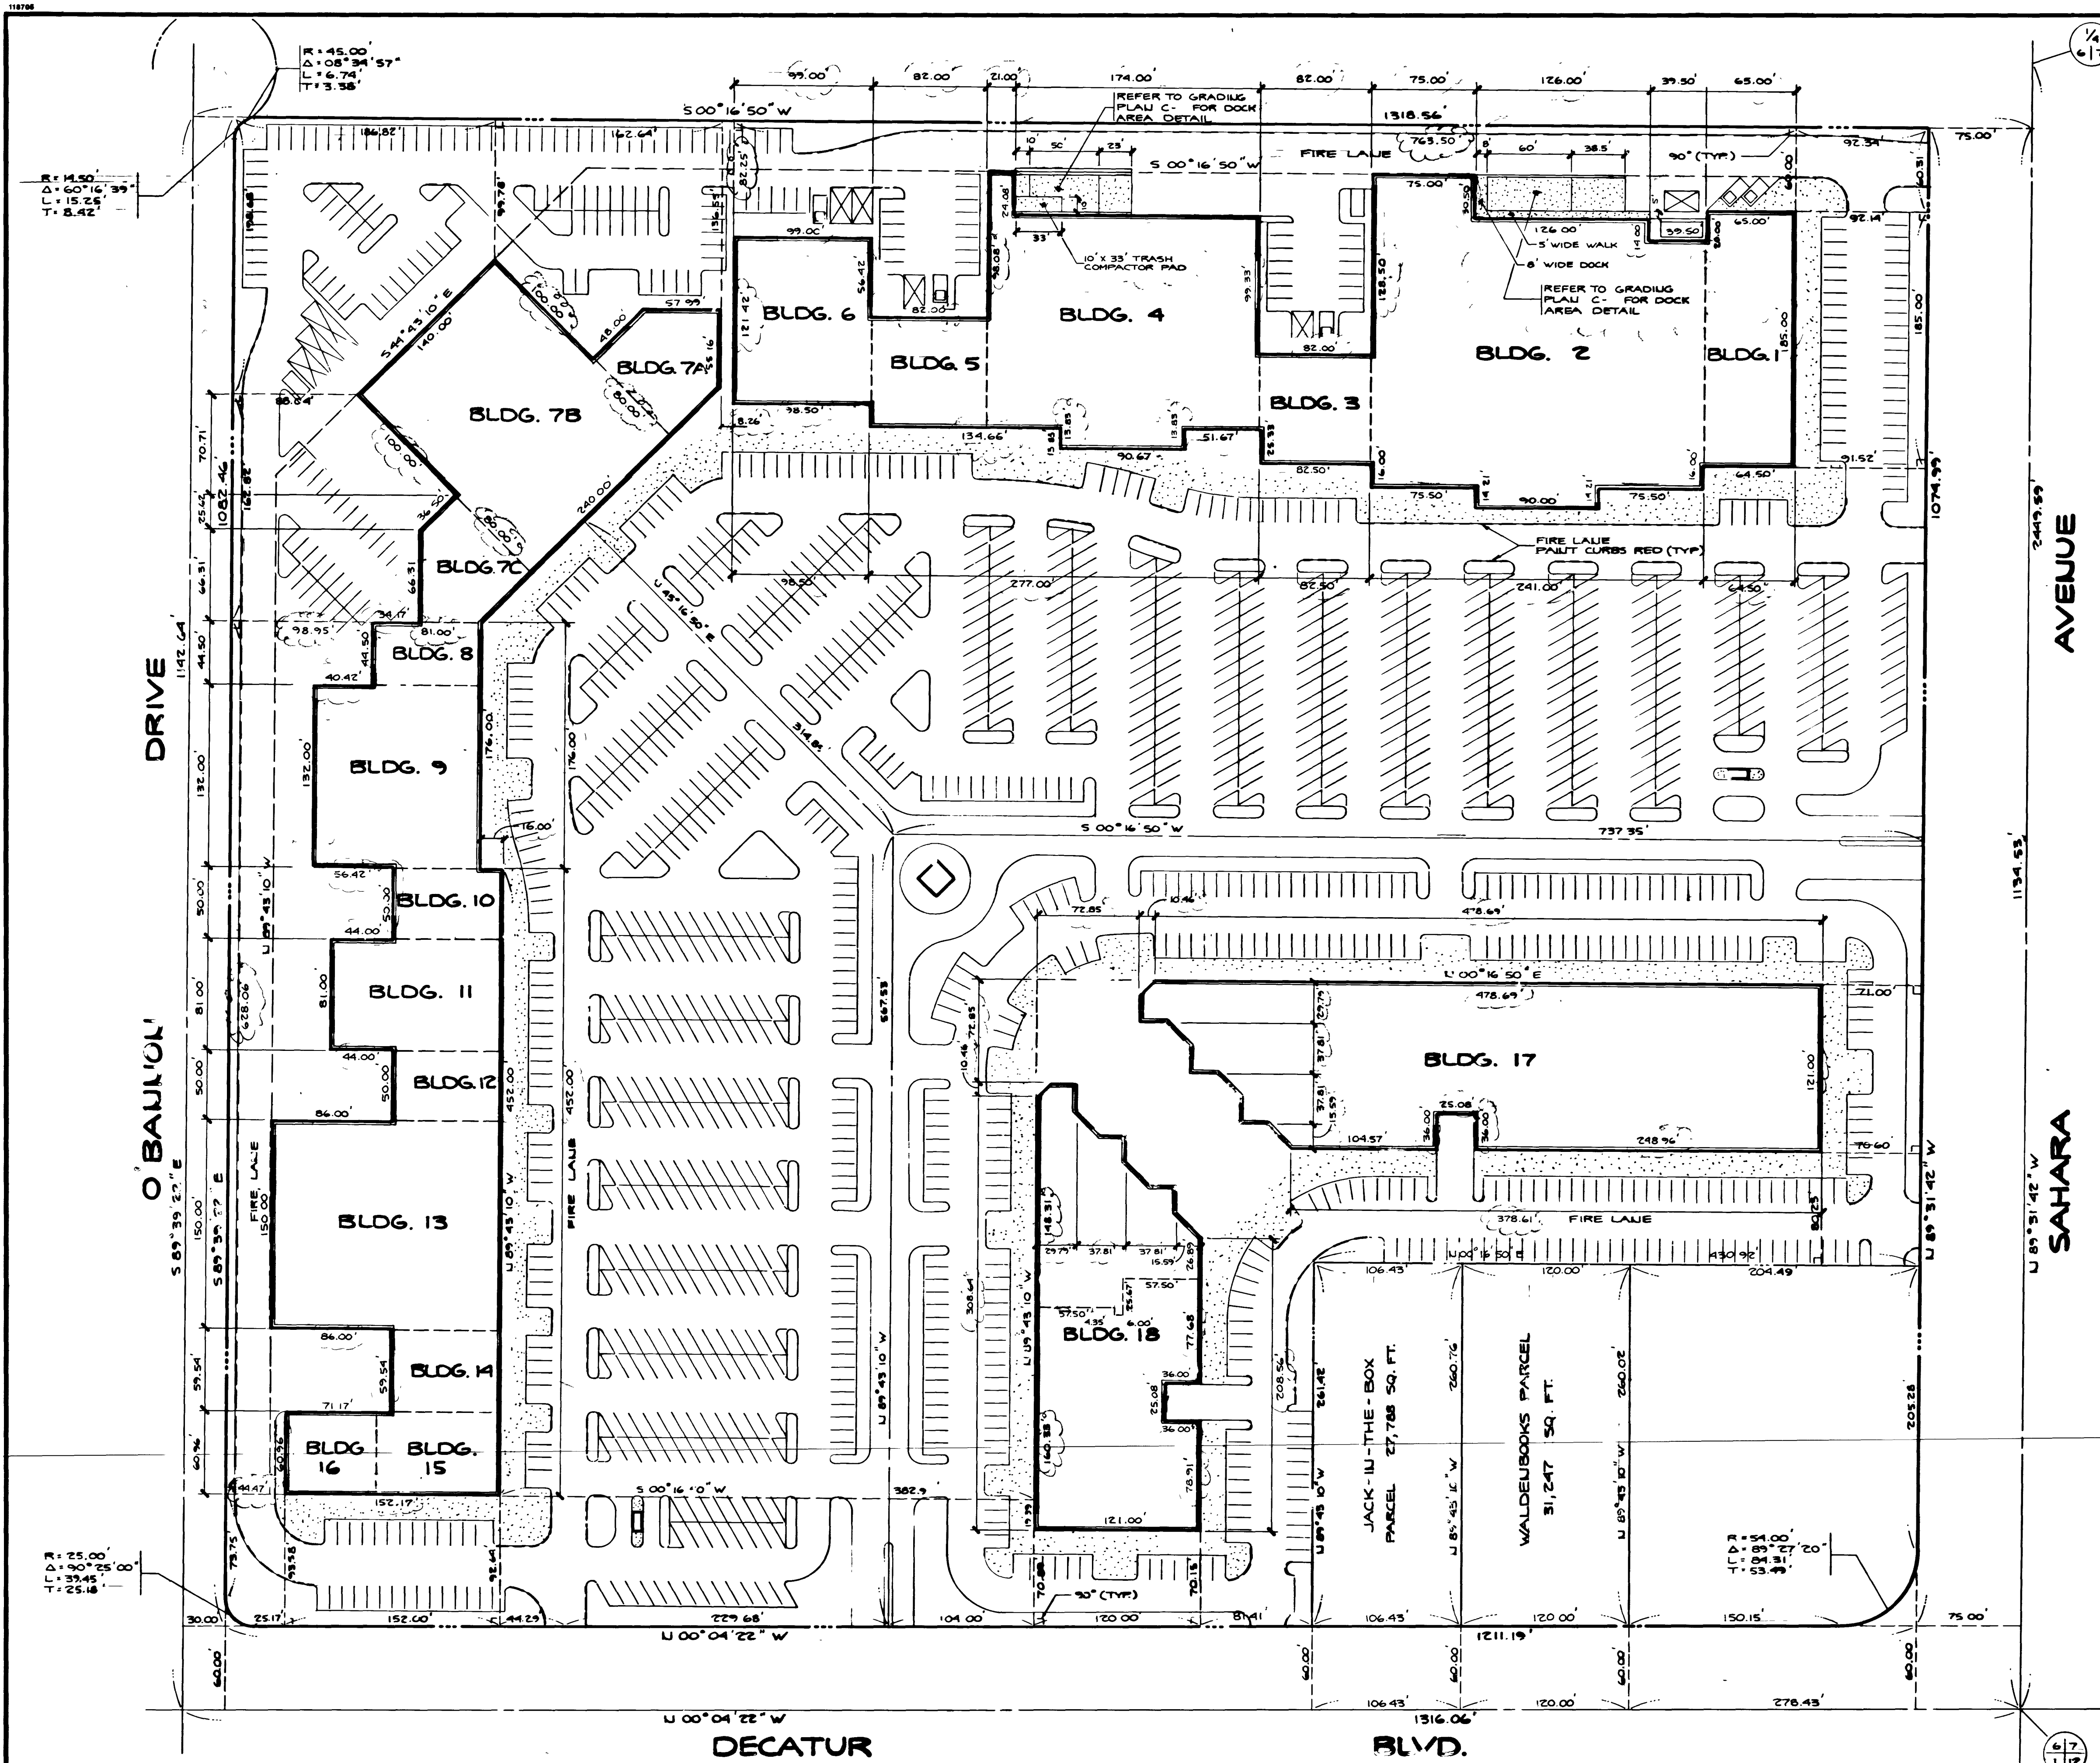

DATE	DESIGN	CHECK	SCALE
2/22/89	BAUGHMAN & TURNER	MINING ENGINEERS	1" = 60'
2/22/89	CIVIL ENGINEERS	LAND SURVEYORS	
2/22/89	3325 WEST CHARLESTON BOULEVARD	LAS VEGAS, NEVADA 89102	
2/22/89	SECTION 6, TOWNSHIP 21 SOUTH, RANGE 61 EAST, MDB # 11, CLARK COUNTY, NEVADA	SAHARA PAVILION NORTH	
2/22/89	PROJECT NO.	ALLIED DEVELOPMENT CO.	
2/22/89	DATE	REVISIONS	APPROVED
2/22/89	1	ADDED DOCK AREAS & REVISED BLDG. DIMENSIONS	
2/22/89	2	ADDED WALKWAYS & DOCK AREAS	

