

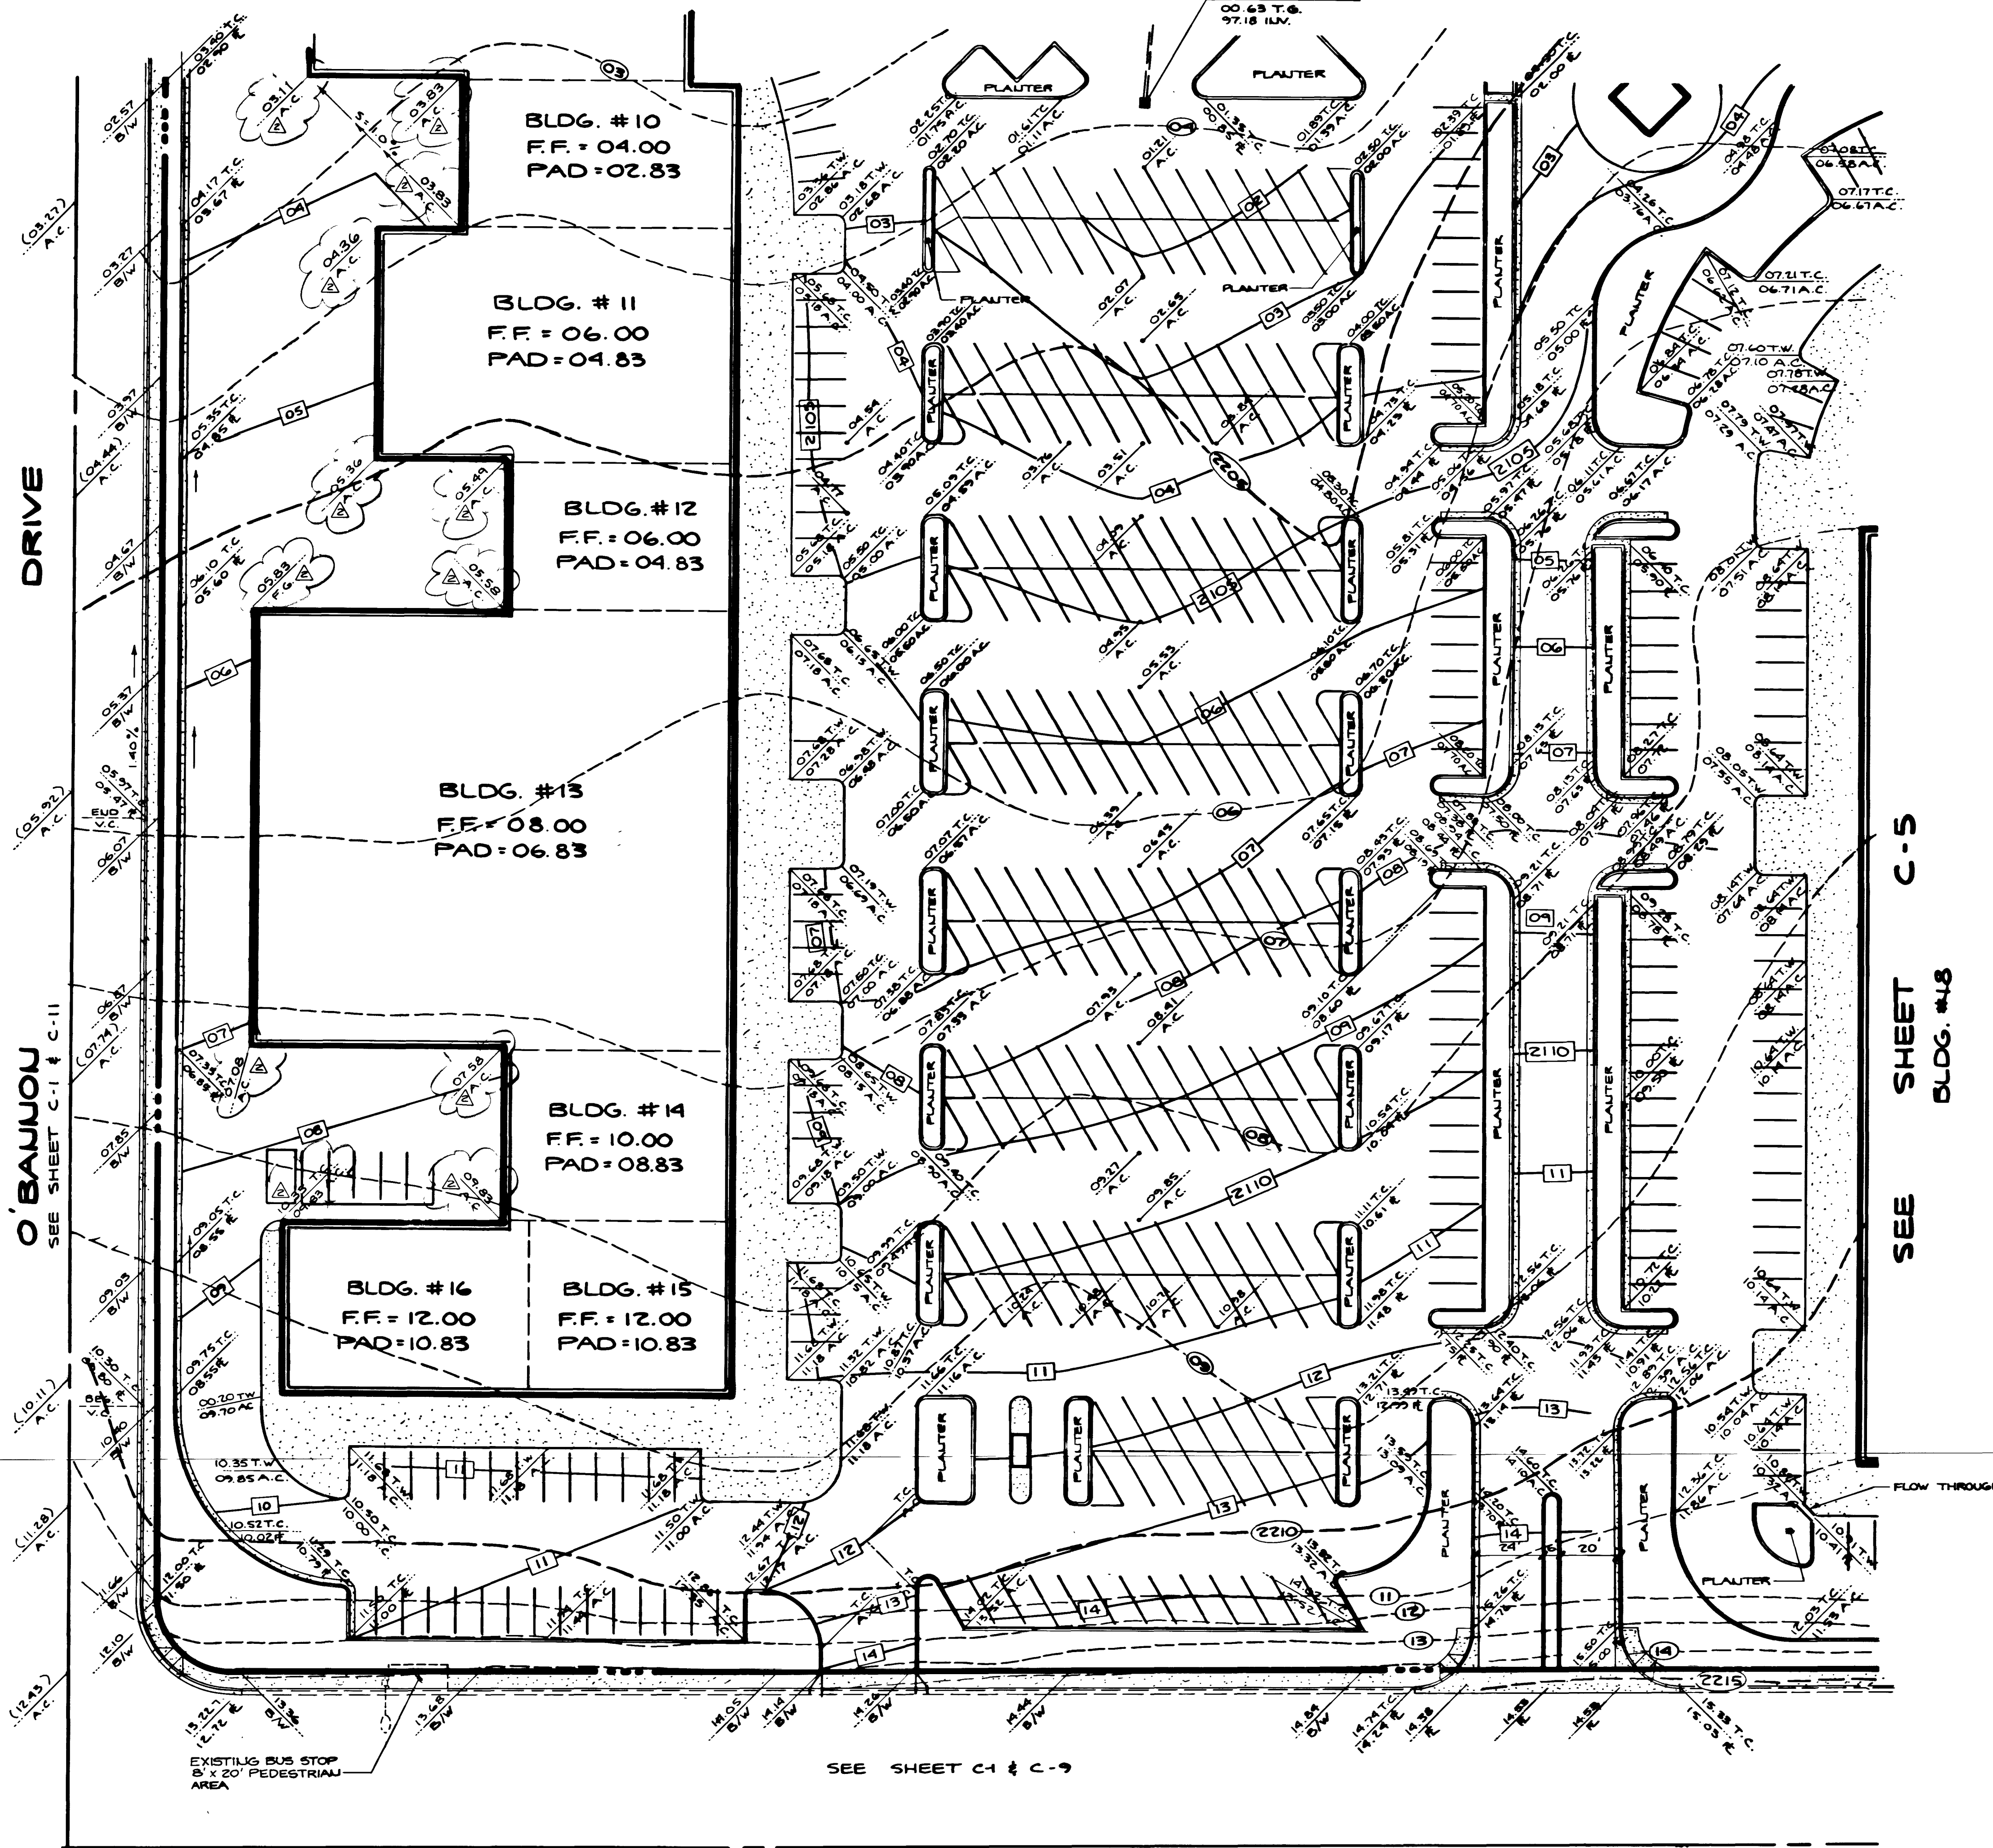
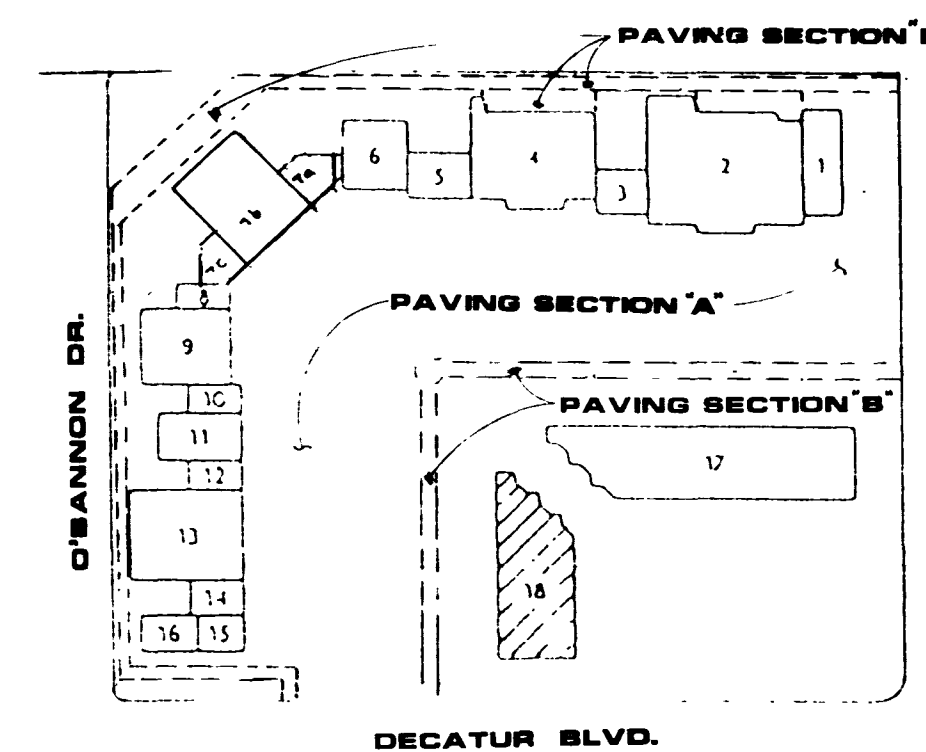


SEE SHEET C-3

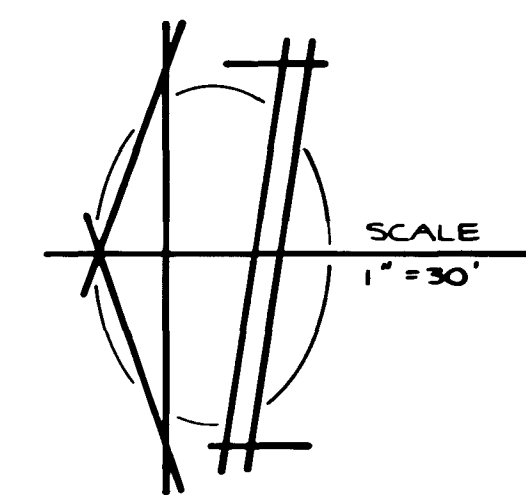

BENCH MARK

B.M. No. C115W06 - Nevada Hwy. Dept. brass cap 0.10' below A.C.
at centerline intersection of Decatur Blvd. & Sahara Ave.
Elev. 2218.49 C.C.E.D. Datum
Equation: C.C.E.D. Datum + 0.43' = C.L.V. Datum

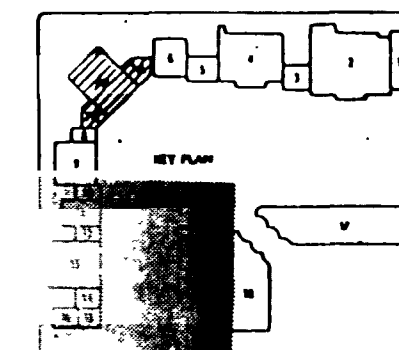

NOTE: ALL SITE WORK TO CONFORM TO "UNIFORM STANDARD SPECIFICATIONS FOR PUBLIC WORKS CONSTRUCTION OFF-SITE IMPROVEMENTS" CLARK COUNTY AREA, NEVADA; 1988 EDITION

LEGEND

- Property Line
- Street Centerline
- Concrete
- Building Line
- T.G. Top of Grade
- T.C. Top of Curb
- T.W. Top of Walk
- R. Flow Line
- T.M.H. Top of Manhole
- AC AC Pavement
- D.I. Drop Inlet
- INV. Invert
- Exist. Contour Line
- Design Contour Line AC PAVE
- Exist. Elevation
- Design Elevation
- "A" Type Curb
- "L" Type Curb
- CONTOUR LINE ROUGH GRADE


QUANTITIES

CUT - 33,174 CU. YDS.
FILL - 29,969 CU. YDS.
EXCESS - 3205 CU. YDS.
QUANTITIES INCLUDE 25% SHRINKAGE & 0.25' SUBSIDENCE

Richard P. Baughman
2-22-89

APP'D	REVISIONS	DATE	BY	REASON
PREPARED BY: BAUGHMAN & TURNER DATE DEC. 1988 DESIGN G.A.P. DRAWN D.B.T. CHECK R.J.B. SCALE 1"=50' CIVIL ENGINEERS LAND SURVEYORS 3333 WEST CHARLTON BOULEVARD LAS VEGAS, NEVADA 89102 702.770.9771				
GRADING PLAN SECTION 4, TOWNSHIP 21 SOUTH, RANGE 41 EAST, M.D.B. 44M CITY OF LAS VEGAS, CLARK COUNTY, NEVADA SAHARA PAVILION NORTH				
PROJ. NO. 15168 P122				

SBS SHEET C-3

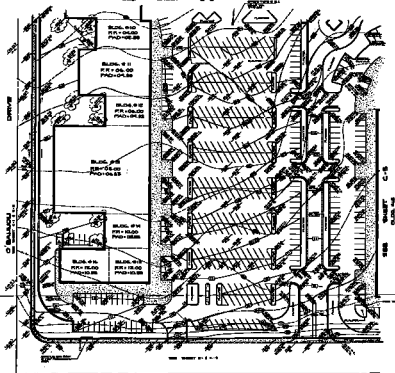

DECATUR

BLVD




