


107155

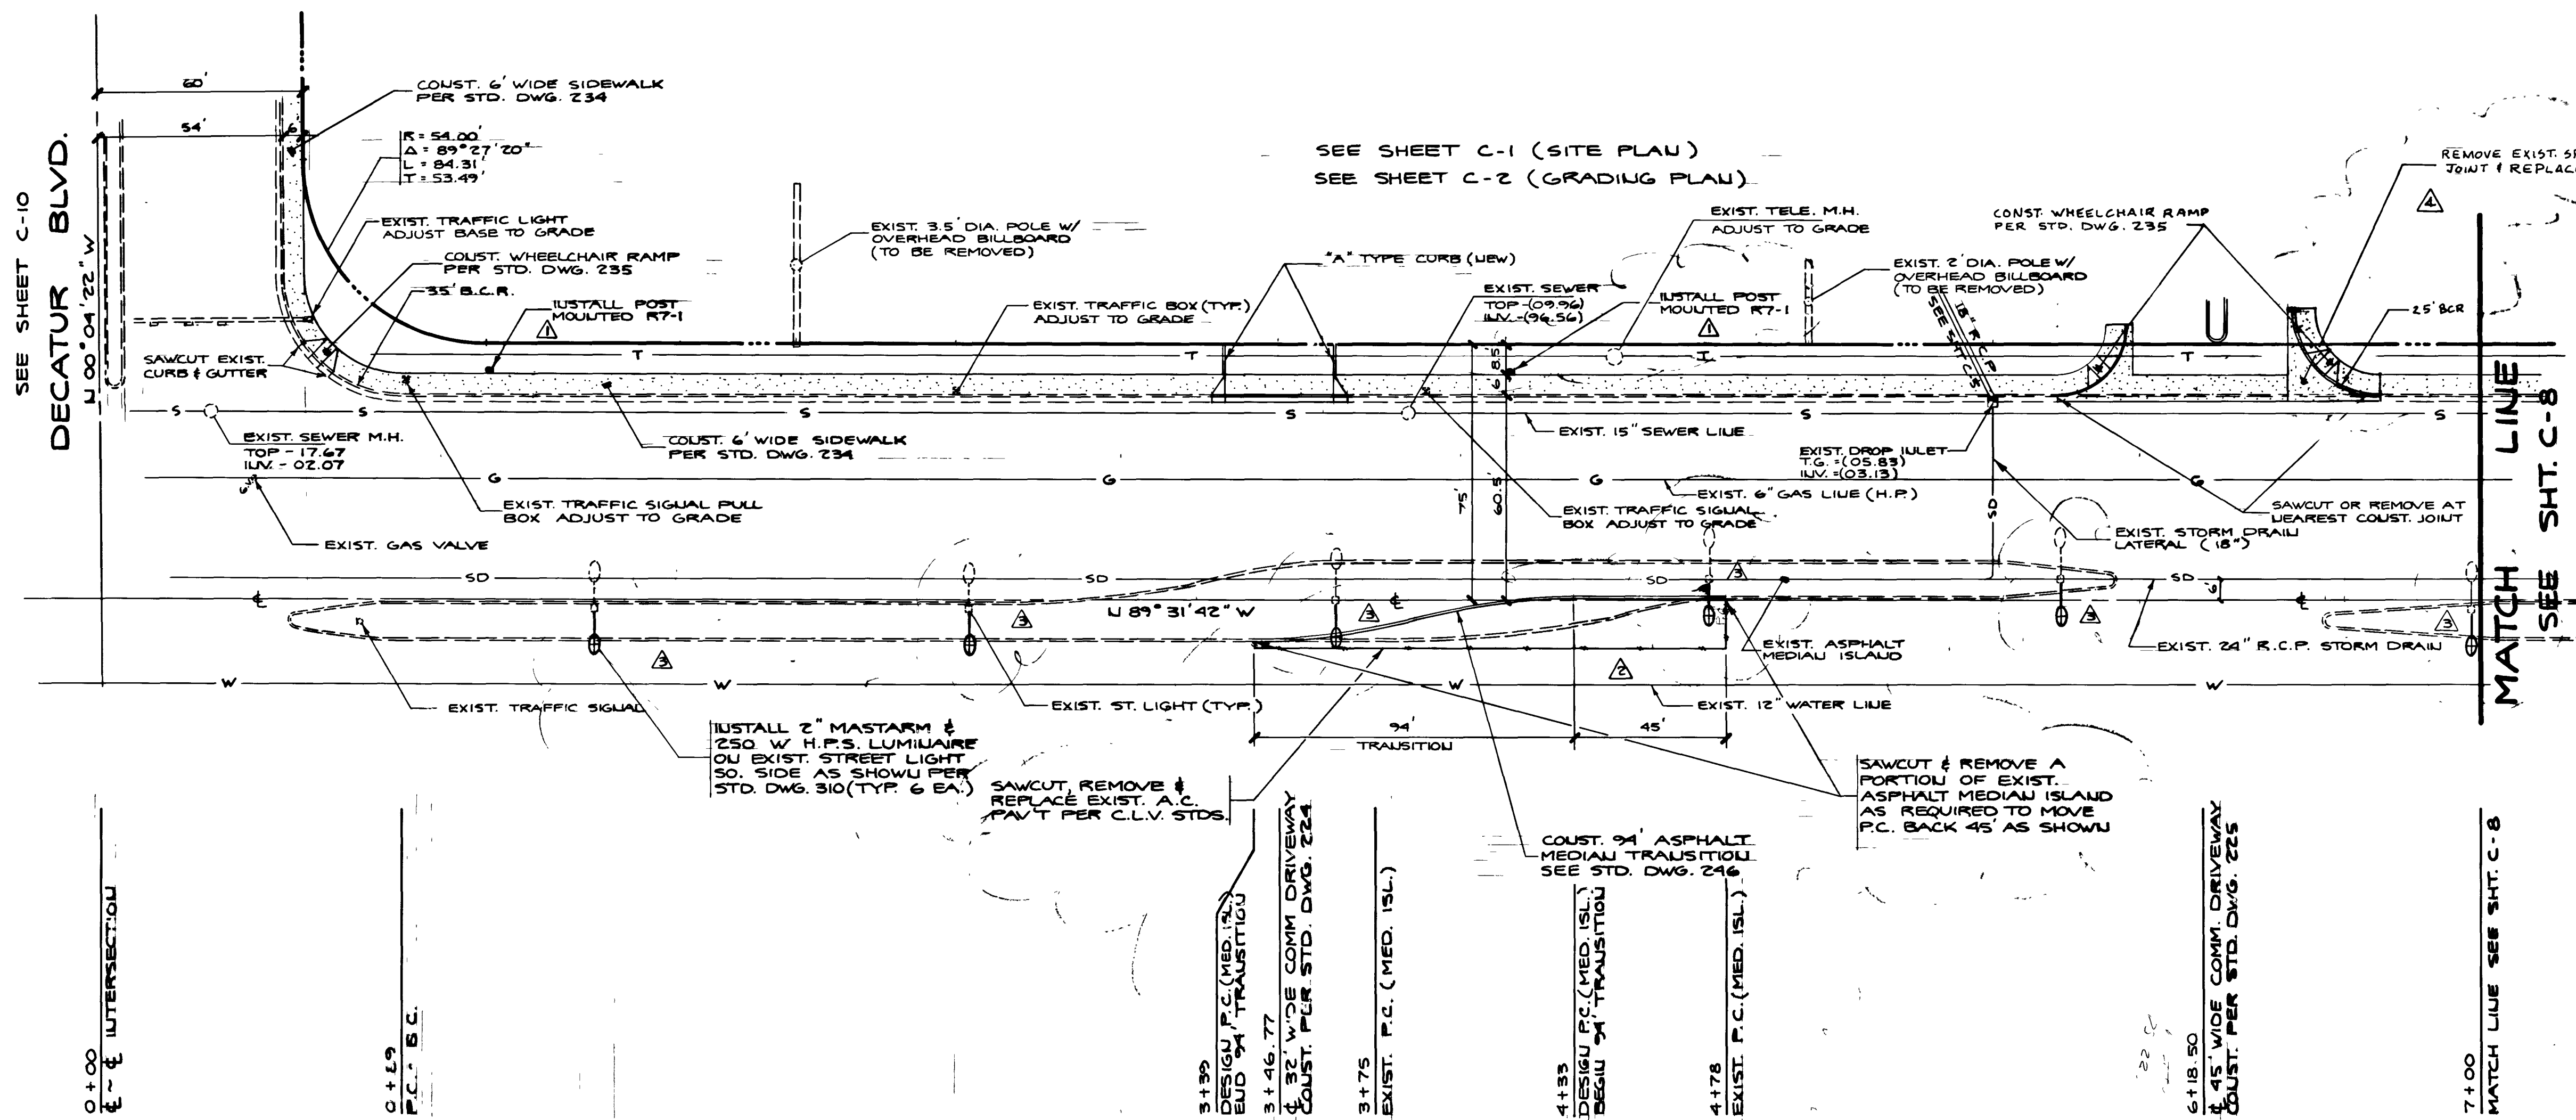

UTILITY NOTE

The location of underground utilities shown hereon has been determined from surface evidence of their existence or from information obtained from the utility companies. The Engineer accepts no liability for the existence or non-existence of utility lines. Contractors and others using these maps must confirm the location of underground lines of structures with the utility companies prior to commencing any excavation.

STREET DESIGN SECTION 6, TOWNSHIP 21 SOUTH, RANGE 4 EAST, M.D.B.M. CITY OF LAS VEGAS, CLARK COUNTY SAHARA AVENUE	BAUGHMAN & TURNER CIVIL ENGINEERS LAND SURVEYORS 2335 WEST CHARLSTON BOULEVARD LAS VEGAS, NEVADA 89102 702-870-1271	MINING ENGINEERS	DATE DEC. 1988	DESIGN D.S.T.	DATE DEC. 1988	REVISIONS	APPROVED
			DRAWN D.S.T.	CHECK R.J.B.	SCALE 1" = 30'	ADDED R7-1'S REVISED MEDIAN ISLAND P.C. & TRANSITION ADDED MASTARMS & LUMINAIRES REMOVE MASTARMS, LUMINAIRES & R7-1'S	DATE NO. 11/1/88

PROJ. NO. 107-11648

