
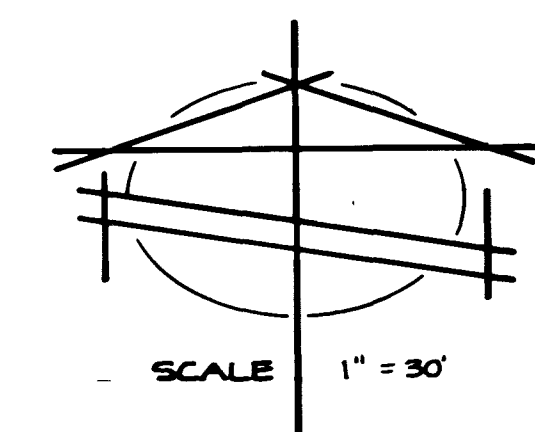


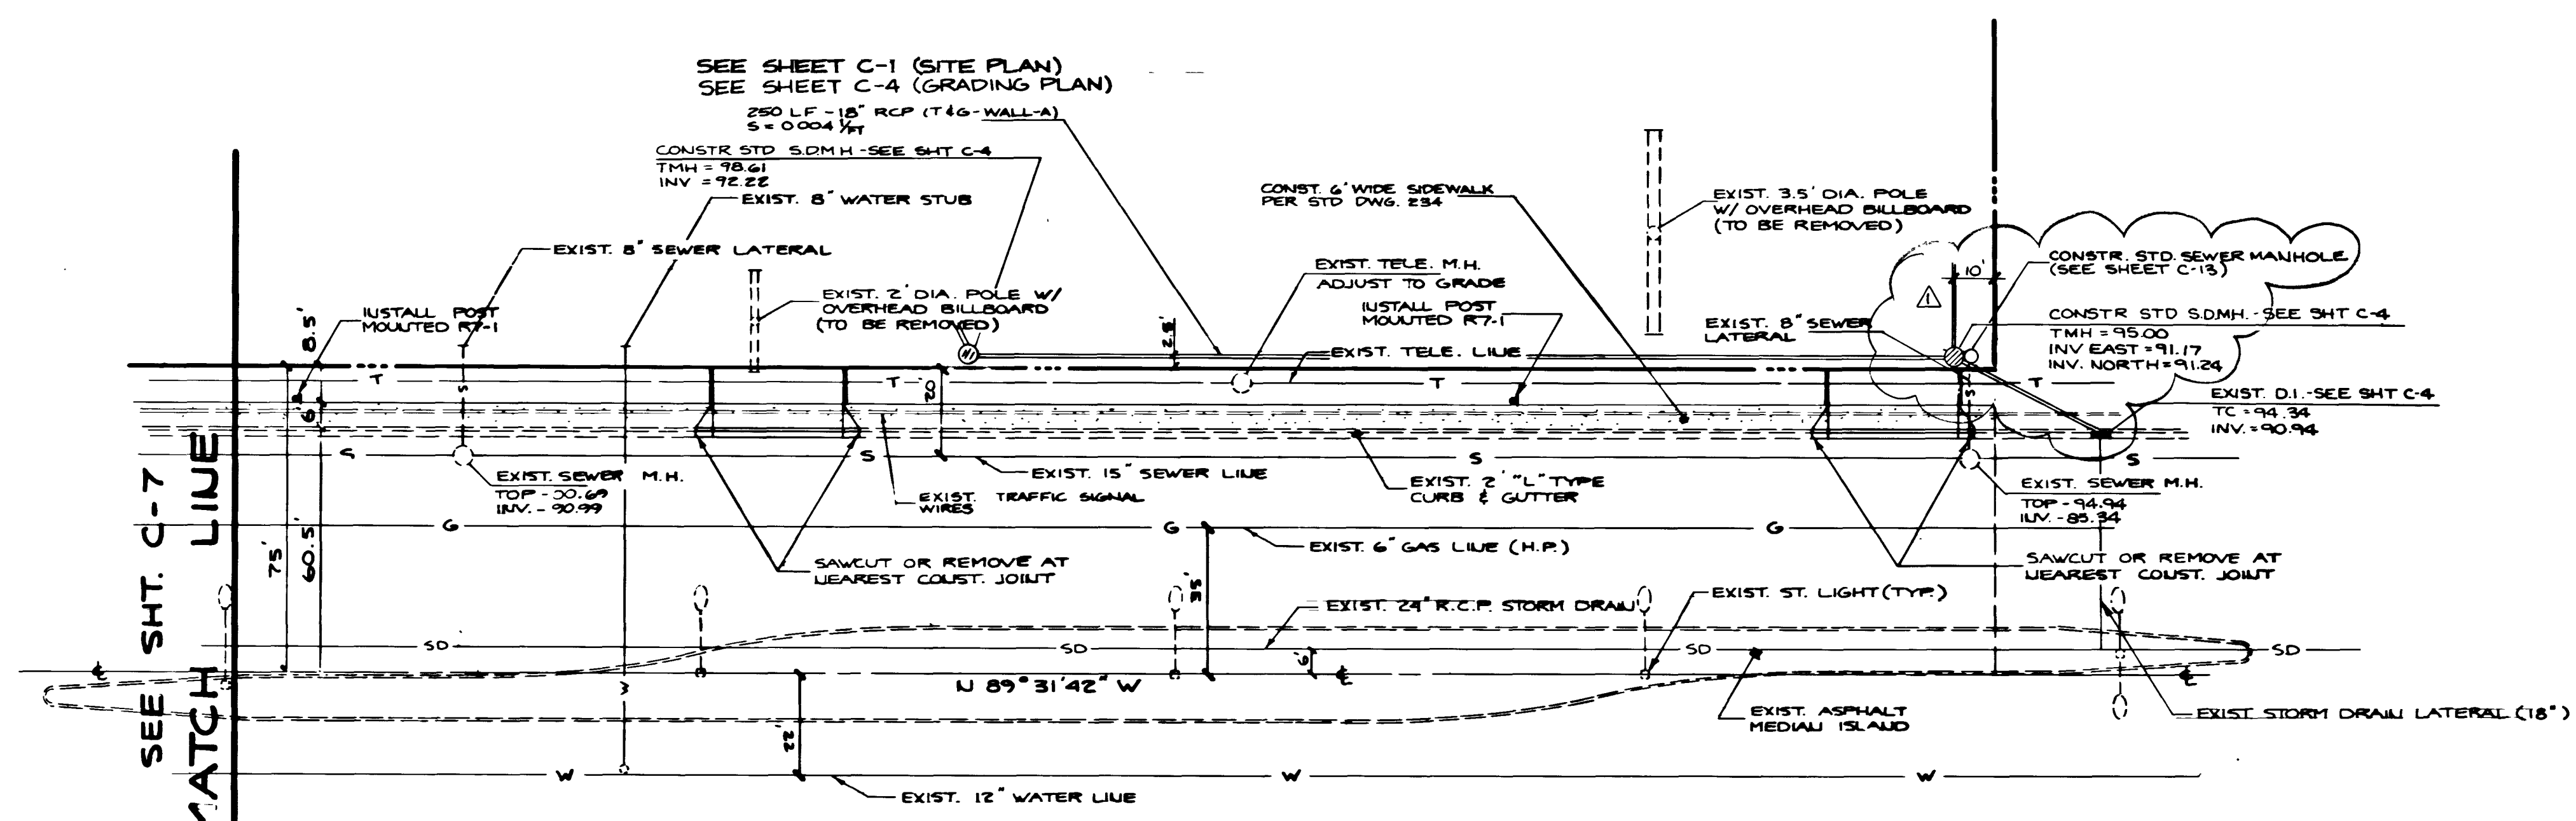

UTILITY NOTE

The location of underground utilities shown hereon has been determined from surface evidence of their existence or from information obtained from the utility companies. The Engineer accepts no liability for the existence or non-existence of utility lines. Contractors and others using this map must confirm the location of underground lines or structures with the utility companies prior to commencing any excavation.

Call before you Dig.
1-800-227-2600
UNDERGROUND SERVICE (USA)

7+00
MATCH LINE SEE SHT. C-7


8+34
32' WIDE COMM. DRIVEWAY
CONST. PER STD DWG. E24

11+09.5
32' WIDE COMM. DRIVEWAY
CONST. PER STD DWG. E24


11+34.1
INTERSECTION

SAHARA

AVENUE

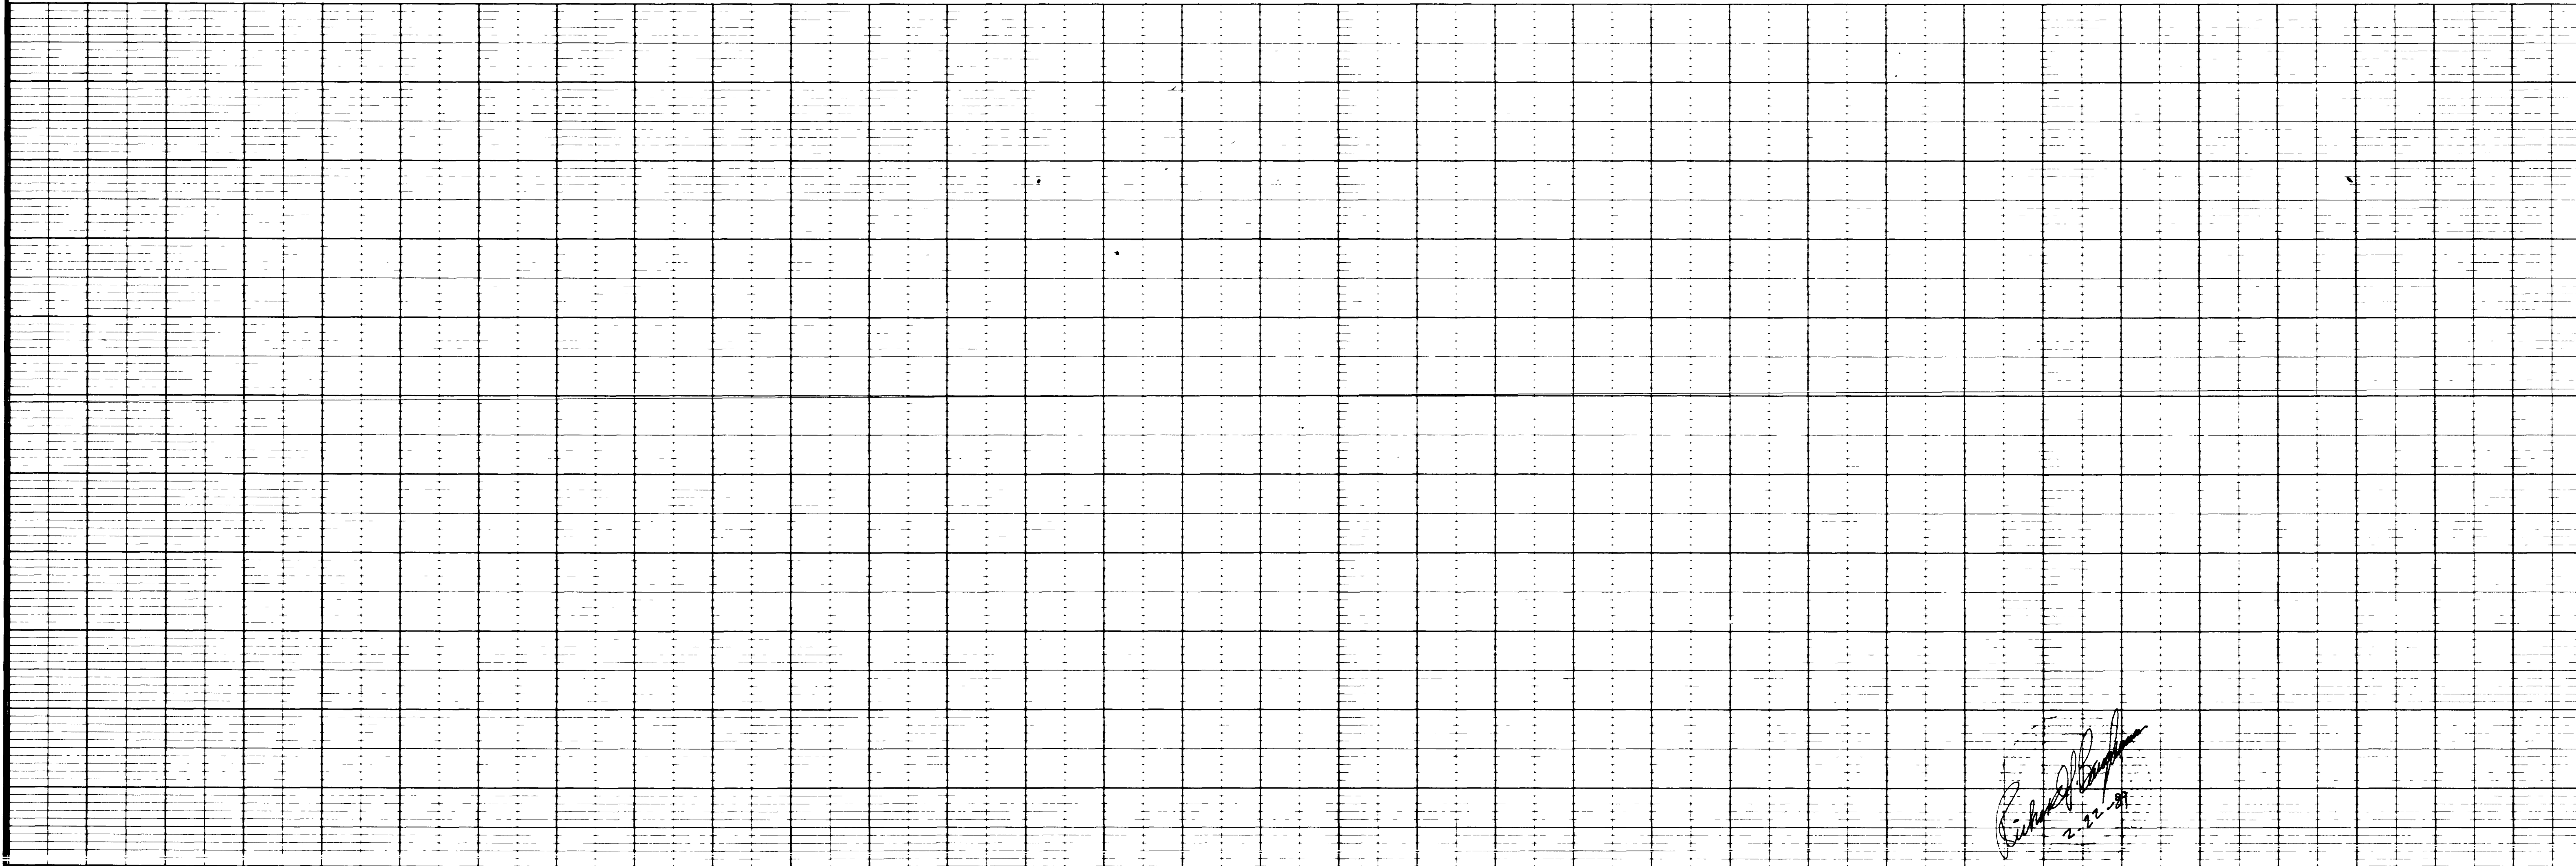

STREET DESIGN	SECTION 4, TOWNSHIP 21 SOUTH, RANGE 41 EAST, M.D.B. & M. CLARK COUNTY, NEVADA SAHARA AVENUE	BAUGHMAN & TURNER CIVIL ENGINEERS LAND SURVEYORS 2335 WEST CHARLESTON BOULEVARD LAS VEGAS, NEVADA 89102 702-270-5771	DATE DEC. 1988 DESIGN G.A.F. DRAWN D.S.T. CHECK R.J.B. SCALE 1" = 30'	PREPARED FOR:	ALLIED DEVELOPMENT CO.
				DATE NO. 1/1/99 REVISED AS SHOWN IN CIRCLED AREA ADDED RT-1'S	REVISIONS

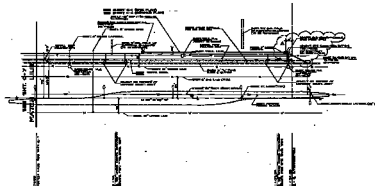

UTILITY NOTE


ALLIED
DEVELOPMENT CO.









