
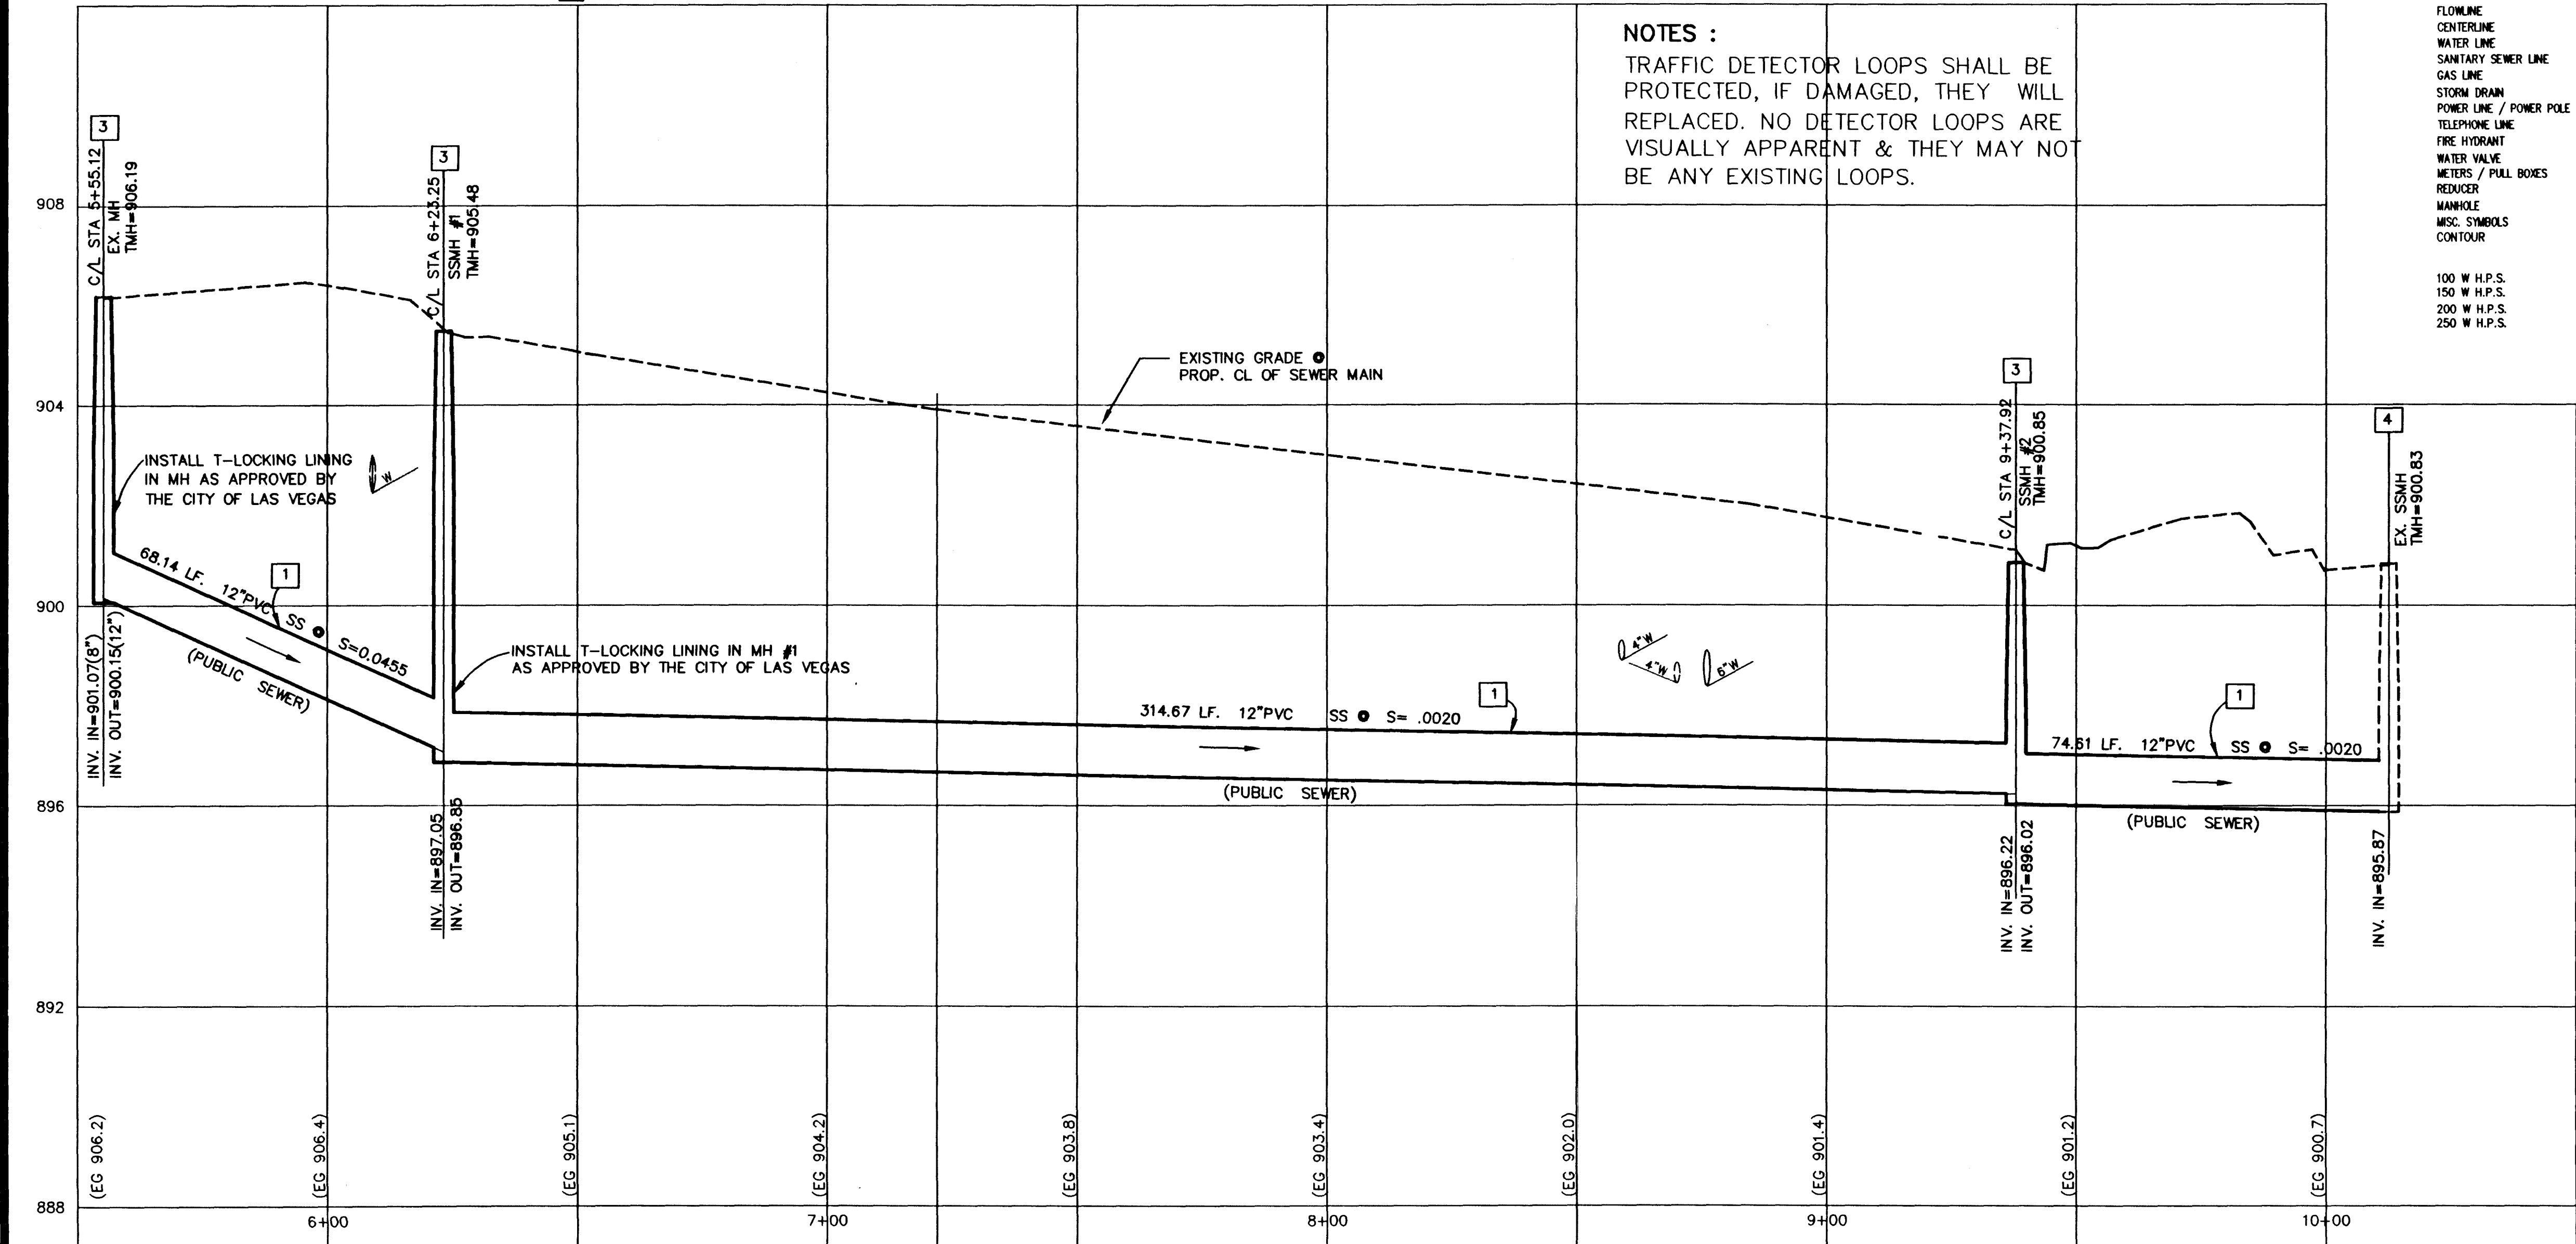


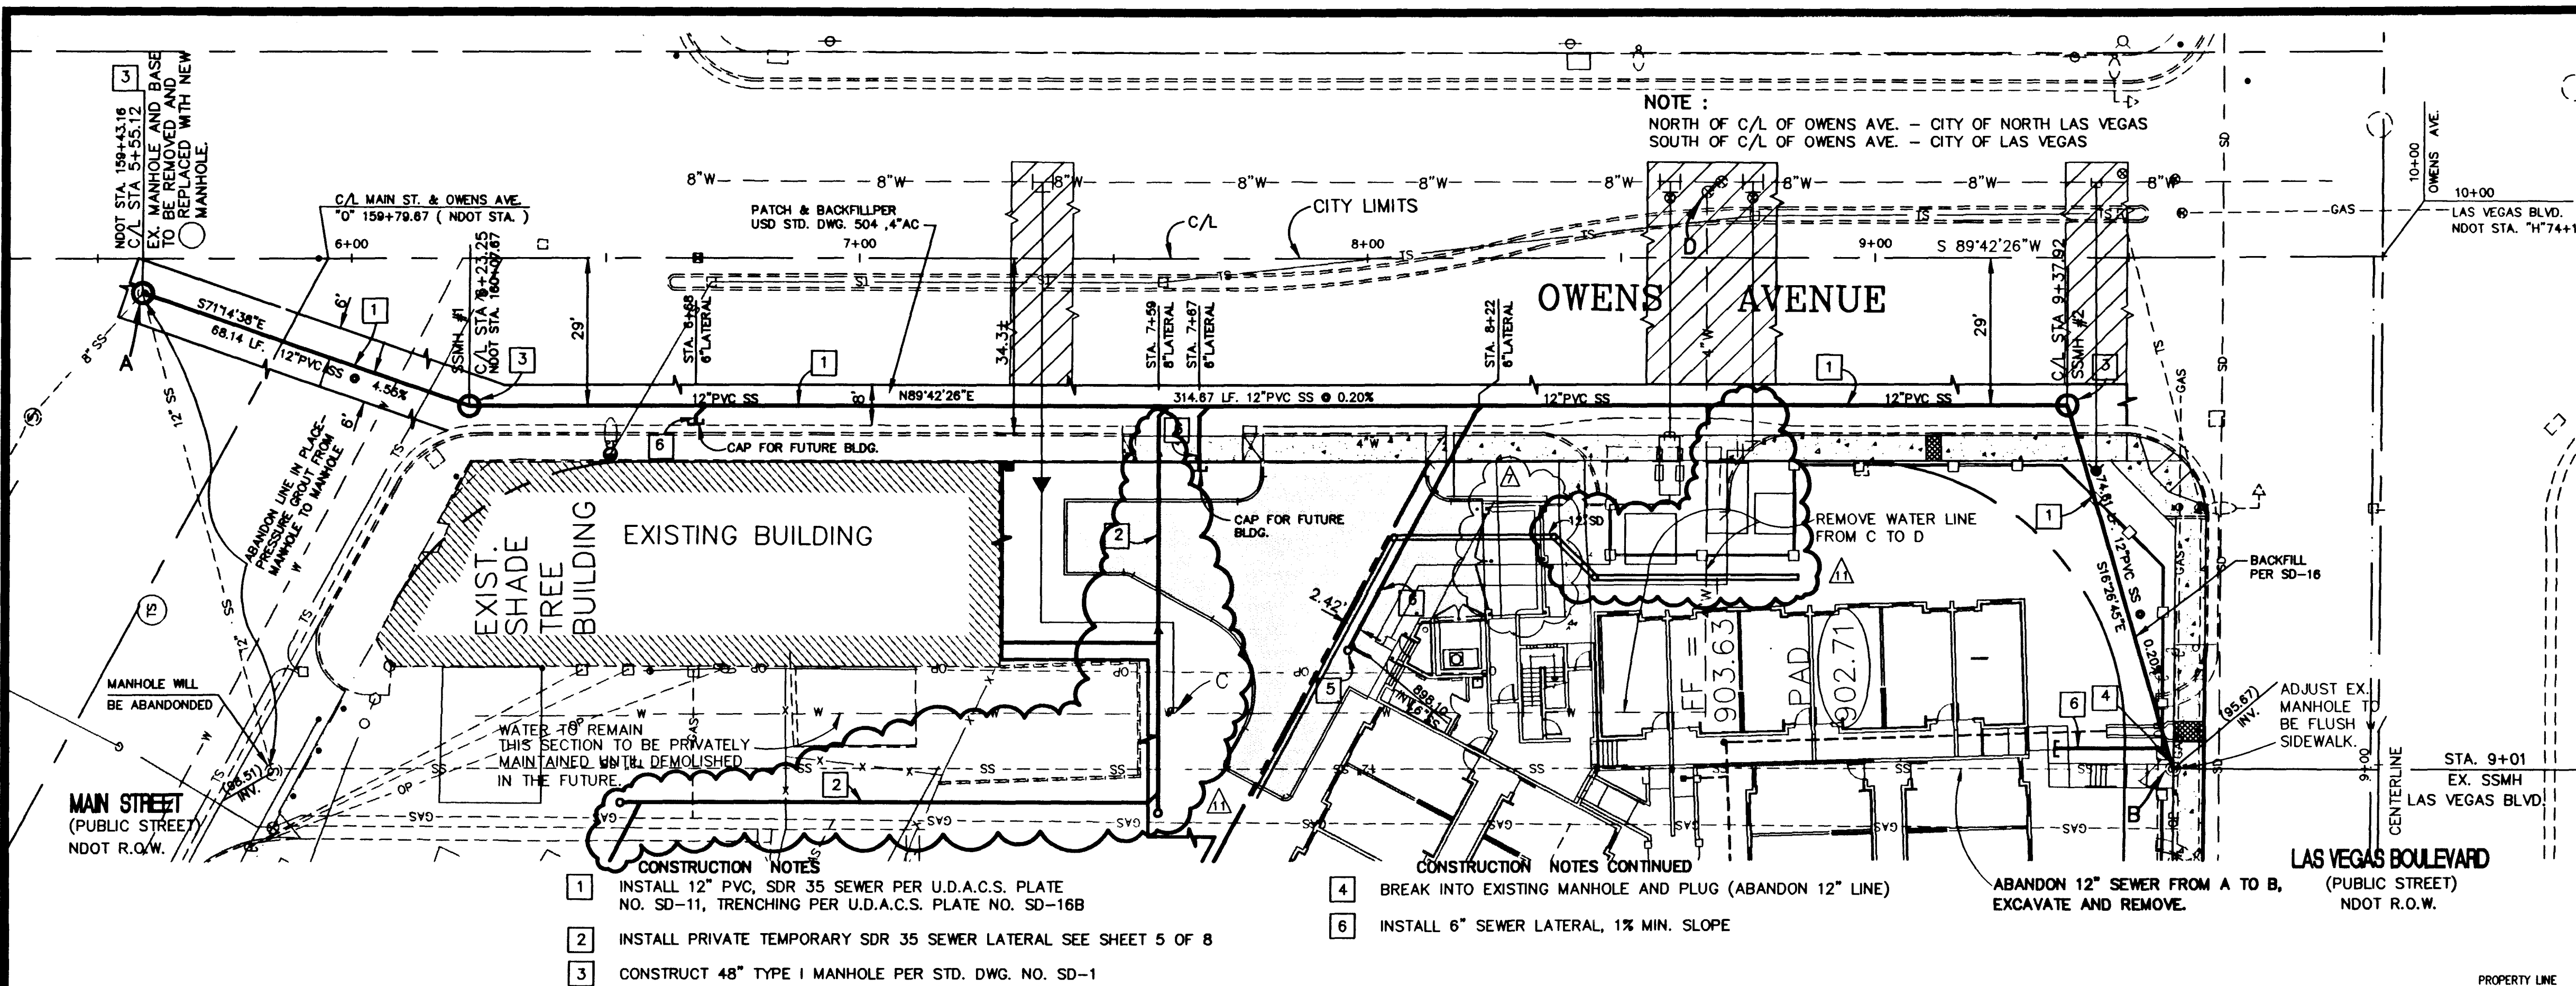

SHEET
SEWER PLAN AND PROFILE
OWENS STREET

TITLE
SAINT VINCENT'S H.E.L.P.
ONE & TWO HOUSING UNITS

DRAWN BY: J. WREY
DESIGNED BY: J. WREY
CHECKED BY: K. ANDERSON
PROJECT NO.: 1609.01

SCALE: 1" = 20' HOR

SEAL
KIRK S. ANDERSON
CIVIL


SHEET
SS1
7 OF 8 SHEETS
C.L.V. DRAWING NO.
107V2848

ST. VINCENT'S HELP.
808 SOUTH MAIN STREET
LAS VEGAS, NEVADA 89101
(702) 385-2662

MARTIN & MARTIN
SUITE B
1909 SOUTH JONES BLVD.
LAS VEGAS, NEVADA 89102
PHONE (702) 248-8000

REVISION

REV	DATE	BY	DESCRIPTION
1	12/16/97	J. WREY	REVISED WATER, TEMP SEWER LATERAL & STORM DRAIN
2	12/16/97	J. WREY	REMOVE PLANTER CURB & ROOF TRELLIS

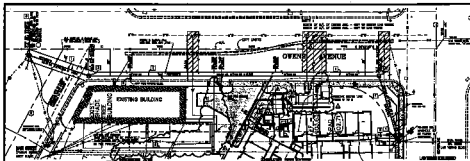







NOTES:


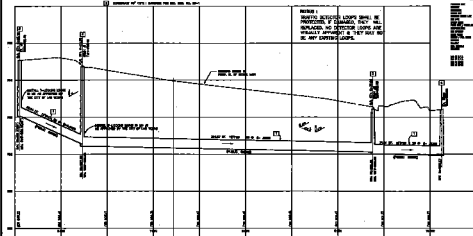

MARTIN & MARTIN




