



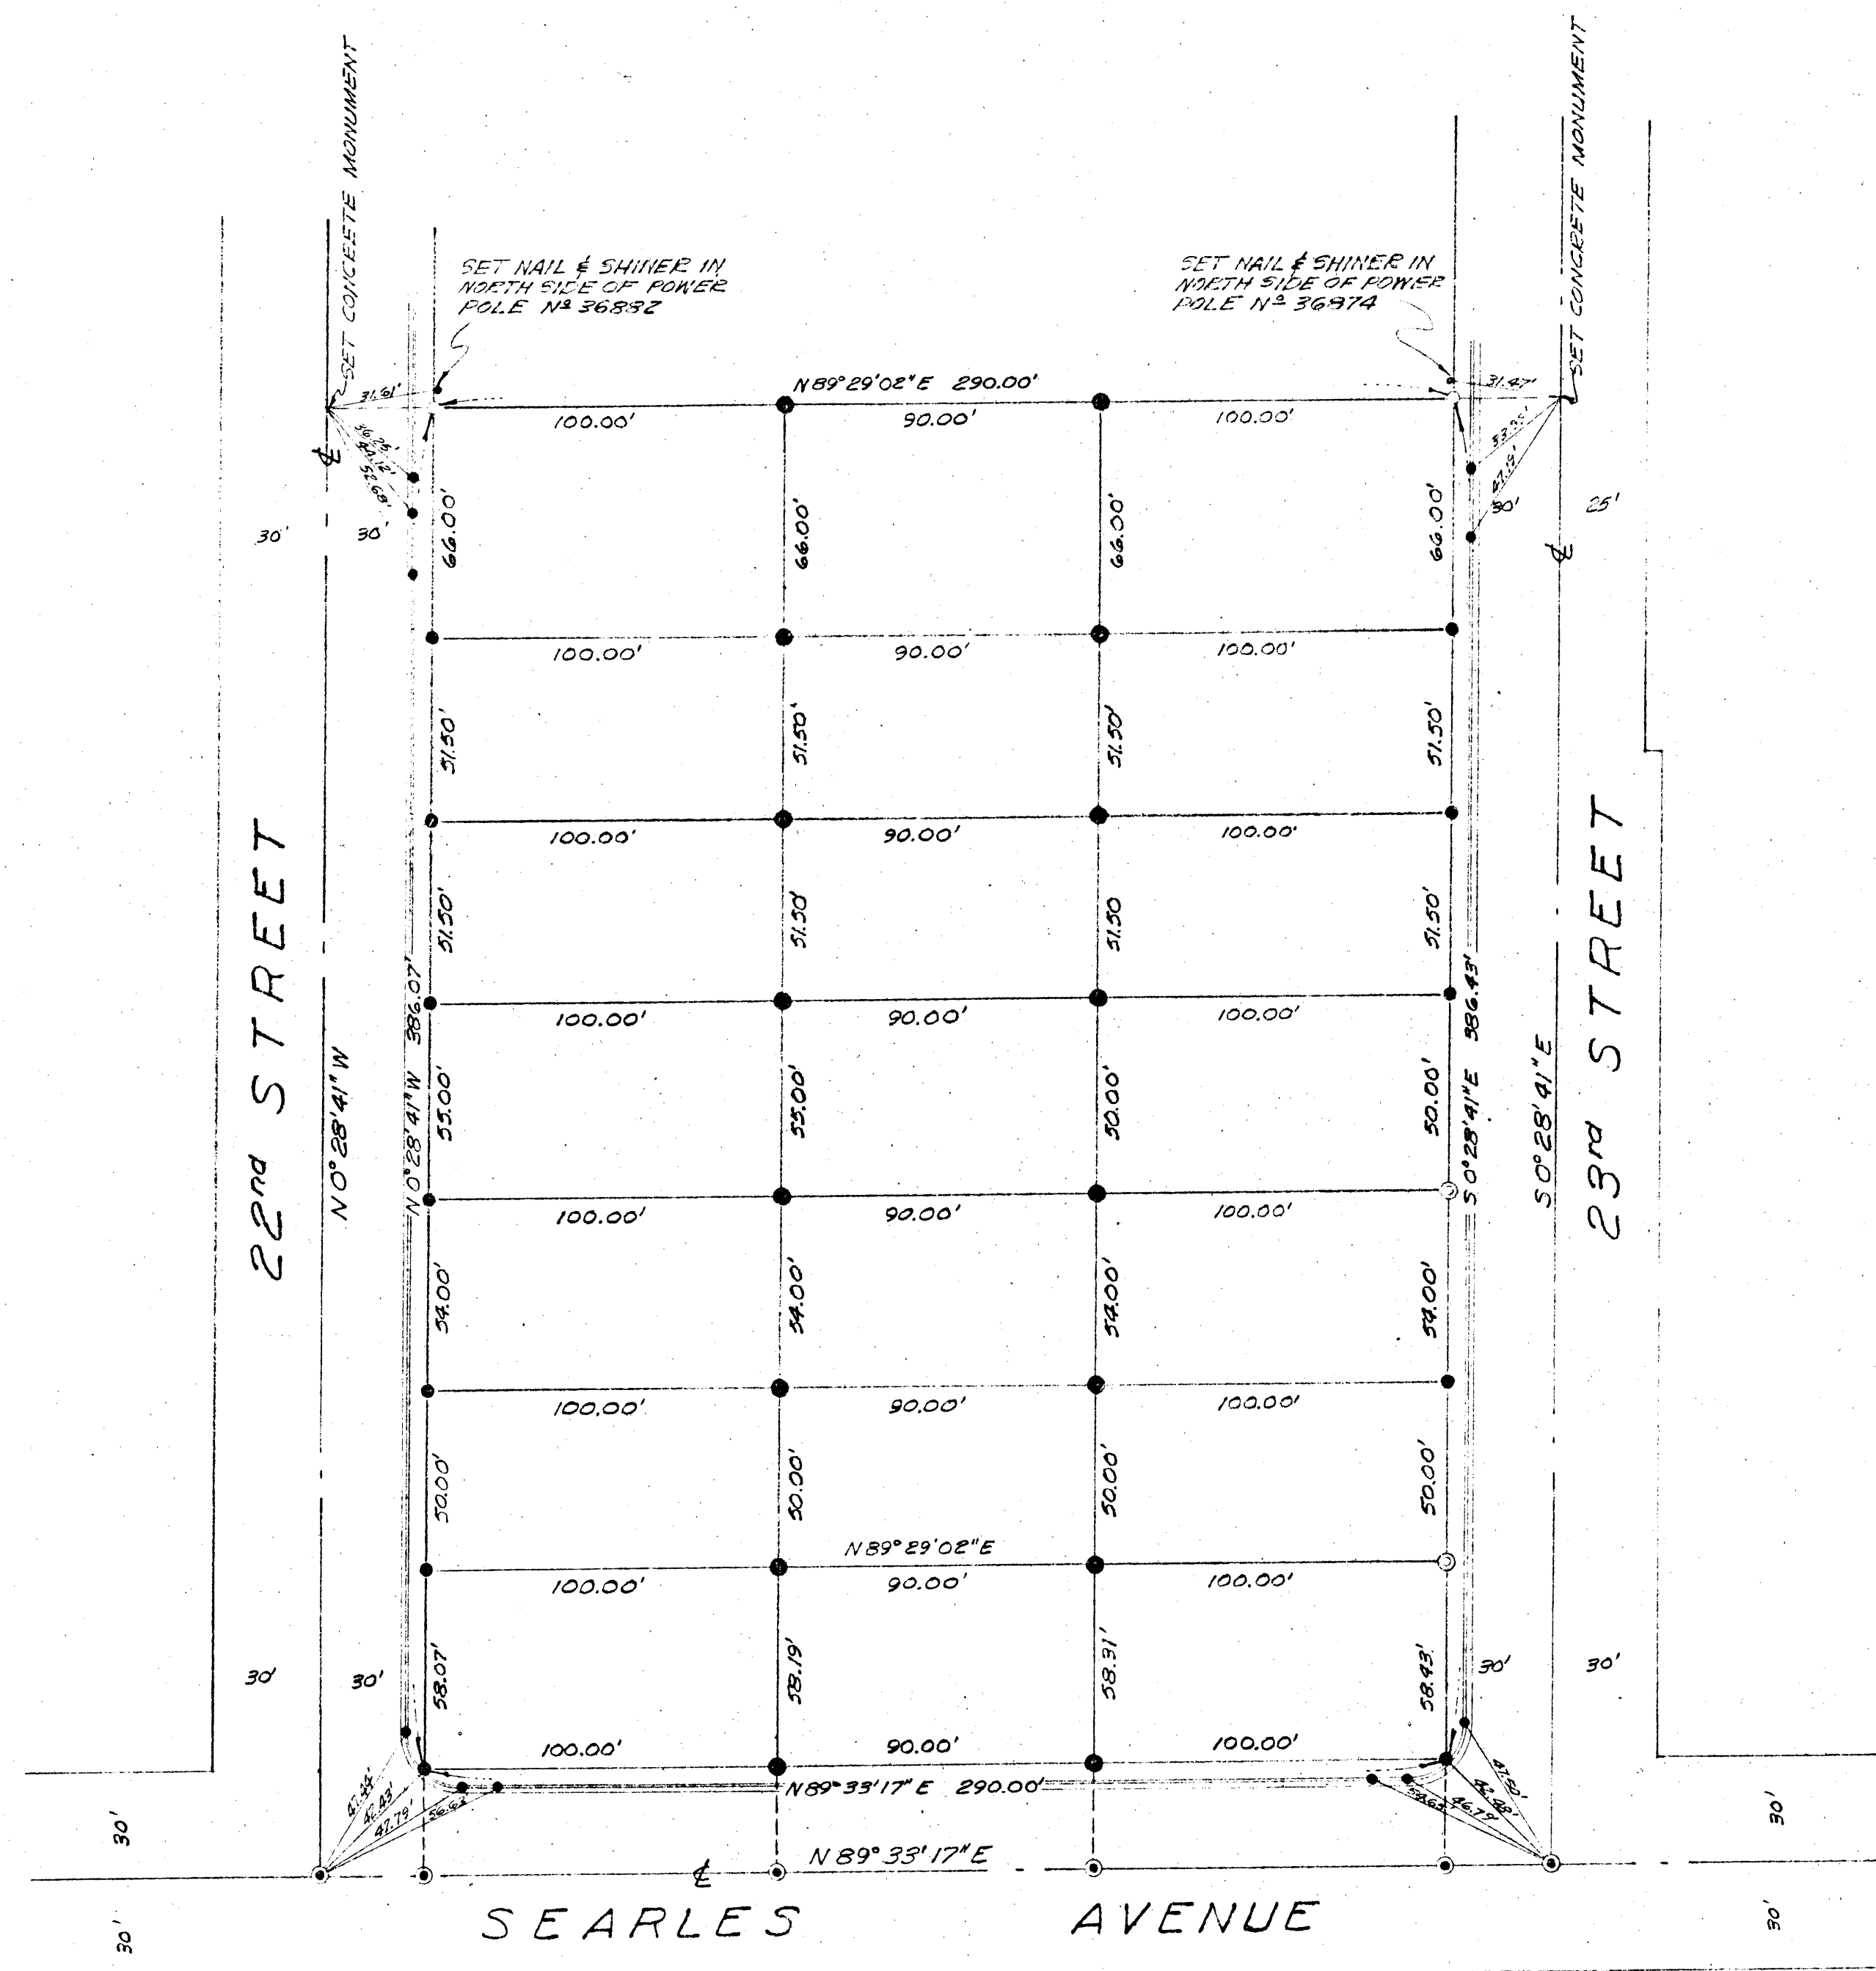

### CERTIFICATE

I, Jack K. Leavitt, registered professional engineer and land surveyor do hereby certify that this map is a true and accurate representation of the lands shown hereon. All points found or set are correctly designated. This survey was completed on June 21, 1963 at the instance of Rankin & May, Builders.

*Jack K. Leavitt*  
**JACK K. LEAVITT**  
 Registered Professional Engineer  
 Land Surveyor R.L.S.807

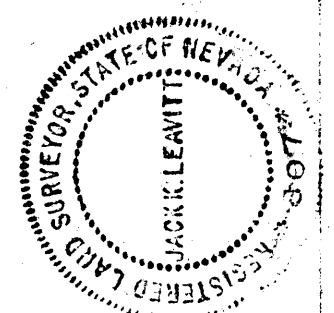


### LEGEND

- Indicates point set - 3/4" iron pipe tagged R.L.S.807
- Indicates point set - 'X' chisled in concrete sidewalk
- ⊙ Indicates point set - 2"x2" hub & tack
- Indicates point set - nail & shiner
- Indicates point set - 8" spike & shiner
- Scale: 1"=40'
- Indicates point set - concrete nail in top of curb

MONUMENT TIE MAP - SEARLES AVE.

SURVEY MAP  
 A PORTION OF NE 1/4 SECTION 26, T.20S,  
 R.61E, M.D.B.#1M, Clark County, Nevada

Surveyed by:  
**JACK K. LEAVITT**  
 Registered Professional Engineer  
 Scale: 1"=40'

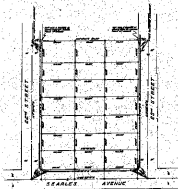










