


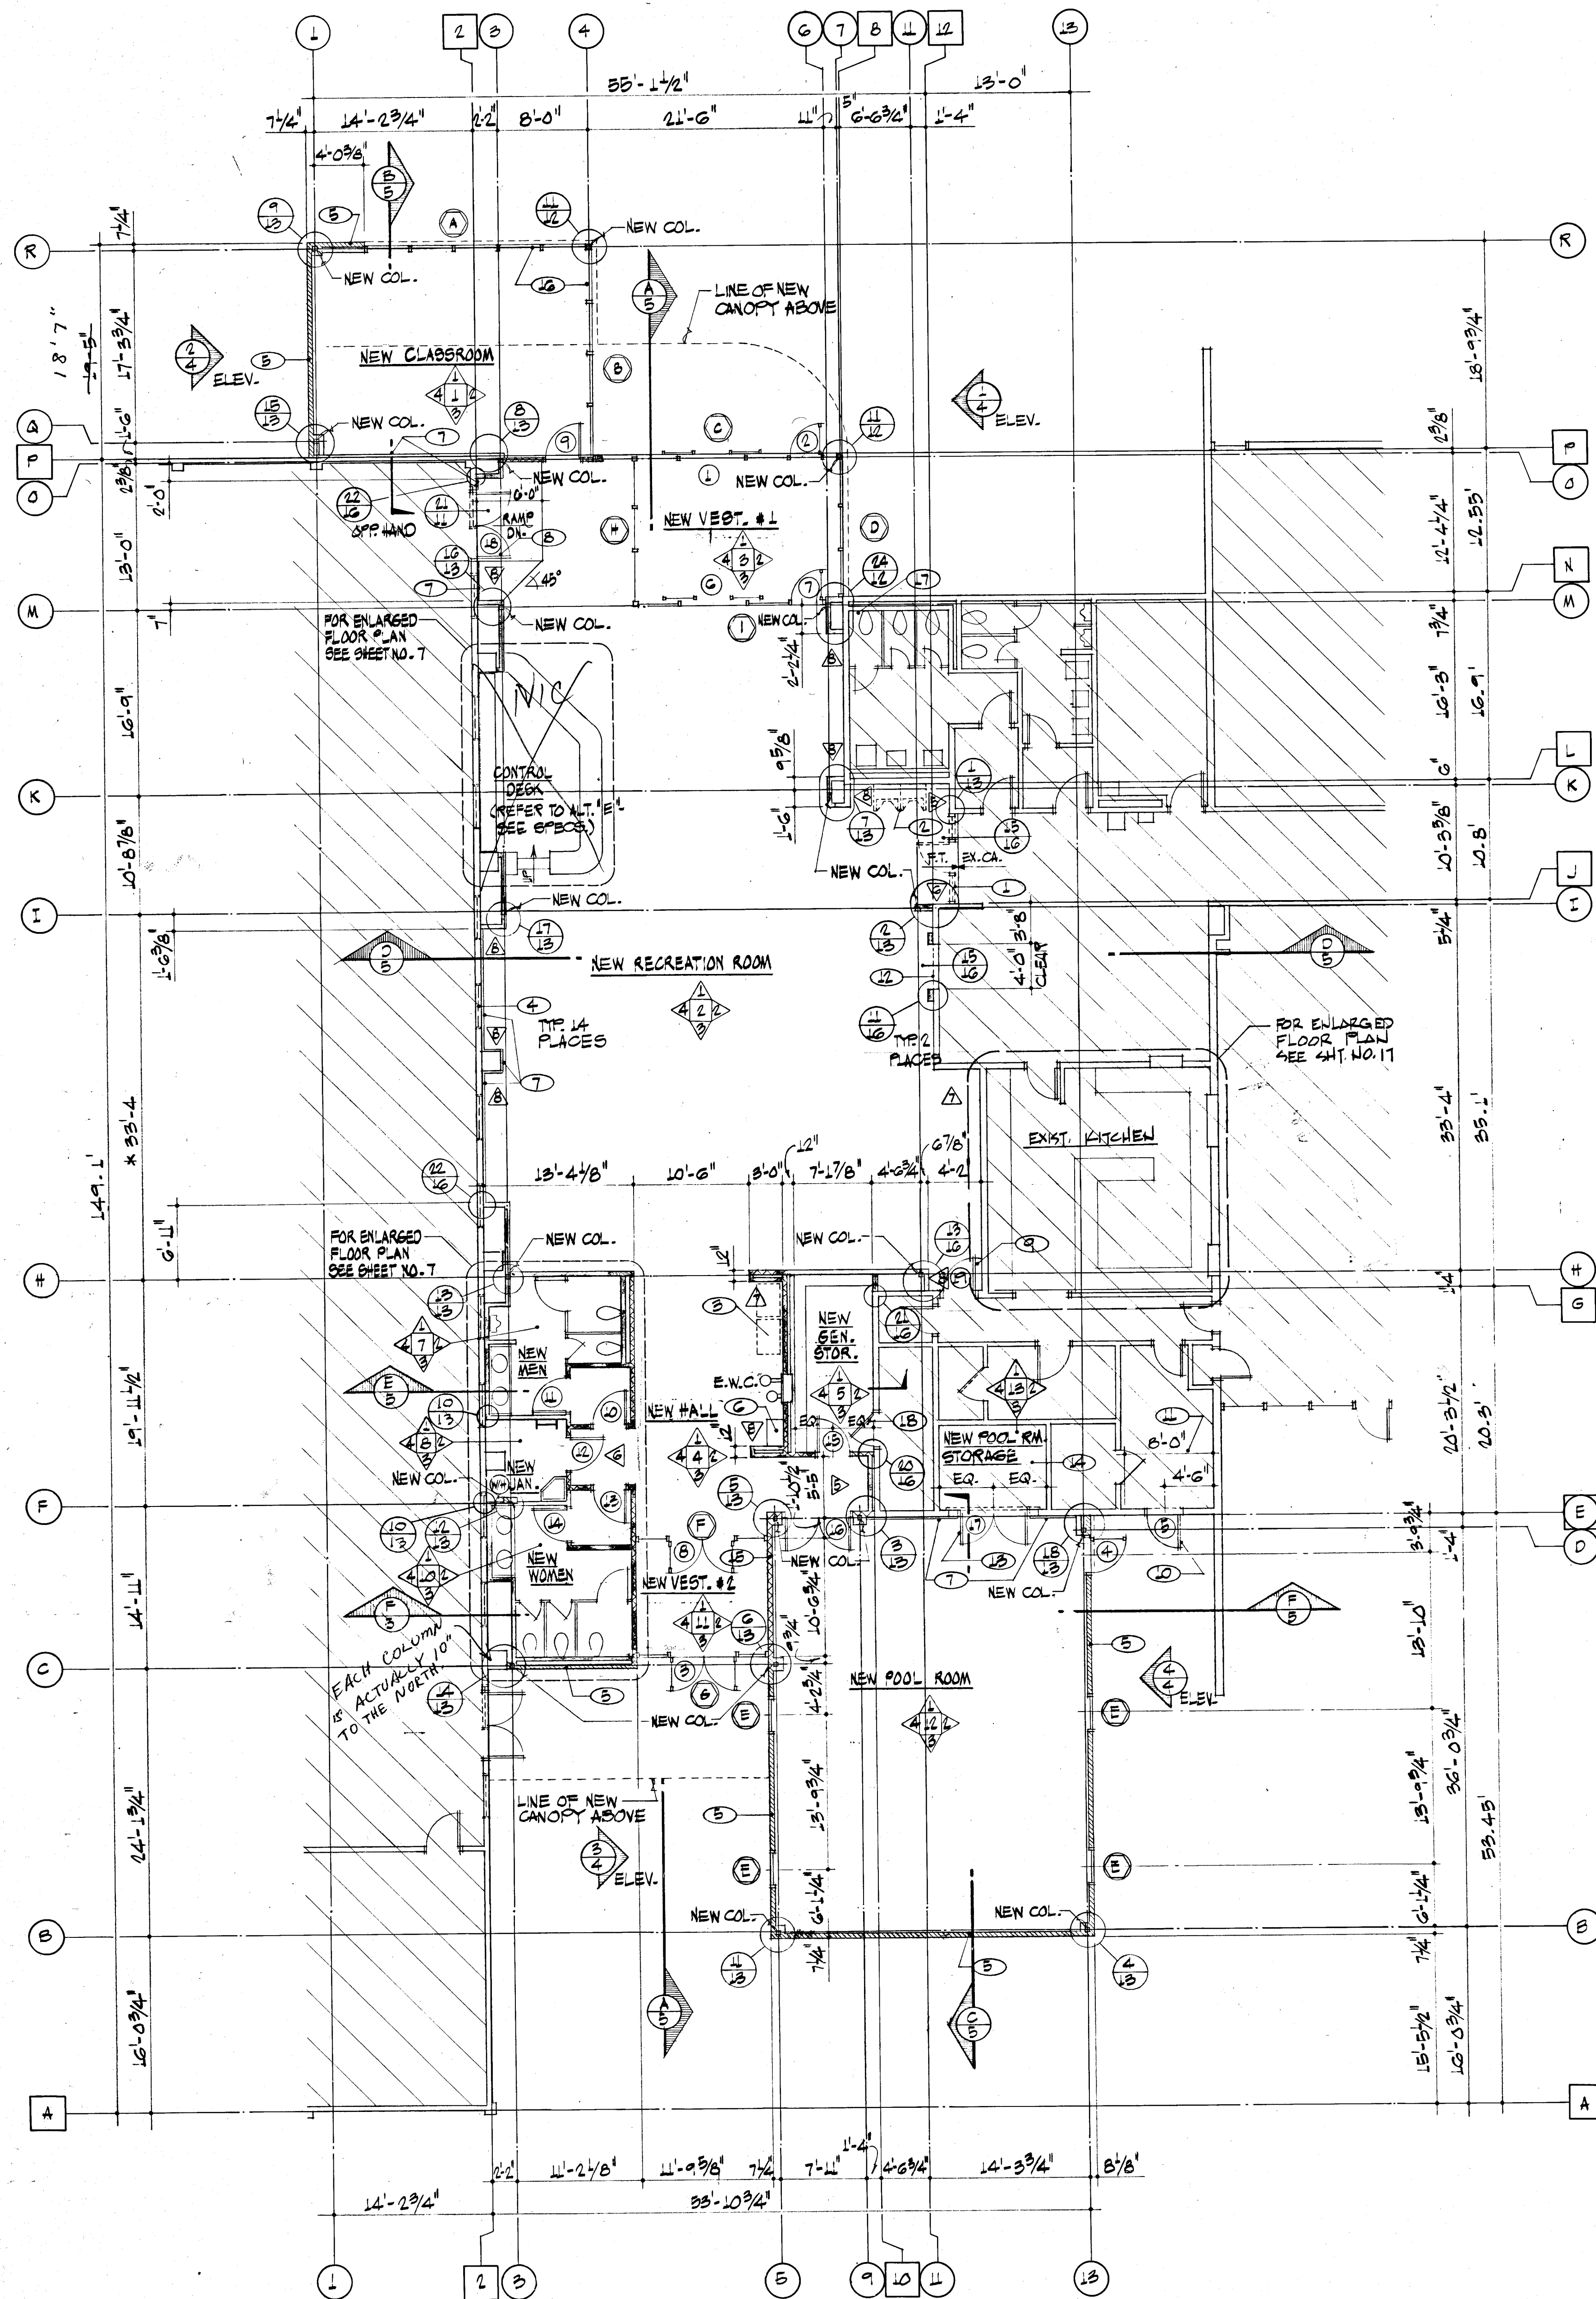


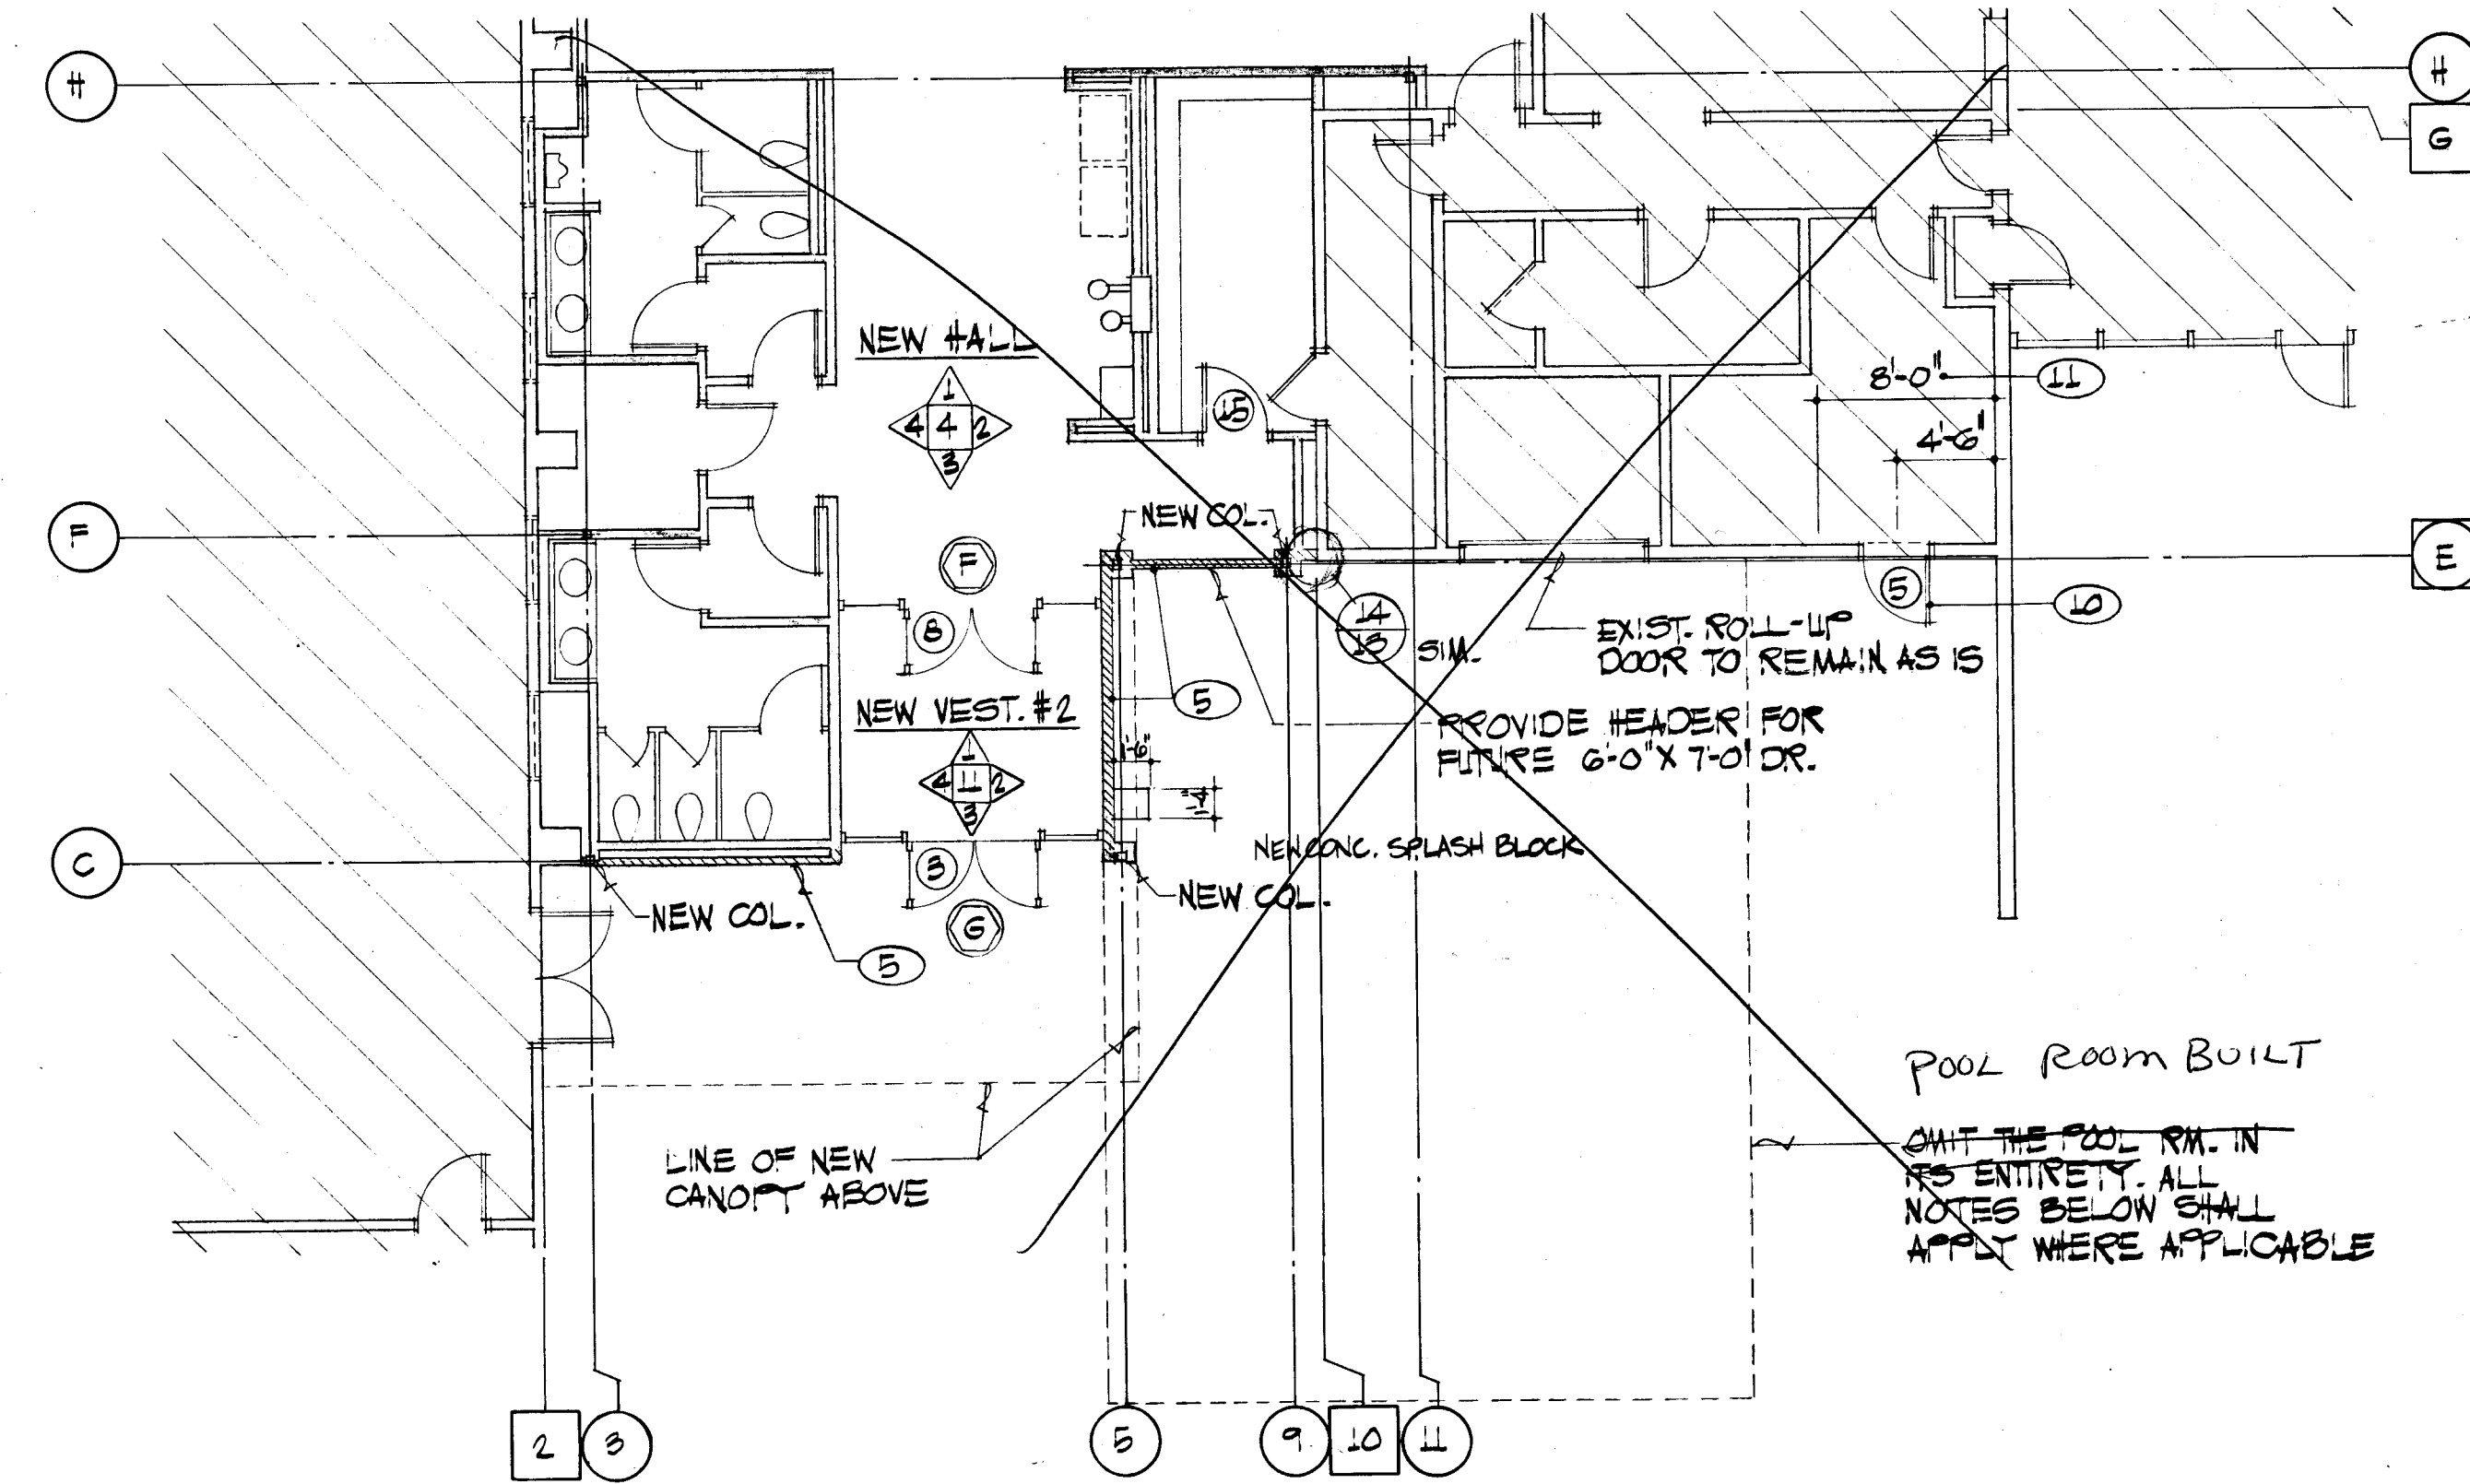

FLOOR PLAN
SCALE 1/8" = 1'-0"

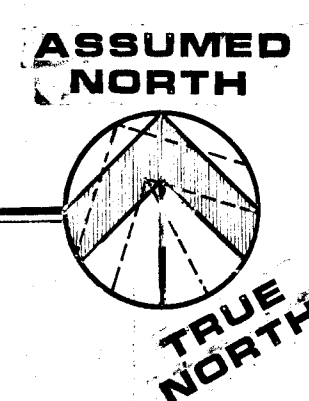

PARTIAL FLOOR PLAN (ALTERNATE G)
SCALE 1/8" = 1'-0"

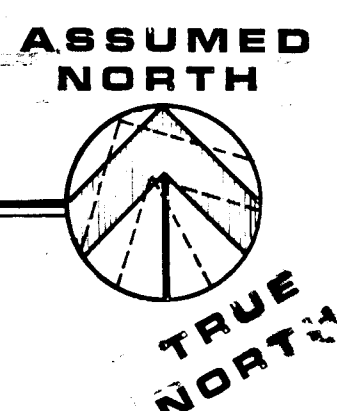

FLOOR PLAN NOTES & LEGEND:

- NEW 16 GA. 4" MT. "C" STUDS @ 16" O.C. W/ 5/8" TYPE "X" GYP. BO. (FLOOR TO ROOF DECK) - INTERIOR & STUCCO (PAINTED) ON WIRE LATH. PAPERBACKED 6/8" EXT. GYP. BO. SHEATHING - EXTERIOR UNLESS OTHERWISE NOTED. REFER TO DET. (15)
 - NEW 3/8" MT. STUDS @ 16" O.C. W/ 5/8" TYPE "X" GYP. BO. (FLOOR TO CLG.) - BOTH SIDES UNLESS OTHERWISE NOTED. REFER TO DET. (15)
 - NEW 3/8" MT. STUDS @ 16" O.C. W/ 5/8" TYPE "X" GYP. BO. (FLOOR TO MT. DECK) - BOTH SIDES UNLESS OTHERWISE NOTED. REFER TO DET. (15)
 - EXIST. WALL TO REMAIN AS IS
- NOTE: PROVIDE 5/8" MOISTURE RESISTANT GYP. BO. & NEW TOILET ROOMS
- NEW DOOR NUMBER - SEE DOOR SCHED.
 - NEW WINDOW NUMBER - SEE WINDOW ELEVATIONS
 - ROOM WALL INDICATOR - SEE ROOM FINISH SCHED. & INTERIOR WALL ELEVATIONS
 - BUILDING SECTION - SEE SHT. NO. 5
 - NEW COLUMN LINE
 - FACE OF EXIST. BLDG. LINE
 - EXTERIOR ELEVATION NUMBER - SEE SHT. NO. 4
- REMOVE EXIST. DOOR, WINDOWS & FRAME
 - FUTURE TELEPHONE BOOTHS BY OWNER
 - VENDING MACHINES (N.I.C.)
 - REMOVE EXIST. WINDOW & FRAME. CLOSE UP OPENING W/ NEW MASONRY WALL - PAINTED BOTH SIDES - SEE DETAIL (16) TYP. AT 14 PLACES
 - NEW 3/4" BATT INSULATION (R-11 MIN) F.L.R. TO ROOF DECK - SEE SPECS.
 - NEW SIGN - IN POOLRM - SEE DET. (16) REFER TO ALT. "E" - SEE SPECS.
 - NEW 5/8" TYPE "X" GYP. BO. 0/7/8" FLOORING CHANNELS @ 12" O.C.
 - REMOVE EXIST. METAL DOOR & FRAME & PROV. NEW METAL DOOR & MT. FRAME - SEE DOOR SCHED.
 - REMOVE EXIST. MT. DOOR & INSTALL NEW NO. DOOR - SEE DOOR SCHED. RE-USE EXIST. DOOR FRAME & HARDWARE
 - REMOVE EXIST. WALL AS REQ'D FOR INSTALLATION OF NEW MT. DOOR & FRAME - SEE DOOR SCHED.
 - REMOVE EXIST. GYP. BO. ON WALL AS INDICATED FOR INSTALLATION OF NEW DOOR - PROVIDE NEW GYP. BO. W/ TEXTURE TO MATCH EXISTING. PAINT ENTIRE WALL FLOOR TO CEILING & PROV. NEW RUBBER BASE TO MATCH EXISTING
 - REMOVE EXIST. WALL AS INDICATED - WALL TO REMAIN & COLUMN DELETED
 - REMOVE EXIST. ROLL-UP DOOR & FRAME AS REQ'D FOR INSTALLATION OF NEW PAIR OF NO. DOORS & MT. FRAME - SEE DOOR SCHED. DELIVER TO CITY TAXI BLDG. AT 3100 E. BONANZA CHUCK MALL PROV. NEW CONC. SLAB & RUBBER BASE - SEE DETAIL (16)
 - 16 GA. 4" MT. "C" STUDS @ 16" O.C. (HERE ONLY)
 - NEW VERTICAL LOUVERED BLINDS - F.L.R. TO CLG. @ WINDOWS (A) & (B) ONLY - SEE SPECS. COLOR AS SELECTED BY ARCHITECT. (REFER TO ALT. "A" - SEE SPECS.)
 - REMOVE EXIST. CERAMIC TILE & GYP. BO. AS REQ'D FOR INSTALLATION OF NEW GAS LINE & RELOCATION OF ROOF DRAIN LEADER. REPLACE GYP. BO. & CERAMIC TILE TO MATCH EXIST.
 - EXIST. MT. DOOR & FRAME TO REMAIN (PAINTED) - COLOR AS SELECTED BY ARCHITECT.
- CONTRACTOR SHALL AVOID ANY UNNECESSARY OBSTRUCTIONS TO THE FUNCTIONS AND/OR DAILY ACTIVITIES OF THE EXIST. BUILDINGS
 - THE GENERAL CONTRACTOR SHALL INCLUDE IN HIS BID THE SUM OF \$ 1,250.00 (NINETEEN HUNDRED EIGHTY DOLLARS & ZERO CENTS) FOR WORK & MATERIAL PROVIDED BY ALARMCO FOR EXPANSION OF EXIST. SECURITY ALARM SYSTEM AS SHOWN ON SHEET E-3. FOR FURTHER DETAILS, CONTACT CHUCK EMERY AT ALARMCO. TEL. NO. 282-5000.
 - CONTRACTOR SHALL VERIFY ALL DIMENSIONS IN THE FIELD.
 - ALL DIMENSIONS ARE TO FACE OF STUD UNLESS OTHERWISE NOTED.
 - CONTRACTOR SHALL PROVIDE A TEMPORARY SELF-SUPPORTING 8'-0" HIGH PLANK BARRICADE A DISTANCE OF 5'-0" FROM ALL NEW CONSTRUCTION WORK AREAS. PARTICULAR ATTENTION SHALL BE PAID TO THE EXIST. SENIOR CITIZENS CENTER WEST ENTRANCE W/ LEADS TO THE EXIST. HALLWAY & SNACK AREA & TO THE TWO PAIR OF DOORS ON THE EAST SIDE OF THE EXIST. DULA CENTER.

FIRE PROOFING TABLE

MEMBER	THICKNESS	HOURLY RATING	ILL. DESIGN #
4" TUBE STEEL COLUMN	1/4" THK.	1 HOUR	X 752
MT. DECK	1/4" THK.	1 HOUR	P 701
OPEN WEB JOIST	1/8" W/ LATH - SEE SPECS.	1 HOUR	P 701
BEAM	1/8" THK.	1 HOUR	P 701
BRIQUING	1/8" THK.	1 HOUR	P 701
TUBE STEEL COL. & FRAMING (MONITOR WINDOW)	1/4" THK.	1 HOUR	X 752

4-5
All fees, designs, arrangements and plans indicated, or presented by this drawing, are the property of CAMBEIRO & CAMBEIRO LTD. The use of these plans and specifications without the written consent of CAMBEIRO & CAMBEIRO LTD. 

REVISIONS
DATE
JULY 07, 1983
DRAWN
JAO R.
CHECKED
C. J. 12
DO NOT SCALE DRAWINGS

CAMBEIRO & CAMBEIRO LTD.
ARCHITECTS
INSTITUTE OF ARCHITECTS
MEMBERS OF THE AMERICAN INSTITUTE OF ARCHITECTS
ARTURO B. CAMBEIRO A.I.A.
DOMINGO CAMBEIRO A.I.A.
LAS VEGAS, NEVADA

PROJECT NO.
002203
SHEET NO.
32
OF 32

513-46J