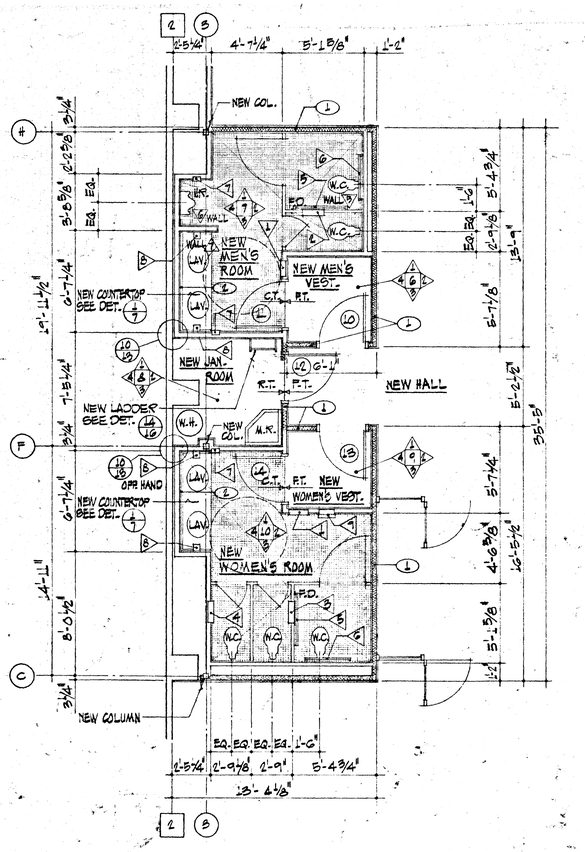

BATHROOM ACCESSORY LEGEND:

1. BEMI - RECESSED WALL MOUNTED STAINLESS STEEL SATIN FINISH PAPER TOWEL DISPENSER AND 8" DEEP TRASH RECEPTACLE - 12 GALLON CAPACITY
2. PARTITION MOUNTED STAINLESS STEEL SATIN FINISH TOILET SEAT COVER DISPENSER, ROLL TOILET TISSUE DISPENSER. ASH TRAY SERVES TWO COMPARTMENTS, MOUNT FLUSH FOR HANDICAP COMPARTMENT
3. PARTITION MOUNTED STAINLESS STEEL SATIN FINISH TOILET SEAT COVER DISPENSER, NAPKIN DISPOSAL, ROLL TOILET TISSUE DISPENSER. SERVES TWO COMPARTMENTS, MOUNT FLUSH FOR HANDICAP COMPARTMENT
4. RECESSED WALL MOUNT STAINLESS STEEL SATIN FINISH TOILET SEAT COVER DISPENSER, NAPKIN DISPOSAL, ROLL TOILET TISSUE DISPENSER, SERVES ONE COMPARTMENT
5. HANDICAP GRAB - BAR 1 1/2" x 8'-0" CONCEALED MOUNTING WITH TEXTURED GRIP SATIN FINISH AT ENDS AND COVER PLATES
6. HANDICAP GRAB - BAR 1 1/2" x 3'-0" CONCEALED MOUNTING WITH TEXTURED GRIP SATIN FINISH AT ENDS AND COVER PLATES
7. ASH URN
8. LIQUID SOAP DISPENSER - SEE SPECS.
9. FEMININE NAPKIN - TAMPON DISPENSER

NOTE: FOR MOUNTING HEIGHTS OF BATHROOM ACCESSORIES, SEE INTERIOR ELEVATIONS SHEET NO. 8 & 9

BATHROOM FLOOR PLAN NOTES:

1. SOUND ATTENUATION BLANKET - FLOOR TO ~~CEILING~~ ROOF DECK - SEE SPECS.
2. 1/4" MIRROR W/ ALUM. J-MOULD FRAME - GLUED TO GYP. BD.

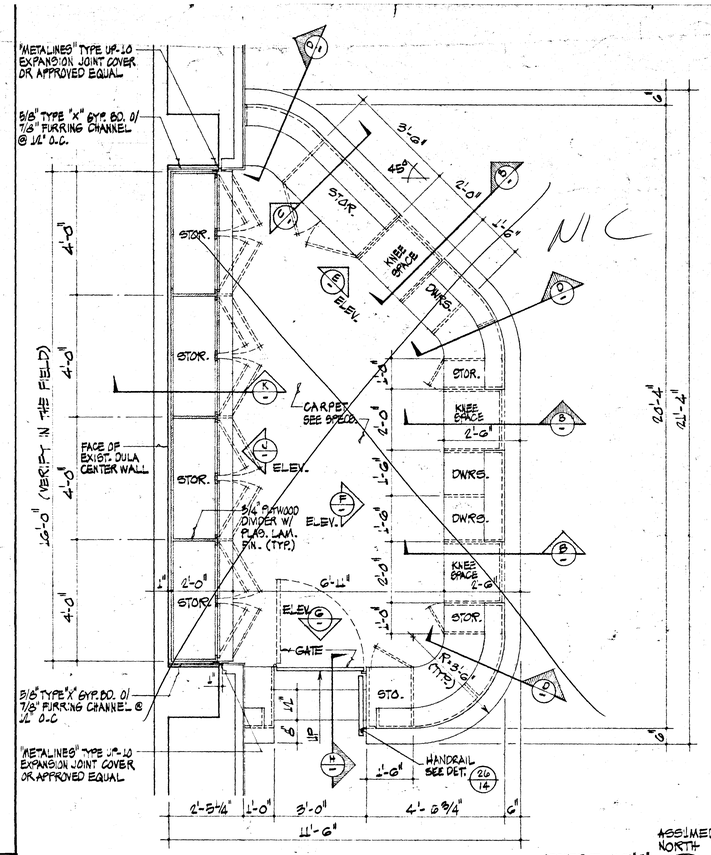

CONTROL DESK NOTES:

1. ALL EXPOSED SURFACES TO RECEIVE PLASTIC LAMINATE FINISH - COLOR AS SELECTED BY ARCHITECT.
2. ALL DOORS & DRAWER FACES TO BE 3/4" PLYWOOD
3. ALL FACE FRAMES TO BE 3/4" HARDWOOD.
4. ALL DRAWERS TO HAVE "KNAPE & VOGT" NO. 1300 DRAWER GUIDES
5. ALL DRAWERS & DOORS TO HAVE "KNAPE & VOGT" NO. 822 ALUM. PULL
6. USE "KNAPE & VOGT" NO. 255 MOUNTING STANDARD & NO. 256 SUPPORTS FOR SHELVES.
7. ALL LOCKS TO BE "NATIONAL LOCK" 68-106
8. ALL DOORS TO HAVE "NATIONAL LOCK" 822-LA SPRING LOADED, SELF CLOSING HINGES
9. GATE BY CABINET MAKER: 1 1/2" THK. SOLID WOOD W/ PLASTIC LAMINATE FINISH ON ALL SIDES. STORS TO BE 3 1/4" X 1 1/2" HARDWOOD W/ PLASTIC LAMINATE FINISH. GATE TO HAVE CONTINUOUS HINGE "KNAPE & VOGT" NO. 1497 & SECRET GATE LATCH "KNAPE & VOGT" NO. 989.

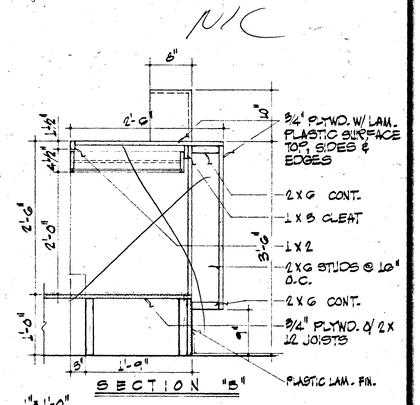

SECTION "B"

ENLARGED PARTIAL FLOOR PLAN
1/4" = 1'-0"

ENLARGED CONTROL DESK PLAN (REFER TO ALT. "E" SEE SPECS.)
1/2" = 1'-0"

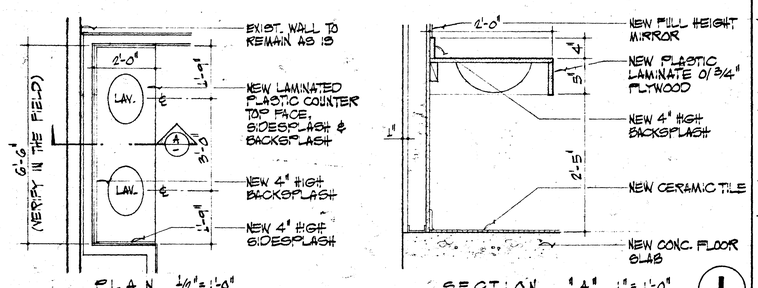

PLAN 1/2" = 1'-0"

SECTION "A" 1" = 1'-0"

NEW COUNTERTOP

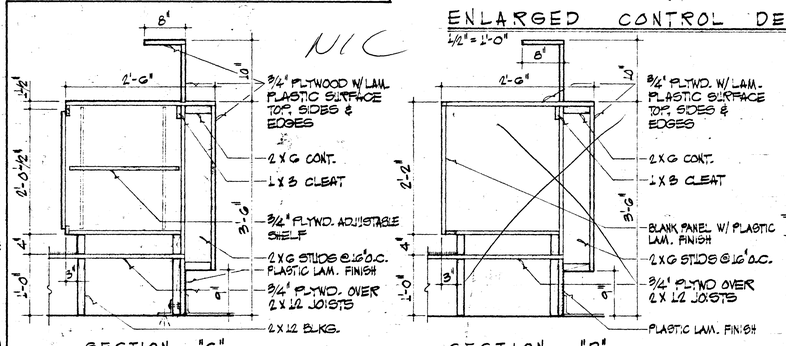

SECTION "C" 1" = 1'-0"

SECTION "D" 1" = 1'-0"

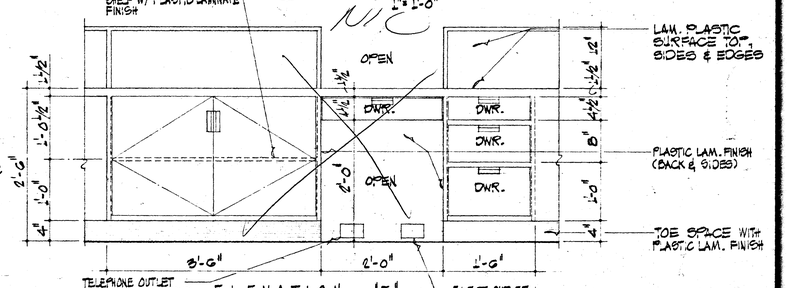

ELEVATION "E" 1" = 1'-0"

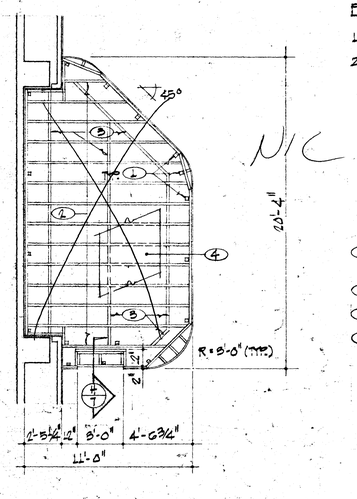

PLATFORM FRAMING PLAN NOTES:

1. ALL WOOD TO BE FIRE TREATED.
2. PLYWOOD SUBFLOOR TO BE GLUED (BF GOODRICH CONSTRUCTION & SUBFLOOR ADHESIVE OR APPROVED EQUAL) & SCREWED @ 12" O.C. - REFER TO MANUFACTURERS RECOMMENDATIONS.

1. "SIMPSON" #L33 HEAVY ANGLE REDHEAD INTO CONC. SLAB - SEE DET. 23/16
2. 2 X 12 FLR. JOISTS @ 16" O.C.
3. 2 X 12 WD. BLKG.
4. 3/4" TONGUE AND GROOVE PLYWOOD FLOORING - SEE NOTE 2 ABOVE

DELETED

CONTROL DESK PLATFORM FRMG. PLAN
1/4" = 1'-0"

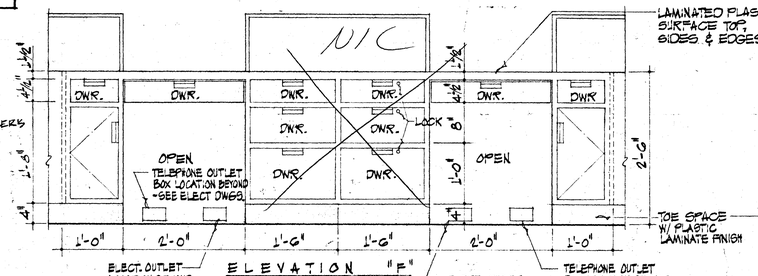

ELEVATION "F" 1" = 1'-0"

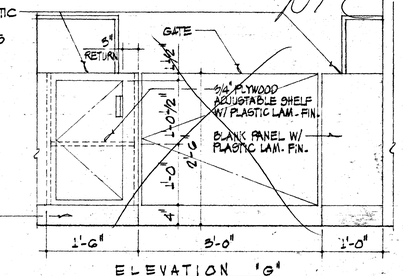

ELEVATION "G" 1" = 1'-0"

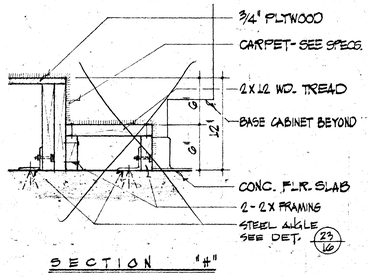

SECTION "H" 1 1/2" = 1'-0"

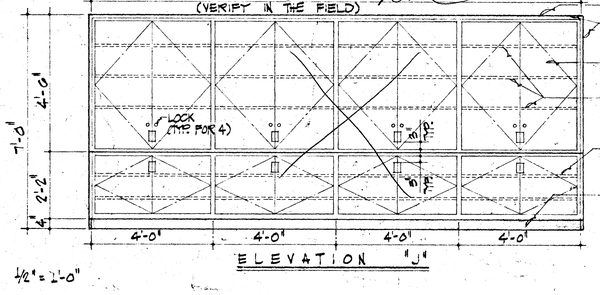

ELEVATION "J" 1/2" = 1'-0"

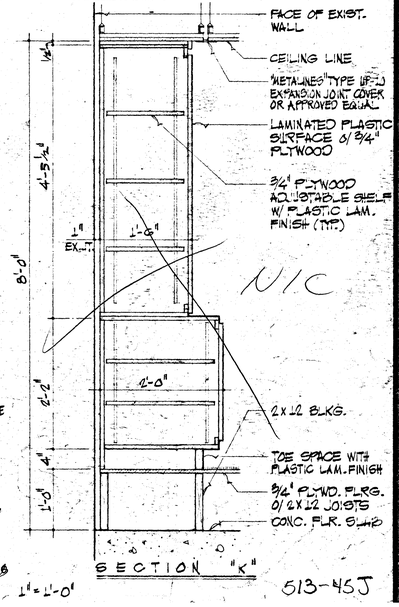

SECTION "K" 1" = 1'-0"

513-45J

All ideas, designs, arrangements and plans indicated, or presented by this drawing, are instruments of service, are owned by and the property of CAMBEIRO & CAMBEIRO LTD. The use of these plans and of specifications shall be restricted to the original site for which they were prepared, and publication thereof is expressly limited to such use. Reproduction, publication or reuse by any method, in whole or in part, is prohibited. None of such ideas, designs, arrangements or plans shall be used by or disclosed to any person, firm, agency, or corporate entity for any purpose whatsoever without the express written permission of the owner. Visitors with these plans and specifications shall constitute prima facie evidence of acceptance of these restrictions.

REVISIONS
RE-ISSUED 5-9-86

DATE JULY 07, 1983
DRAWN JAO R.
CHECKED J.D.C.

DO NOT SCALE DRAWINGS

CAMBEIRO & CAMBEIRO LTD.
ARCHITECTS PLANNERS
MEMBERS OF THE AMERICAN INSTITUTE OF ARCHITECTS
ARTURO B. CAMBEIRO A.I.A. DOMINGO CAMBEIRO A.I.A.
LAS VEGAS NEVADA

PROJECT NO. 8322013
SHEET NO. 7 OF 19 OF 27