
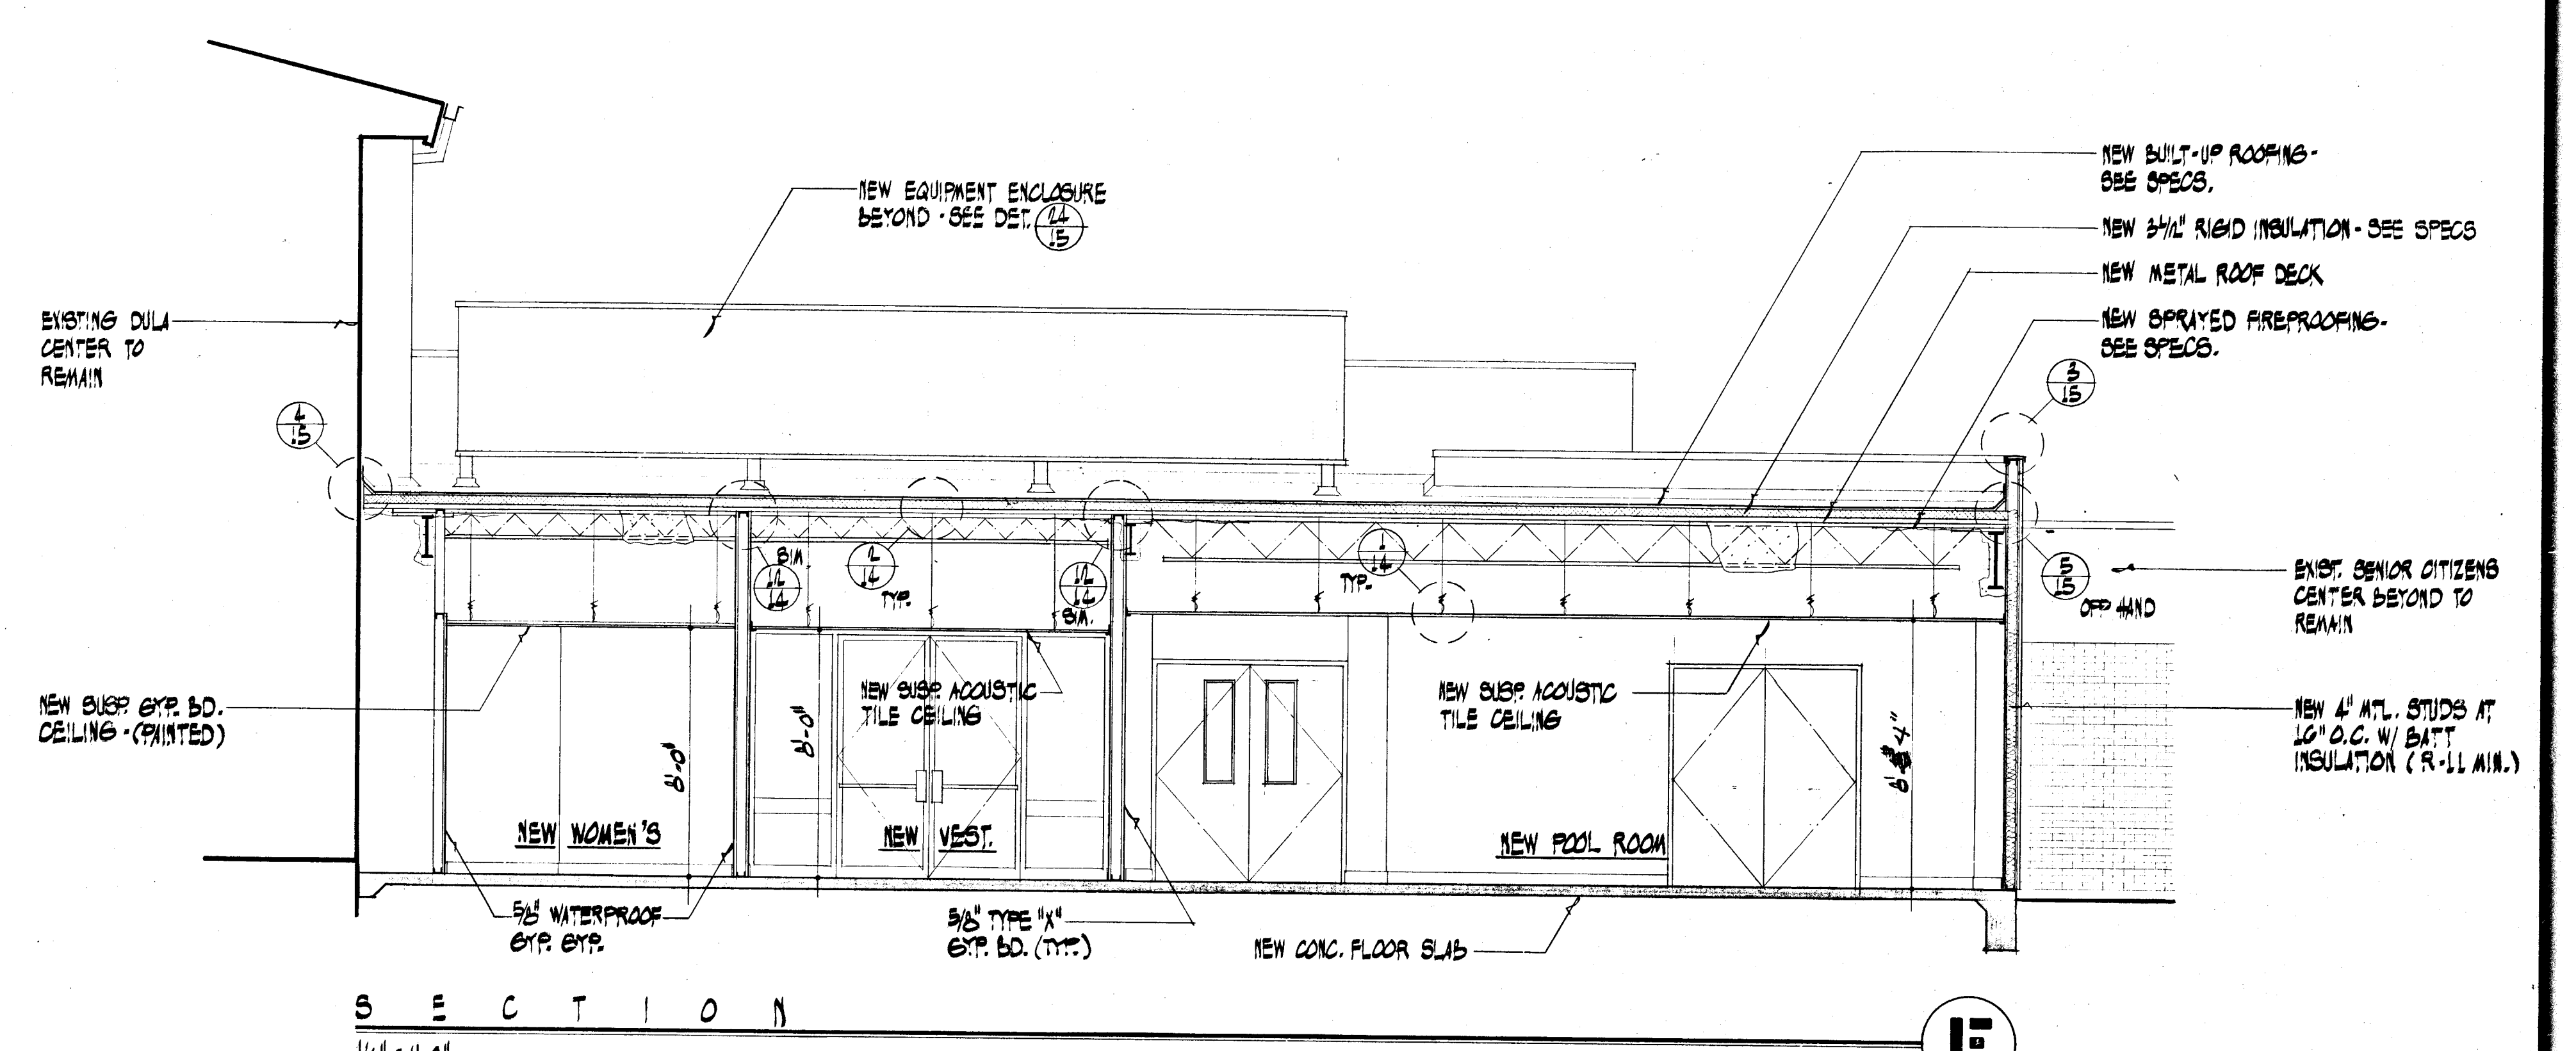
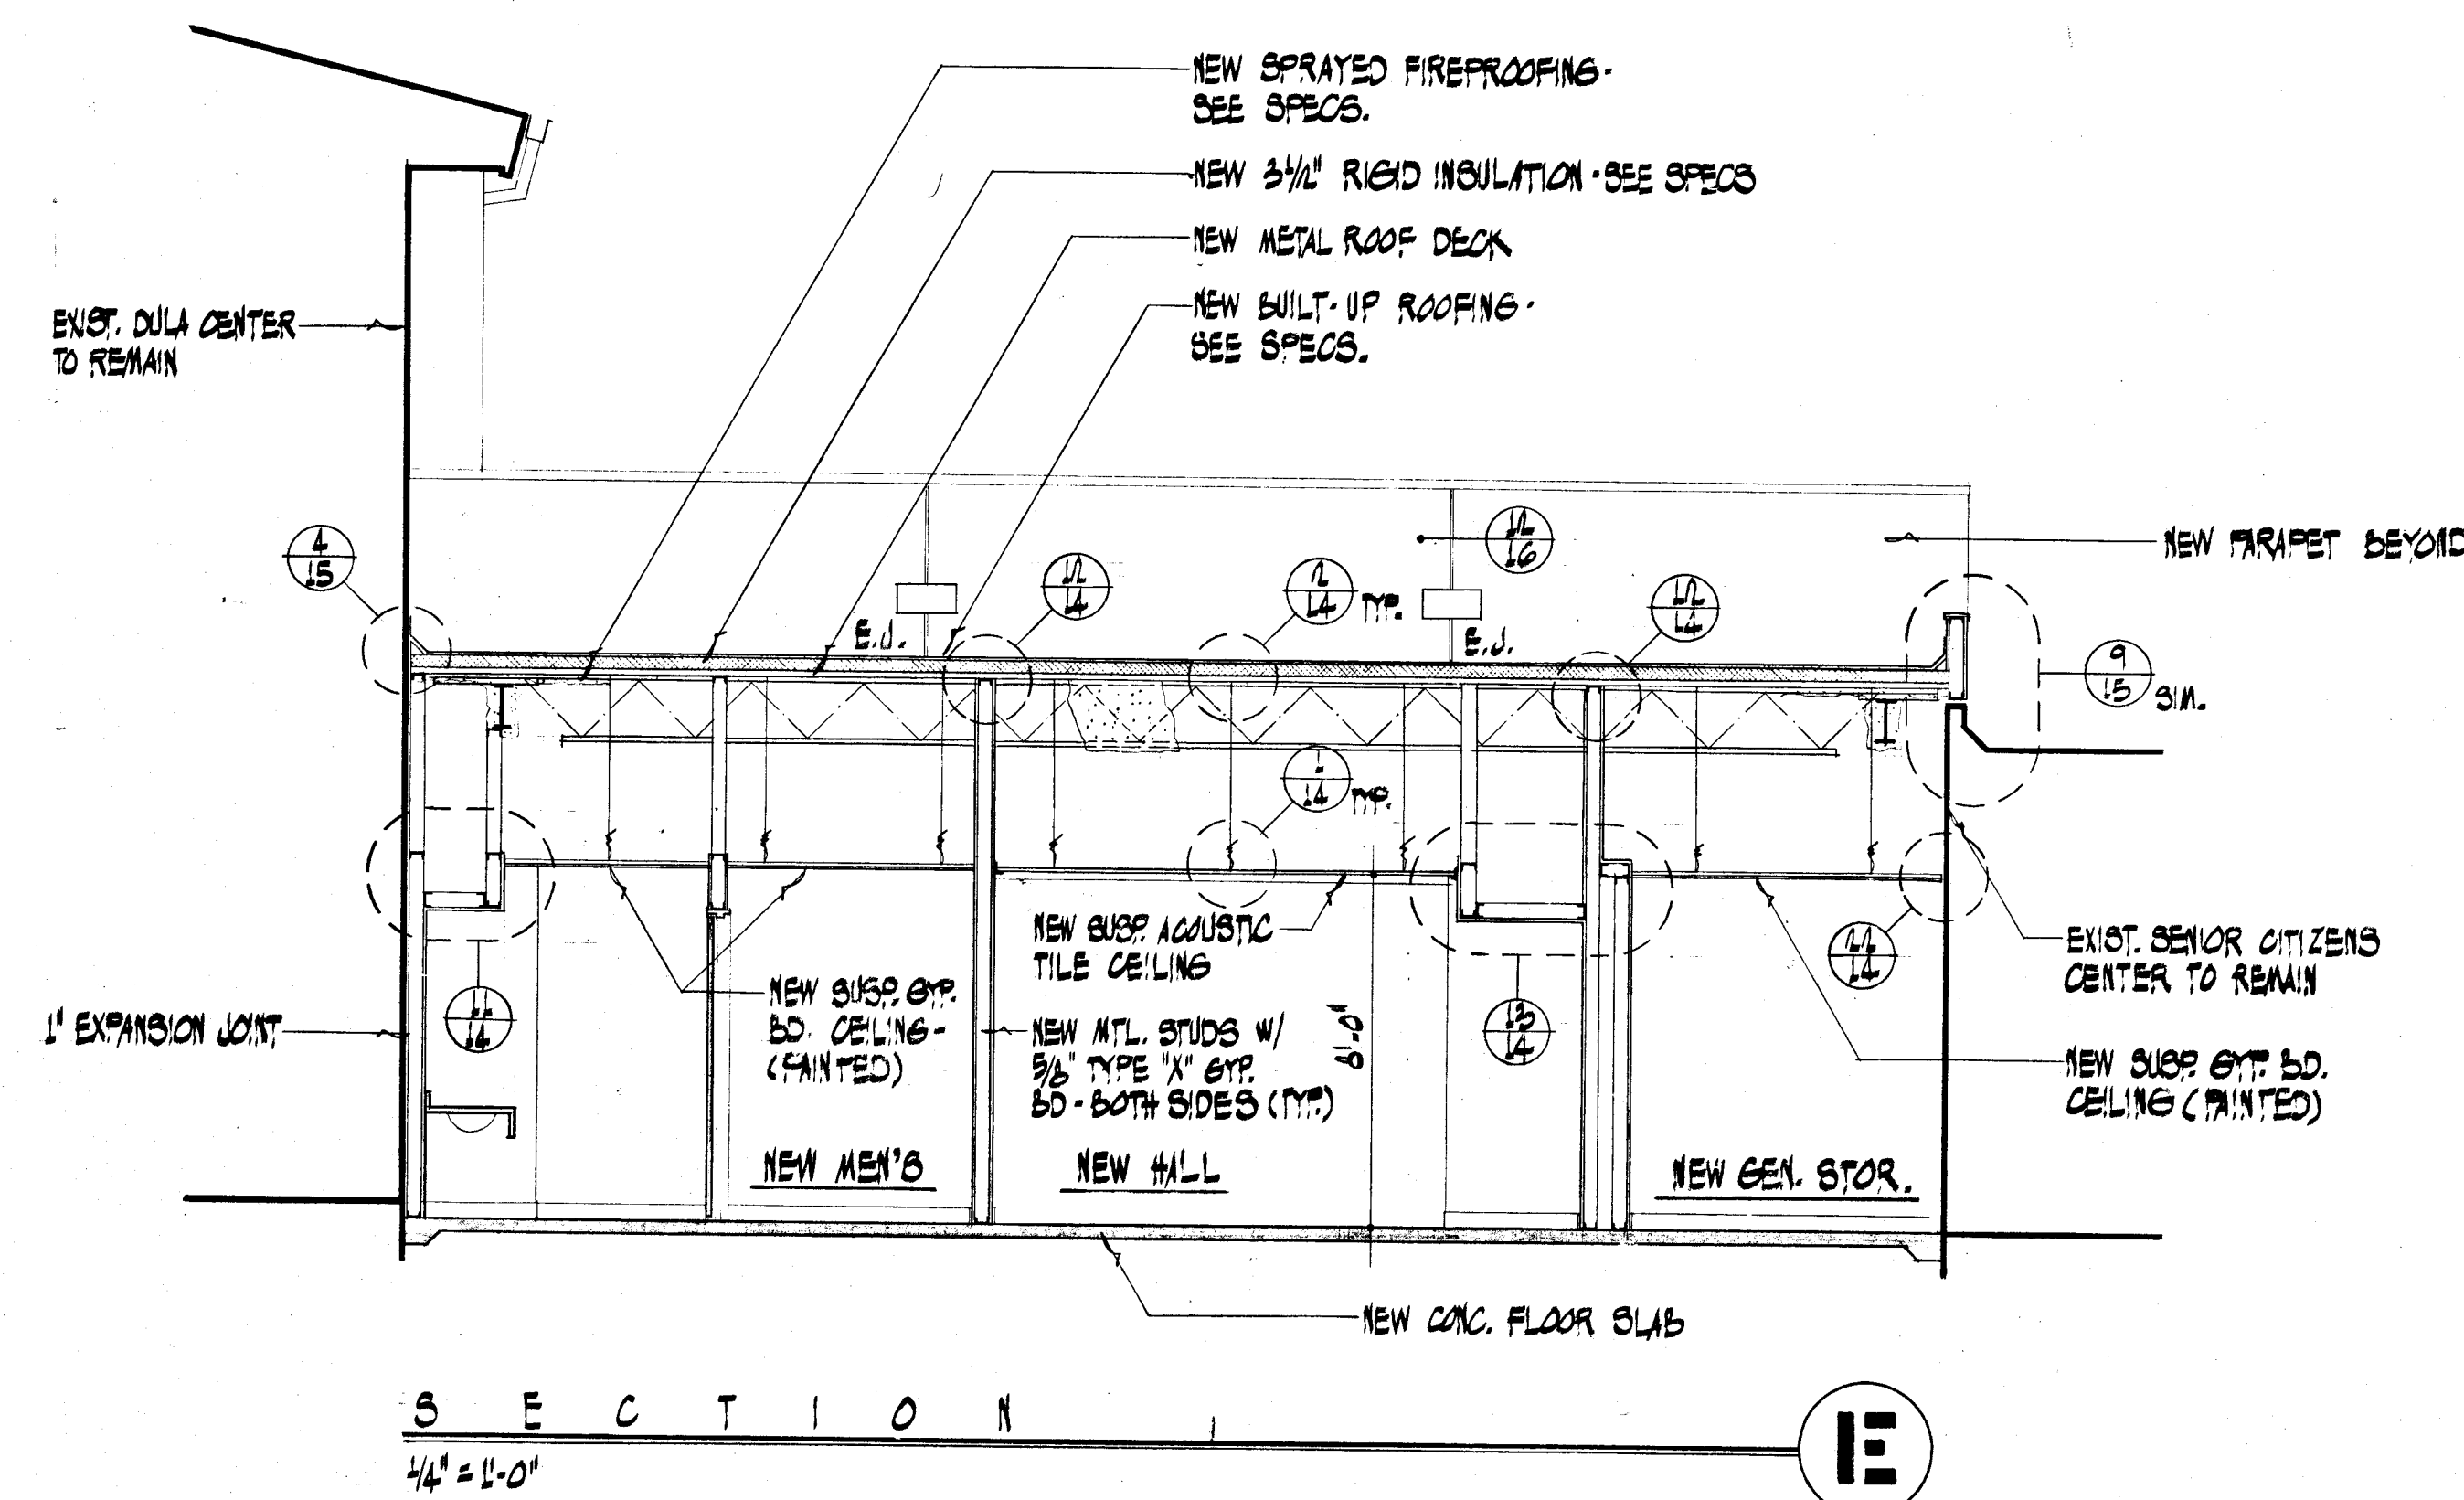
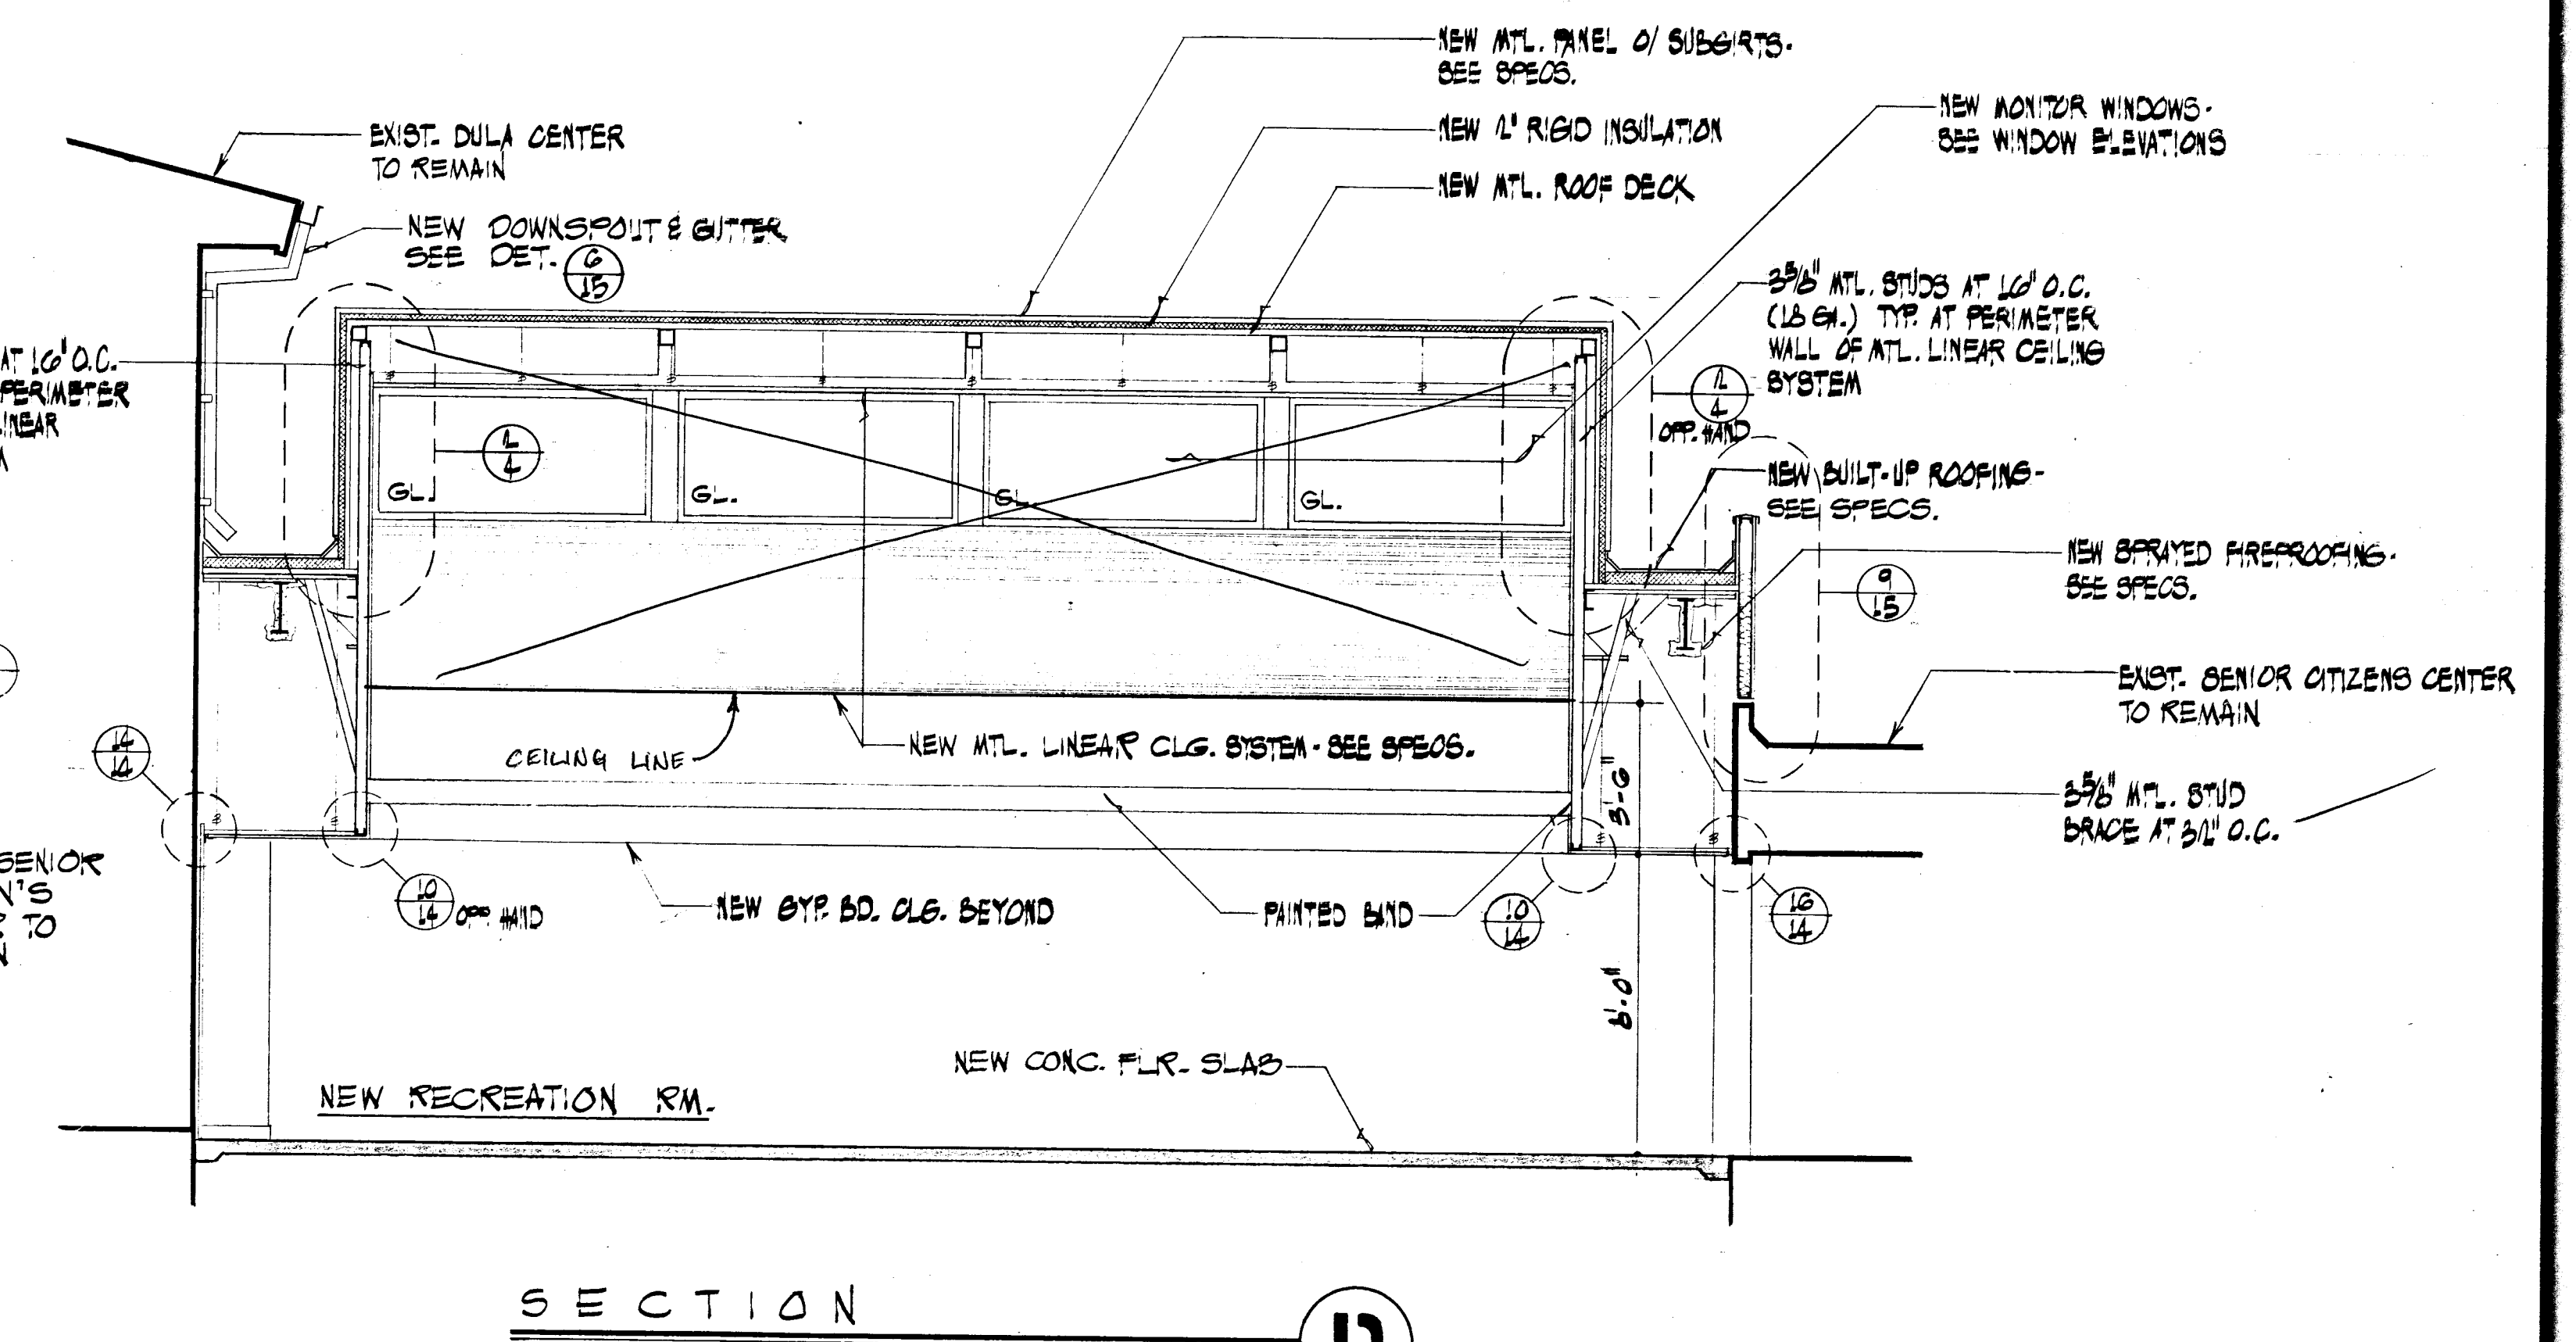
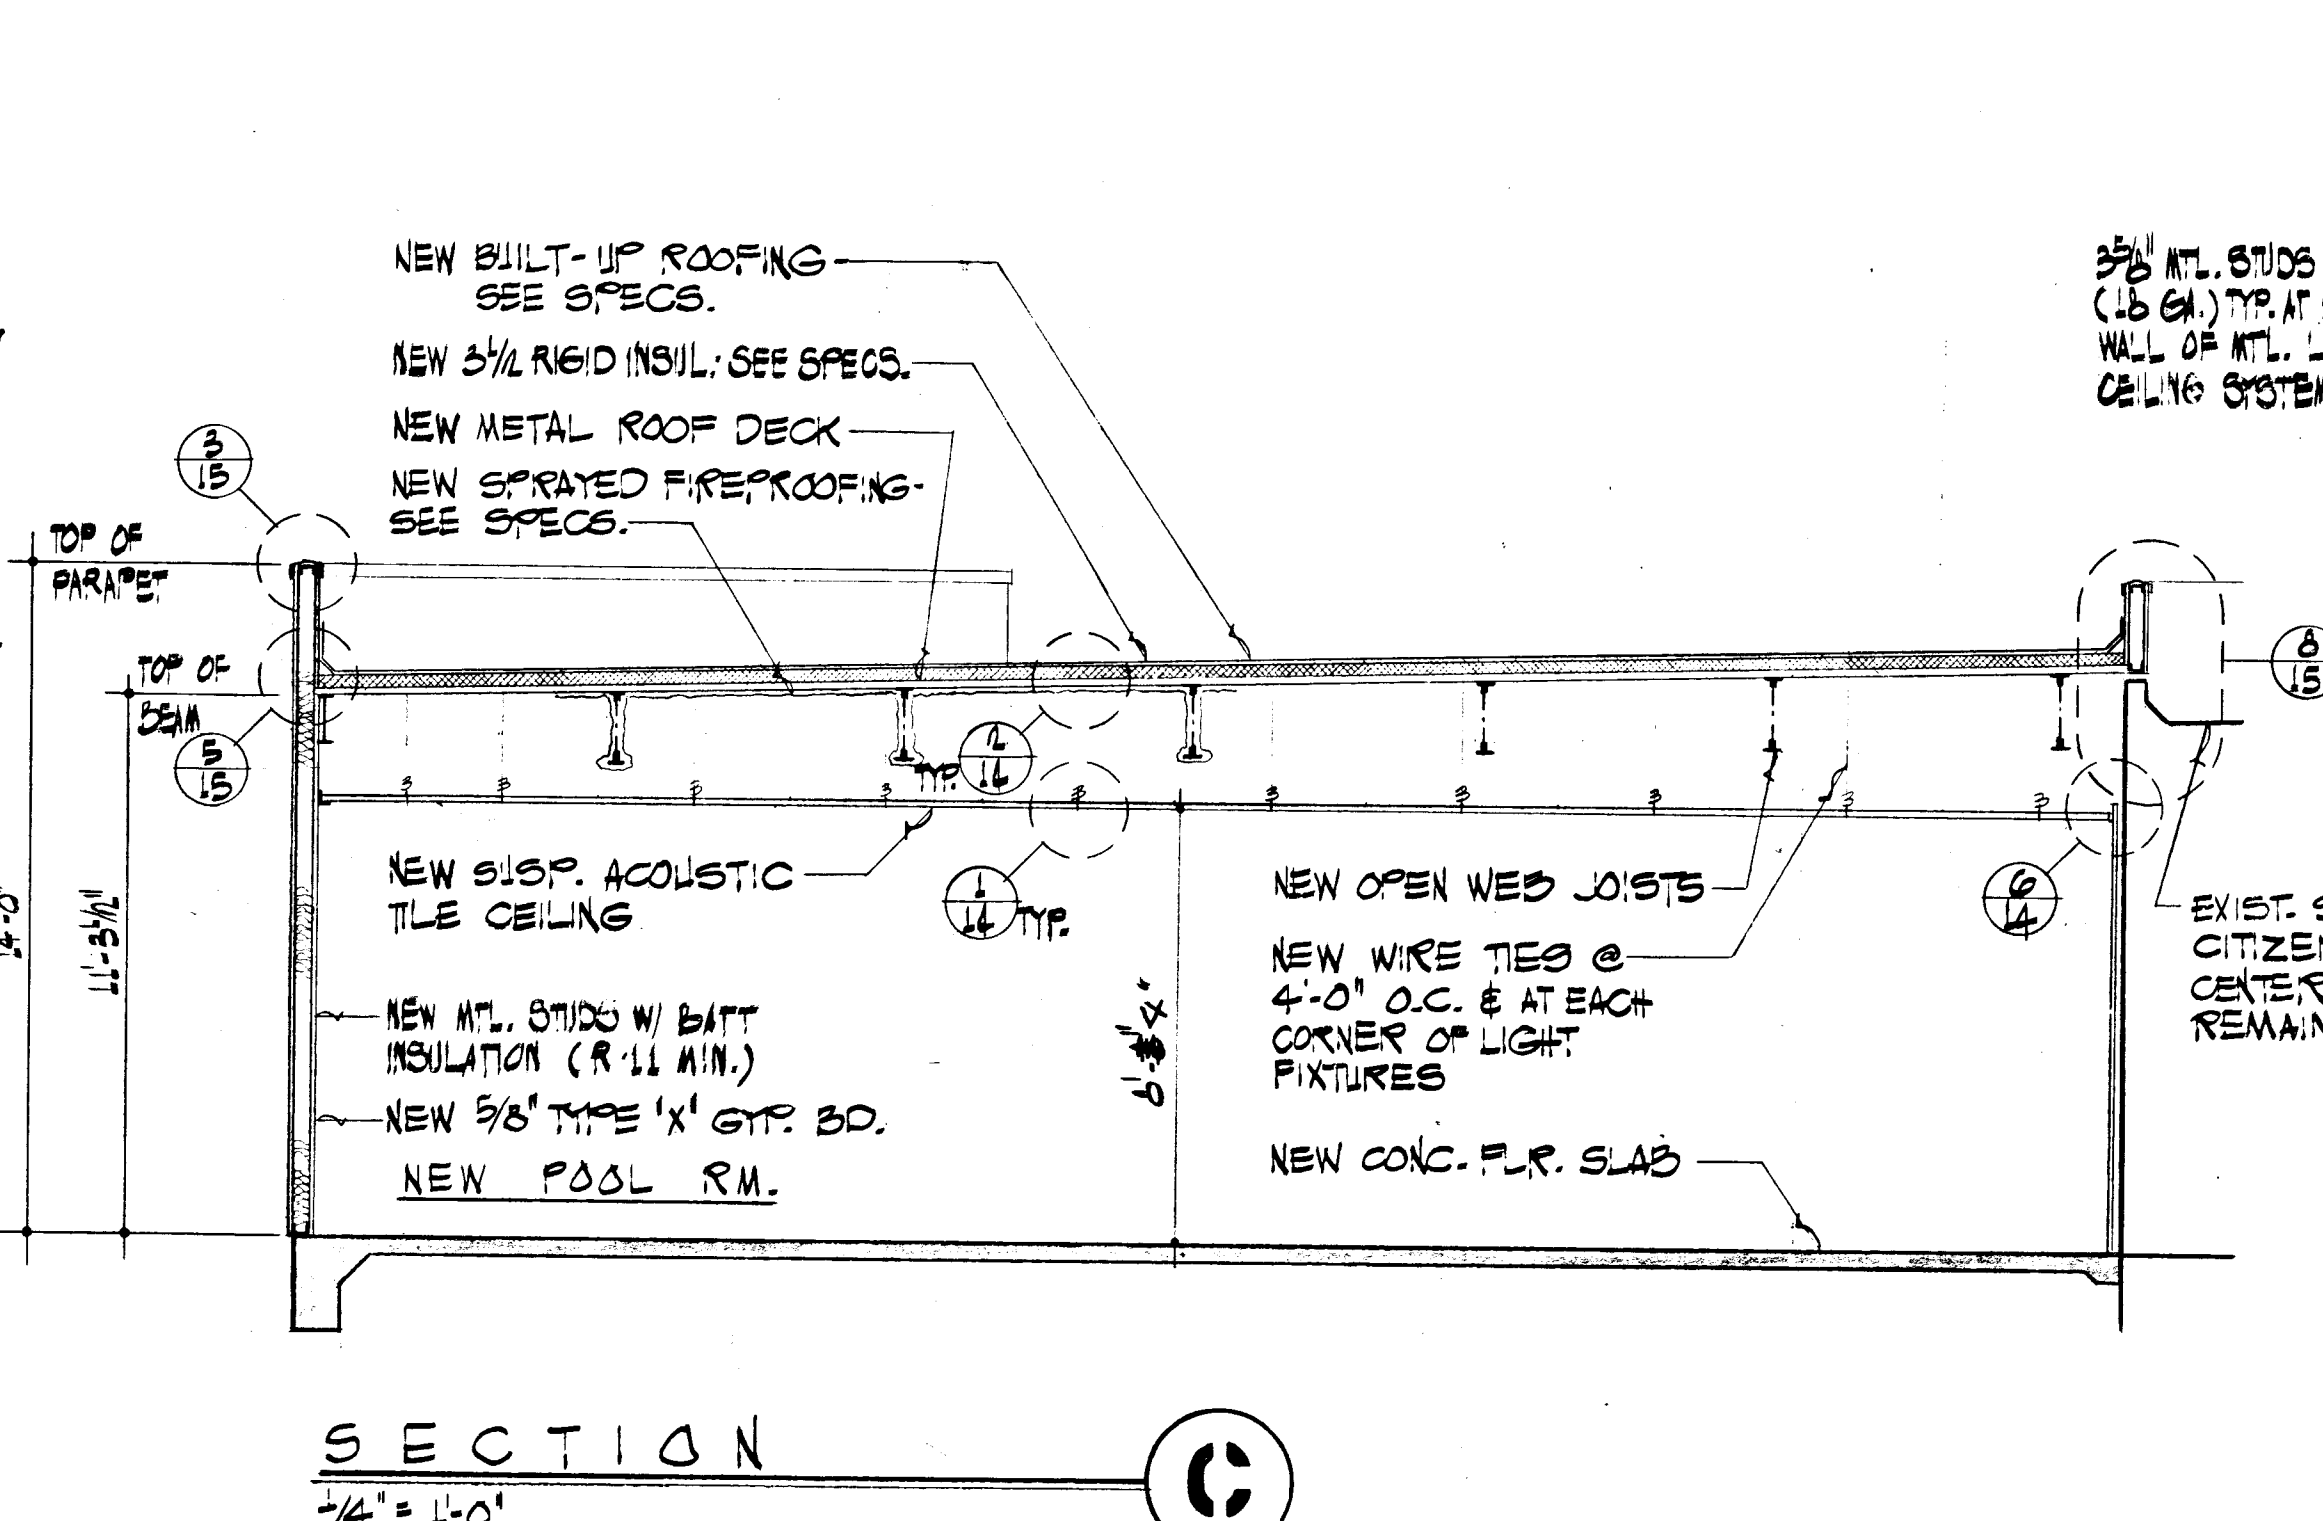
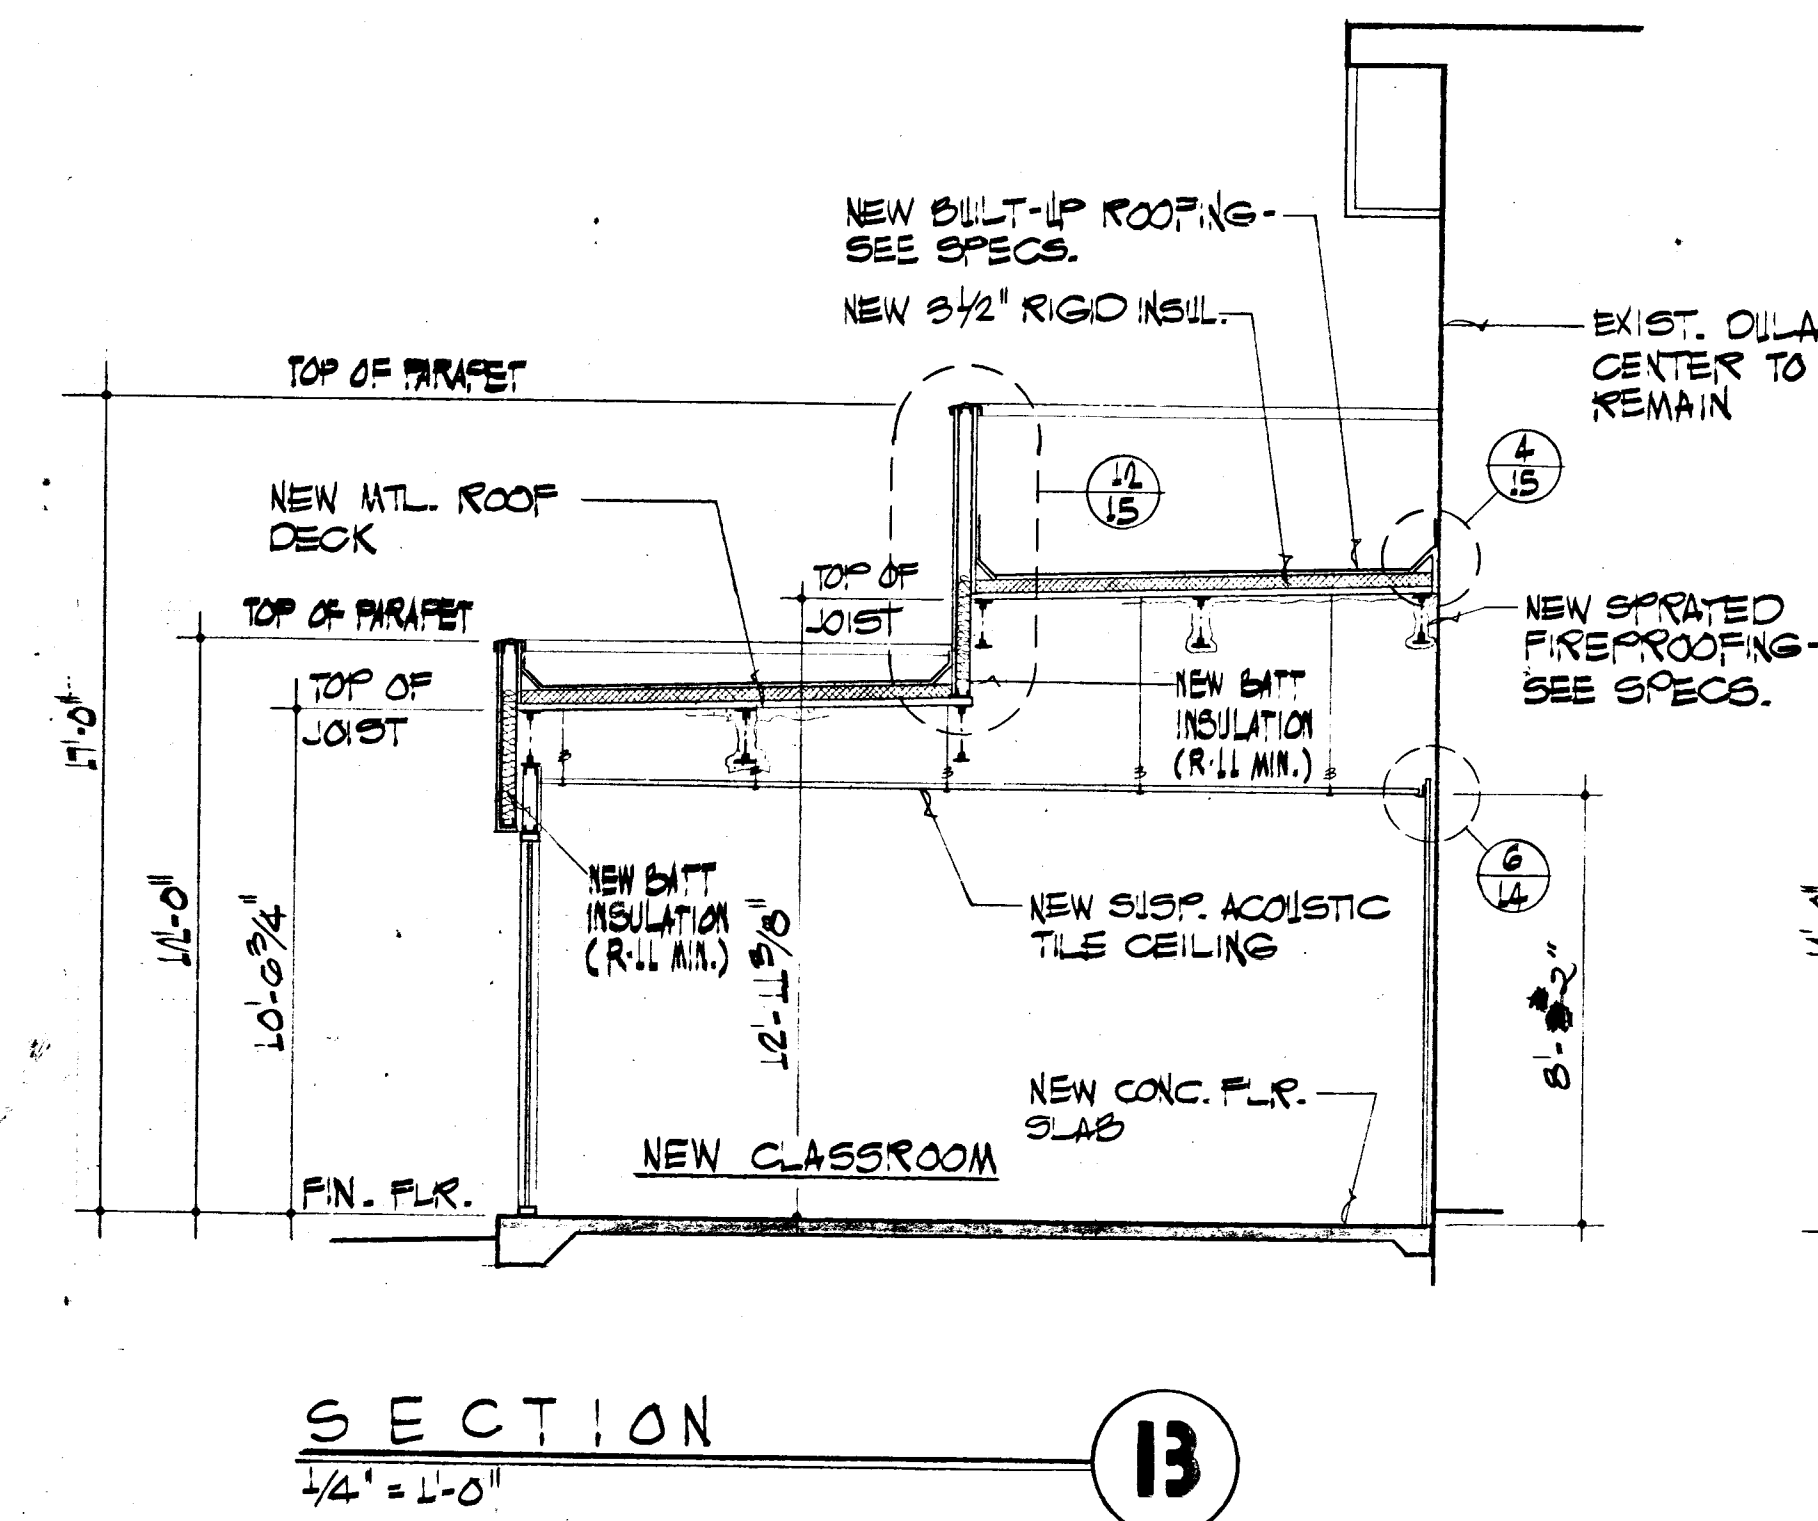


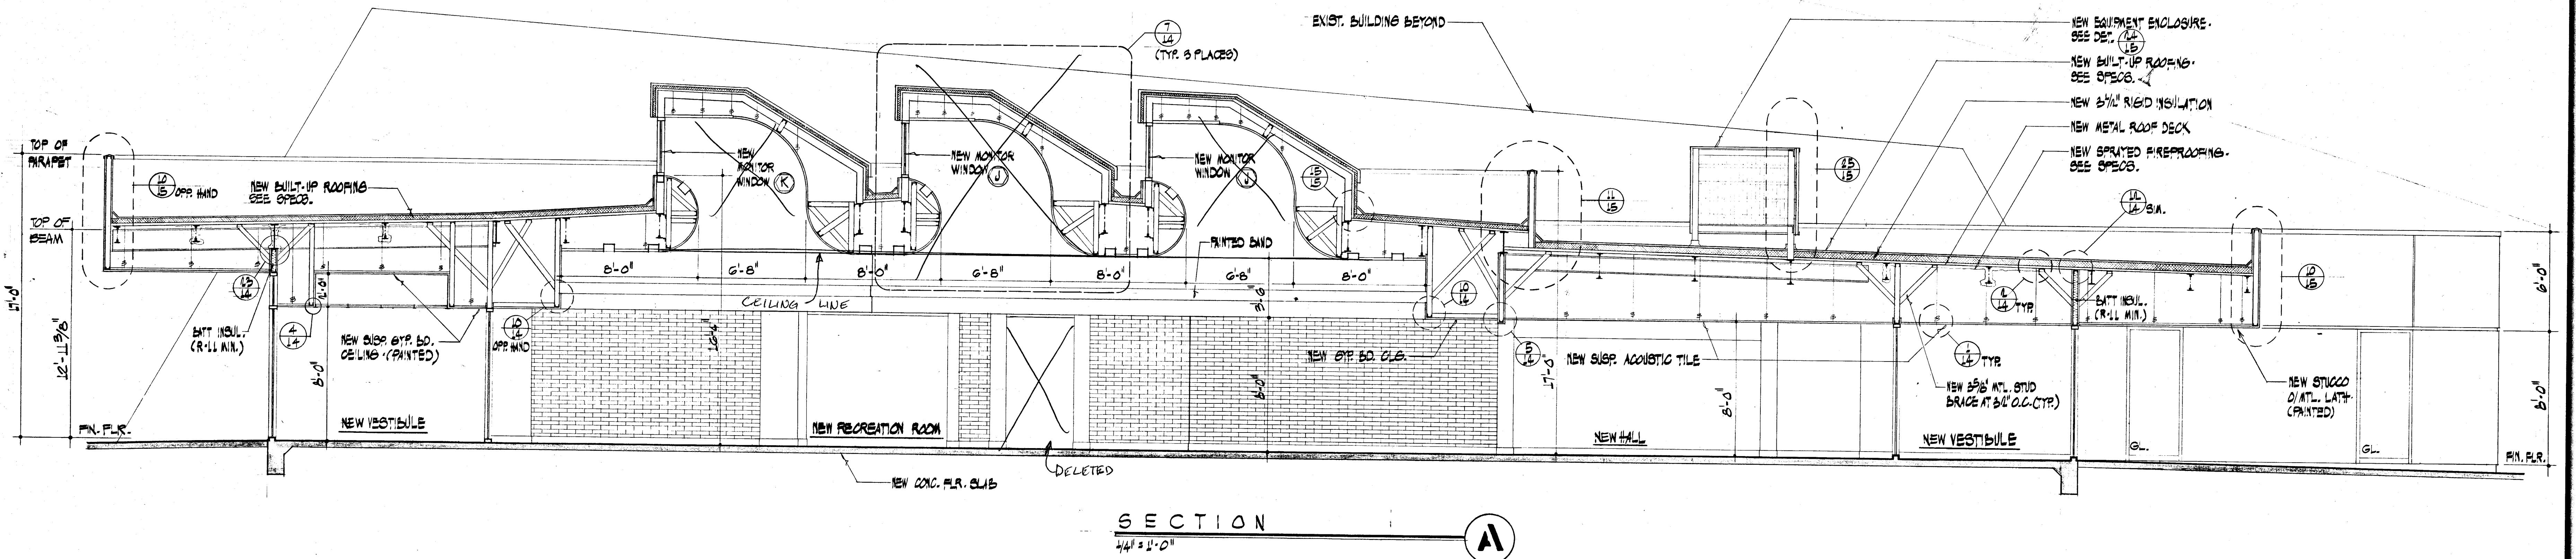

ALL SHOWN, EXCEPT WHERE NOTED OTHERWISE, TO BE IN ACCORDANCE WITH THE LATEST EDITIONS OF THE BUILDING CODES AND SPECIFICATIONS. THE USER OF THESE PLANS AND SPECIFICATIONS SHALL BE RESPONSIBLE FOR OBTAINING THE LATEST EDITIONS OF THE BUILDING CODES AND SPECIFICATIONS.

REVISIONS
DATE JULY 01, 1983
DRAWN JAW R., ARS J.
CHECKED J.D.R.
DO NOT SCALE DRAWINGS

CAMBEIRO & CAMBEIRO LTD.
ARCHITECTS
INSTITUTE OF ARCHITECTS
DOMINGO CAMBEIRO A.I.A.
NEVADA
ARTURO B. CAMBEIRO A.I.A.
LAS VEGAS

PROJECT NO. 82203
SHEET NO. 5
OF 19

4389 4000 513-453