



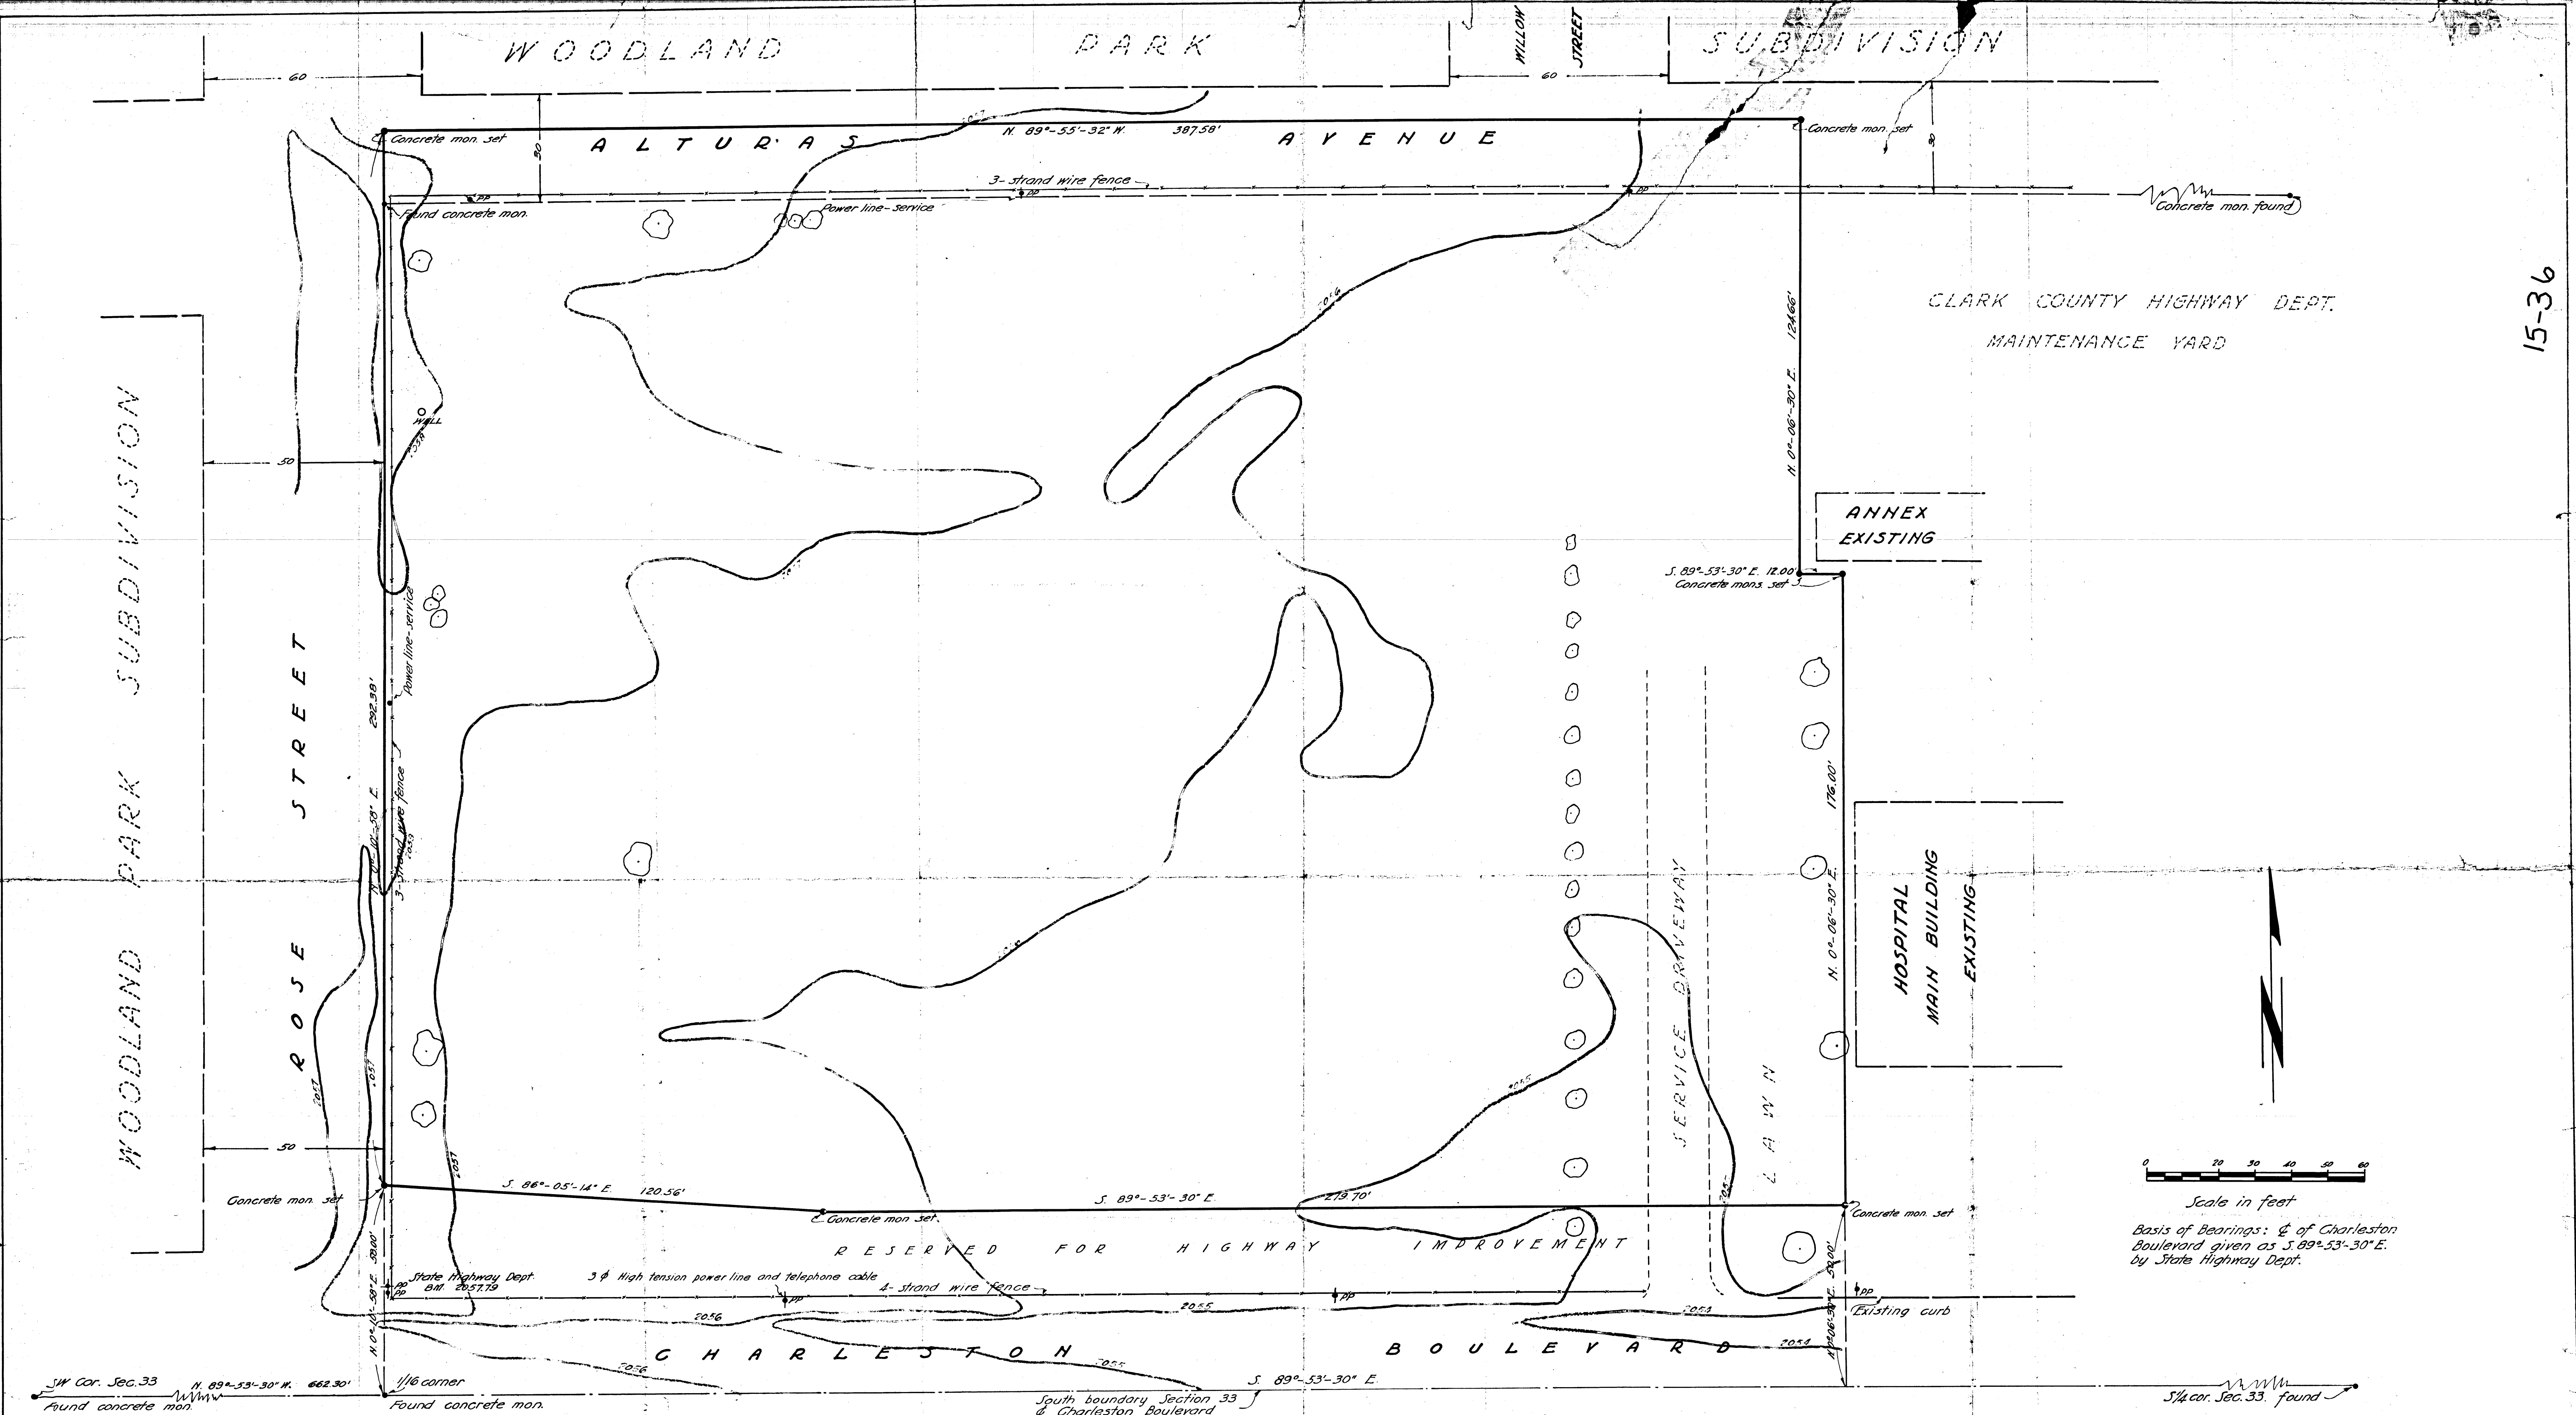

15-36

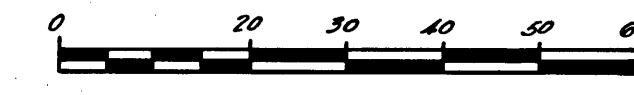

Scale in feet
Basis of Bearings: $\angle$ of Charleston Boulevard given as $S 89^{\circ} 53' 30'' E$ by State Highway Dept.

TRAVERSE TABLE

$S 86^{\circ} 05' 14'' E$	120.56'	8.23	120.28
$S 89^{\circ} 53' 30'' E$	279.70'	0.53	279.70
$N 0^{\circ} 06' 30'' E$	176.00'		0.53
$N 89^{\circ} 53' 30'' W$	12.00'	0.02	12.00
$N 0^{\circ} 06' 30'' E$	124.66'	0.50	
$N 89^{\circ} 53' 30'' W$	387.58'		387.58
$S 0^{\circ} 10' 58'' W$	292.38'	0.93	
	1392.88'	301.18	301.14
		400.55	400.51
		+04	+04
		1-25000	

ENGINEER'S CERTIFICATE
I, FRANCIS T. EISENMAN, JR., a duly licensed Civil Engineer, do hereby certify that the accompanying map truly represents the results of a survey of the western portion of the $\frac{1}{4}$ E of the $\frac{1}{4}$ of the SW $\frac{1}{4}$ of Section 33, T. 20 S., R. 6 E., M. 22 N., said survey having been made November 1-12, 1943, at the instance of the Board of Hospital Trustees, Clark County, Nevada.
Francis T. Eisenman, Jr.
REGISTERED PROFESSIONAL ENGINEER - NEVADA LICENSE NO. 248

056-30

OFFICE OF
FRANCIS T. EISENMAN, JR.
REGISTERED ENGINEER
LAS VEGAS, NEVADA

**SITE OF NEW
CLARK COUNTY GENERAL
HOSPITAL
LAS VEGAS-NEVADA**

Surveyed by F.M.E. & L.M.
Drawn by F.M.E.
Date Nov. 1-12, 1943

26-905