



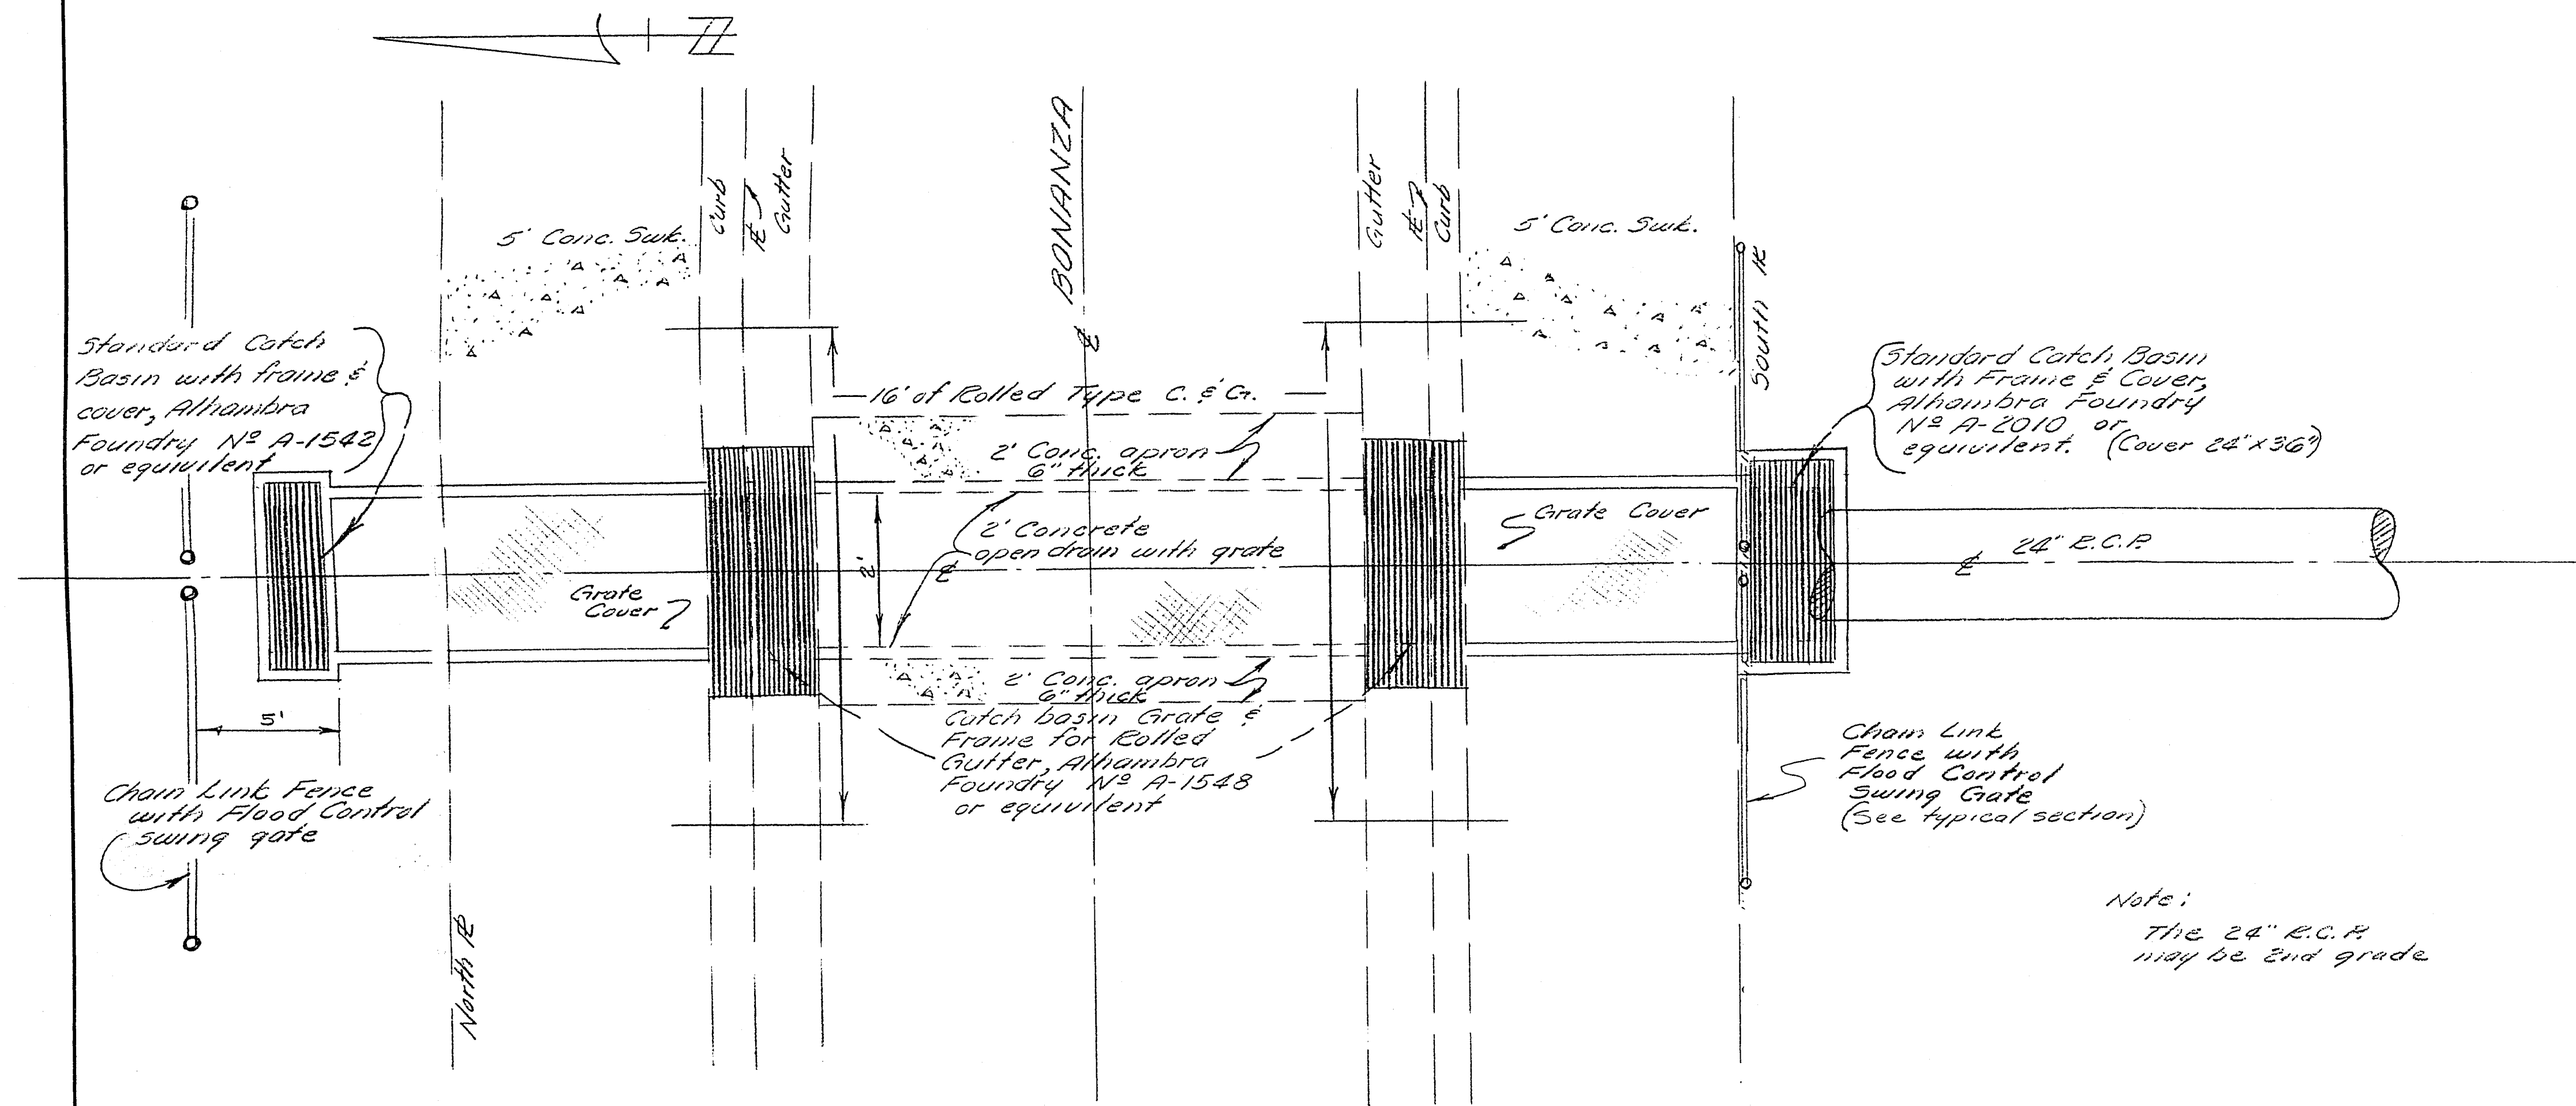


Plan View Section "A"
no scale

Note:
The 24" R.C.P.
may be end grade

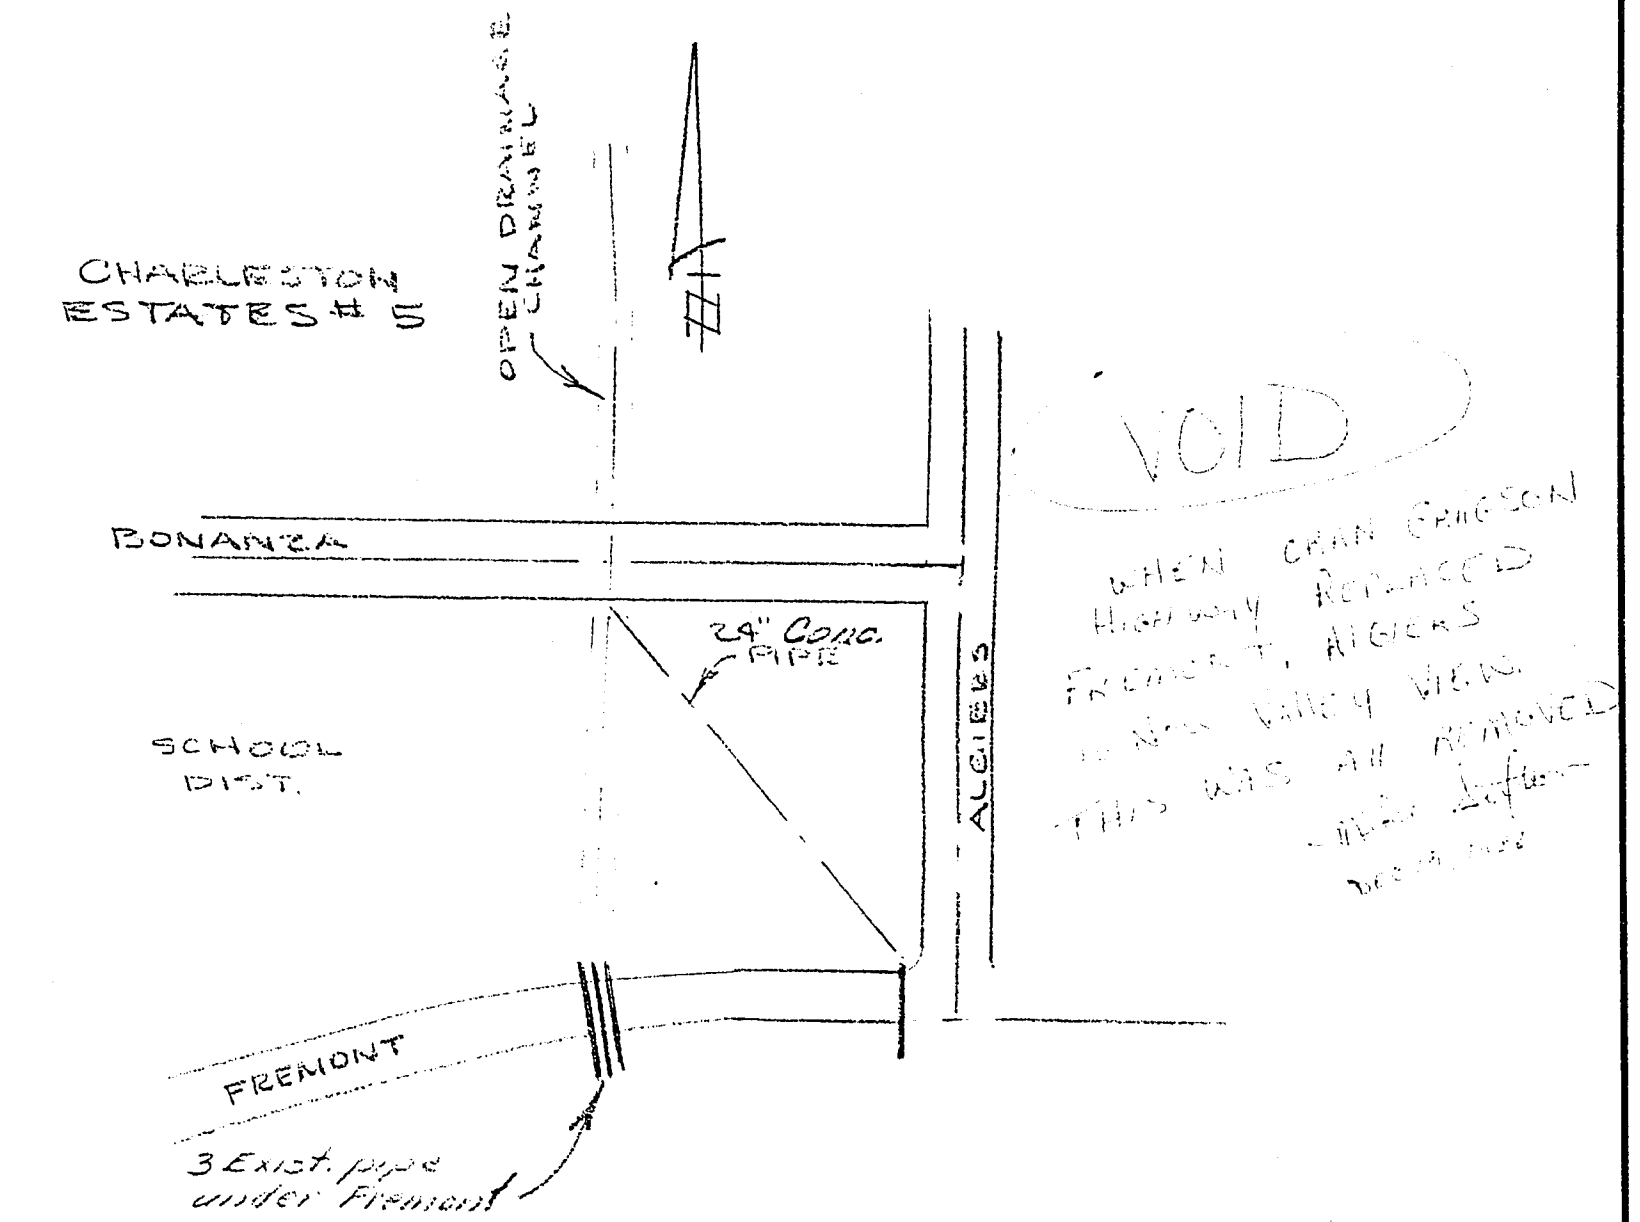


VICINITY MAP
NO SCALE

NOTE:
ALL GATE MATERIAL
TO GALVANIZED

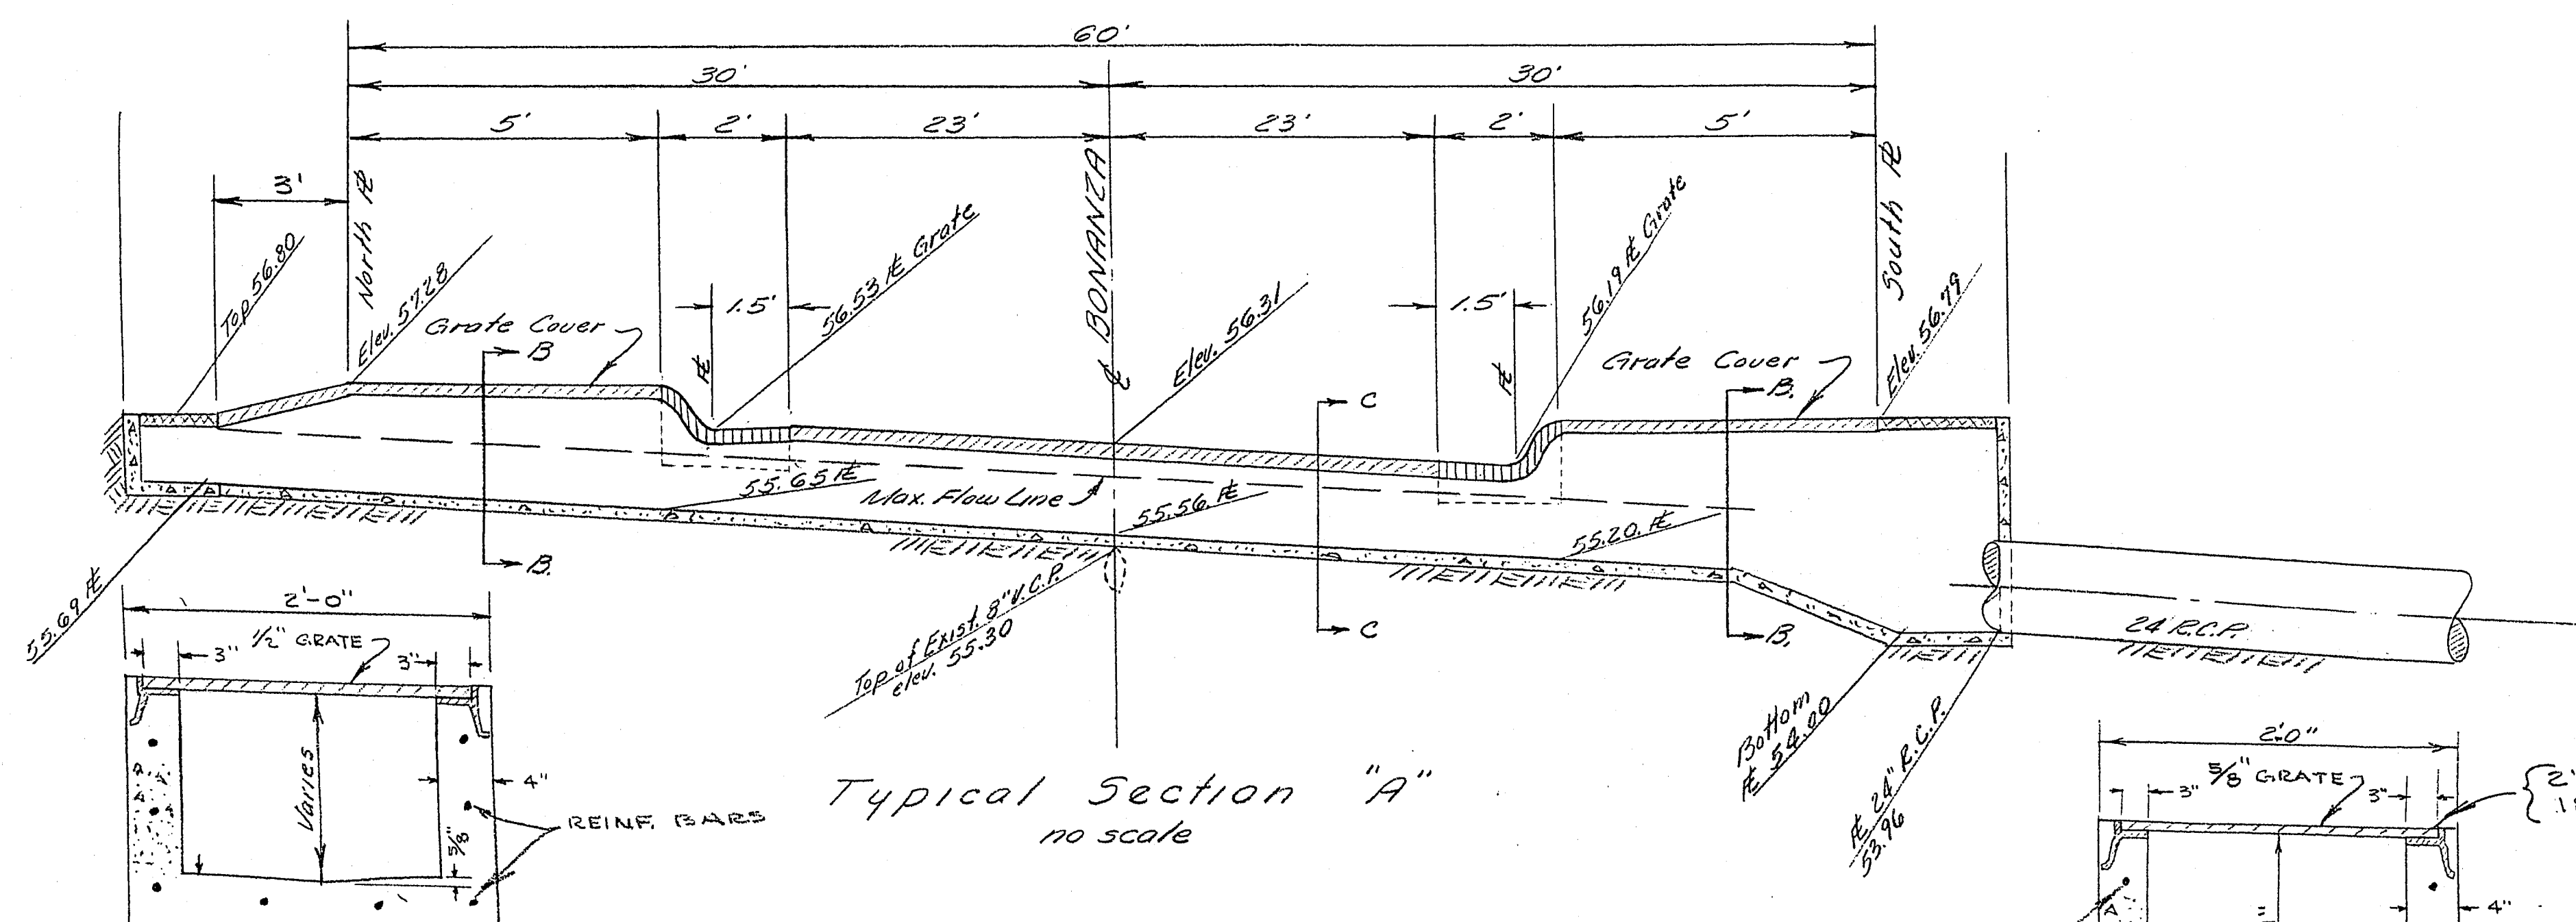

Typical Section "A"
no scale

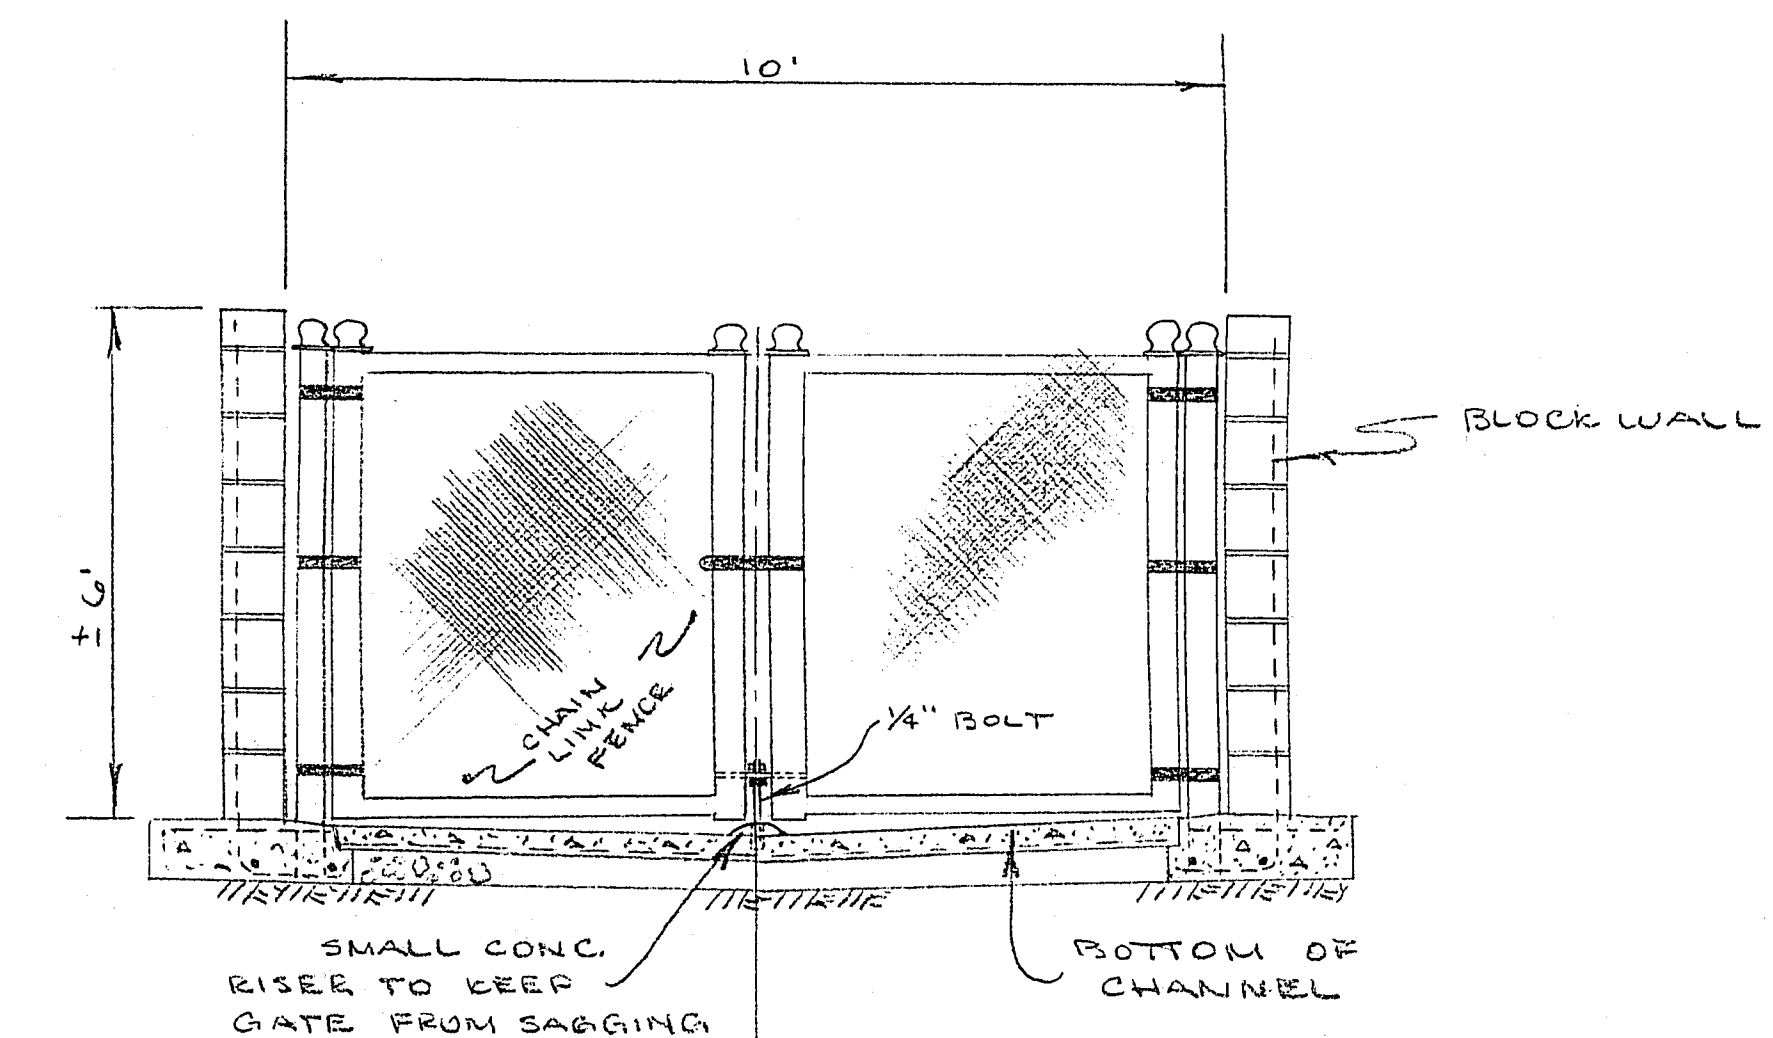

TYPICAL SECTION

Revision of R.C.P. to be used instead of C.H.P. M.H. 4-2-64

Approved By R.P. Hecker
Director of Public Works
Approved By R.G. Carter
Sanitation Dept.
Approved By J.H. McWhorter 4-3-64
Field Engineer

CITY OF LAS VEGAS NEVADA ENGINEERING DEPT.			
24" DRAINAGE PIPE from BONANZA to FREMONT			
DES. Mitchell	DATE 3-20-64	SC. 100	1" = 25'
DR. Mitchell	3-20-64	SC. 10	1" = 2'
CHK. Mitchell		F.B.K. NO.	
		P.L.O. NO.	
APPROVED BY CITY ENGR.		DRAWING NO.	327-89