


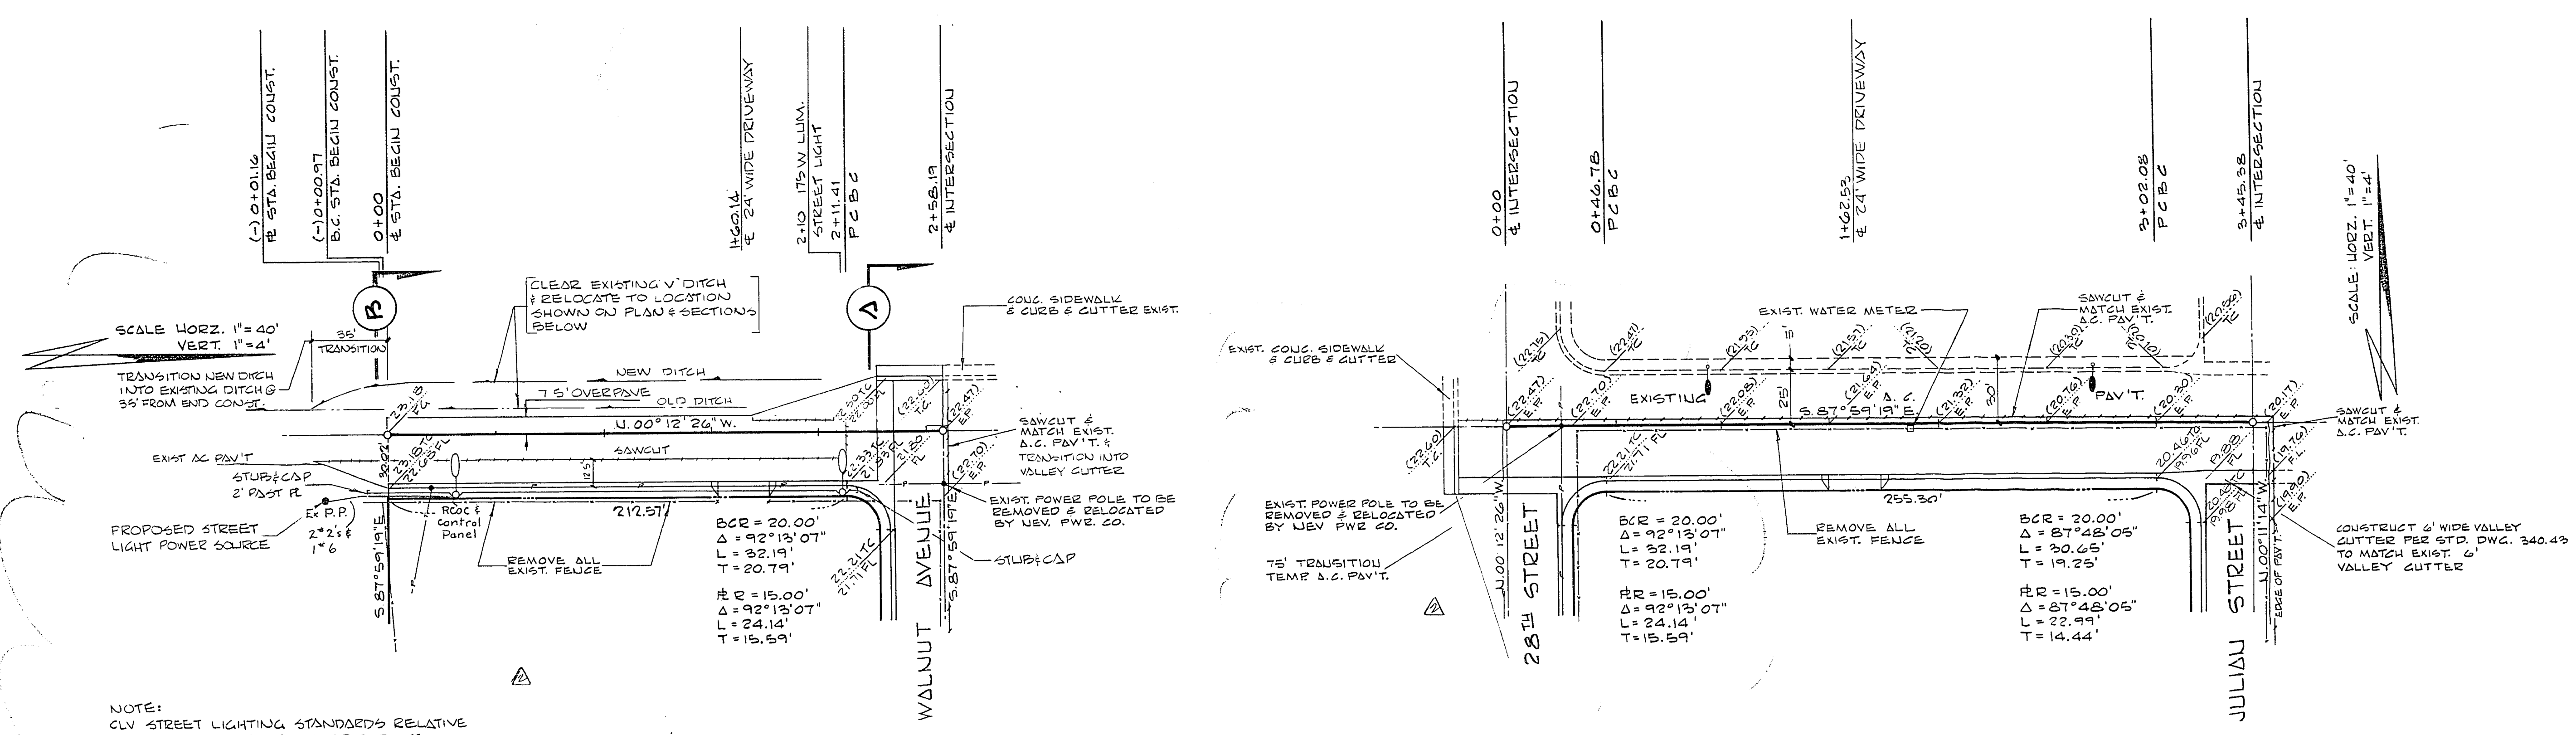

NOTE:
CLV STREET LIGHTING STANDARDS RELATIVE
TO 240 LOW VOLTAGE MULTIPLE DATED
SEPTEMBER 1, 1971 TO APPLY.
ALL FIELD WIRE TO BE 2"4"

NOTE TYPE V CEMENT TO BE USED
IN ALL CONCRETE CONSTRUCTION

28TH STREET WALNUT AVENUE

APPROVALS



William J. ... 12/2/76
CITY OF LAS VEGAS ENGINEERING DEPT. DATE

Robert ... 12/2/76
CITY OF LAS VEGAS FIELD ... IS ENGR. DATE

George ... 11/24/76
CITY OF LAS VEGAS ELECTRICAL DEPT. DATE

... 11/24/76
NEVADA POWER CO. DATE

Rob ... 11/24/76
CLV ELECTRICAL COORDINATOR DATE

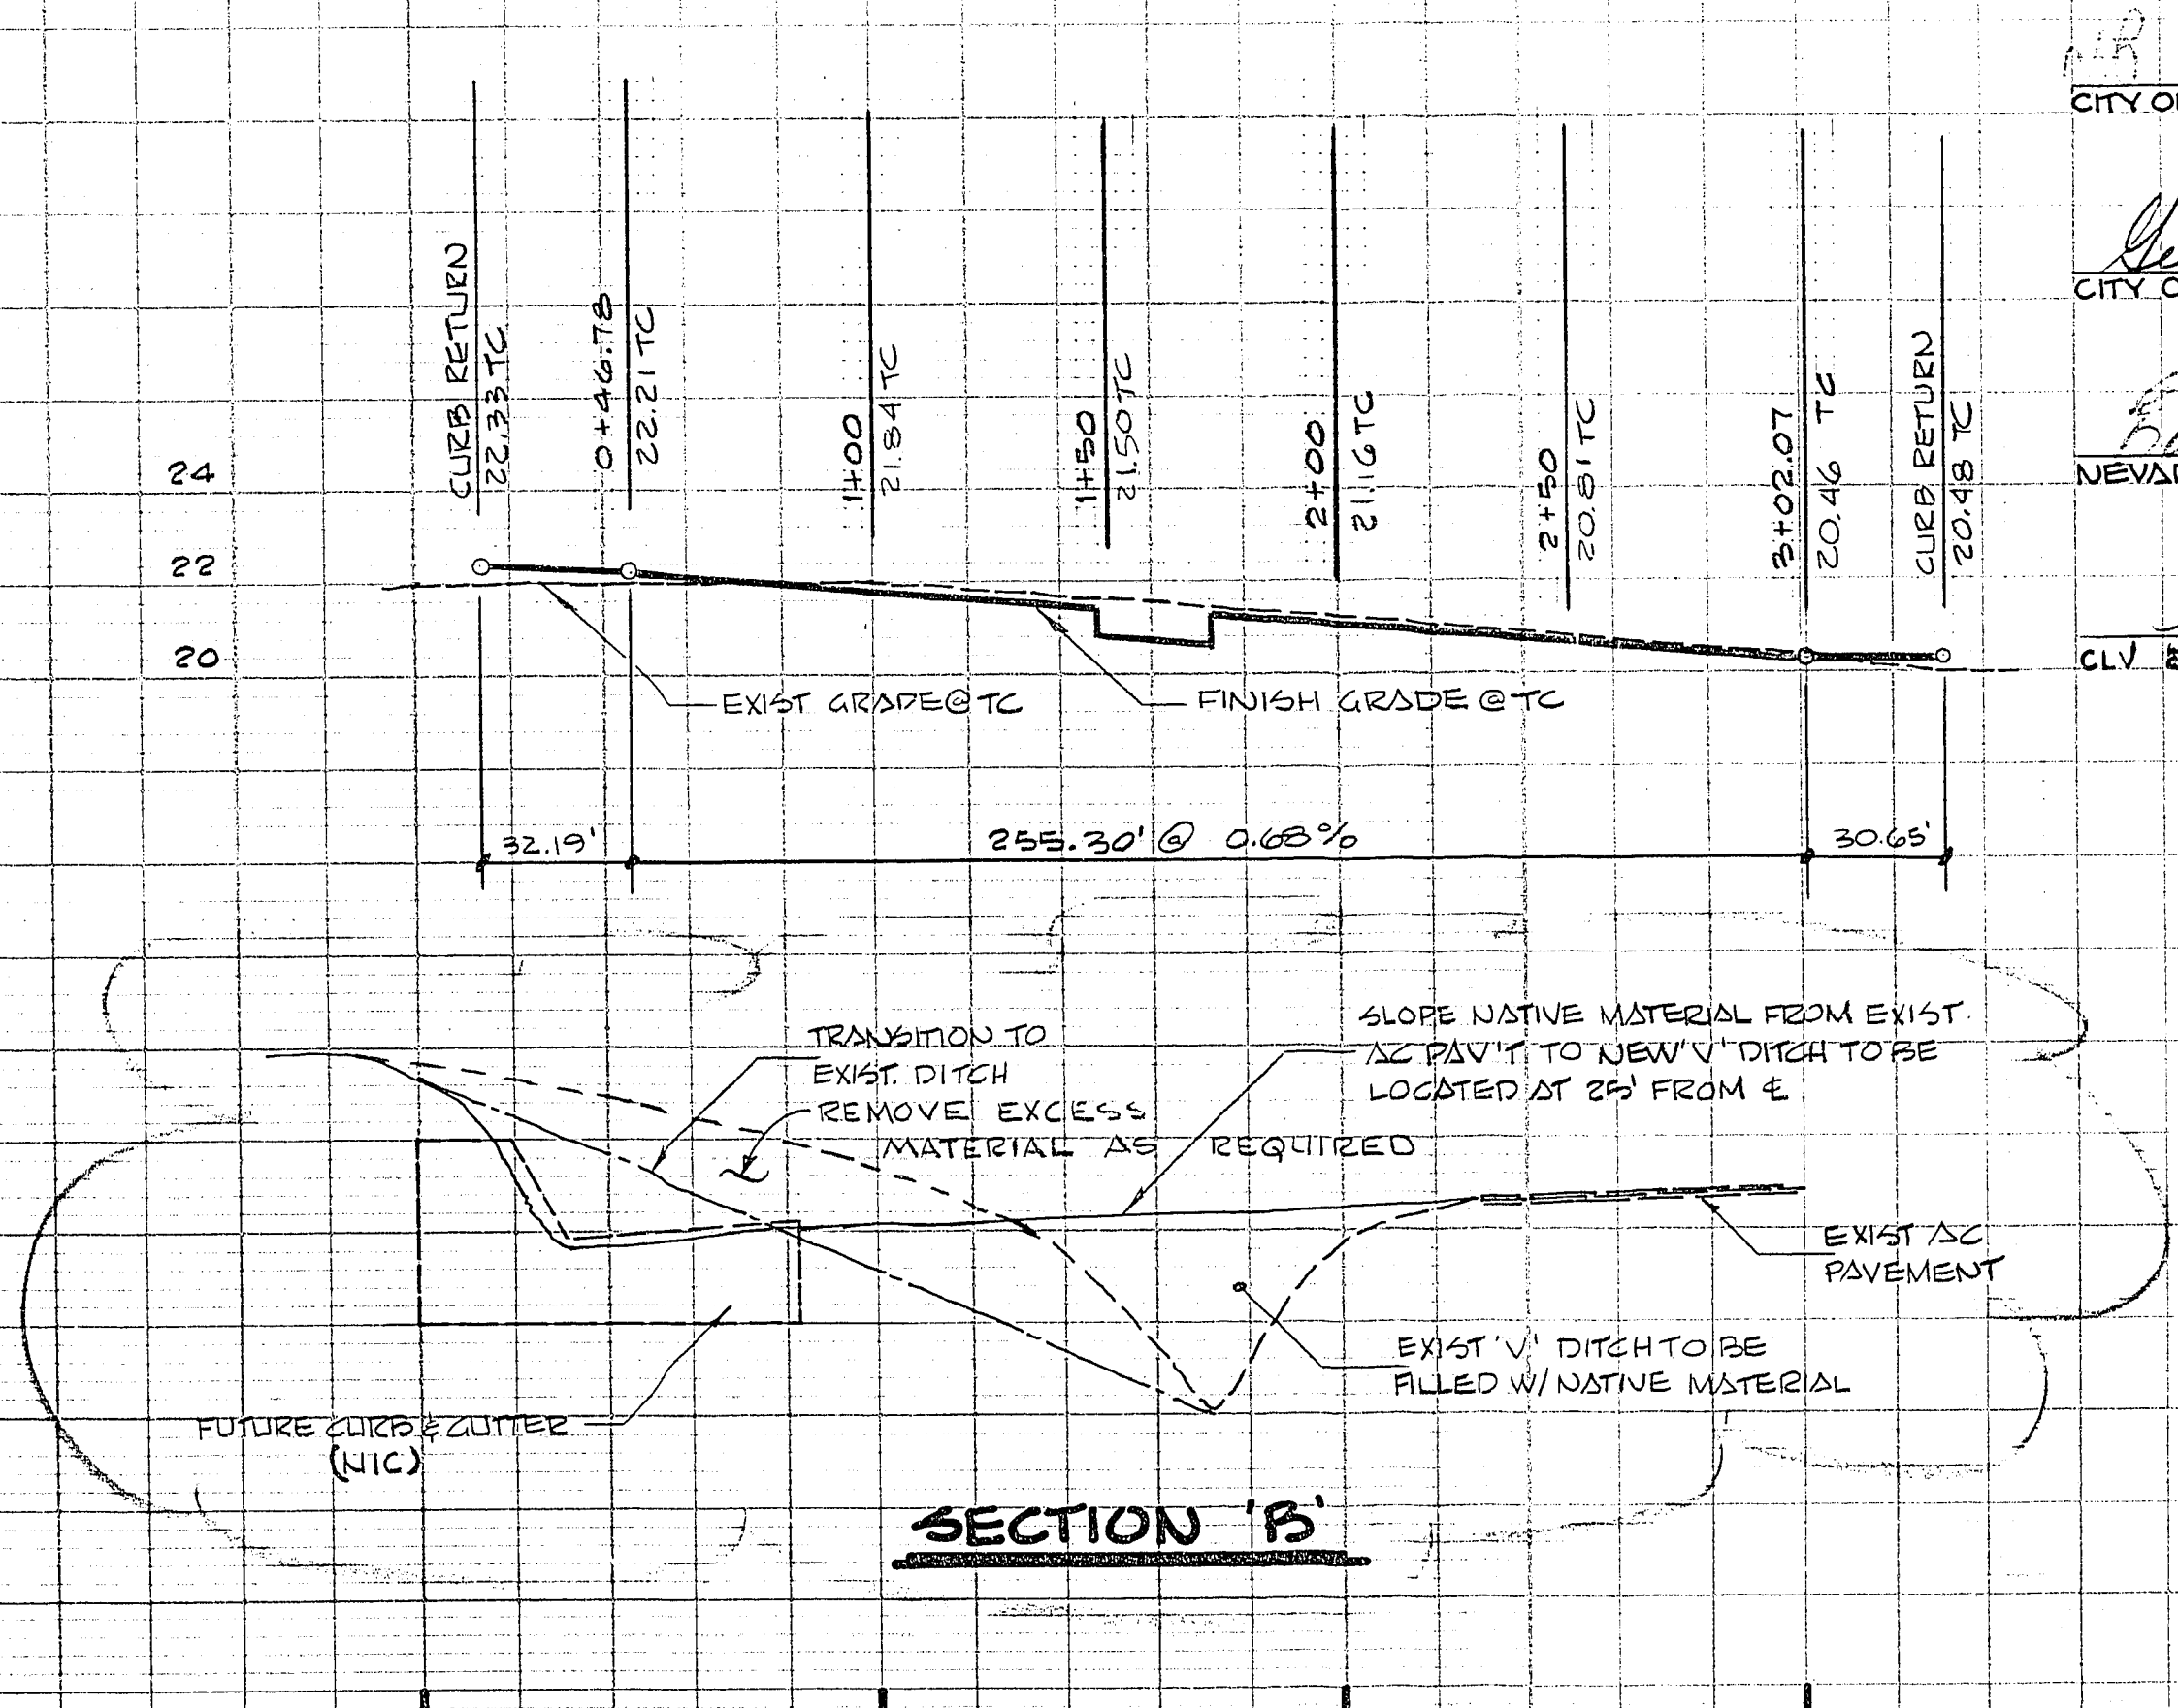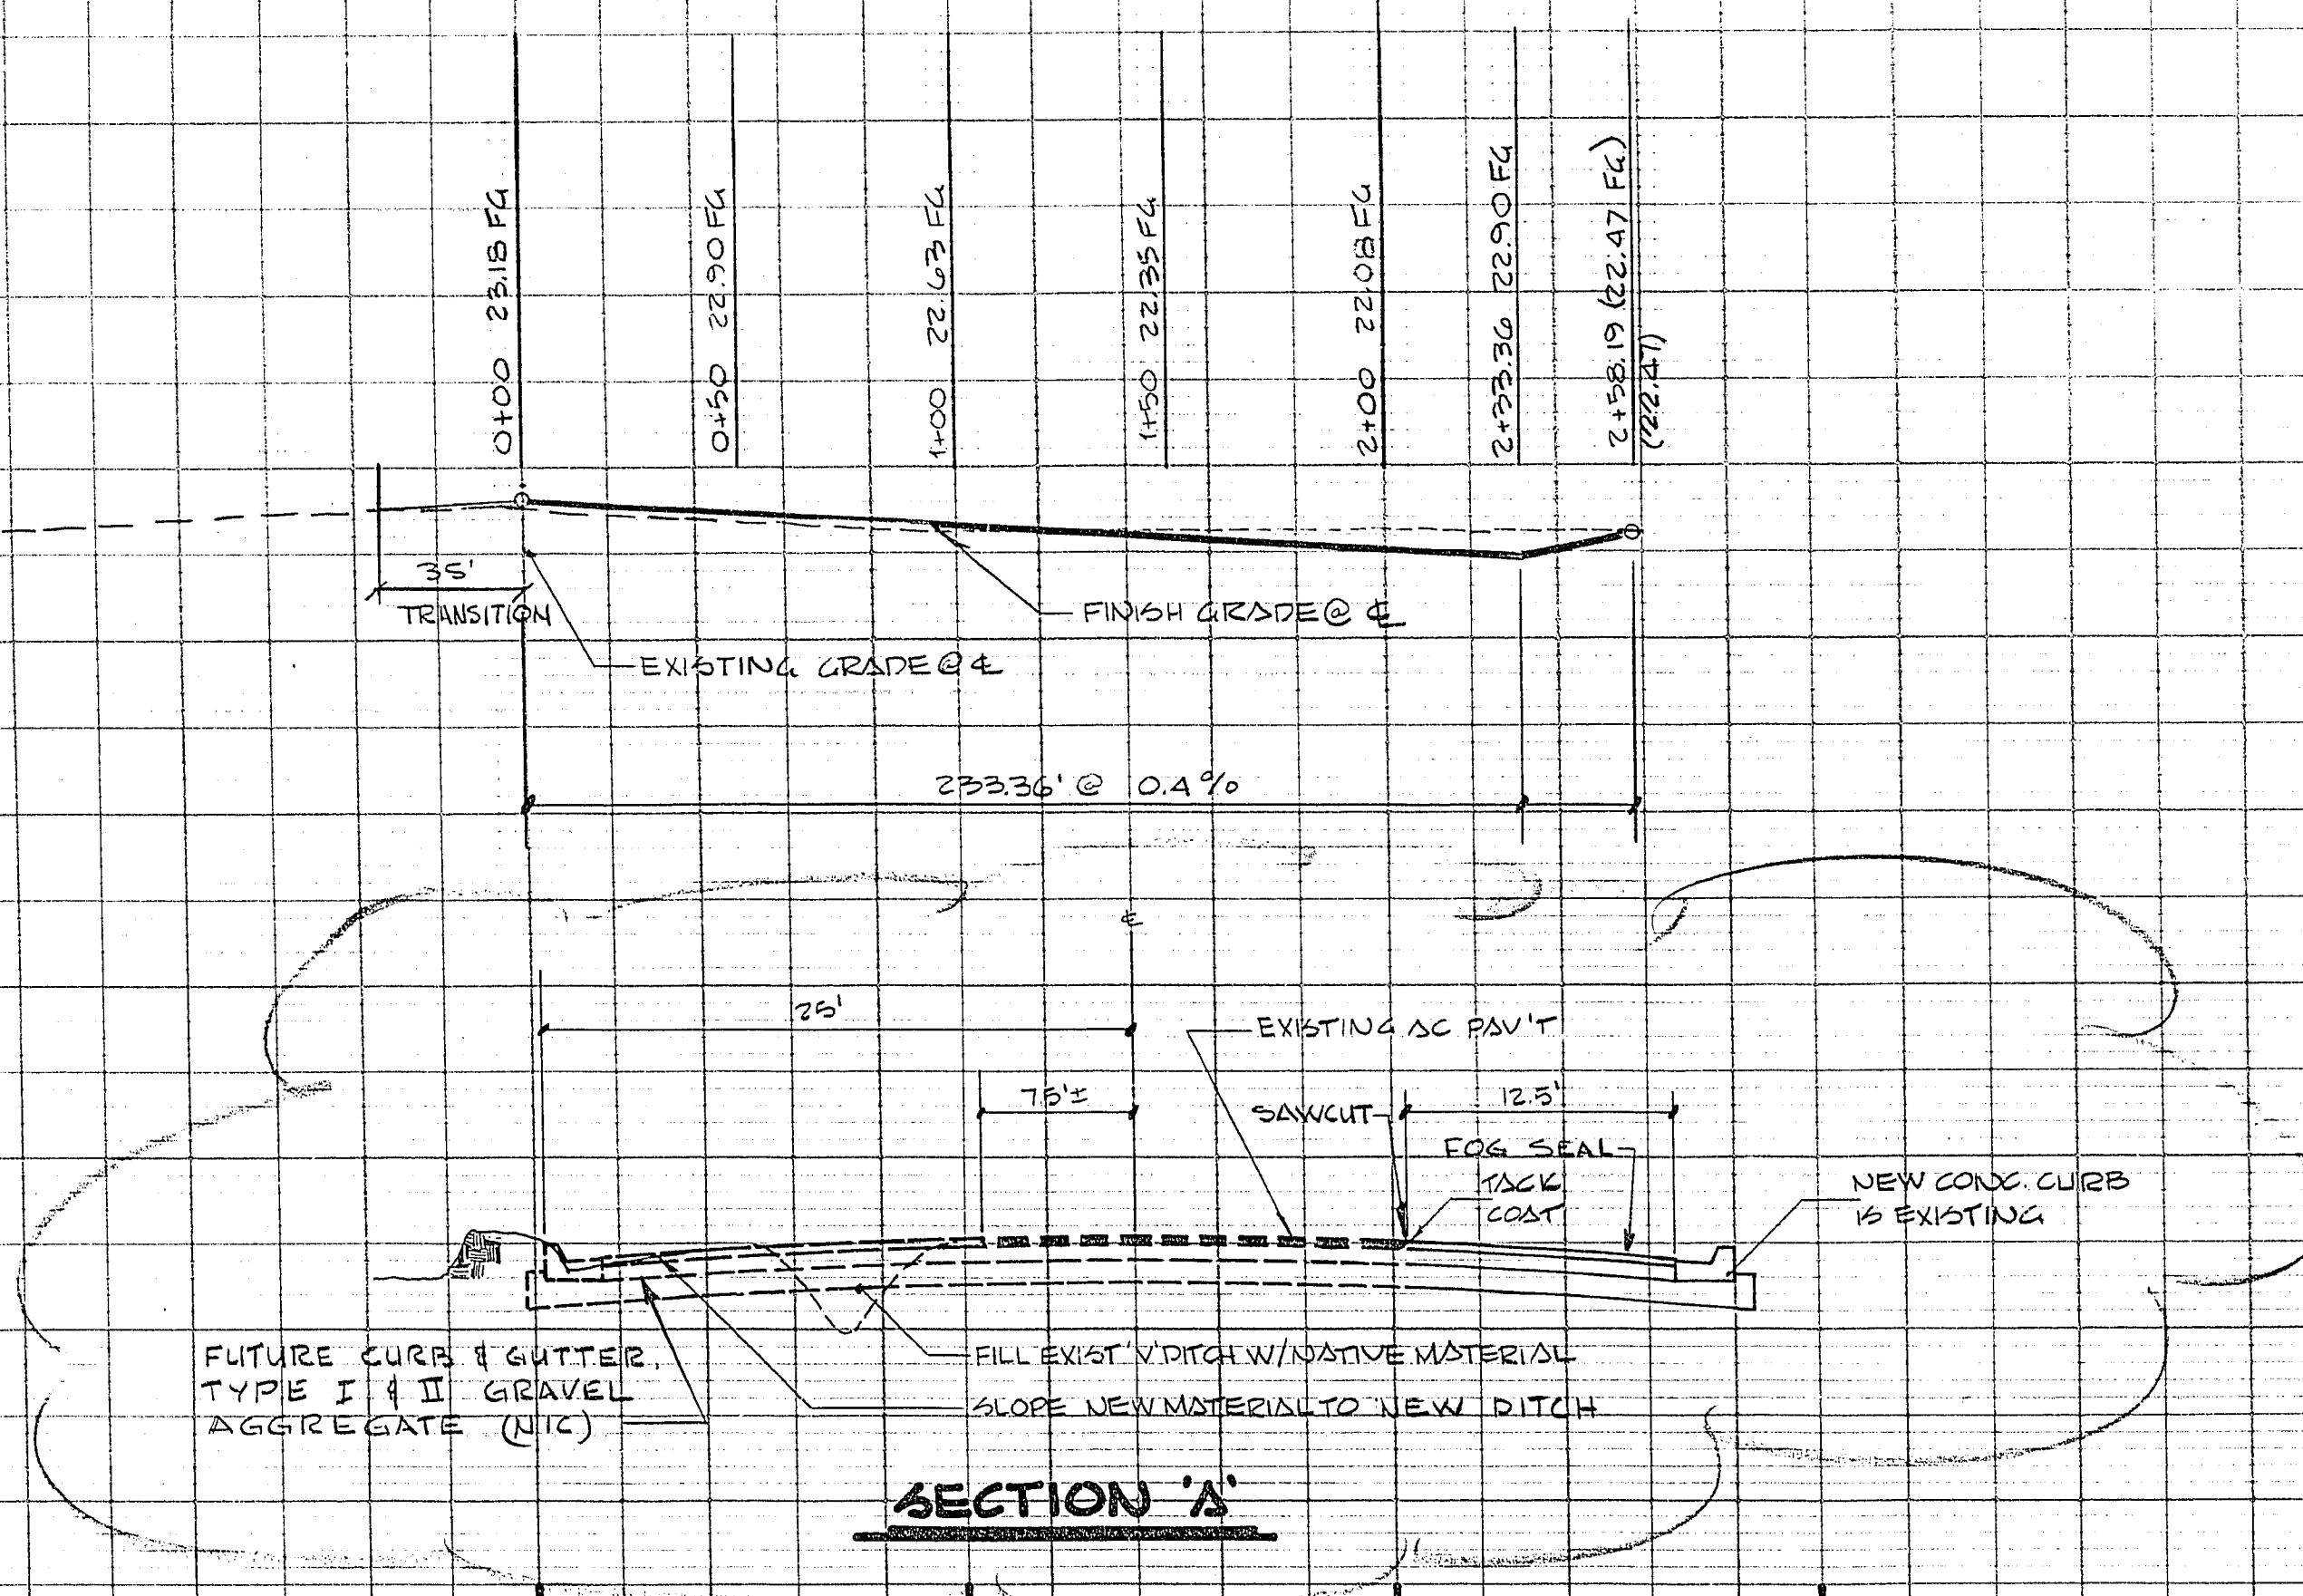

NOTE: UTILITY INFORMATION WAS
DERIVED FROM DATA FURNISHED BY
UTILITY COMPANIES CONTRACTOR
MUST CONFIRM LOCATION OF UTILITIES
BEFORE COMMENCING EXCAVATION.

DATE NO. 11/24/76	DESIGN DRAWN JJP	CHECK RJP	SCALE AS SHOWN
DATE NOV 1976			
DESIGN DRAWN JJP			
CHECK RJP			
SCALE AS SHOWN			
PREPARED FOR: ZICK & SHARP ARCHITECTS			
APPROVALS			
CIVIL ENGINEERS BAUGHMAN & TURNER			
LAND SURVEYORS			
CITY OF LAS VEGAS ENGINEERING DEPT.			
CITY OF LAS VEGAS ELECTRICAL DEPT.			
NEVADA POWER CO.			
CLV ELECTRICAL COORDINATOR			
SECTION 36, TOWNSHIP 30 SOUTH, RANGE 6 EAST, M. 08. & M. 09. CLARK COUNTY			
SHEET 1			
PROJ. NO. PB 110 P52			