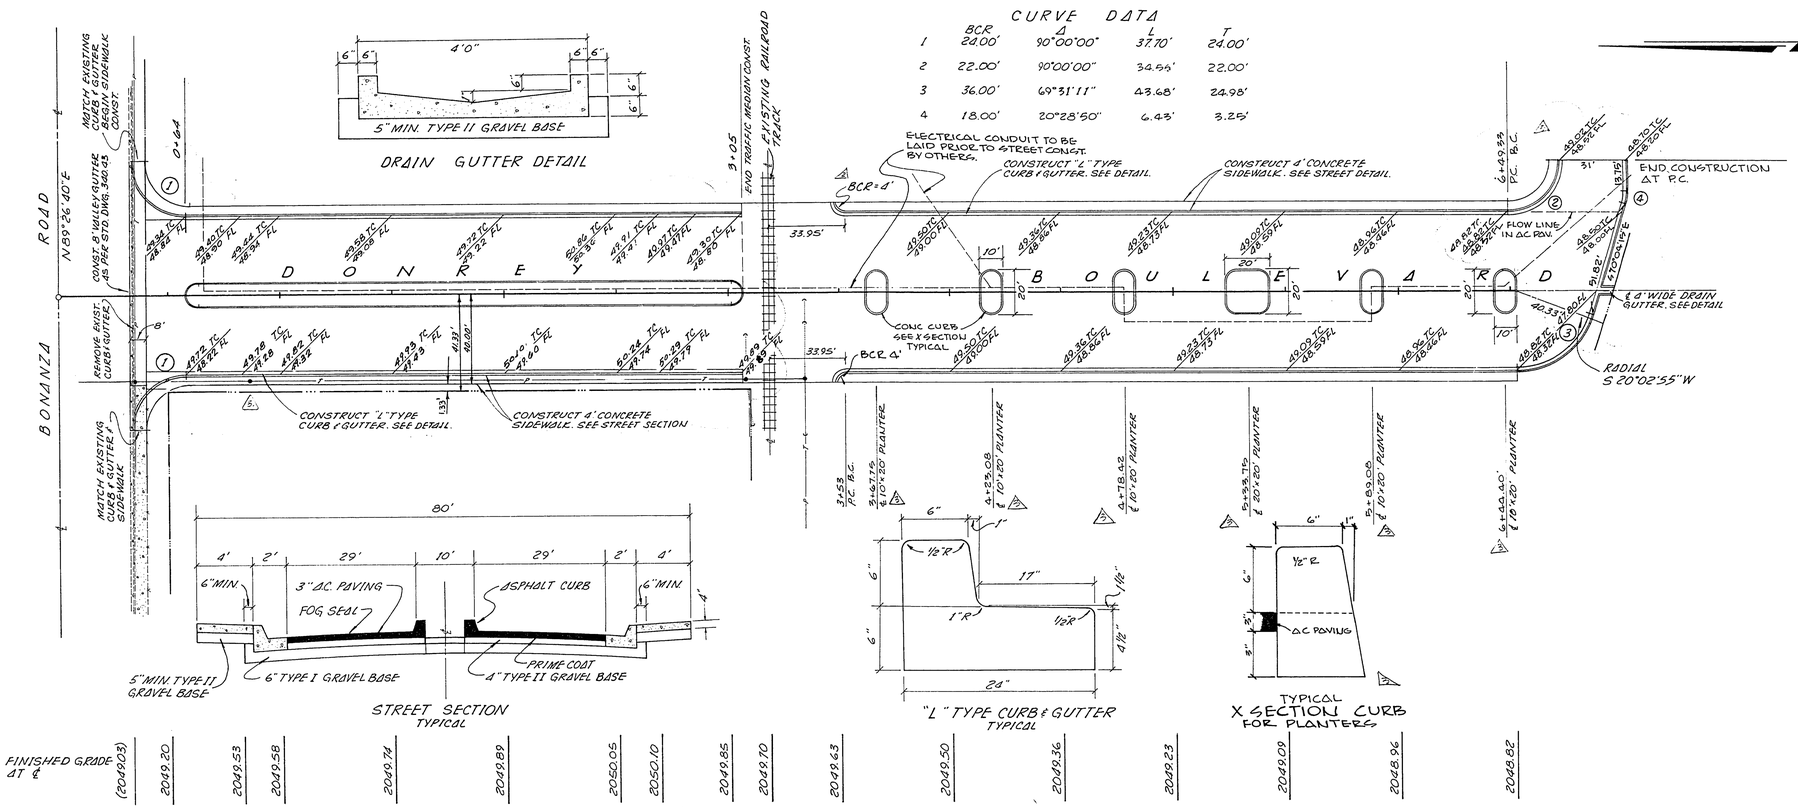

REVISIONS
△ 11-19-69
△ 11-25-69
△ 5-8-70

△ 5-8-70 REVISED GRADES BETWEEN STATION 0+00 TO 3+05
△ 11-19-69 STREET RELOCATED 1.35' EAST OF PROPERTY LINE
△ 11-25-69 REMOVE DRIVEWAY CUTS

DWG. 69-101
SHT. 3 of 4

APPROVALS

REV 1/14/70
Rev 1-22-70
JDD 1-29-70

STATE OF NEVADA
RICHARD J. BAUGHMAN
CIVIL
REGISTERED PROFESSIONAL ENGINEER

SCALE
HORIZ. 1"=30'
VERT. 1"=5'

SURVEYS & MAPPING
CONSULTING ENGINEERS—LAND SURVEYORS
536 EAST SAHARA AVENUE
PHONE 735-0230

DESIGN: RICHARD J. BAUGHMAN REG. P.E. 2162 DATE 10-30-69
CHECK DATE

STREET DESIGN
DONREY BOULEVARD
(PRIVATE ROAD)
A PORTION OF THE SW¼ SE¼
SECTION 28, TOWNSHIP 20 SOUTH, RANGE 61 EAST
CITY OF LAS VEGAS M.D.M. NEVADA

16-4-176 167 X 818 (2)