


22-5-45

SHEET NO. 128

SHEET NO. 130

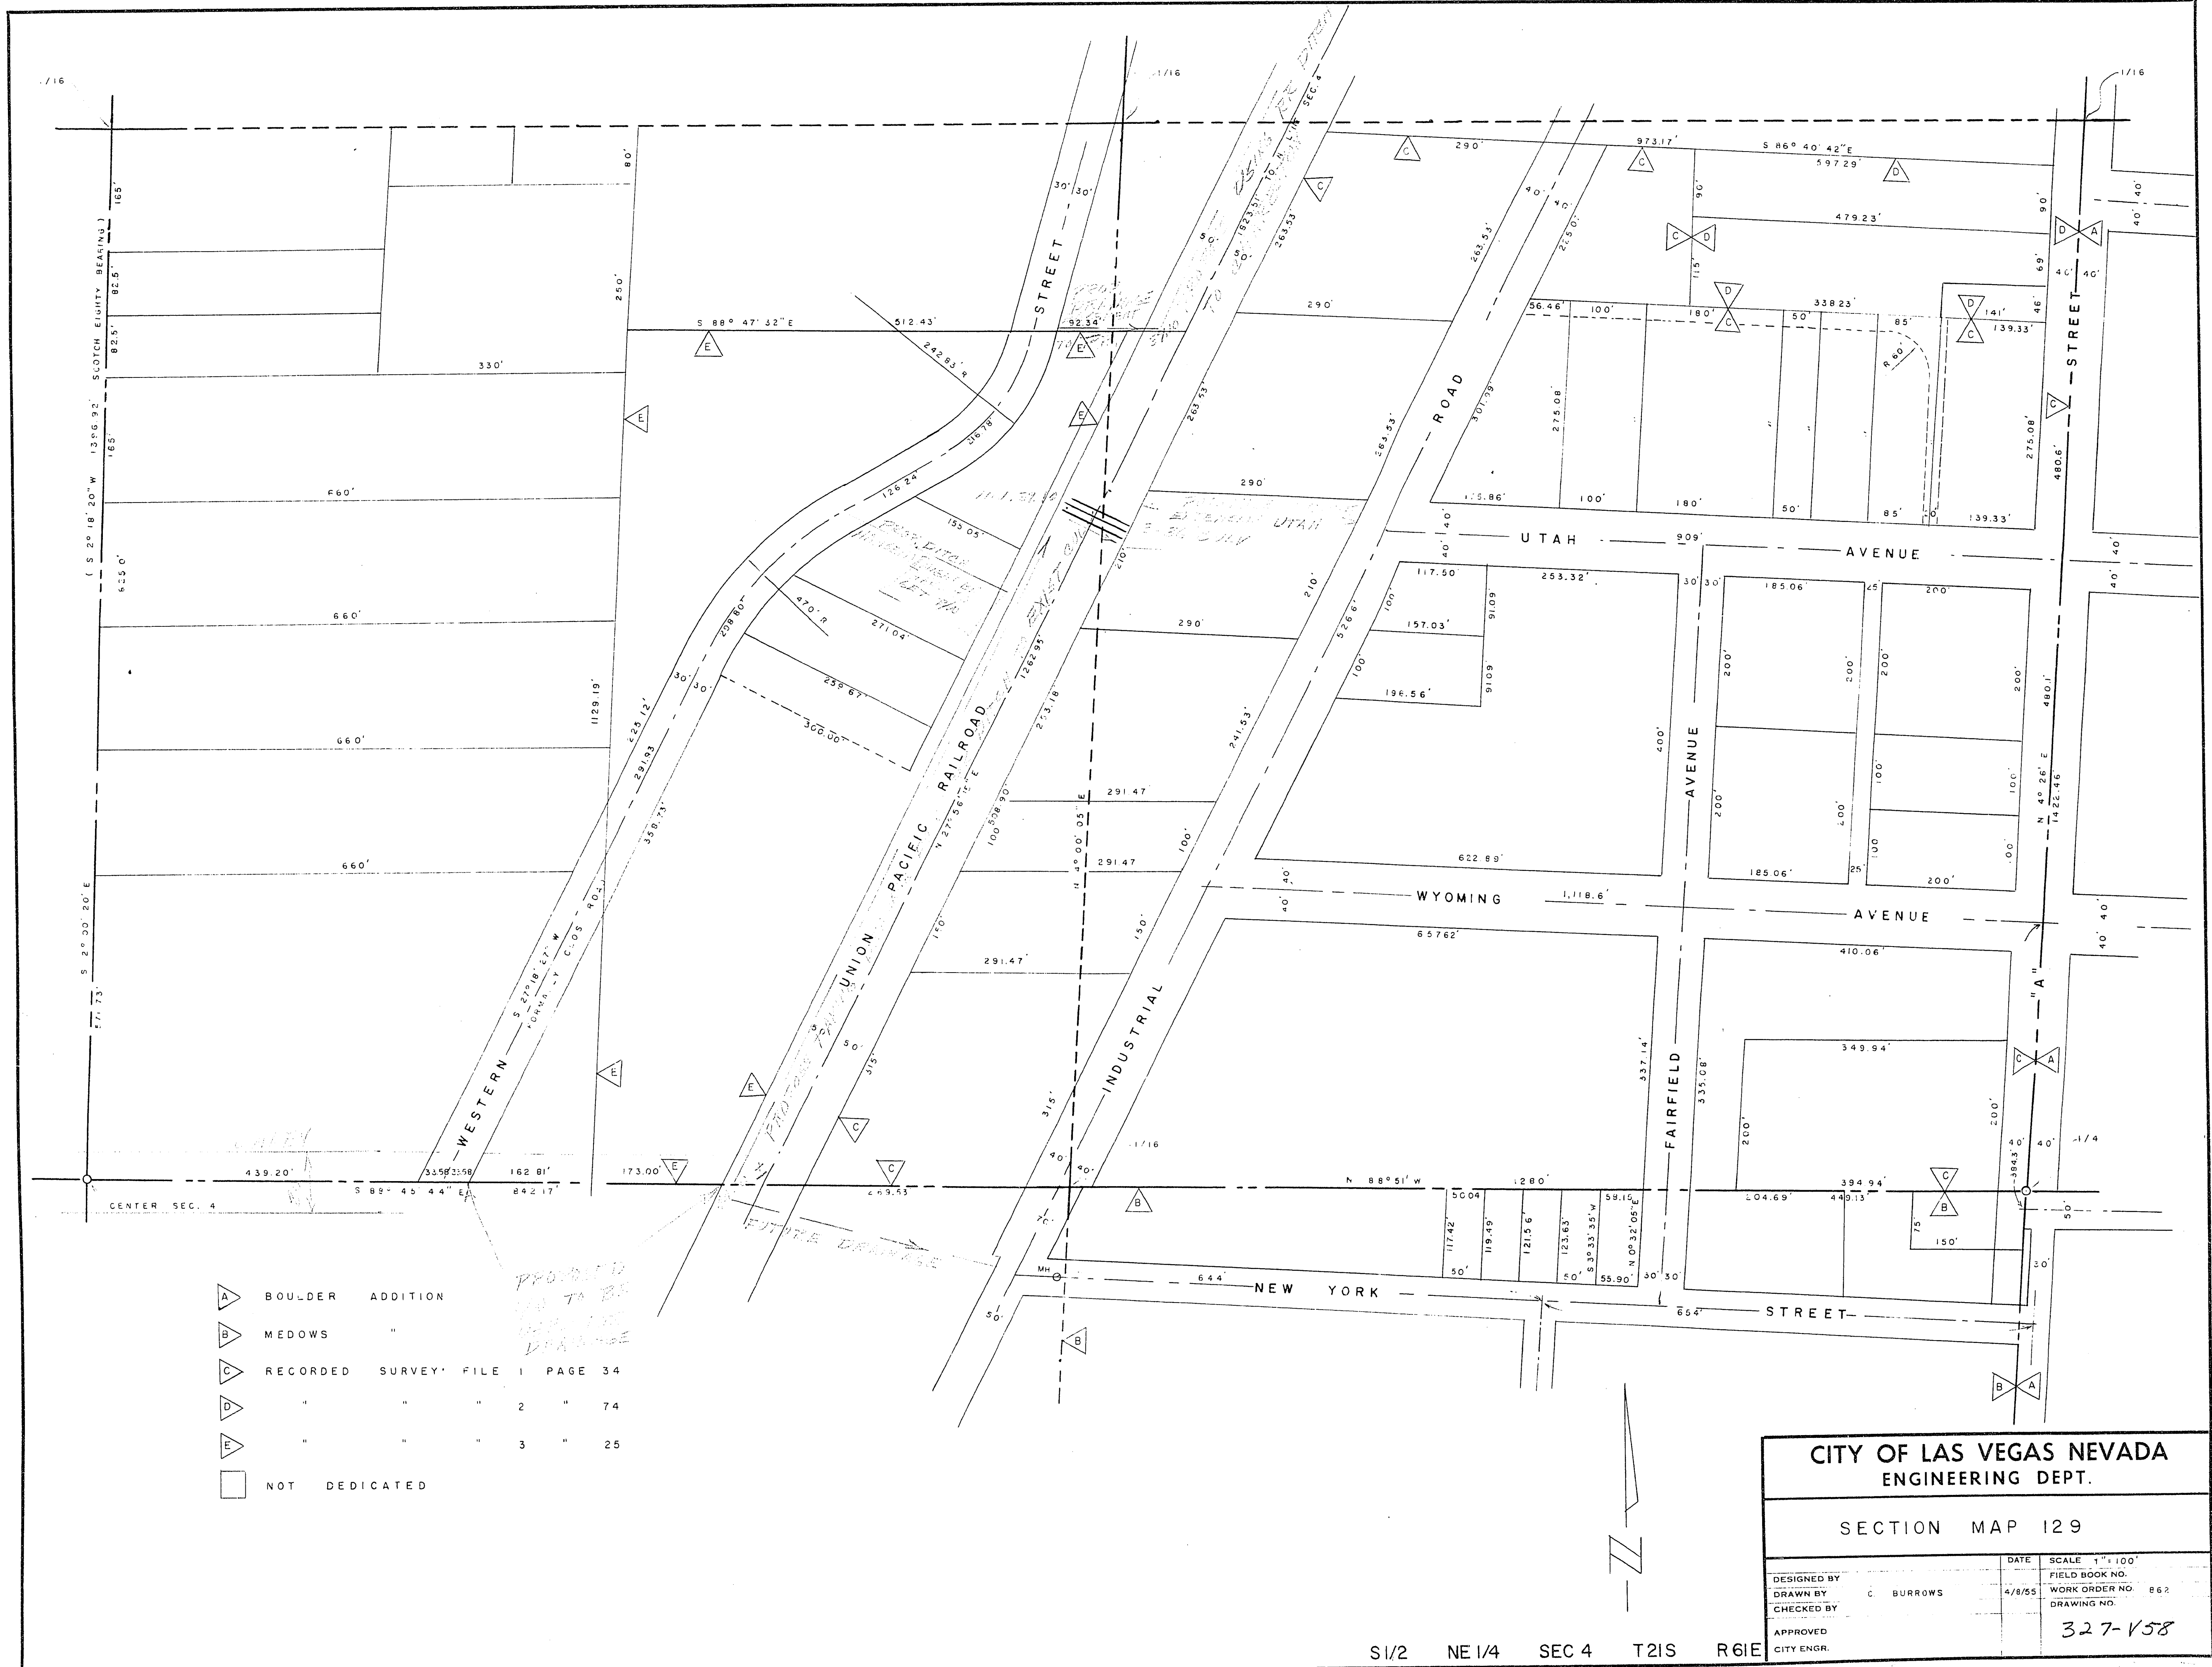

- PROPOSED
TO BE
MADE
DRAINAGE
- A BOULDER ADDITION
 - B MEADOWS
 - C RECORDED SURVEY FILE 1 PAGE 34
 - D " " " 2 " 74
 - E " " " 3 " 25
 - NOT DEDICATED

CITY OF LAS VEGAS NEVADA ENGINEERING DEPT.			
SECTION MAP 129			
DESIGNED BY	DATE	SCALE 1"=100'	
DRAWN BY C. BURROWS	4/8/55	FIELD BOOK NO.	
CHECKED BY		WORK ORDER NO. 862	
		DRAWING NO.	
APPROVED			327-V58
CITY ENGR.			

S1/2 NE 1/4 SEC 4 T21S R61E