

LAKE TONOPAH APARTMENTS

CLV. DWG. NO. 107-V2428




EXISTING 6' HIGH C.M.U WALL ALONG PROPERTY LINE.

SIERRA NEVADA BOOK 09, PAGE 49






EXISTING 5' HIGH C.M.U WALL ALONG PROPERTY LINE.

MATCHLINE SEE SHEET 7 OF 15

MATCHLINE SEE SHEET 7 OF 15

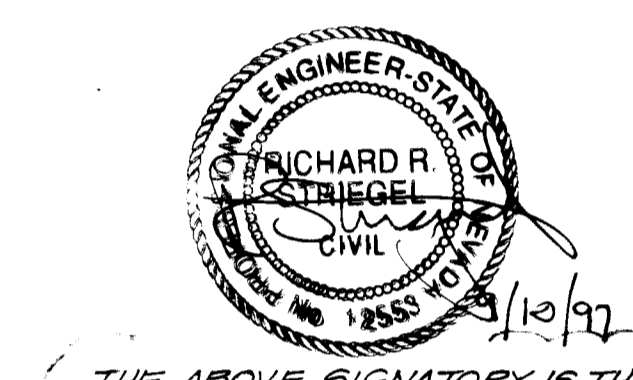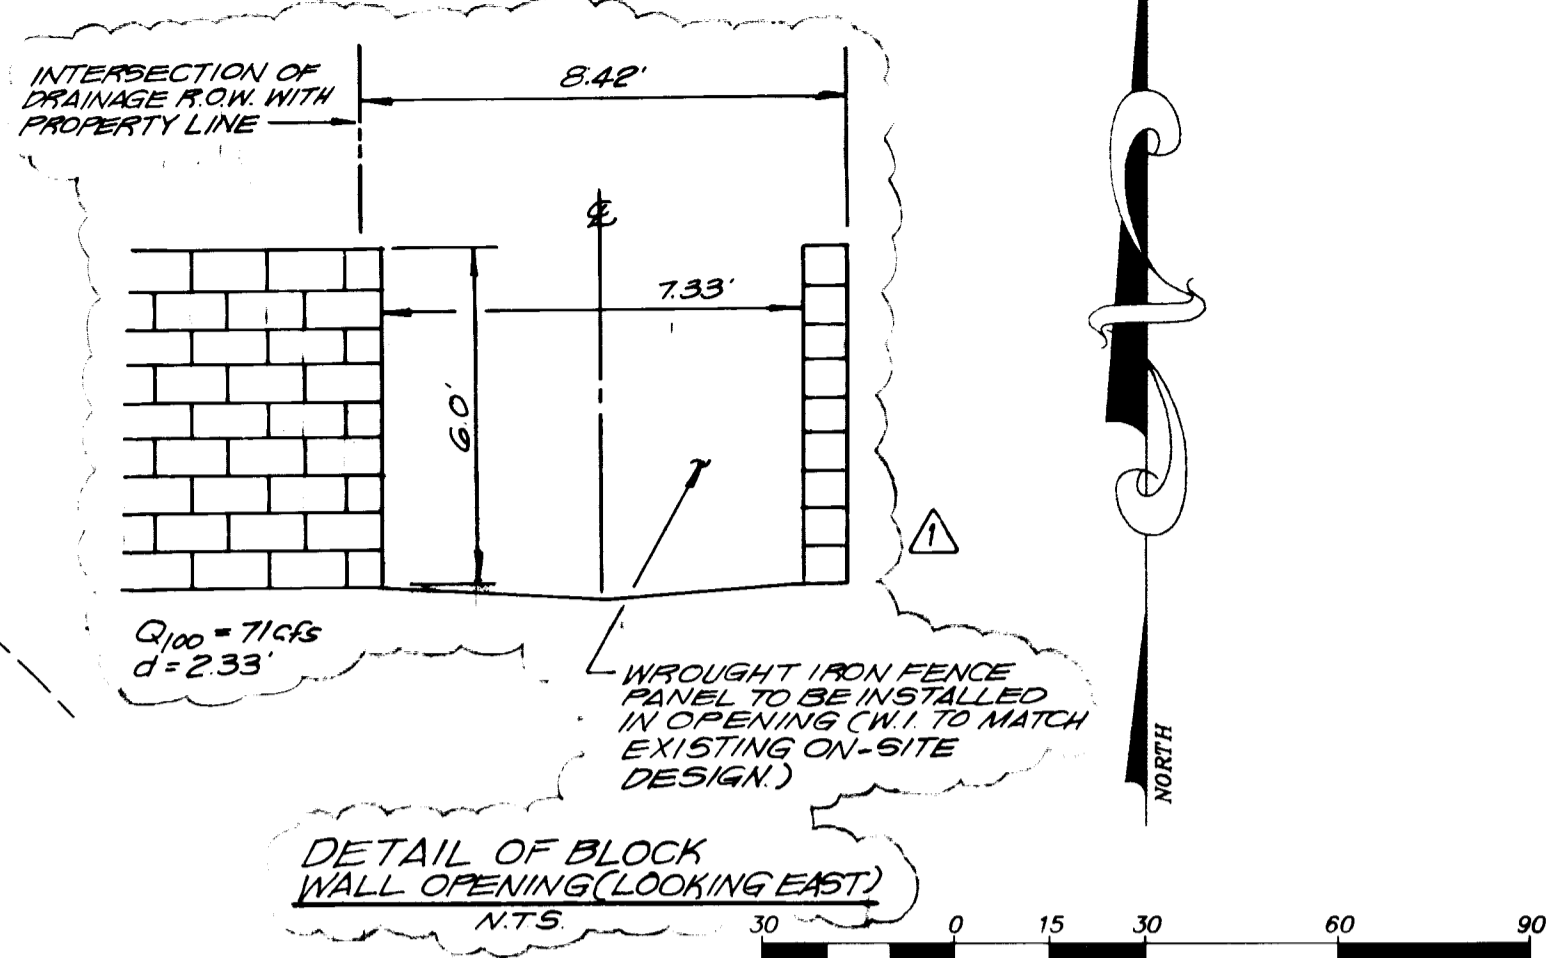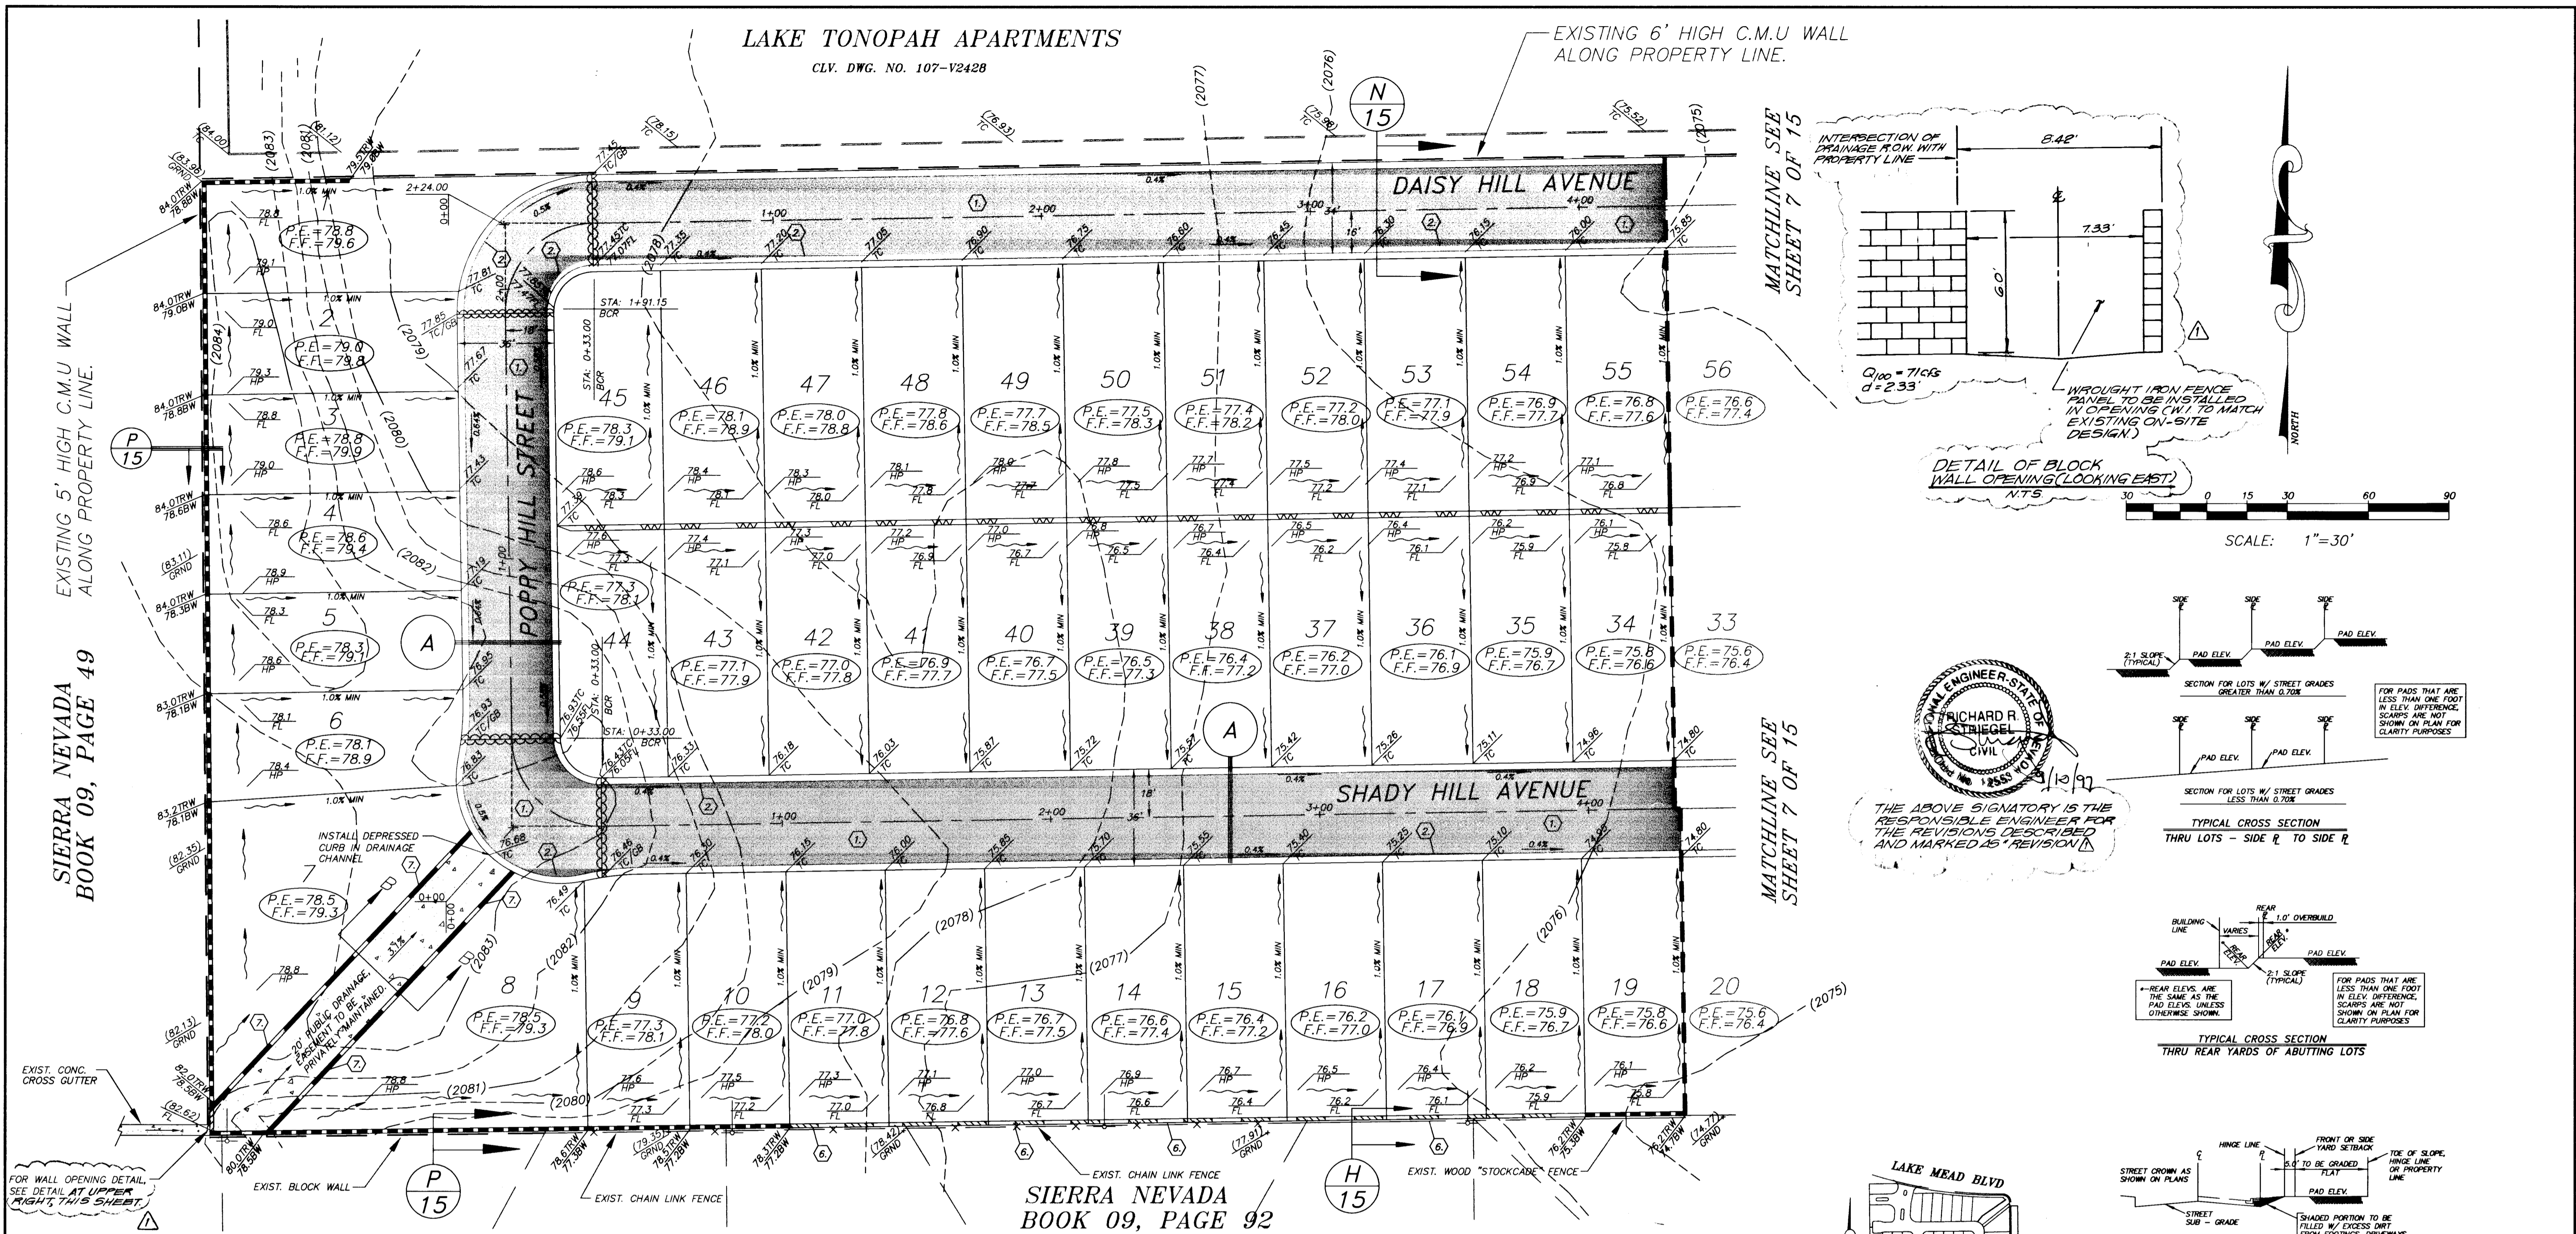


THE ABOVE SIGNATORY IS THE RESPONSIBLE ENGINEER FOR THE REVISIONS DESCRIBED AND MARKED AS REVISION.

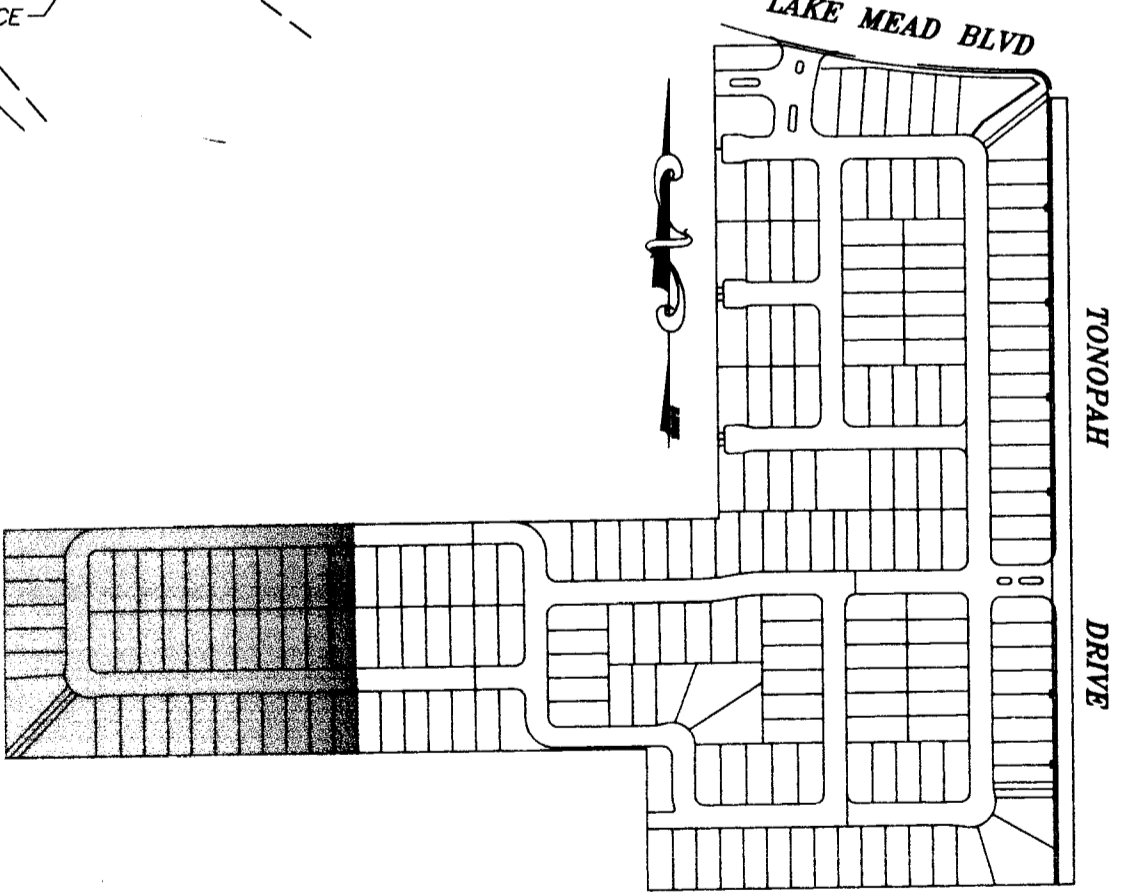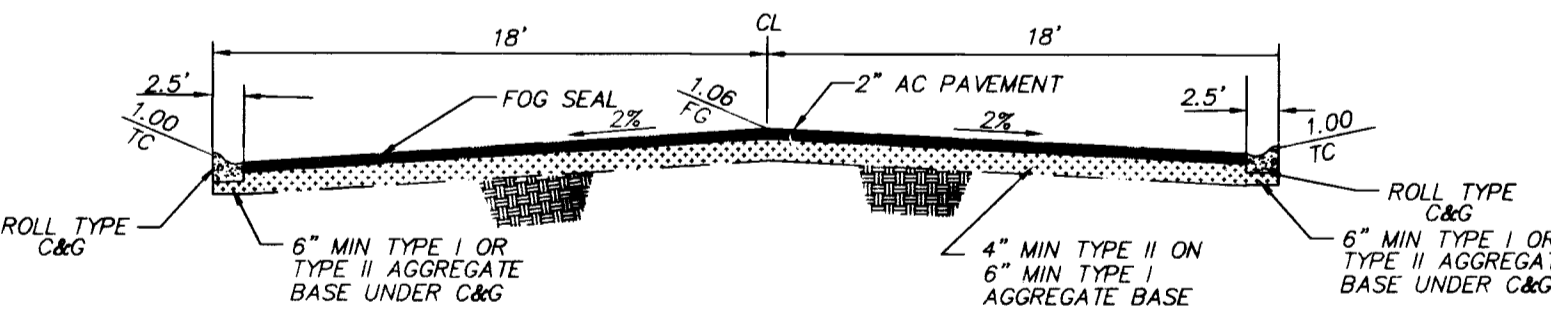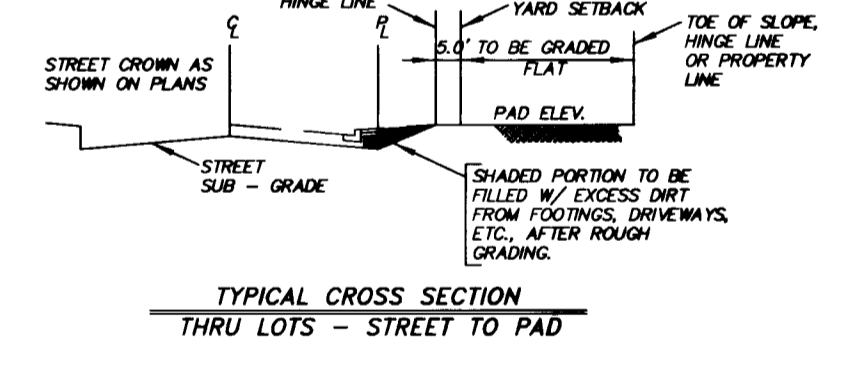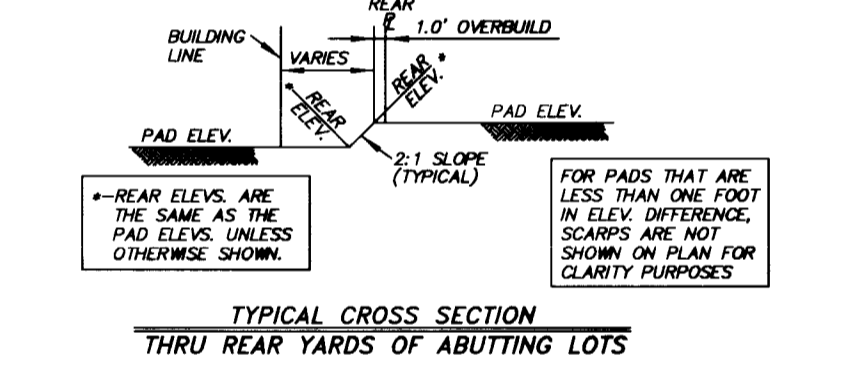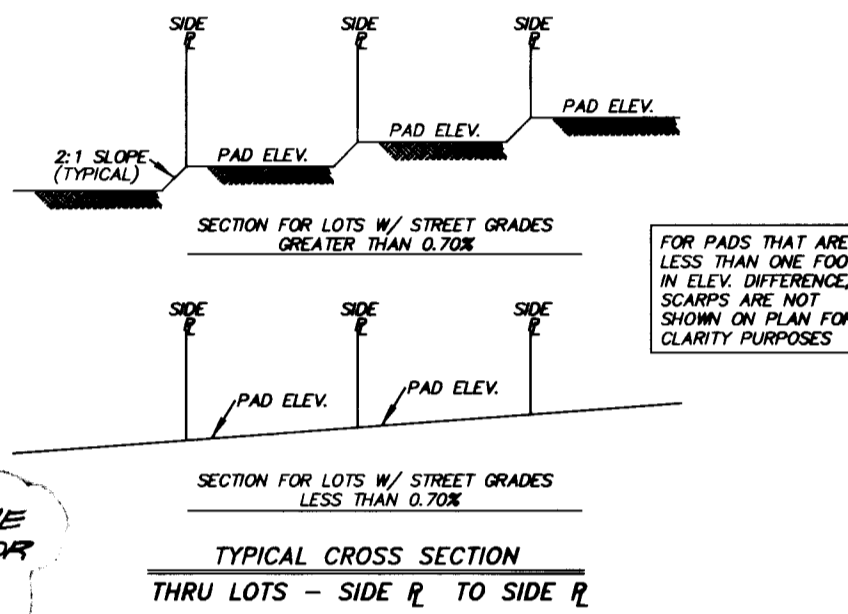

KEY MAP N.T.S.

BENCHMARK
 BM CLV - #46 2LV01-29NES, WEST CURB TONOPAH DRIVE, 200 +/- VEGAS DRIVE. ELEV. = 2064.82 FT (NAVD88)

I CERTIFY THAT THIS GRADING PLAN IS IN CONFORMANCE WITH THE APPROVED DRAINAGE STUDY ON FILE AT THE CITY OF LAS VEGAS FOR THIS PROJECT.

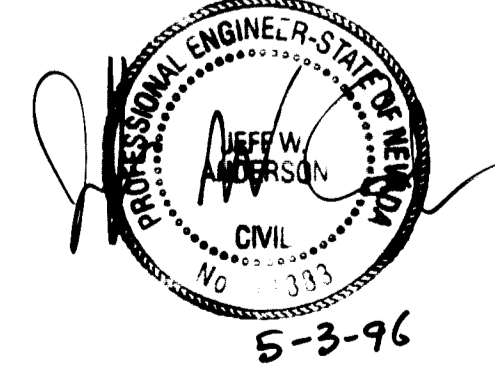

KEY NOTES:

- CONSTRUCT 2" AC PAVING OVER 4" MINIMUM TYPE II ON 6" MINIMUM TYPE I BASE OR AS APPROVED AND COORDINATED WITH CLV INSPECTOR.
- CONSTRUCT 30" ROLL TYPE CURB PER CITY STANDARDS. SEE UNIFORM STANDARD DWG. NO. 217A.
- CONSTRUCT 6' HIGH DECORATIVE MASONRY BLOCK WALL PER CITY OF LAS VEGAS STANDARDS AND SPECIFICATIONS.
- CONSTRUCT 6' PERIMETER WALL WITH 2' FOOTING, AND SOLID GROUT FIRST (3) COURSES ABOVE GROUND.

LEGEND:

- 100.00 DESIGN ELEVATION
- (100.00) EXISTING ELEVATION
- AC ASPHALTIC CONCRETE
- TC TOP OF CURB
- FG FINISH GRADE
- GB GRADE BREAK
- HP HIGH POINT
- PE PAD ELEVATION
- FF FINISH FLOOR
- FL FLOWLINE
- TRW TOP OF RETAINING WALL
- BW BOTTOM OF WALL
- SLOPE DIRECTION
- SWALE/FLOWLINE
- GRADE BREAK
- 2:1 SCARP (TYPICAL)
- EXISTING CONTOUR (1' INTERVAL)
- EXISTING CONTOUR (5' INTERVAL)
- CONSTRUCTION NOTES
- LOT NUMBER
- PAD ELEVATION
- SHADED AREA DENOTES PROPOSED PAVING AREA
- 6' PERIMETER WALL
- 6' FLOOD WALL - PER KEY NOTE 7
- RETAINING WALL WITH 6' HIGH PERIMETER WALL
- EXIST. POWER POLE

NOTES:

- HUNSAKER & ASSOCIATES SHALL BE NOTIFIED IMMEDIATELY OF ANY DISCREPANCIES IN THE PLANS OR CONDITIONS IN THE FIELD.
- ALL WORK TO BE PERFORMED OUTSIDE OF THE PROJECT BOUNDARY AND ON PRIVATE PROPERTY SHALL NOT BE PERFORMED UNTIL WRITTEN PERMISSION AND EASEMENT HAVE BEEN OBTAINED FROM THE OFFSITE OWNER.
- ALL WORK PERFORMED WITHIN THE PUBLIC RIGHT-OF-WAY AND OUTSIDE THE PROJECT BOUNDARY SHALL BE PERFORMED UNDER A SEPARATE ENCROACHMENT PERMIT ISSUED BY THE CONTROLLING AUTHORITY.
- FOR AREAS THAT ARE FLATTER THAN 2:1 SLOPE, OR LESS THAN 1" ELEVATION DIFFERENCE, SCARPS ARE NOT SHOWN ON PLANS FOR CLARITY PURPOSES.
- ADD 2000' TO ALL ELEVATIONS SHOWN.
- GRADING AND STRUCTURAL SECTIONS SHALL CONFORM TO SOILS REPORT PREPARED BY WESTERN TECHNOLOGIES INCORPORATED, REFERENCE PROJECT NO. 4123.M209, DATED OCTOBER 28, 1993.

SIERRA NEVADA BOOK 09, PAGE 49

SIERRA NEVADA BOOK 09, PAGE 92

SUMMIT HILLS - UNIT 2

LAS VEGAS, NEVADA

GRADING PLAN

SCALE(H): 1" = 30'

SCALE(V): 1" = --

DES. BY: MC

DWN. BY: MC

DATE: 11/95

PROJECT NO. 1512-1

SHEET 8 OF 15

PREPARED BY: Hunsaker Associates, Inc. Planning • Engineering • Surveying

Las Vegas, NV 89101 (702) 897-1833

Las Vegas, NV 89101 (702) 897-1833

San Bernardino • San Diego • Irvine

DOCUMENT NO. 247

BIN NO. 2874RR/95

PLOT DATE: 28/ARR/95


REVISIONS

NO. DESCRIPTION BY DATE

APPR



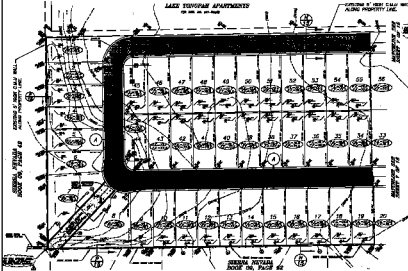












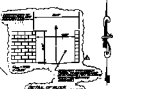

KEY MAP
N.E.A.





