

950811

01747


MONUMENTATION TIE MAP

FINAL MAP OF

SUMMIT HILLS UNIT - 1

BEING A PART OF THE SE 1/4 OF SECTION 20, T. 20 S., R. 61 E.,
M.D.M., CITY OF LAS VEGAS, CLARK COUNTY, NEVADA.

SCALE: 1" = 30'

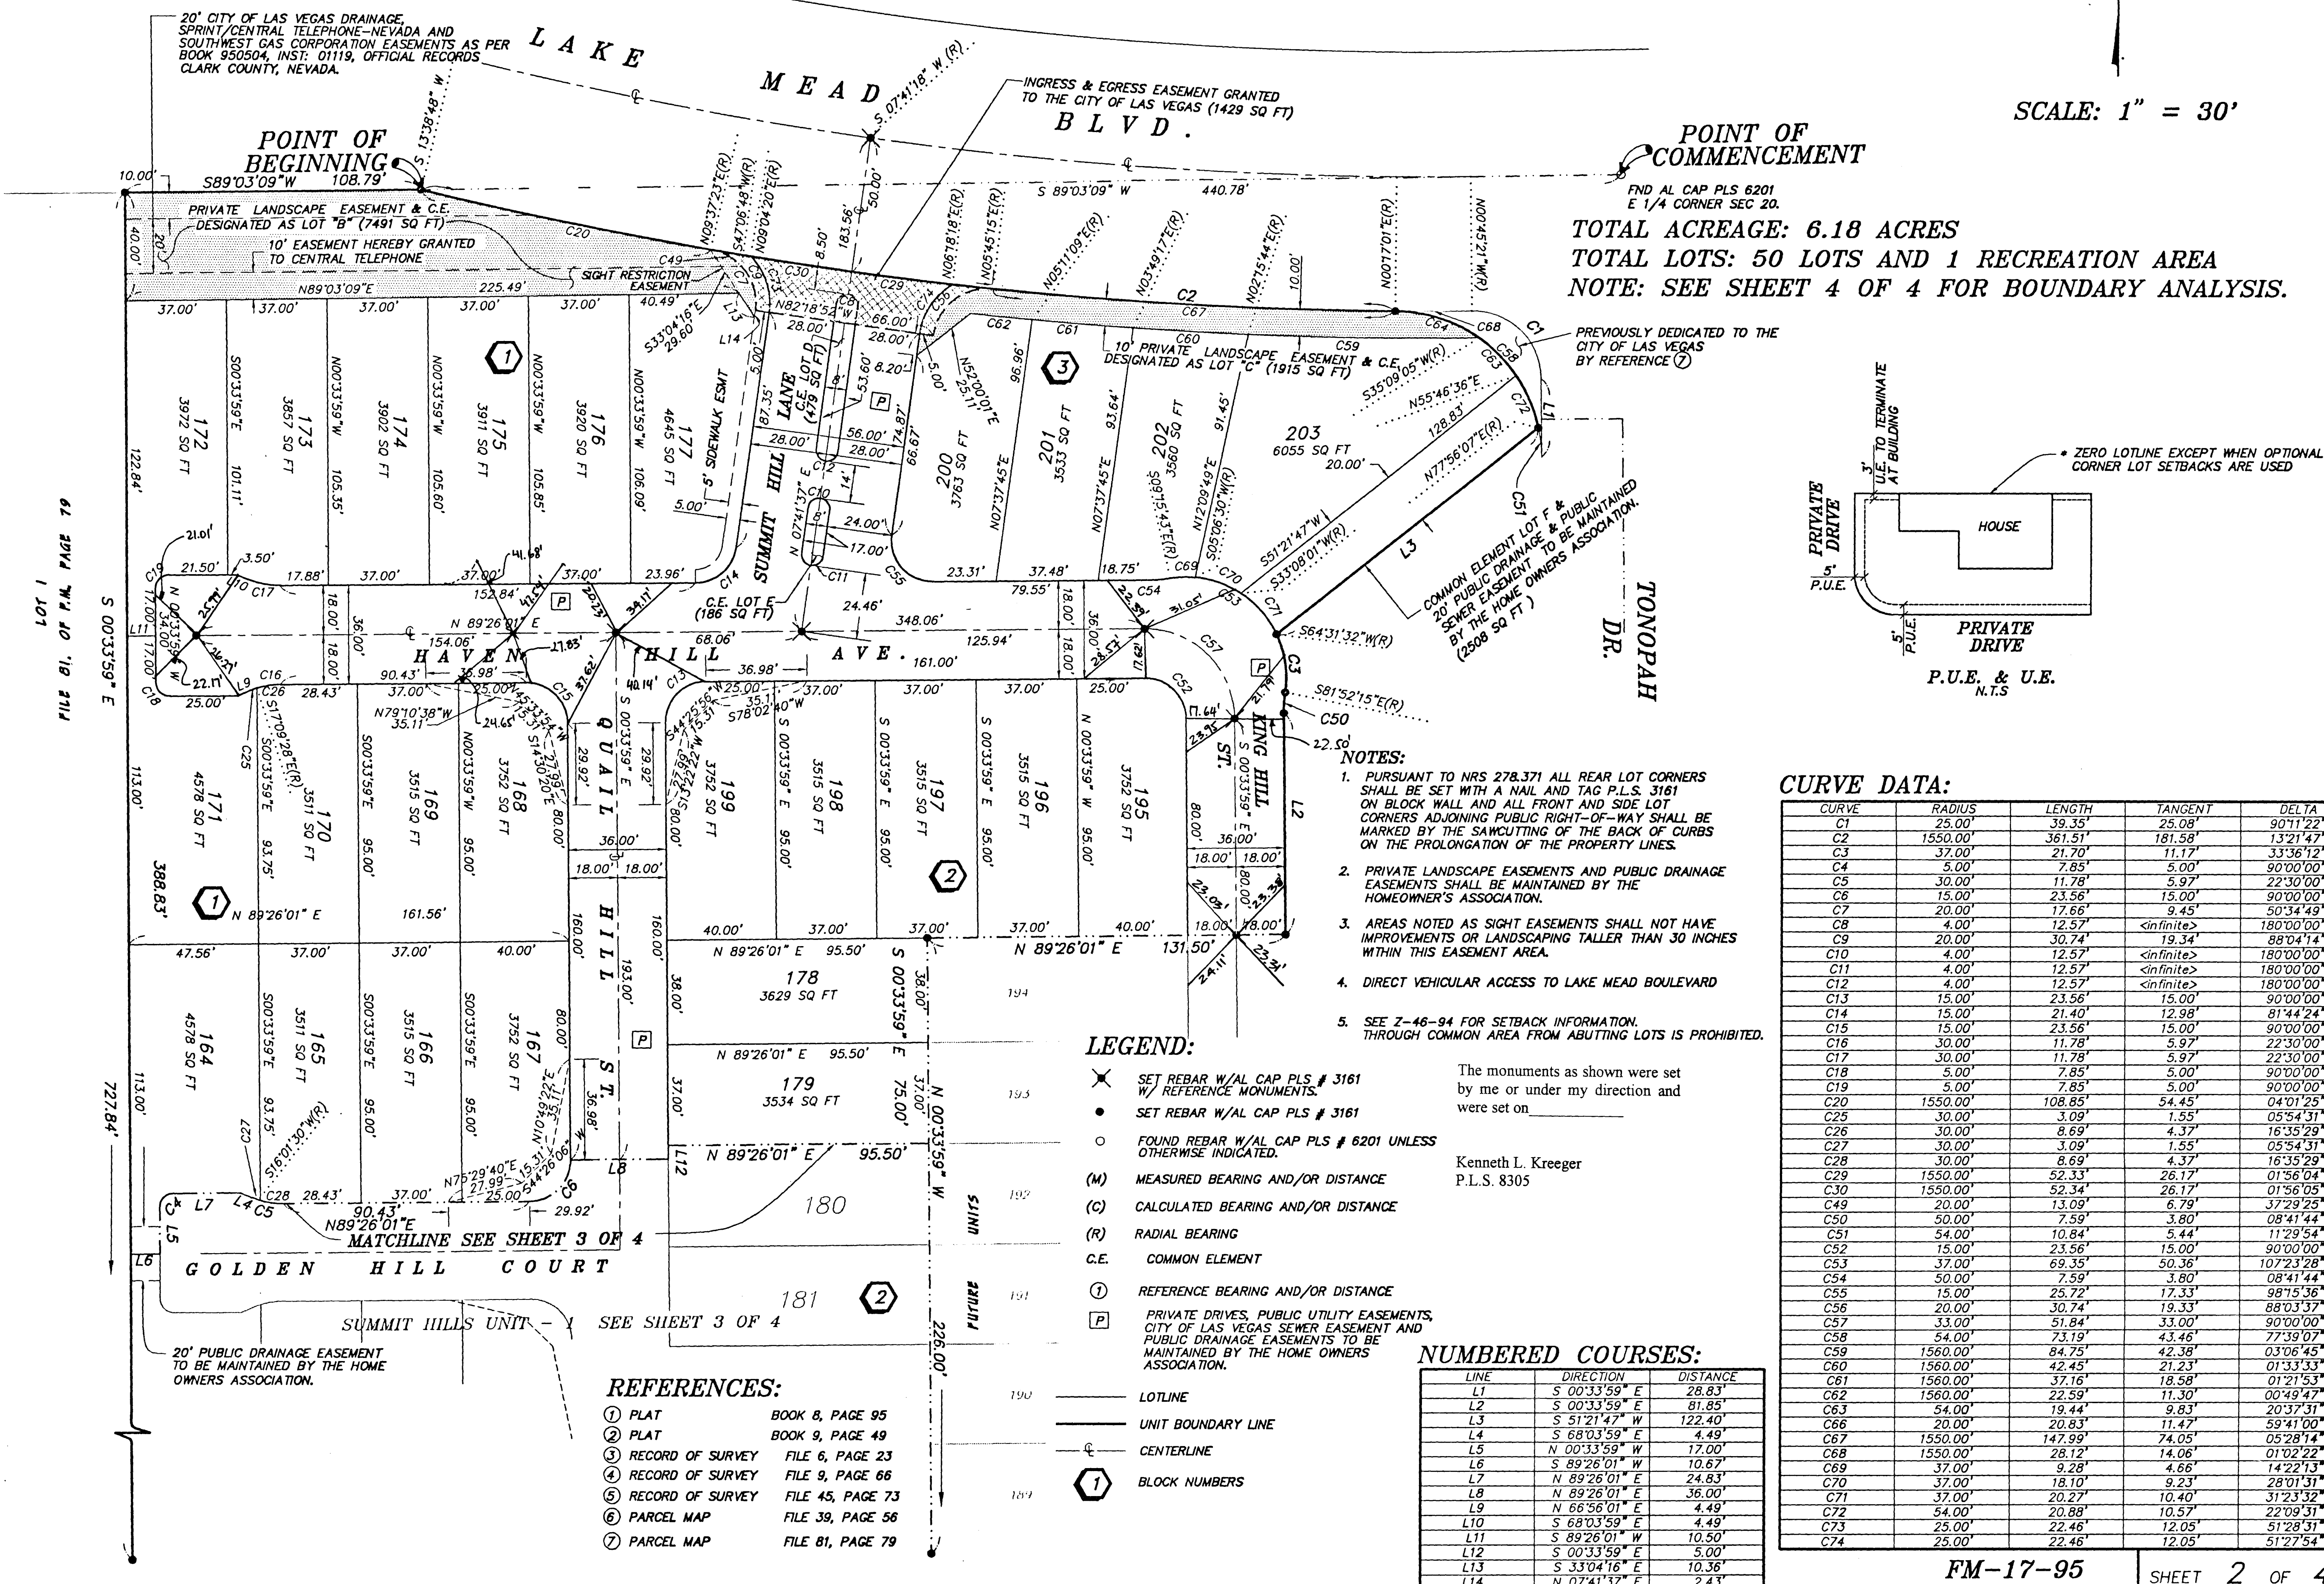

01747

FINAL MAP OF

BEING A PART OF THE SW 1/4 OF SECTION 20, T. 20 S., R. 61 E.,
M.D.M., CITY OF LAS VEGAS, CLARK COUNTY, NEVADA.

SCALE: 1" = 30'

POINT OF COMMENCEMENT
 7/4 1/2 ACRES
 TOTAL ADJACENT: 0.18 ACRES
 TOTAL LOTS: 50 LOTS AND 1 RECREATION AREA
 NOTE: SEE SHEET 4 OF 4 FOR BOUNDARY ANALYSIS



[illegible]



CURVE DATA

 FM-17-00
 PAGE 2 of 4

858-943-4