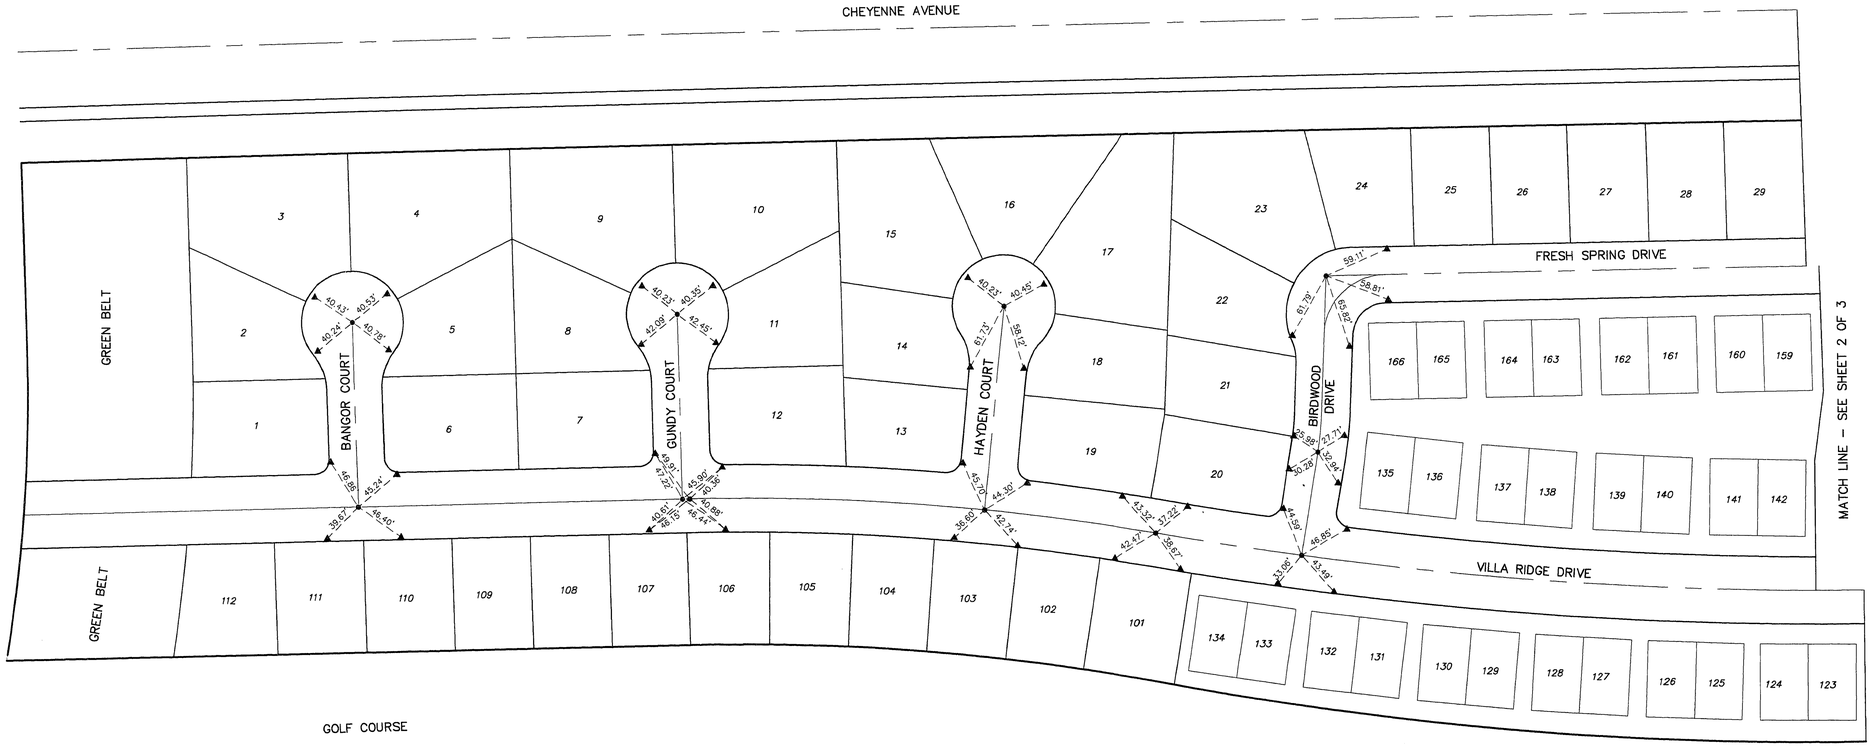

SCALE: 1" = 60'

THE BASIS OF BEARING AND ALL LOT AND CENTERLINE BEARINGS AND DIMENSIONS ARE BASED UPON THE RECORD PLAT OF SUN CITY LAS VEGAS – UNIT NO. 26, RECORDED JUNE 5, 1991, IN BOOK 49, PAGE 82, IN THE CLARK COUNTY RECORDER'S OFFICE.

- ● 5/8" REBAR WITH ALCAP PLS 6030
- ▲ 2" ALCAP STAMPED PLS 6030 WITH TIE DISTANCE
- —— — —— CENTERLINE OF ROADWAY
- – – – – – – – – – – TIE DIMENSION LINE

I, JERRY SLIGAR, A PROFESSIONAL LAND SURVEYOR IN THE STATE OF NEVADA, DO HEREBY CERTIFY THAT THE MONUMENTS HAVE BEEN SET AND THE TIE DISTANCES ESTABLISHED AS SHOWN HEREON.

PROFESSIONAL LAND SURVEYOR · STATE OF NEVADA · JERRY SLIGAR · No. 6030 · 12 June 1992

JERRY SLIGAR
PROFESSIONAL LAND SURVEYOR
NEVADA CERTIFICATE NO. 6030

CENTERLINE TIE SHEET

058-41141-26
10-6-143

DESCRIPTION	DRAWN BY	ALCA APPROVAL	PUBLIC AGENCY	DATE
REVISED				

SCALE (H) 1" = 60'
SCALE (V)
DRAWN BY FAIRES
SEC. 17/18, T.19 S., R.61 E.

ALCA
ENGINEERING & SURVEYING, INC.
820 S. VALLEY VIEW BOULEVARD
LAS VEGAS, NEVADA 89107-4411
(702) 878-3358 FAX: 878-1092

JOB TITLE
SUN CITY LAS VEGAS – UNIT NO. 26
A PLANNED DEVELOPMENT
CENTERLINE TIE SHEET
CLARK COUNTY, NEVADA

.DWG NAME SC26-1CT
.DWG DATE 06/12/92

JOB NO.
91020103

SHEET 1 OF 3