



MATCH LINE - SEE SHEET 2 OF 3

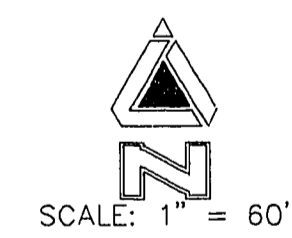

THE BASIS OF BEARING AND ALL LOT AND CENTERLINE BEARINGS AND DIMENSIONS ARE BASED UPON THE RECORD PLAT OF SUN CITY LAS VEGAS - UNIT NO. 26, RECORDED JUNE 5, 1991, IN BOOK 49, PAGE 82, IN THE CLARK COUNTY RECORDER'S OFFICE.

- 5/8" REBAR WITH ALCAP PLS 6030
- ▲ 2" ALCAP STAMPED PLS 6030 WITH TIE DISTANCE
- CENTERLINE OF ROADWAY
- - - - TIE DIMENSION LINE

I, JERRY SLIGAR, A PROFESSIONAL LAND SURVEYOR IN THE STATE OF NEVADA, DO HEREBY CERTIFY THAT THE MONUMENTS HAVE BEEN SET AND THE TIE DISTANCES ESTABLISHED AS SHOWN HEREON.

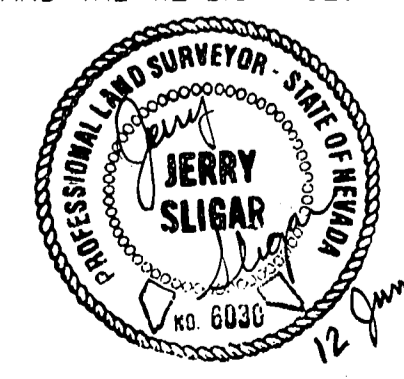

JERRY SLIGAR  
PROFESSIONAL LAND SURVEYOR  
NEVADA CERTIFICATE NO. 6030

**CENTERLINE TIE SHEET**

058-4141-26  
10-6-148

DATE	
DESCRIPTION	
DRAWN BY	J.A.C. APPROVAL
DATE	

SCALE (H) 1" = 60'  
SCALE (V)  
DRAWN BY FAIRES  
SEC. 17/18, T. 19 S., R. 61 E.

**ALCA**  
ENGINEERING & SURVEYING, INC.  
820 S. VALLEY VIEW BOULEVARD  
LAS VEGAS, NEVADA 89107-4411  
(702) 878-3358 FAX: 878-1092

JOB TITLE	SUN CITY LAS VEGAS - UNIT NO. 26 A PLANNED DEVELOPMENT CENTERLINE TIE SHEET	NEVADA
DWG NAME	SC26-1CT	
DWG DATE	06/12/92	
JOB NO.	91020103	
SHEET	1 OF 3	