

ESTIMATED QUANTITIES

	ONSITE	OFFSITE
8" VCP	2768 LF	115 LF
10" VCP	0 LF	271 LF
MANHOLES	18 EA	2 EA


SCALE
HORIZ. 1" = 40', VERT. 1" = 4'

APPROVALS

LAS VEGAS CITY ENGINEER DATE

J. D. ...
LAS VEGAS FIELD ENGINEER DATE

SANITATION SUPT. DATE

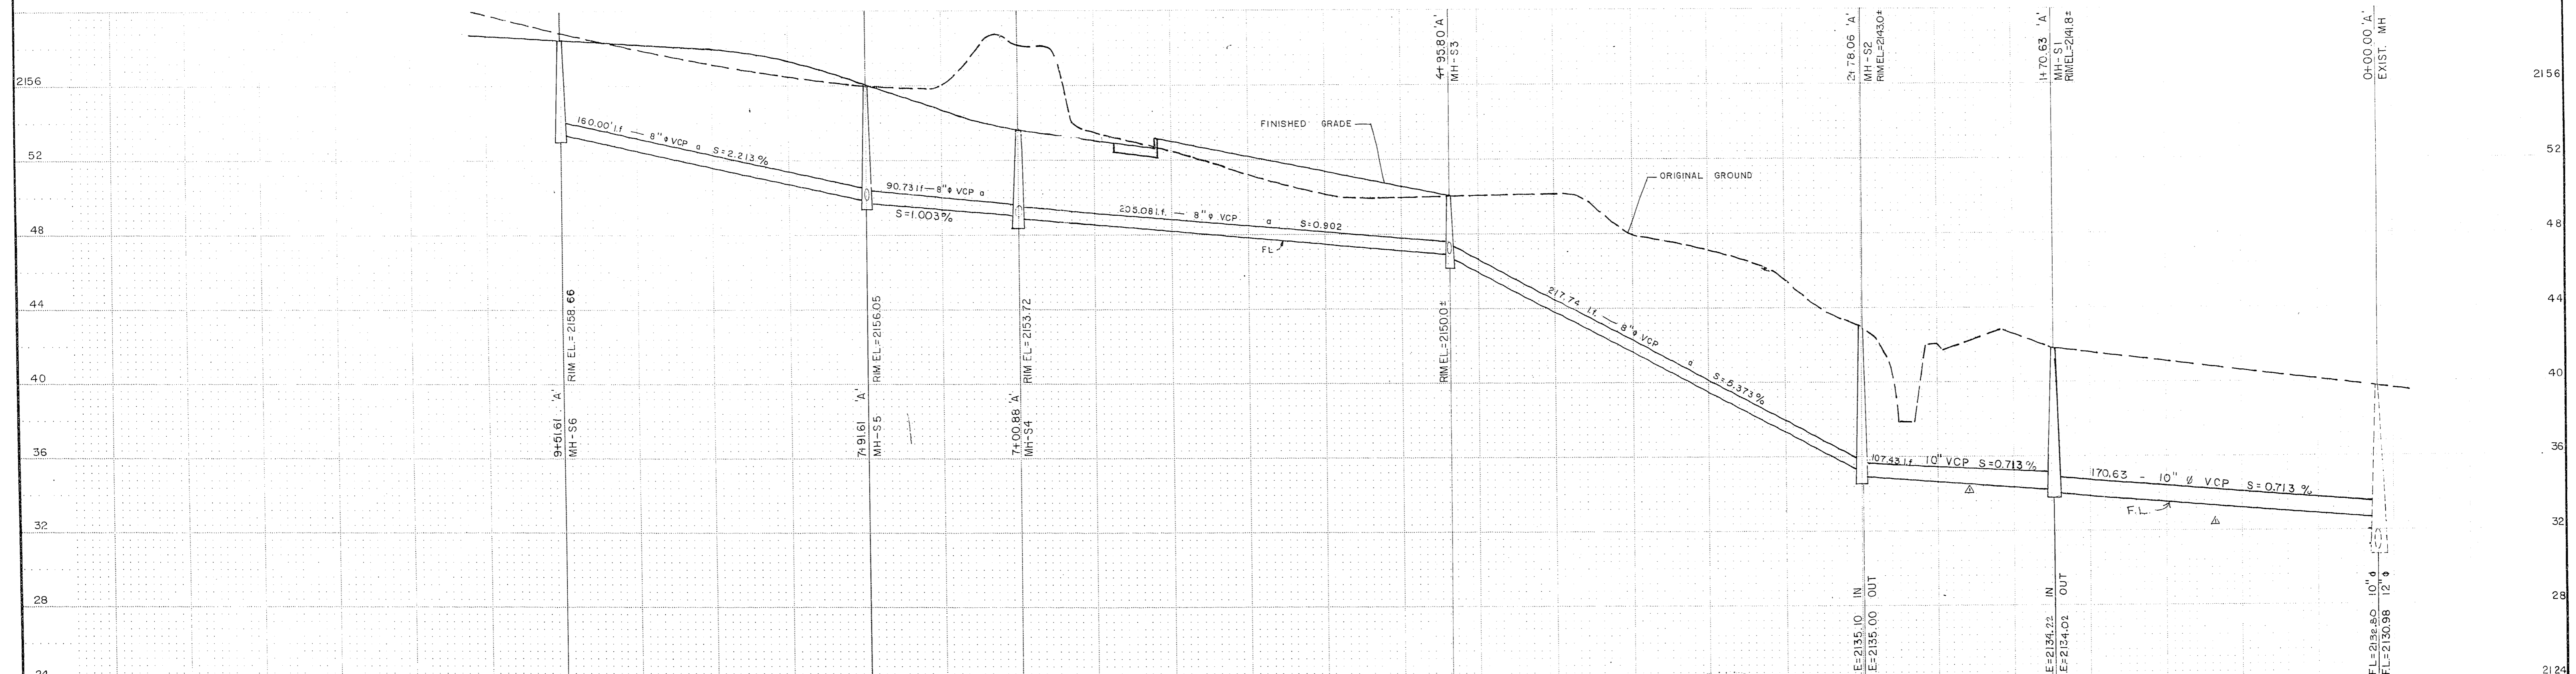

NO.	DESCRIPTION	DATE
1	RAISE LINE - EXIST. MH-S2 7/4	

SUNDOWN, UNIT 1
SANITARY SEWER


Portion of the NW 1/4 of the SE 1/4 of Section 31, T20S, R61E, M.D.B. & M.

APPROVED: *Dwight Wagoner*

LAS VEGAS CONSULTING ENGINEERS / PLANNERS
SPARKS, NEVADA · SEATTLE, WASHINGTON · LAS VEGAS, NEVADA

NEVADA

JOB NO. 271013
DESIGNED RDS
DRAWN DRC
COMP. _____
CHECKED RDS/RDB
DATE MAY 1972
SHEET NO. 10
OF 15 SHEETS

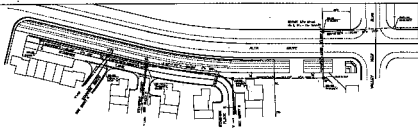






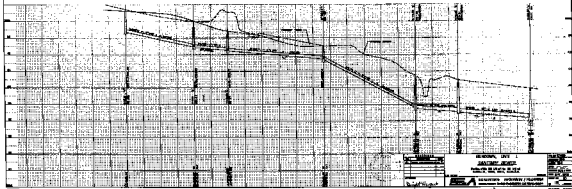



