



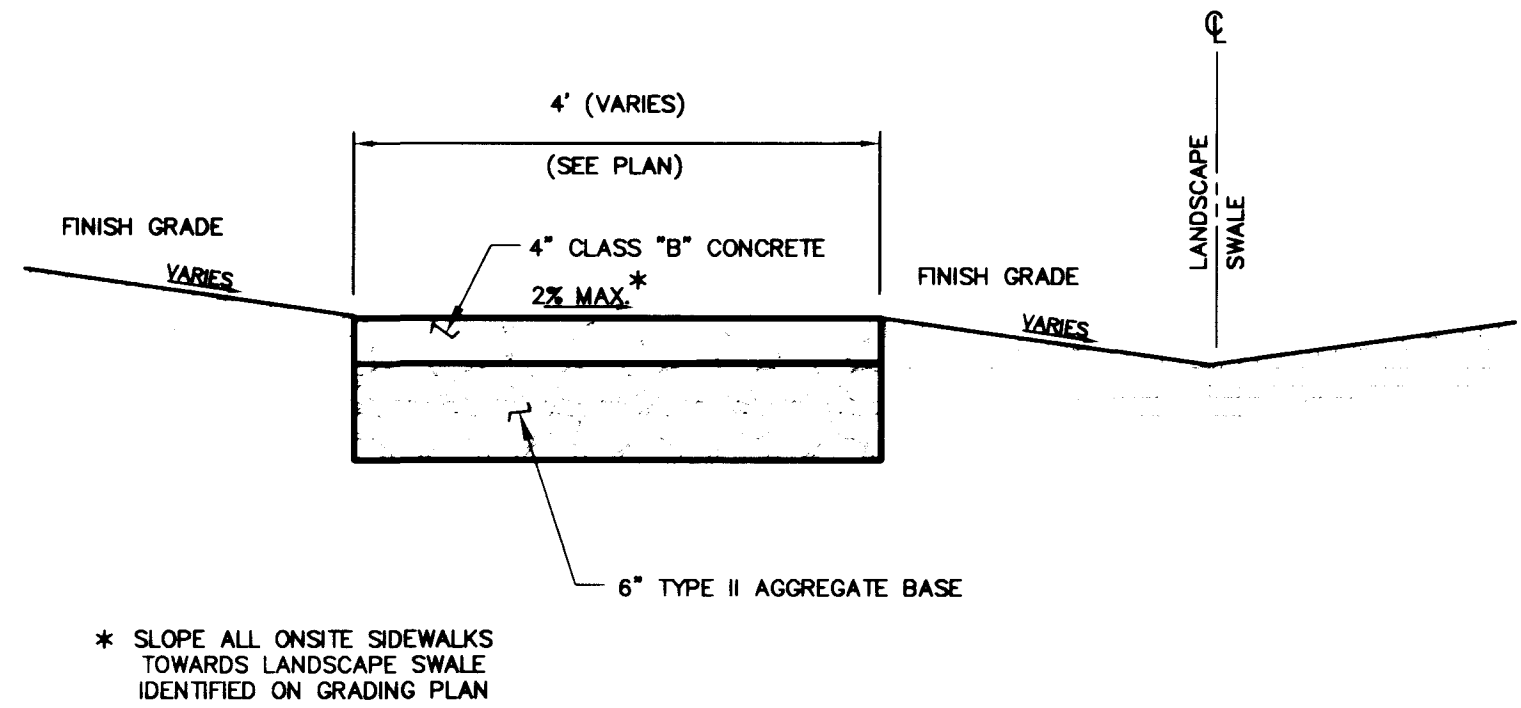


TYPICAL SIDEWALK - ONSITE

NO SCALE

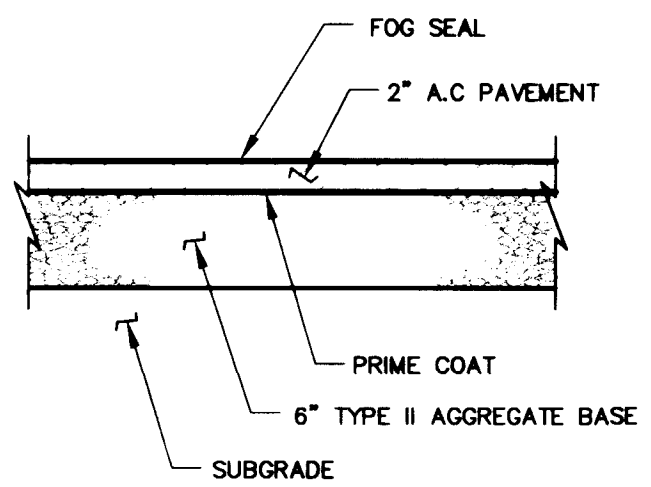


TYPICAL ONSITE A.C. PAVEMENT DETAIL

NO SCALE

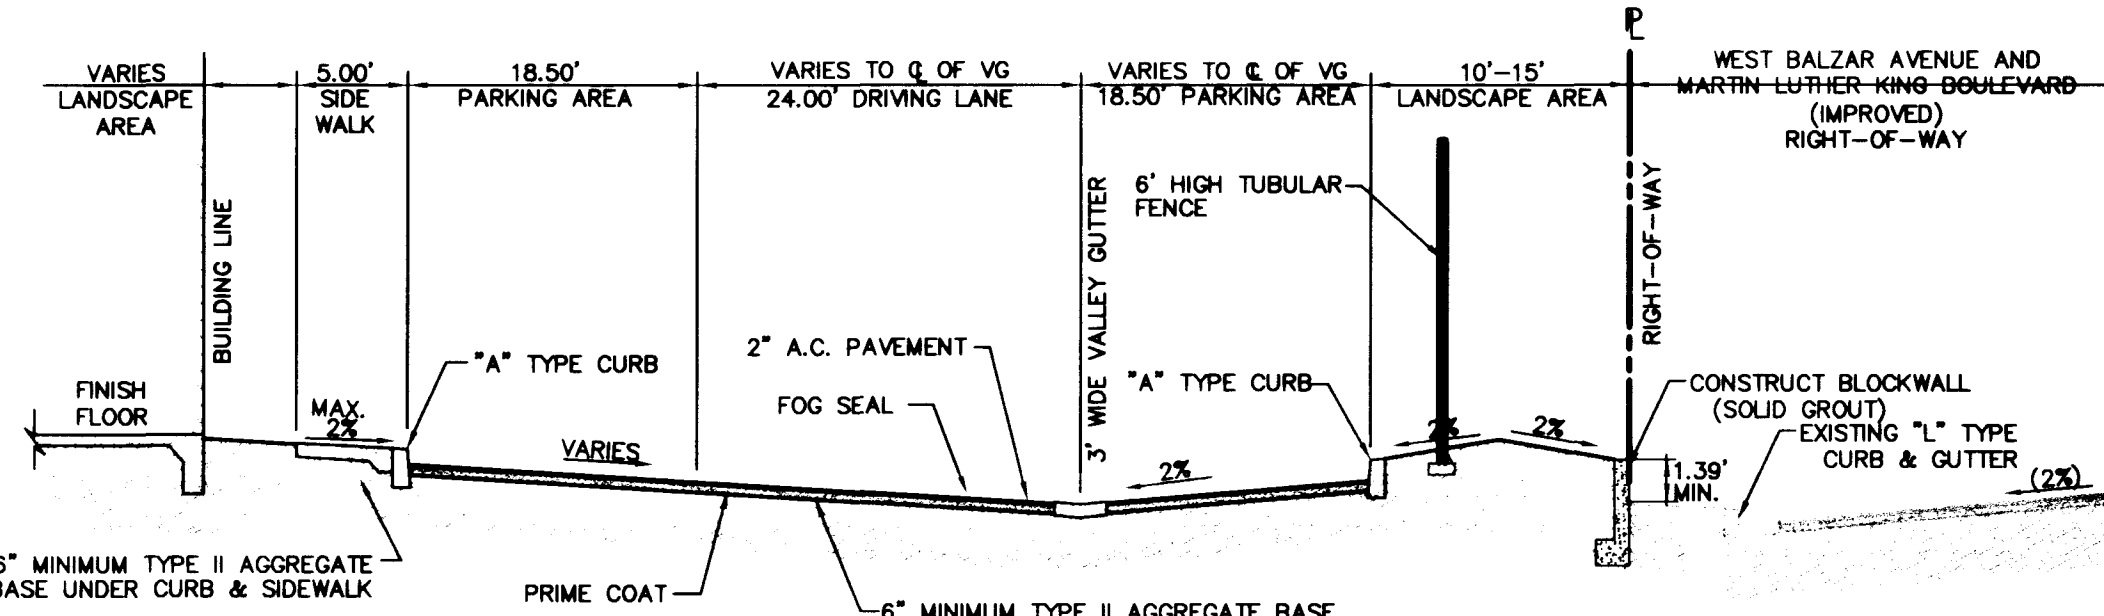


SECTION

NO SCALE

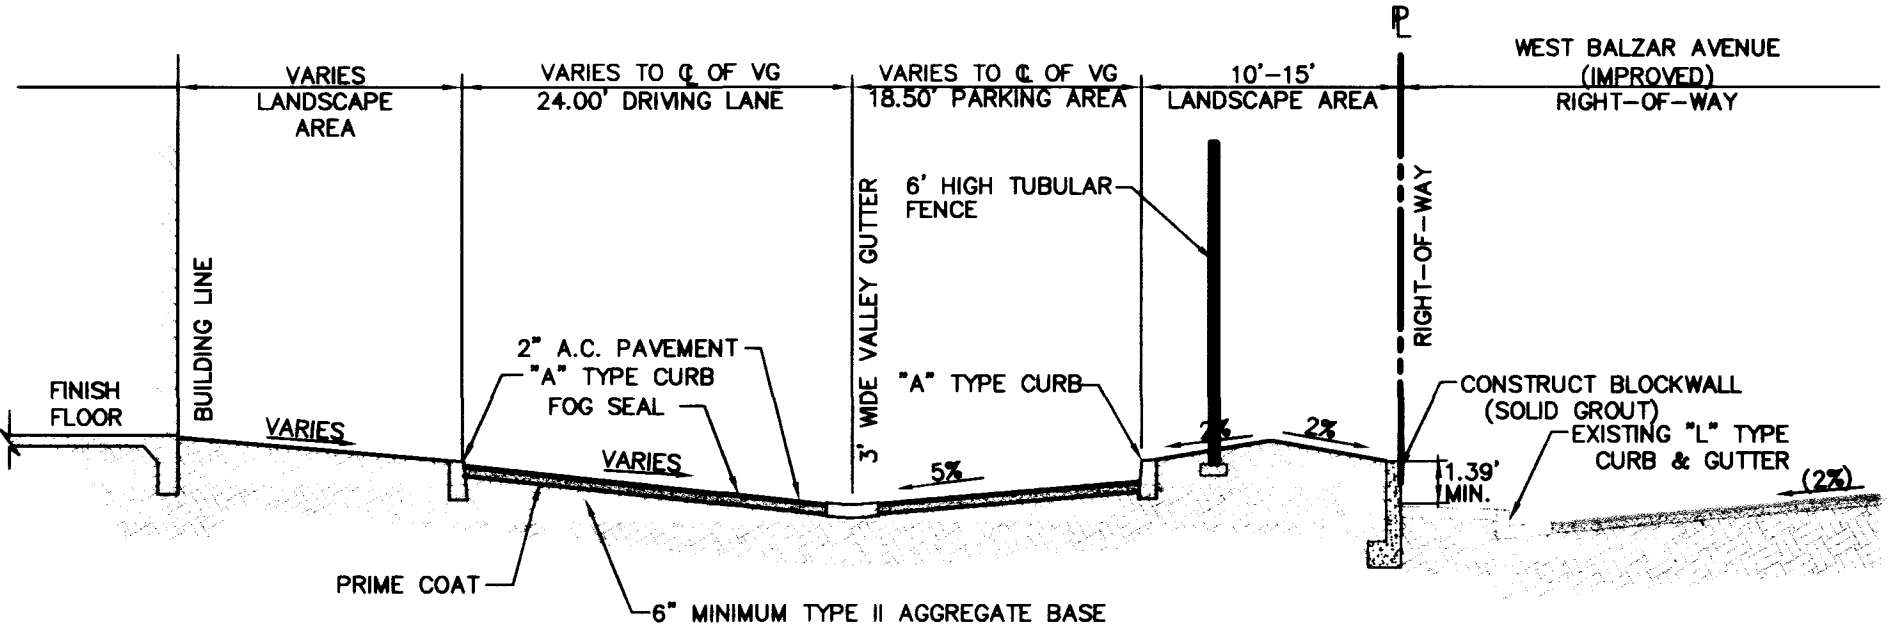


SECTION

NO SCALE

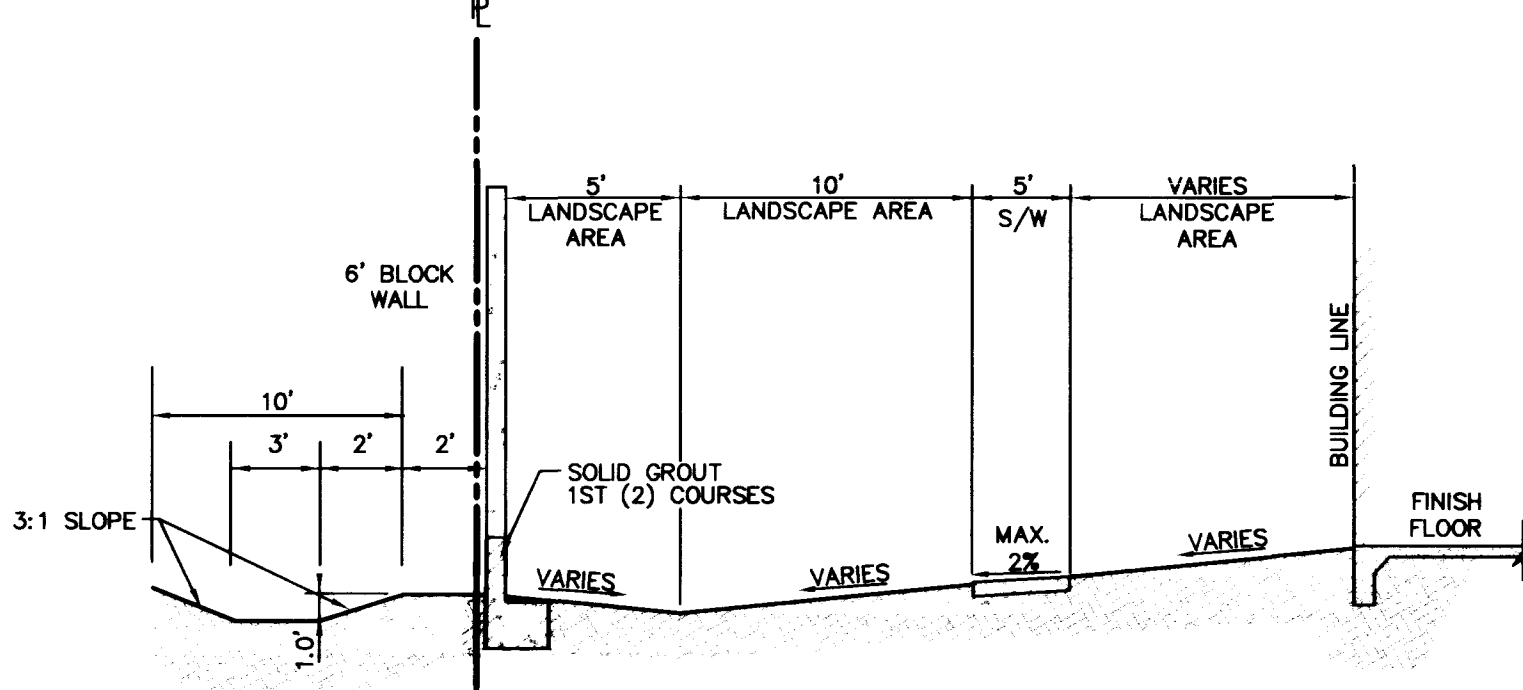


SECTION

NO SCALE

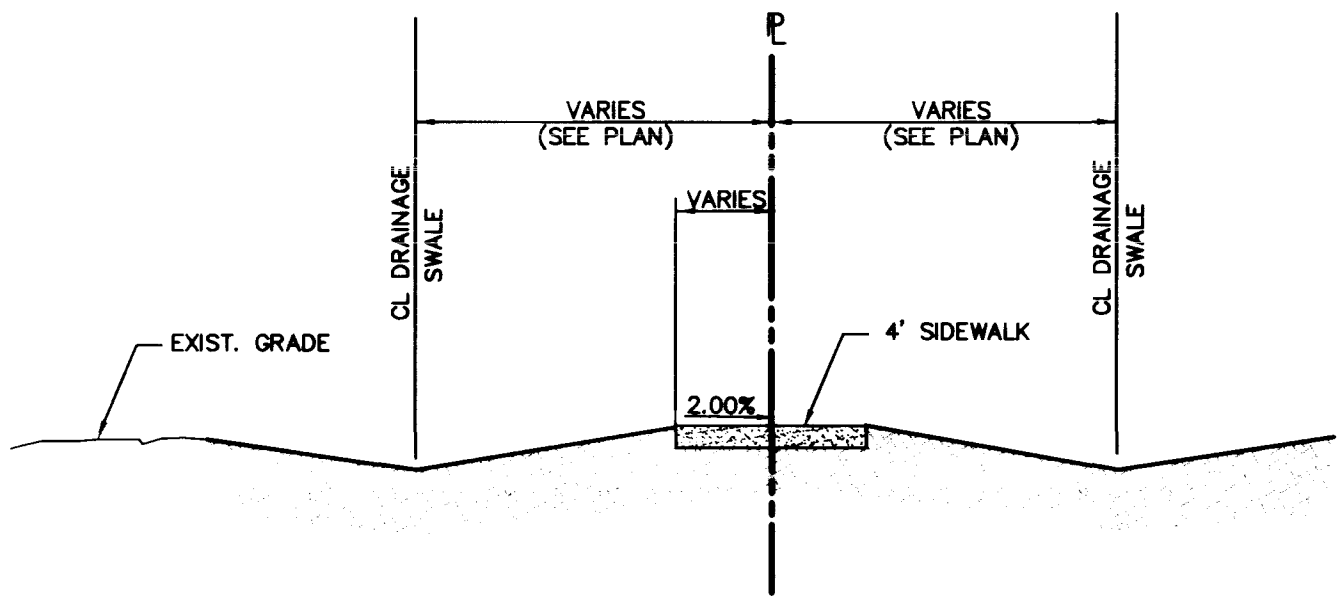


SECTION

NO SCALE

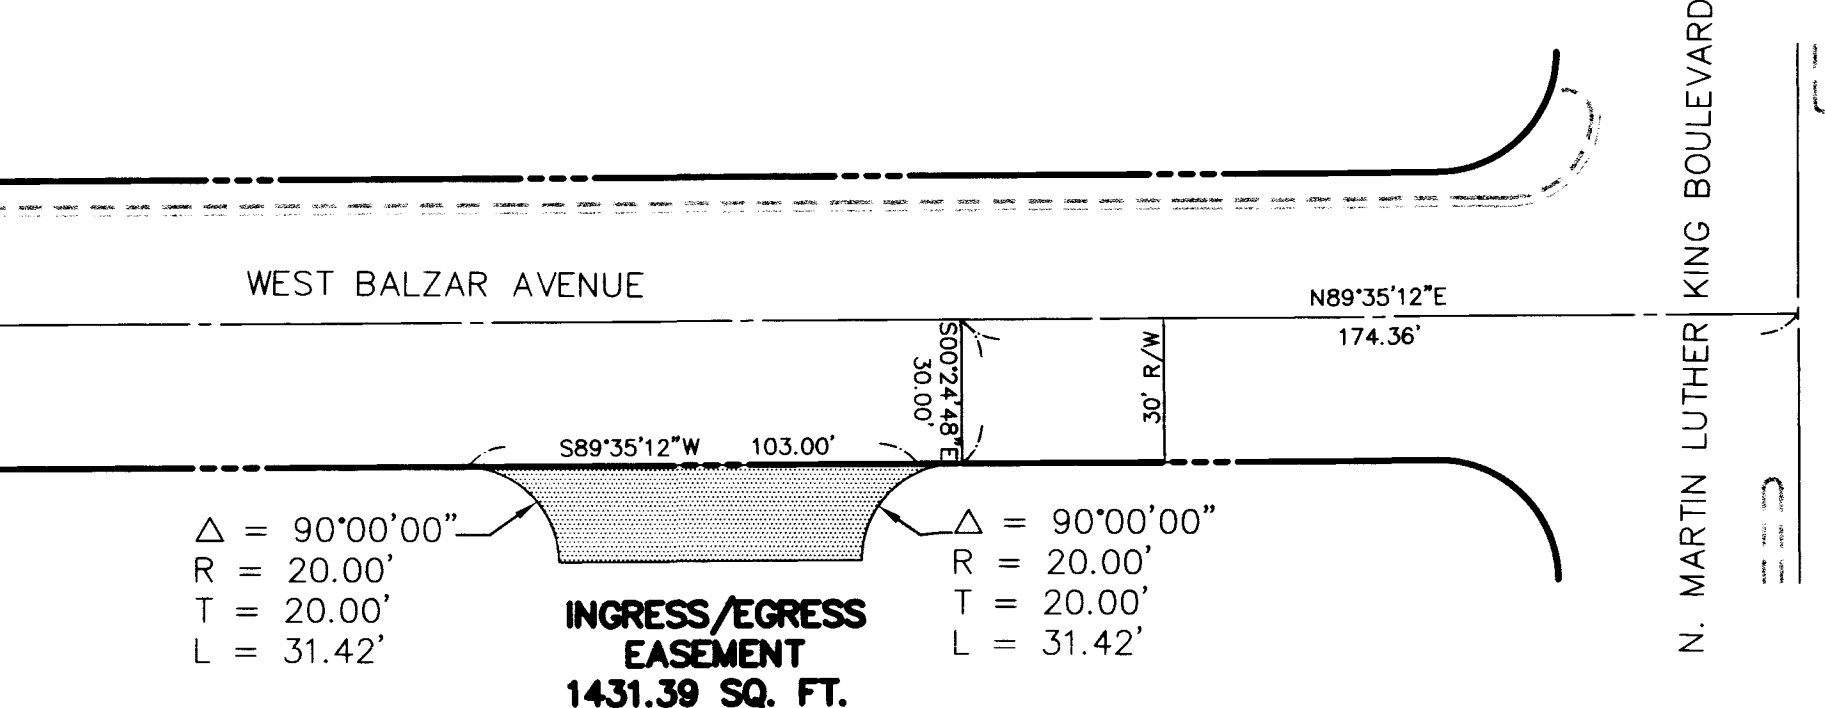


INGRESS / EGRESS EASEMENT

NO SCALE

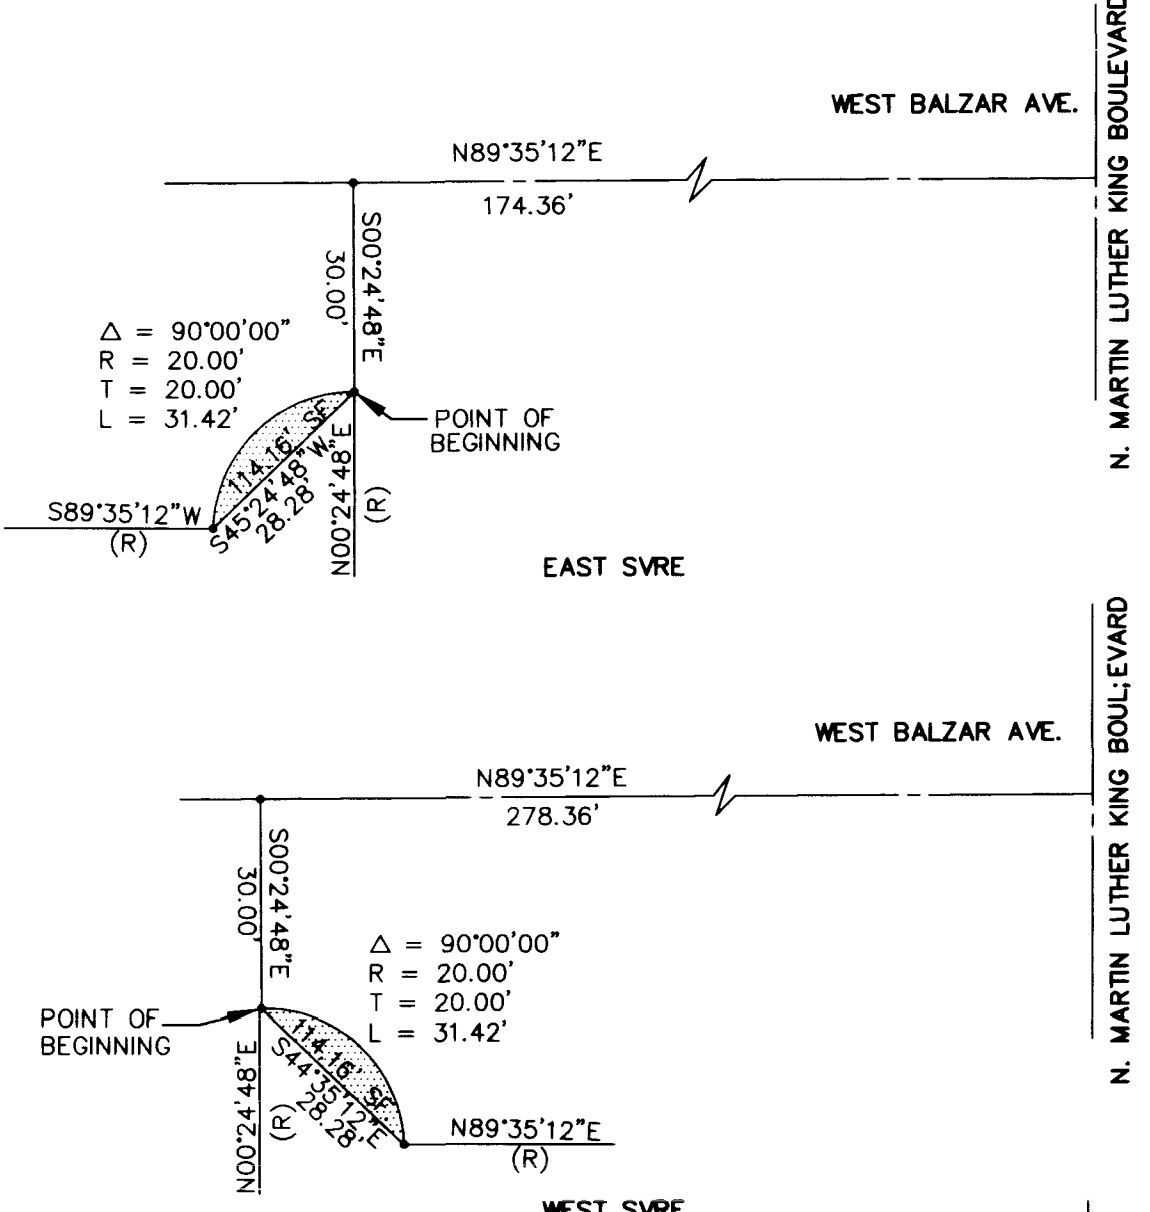


SIGHT VISIBLY EASEMENTS

NO SCALE

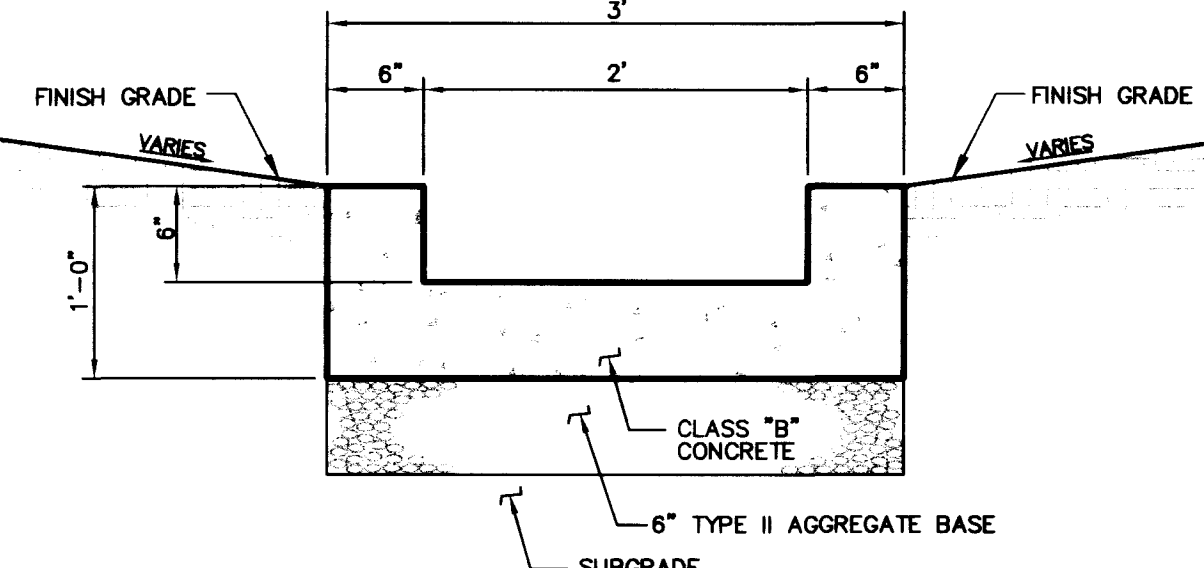


CONCRETE FLUME

NO SCALE

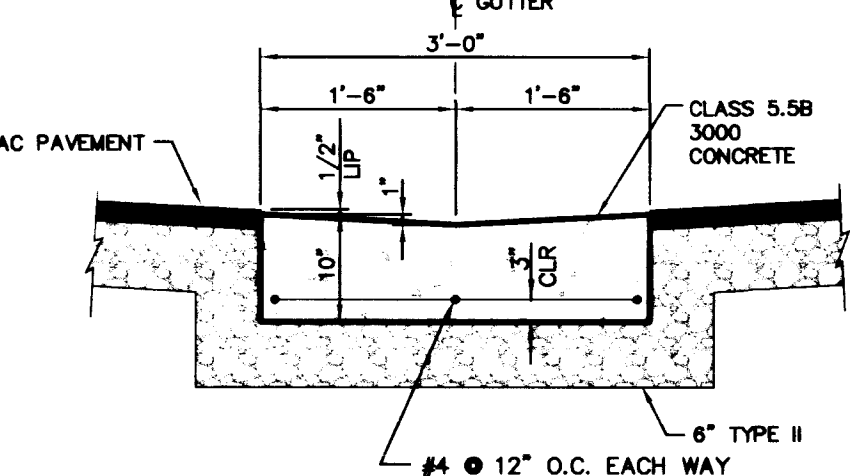

ONSITE VALLEY GUTTER

NO SCALE

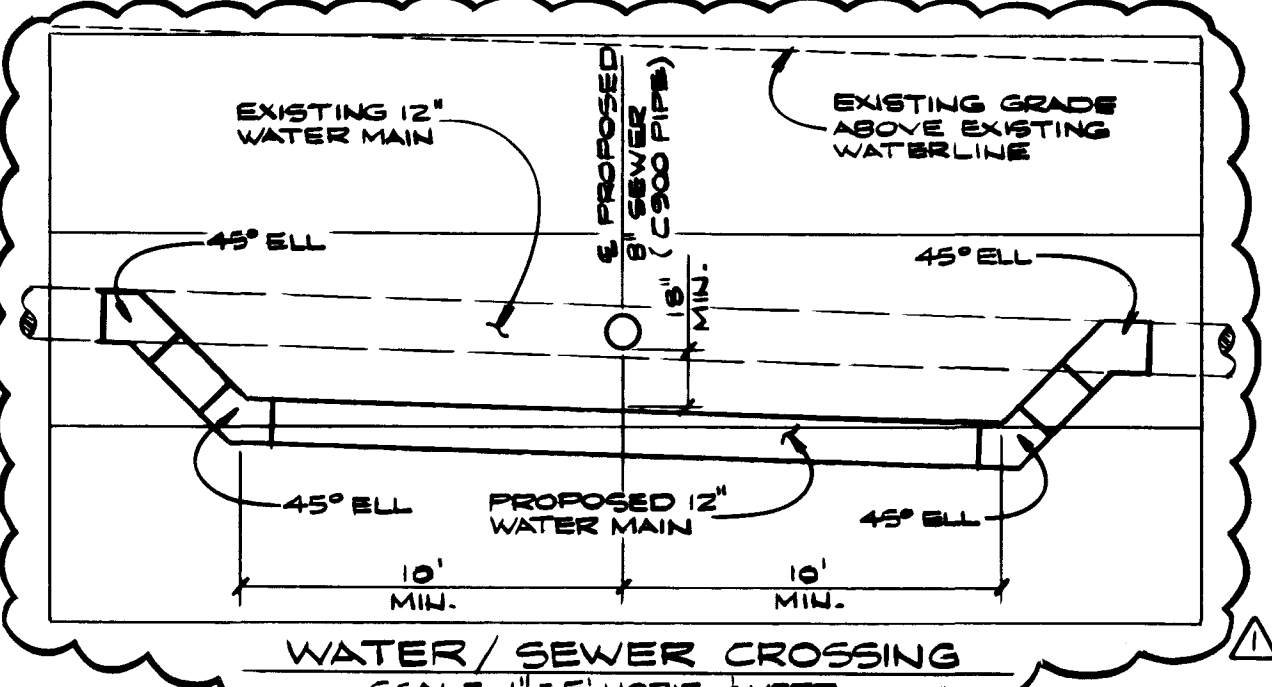

WATER/SEWER CROSSING

SCALE 1" = 5' HORIZ. & VERT.

KAUFMAN & BROAD 320 GOLDEN SHORE, SUITE 200 LONG BEACH, CALIFORNIA 90802-4217 (310) 236-2000		L. R. NELSON CONSULTING ENGINEERS, INC. 3035 East Patrick Lane Suite 8 Las Vegas, Nevada 89120 (702) 491-2288 FAX	
DRAWN BY: JRM		DESIGNED BY: JRM	
CHECKED BY: RT		PROJECT NO: 907-002-992	
SCALE: 1" = 30'		SHEET 7 OF 7 SHEETS	
DRAWING NO. 107-V3083		DATE: 4-12-99	


























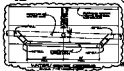













