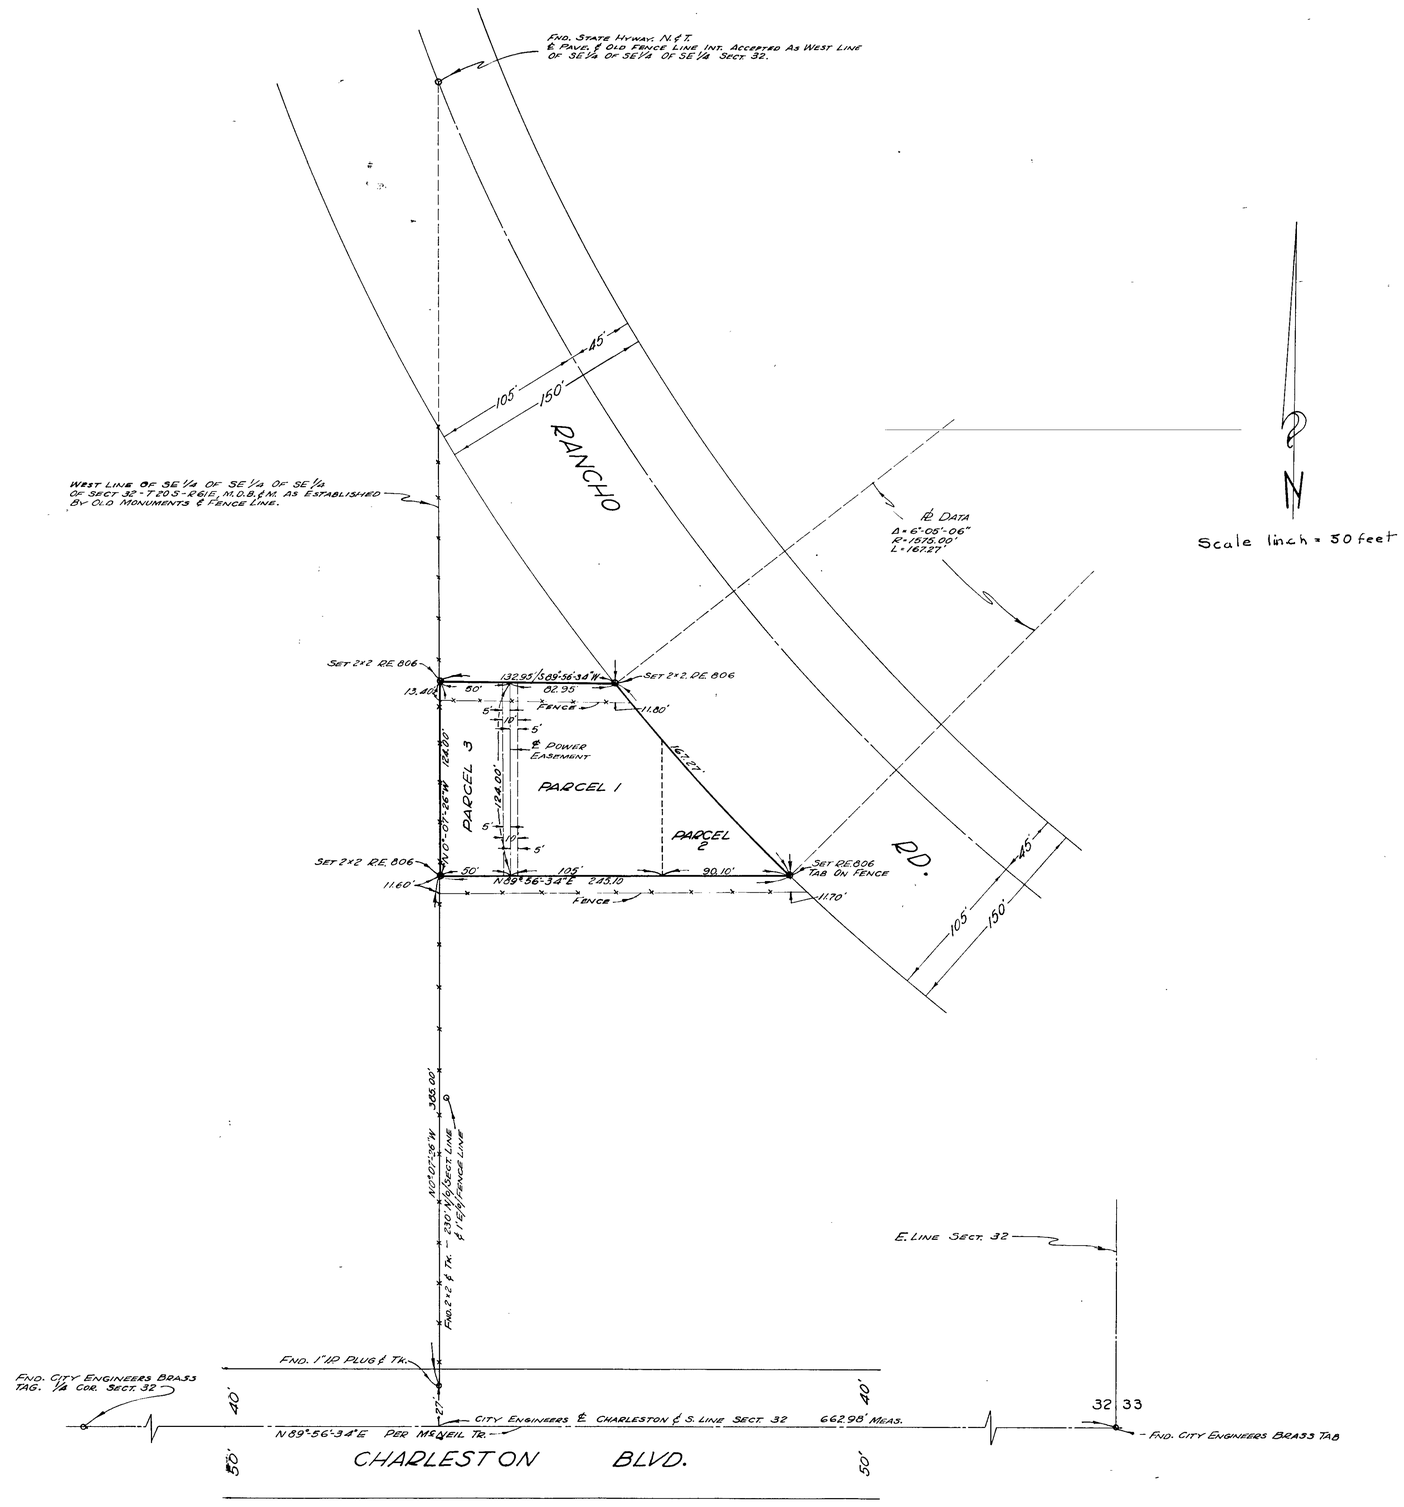

I, A.K. Bowman, a registered Professional Engineer and Land Surveyor in the State of Nevada, do hereby certify that this map accurately delineates a survey made by me at the instance of Edgar L. Compton, and that all points have been definately established, and are contained in the following described boundary:

Begining at a point in the west line of the SE 1/4 of the SE 1/4 of the SE 1/4 of Section 32, T-20-S, R-61-E, M.D.B.&M., a distance thereon N 0° 07'-26" W 385 feet from the South line of the SE 1/4 of said Section 32 the true point of begining; thence continue along the West line thereof a distance of 124 feet to a point; thence N 89°-56'-34" E 132.95 feet to a point of intersection with the West boundary line of Rancho Road; thence Southeasterly along the Southwesterly line of said Rancho Road an arc length of 167.27 feet to a point; thence S 89°-56'-34" W 245.10 feet to the true point of begining.

This survey was completed on the 11 day of Dec., 1953.

A.K. Bowman

REGISTERED ENGINEER, NEVADA LIC. NUMBER 806

Subscribed and sworn to before me this 1st day of Dec. 1953

NOTARY PUBLIC IN AND FOR CLARK COUNTY, NEVADA

MY COMMISSION EXPIRES _____

420381

A. K. BOWMAN
DEC 18 1953 / 11:05 A.M
File 2 Page 66
Reg. Prof. Eng. Surveys

2.50

PORTION OF THE W 1/2 OF SE 1/4 OF SE 1/4 OF SE 1/4 OF SECT. 32, T20S. R61E M.D.B.&M.

055-57