


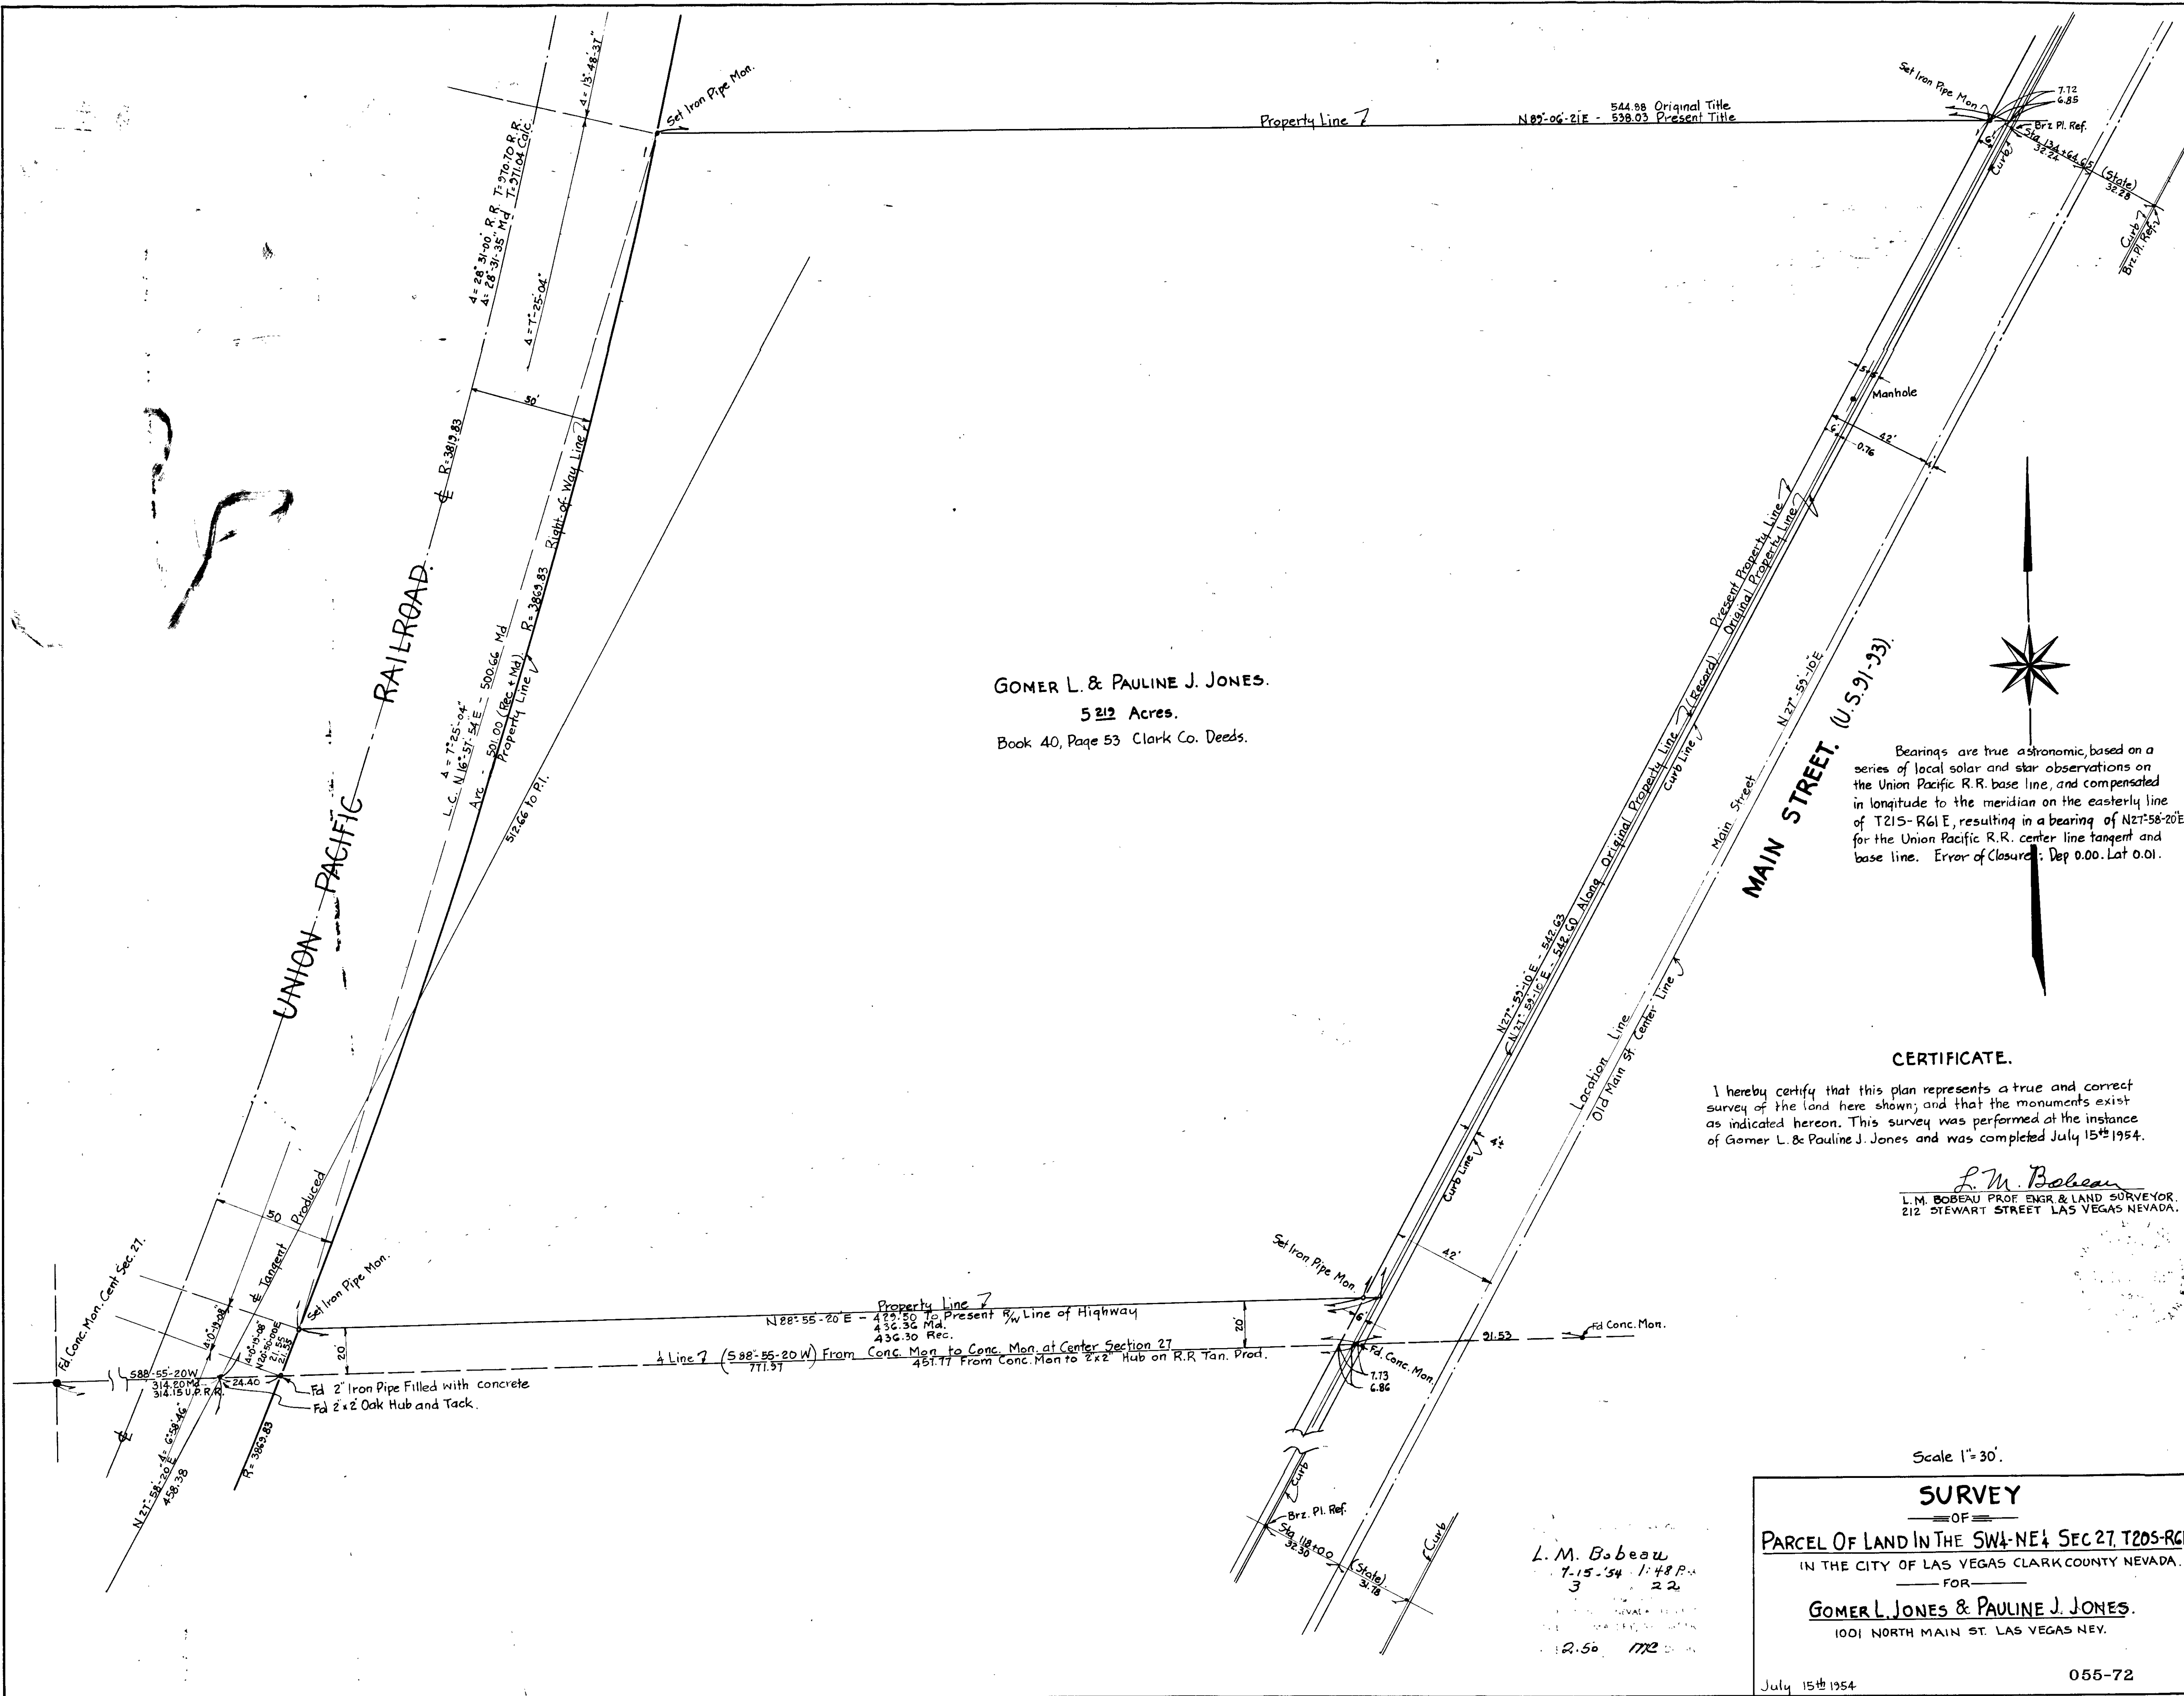

GOMER L. & PAULINE J. JONES.
5 21/2 Acres.
Book 40, Page 53 Clark Co. Deeds.

Bearings are true astronomic, based on a series of local solar and star observations on the Union Pacific R.R. base line, and compensated in longitude to the meridian on the easterly line of T215-R61 E, resulting in a bearing of N27°58'-20"E for the Union Pacific R.R. center line tangent and base line. Error of Closure: Dep 0.00. Lat 0.01.

CERTIFICATE.

I hereby certify that this plan represents a true and correct survey of the land here shown; and that the monuments exist as indicated hereon. This survey was performed at the instance of Gomer L. & Pauline J. Jones and was completed July 15th 1954.

L. M. Bobeau
L. M. BOBEAU PROF. ENGR. & LAND SURVEYOR.
212 STEWART STREET LAS VEGAS NEVADA.

Scale 1"=30'.

SURVEY
OF
PARCEL OF LAND IN THE SW 1/4 NE 1/4 SEC 27, T20S-R61E
IN THE CITY OF LAS VEGAS CLARK COUNTY NEVADA.
FOR
GOMER L. JONES & PAULINE J. JONES.
1001 NORTH MAIN ST. LAS VEGAS NEV.

July 15th 1954

055-72