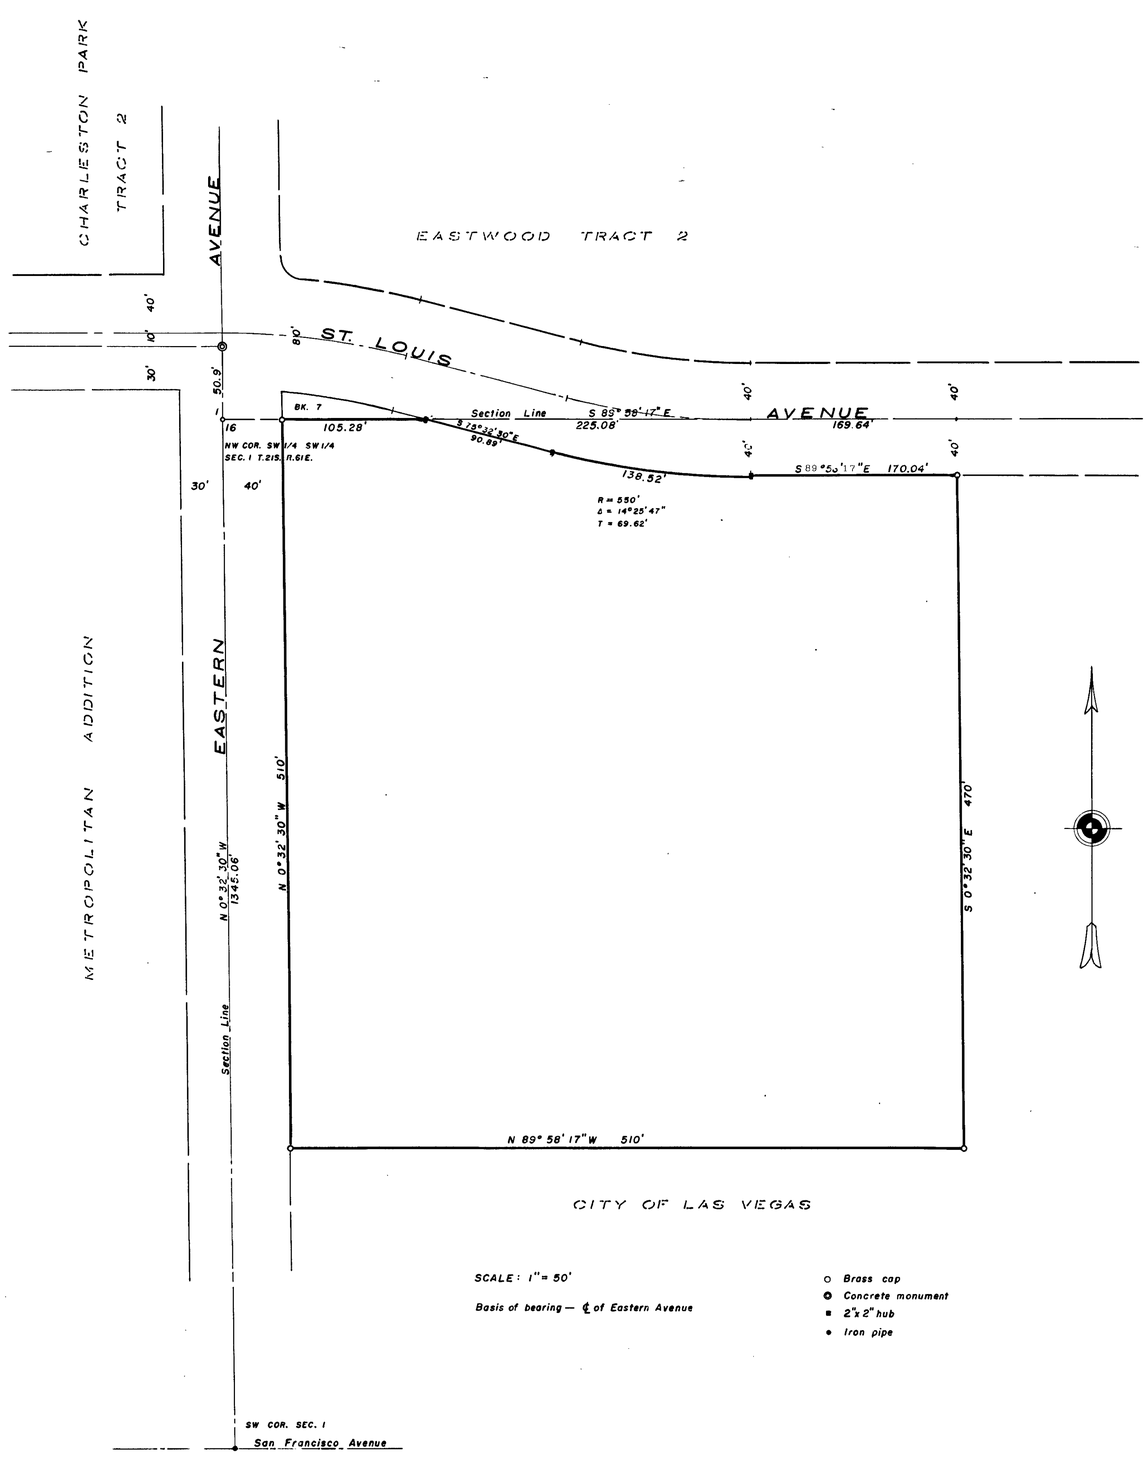

SCALE: 1" = 50'

Basis of bearing — ℄ of Eastern Avenue

- ○ Brass cap
- ◉ Concrete monument
- ■ 2"x2" hub
- ● Iron pipe

PLAT SHOWING

SURVEY OF A PORTION OF THE SW 1/4 SW 1/4 SECTION 1 T.21S. R.61E. M.D.B.&M.

LAS VEGAS NEVADA

CERTIFICATE OF SURVEY -

I, Karsten T. Bronken, a Professional Engineer and Land Surveyor, Nevada certificate No. 618, do hereby certify that the points platted on this map accurately represents a survey of a portion of the SW 1/4 SW 1/4 of section 1, T.21S., R.61E., M.D.B.&M. made by me at the instance of St. Viator's Church. The survey was completed June 23, 1955.

18-13

Karsten T. Bronken
Karsten T. Bronken Nevada Cert. No. 618

50287
Karsten Bronken
6-24-55 1:53 P
5 13
CLARK COUNTY, NEVADA
PAUL C. O'MALLEY, RECORDER
240 Bu

50287
Karsten Bronken
59
240 Bu

055-107

FILE 106 5 PAGE 13