
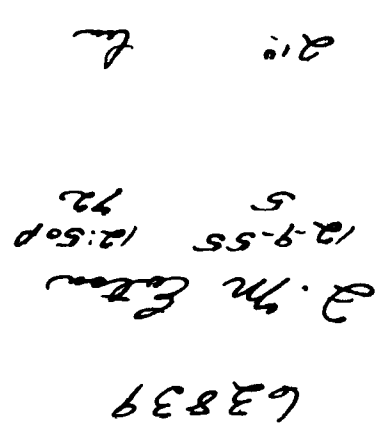
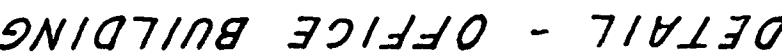
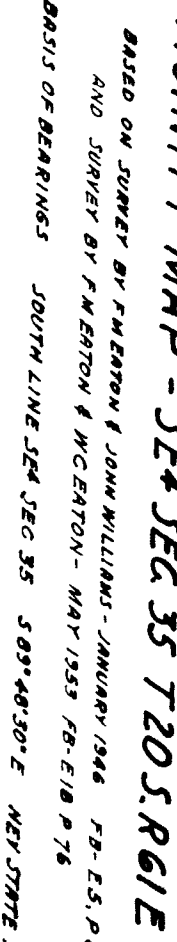


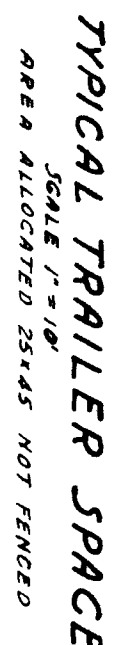

FILE 2 PAGE 12


overlap of buildings or structures off from said land, except as shown.

ENGINEERS CERTIFICATE



TYPICAL TRAILER SPACE
SCALE 1" = 10'

DETAIL BUILDINGS A & B
SCALE 1"=10'

