



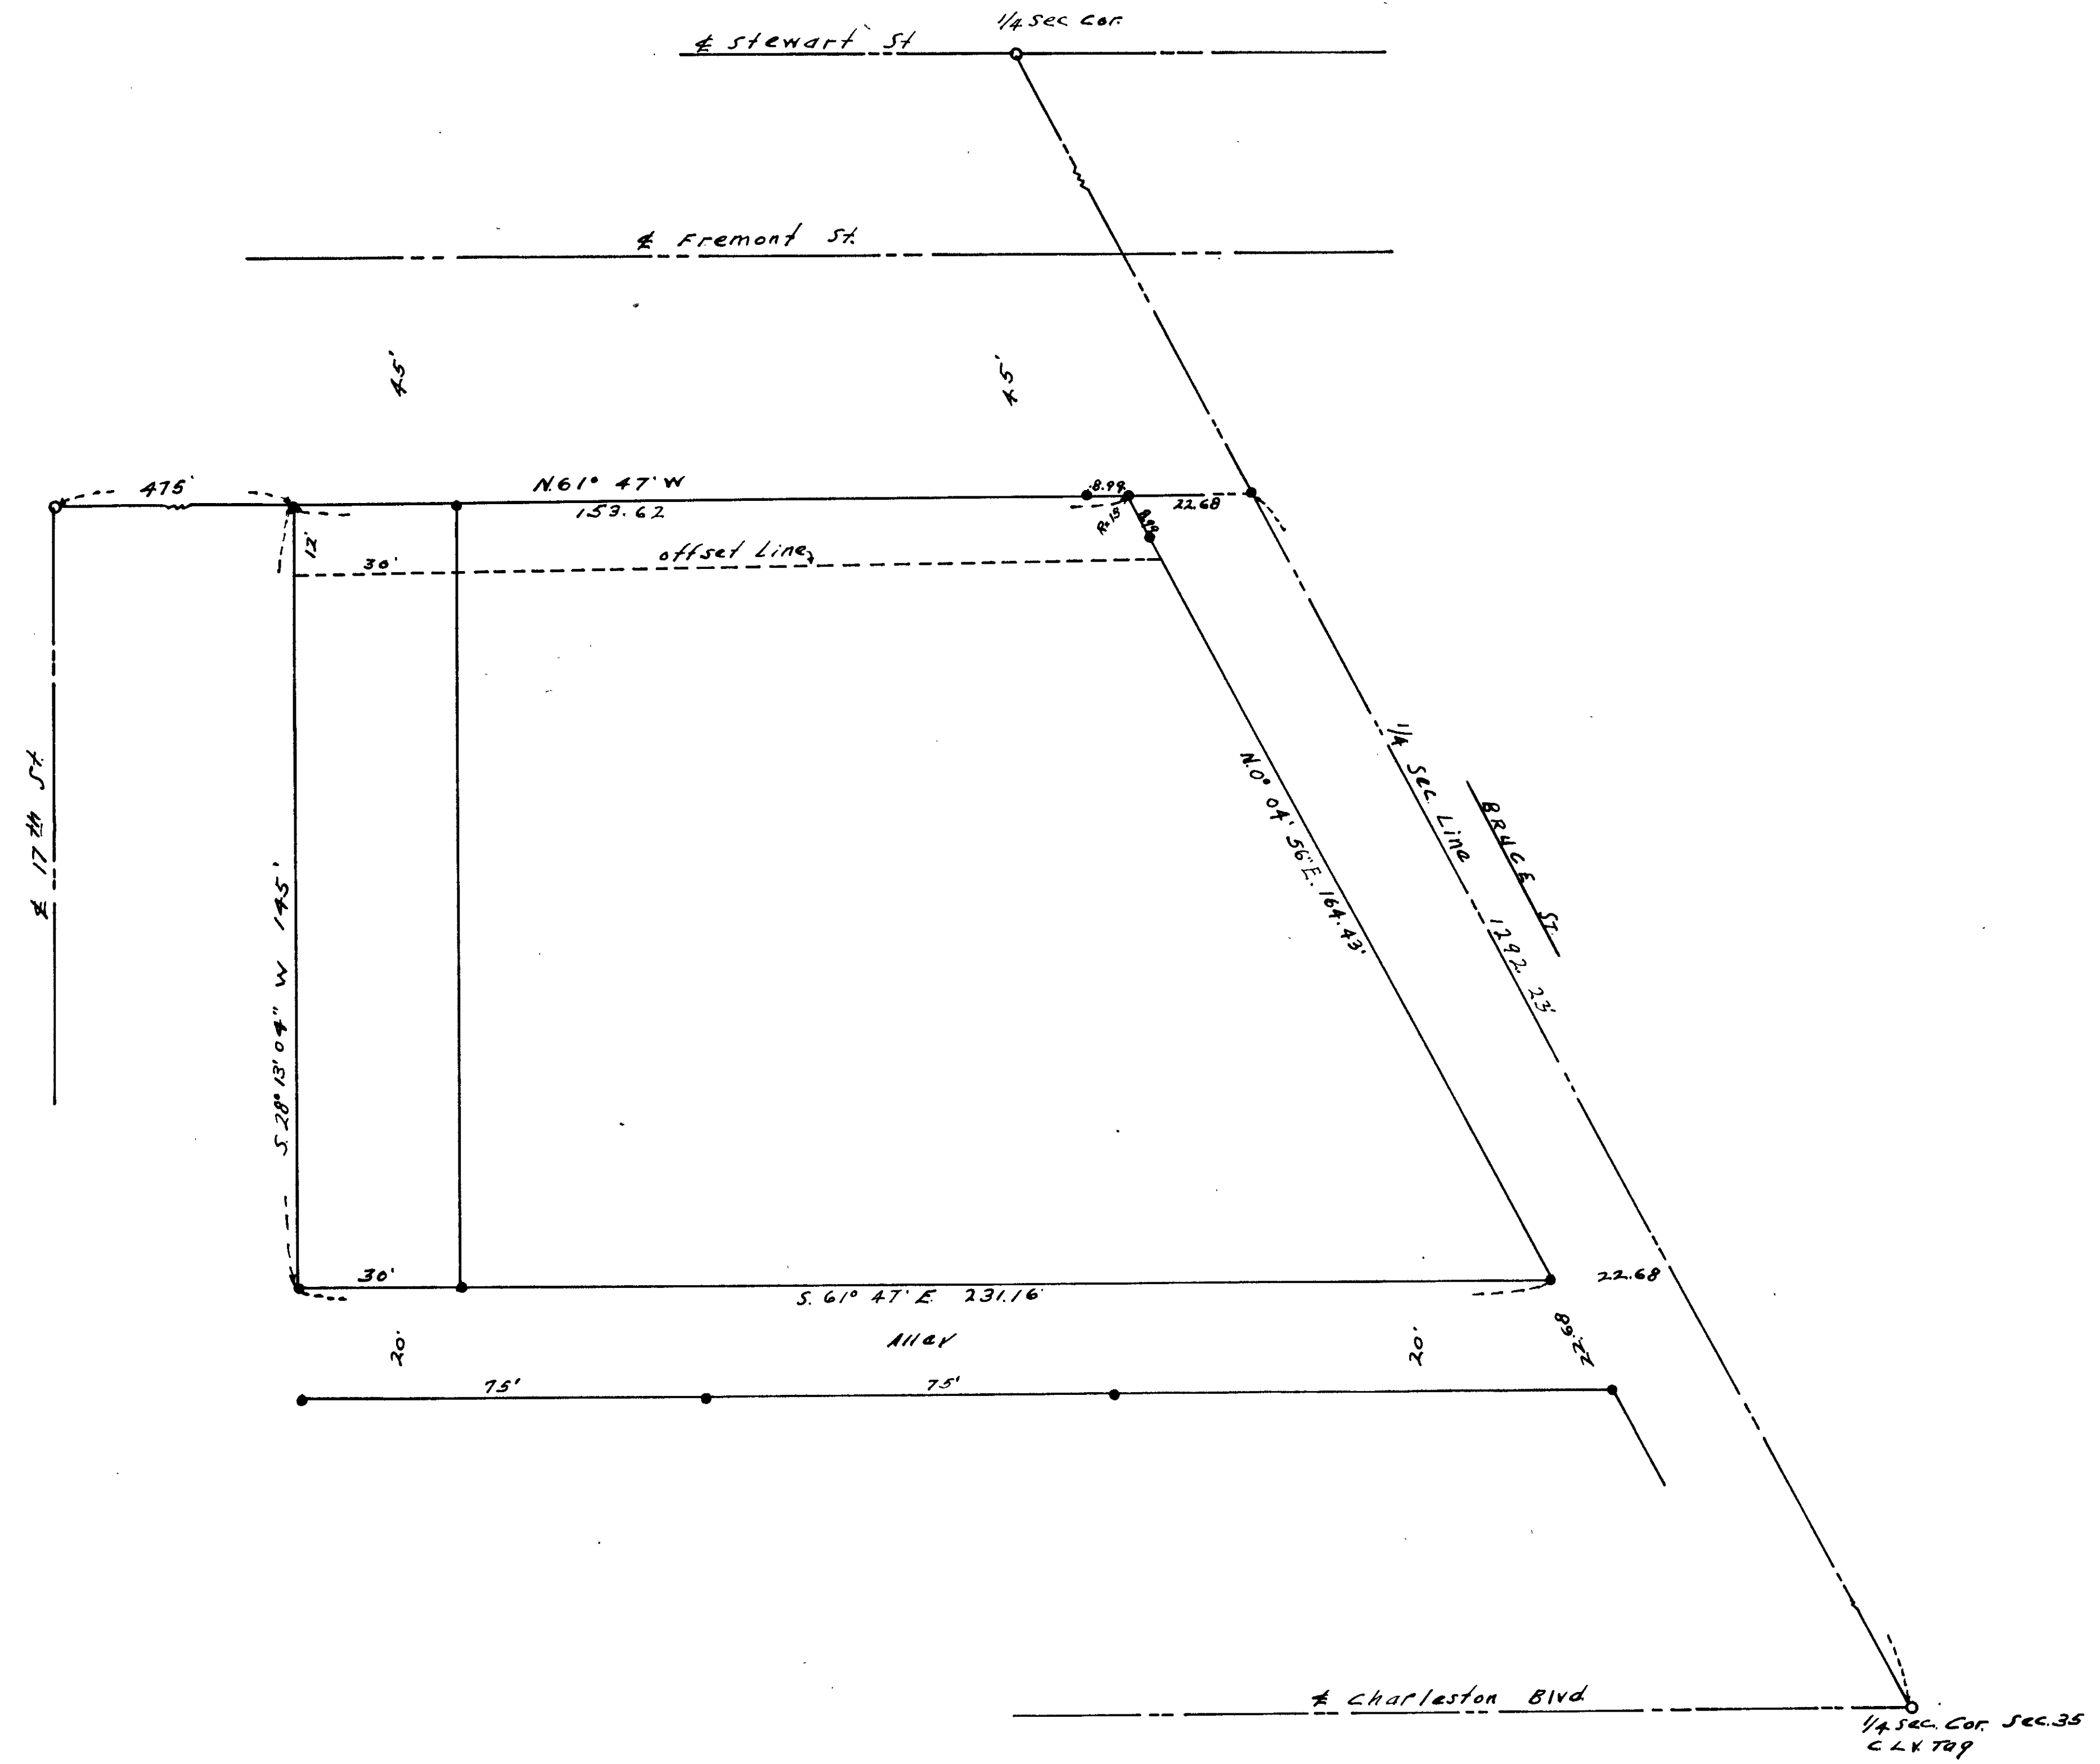

I, L.A. Harris a duly Registered Engineer and Land Surveyor do hereby certify that this map truly and correctly represents the results of a survey made by me at the request of John Henry Clark. Survey Completed on the 2nd day of January, 1956

L.A. Harris
Registered Engineer and Land Surveyor, Nev. 24

Points Found -----○
Points Set -----●
Basis of Bearings and Distances, Mayfair Tract No. 2, Amended,
Las Vegas, Nevada.

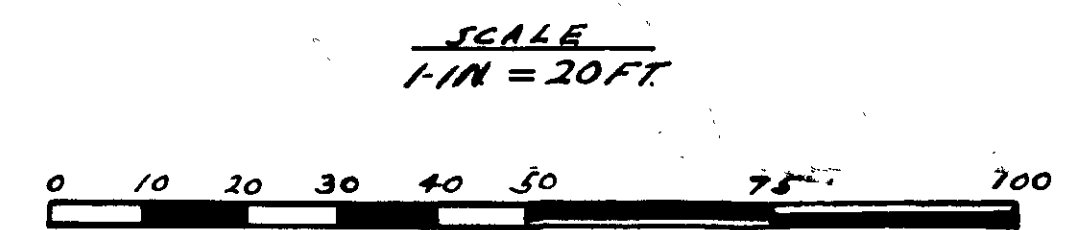

70709
L.A. Harris
2-23-56 1:15 P
5 90
39° 77'

70709
L.A. Harris
2-23-56 1:15 P
5 90
39° 77'

SURVEY OF LOTS 36-37-38, BLOCK B
MAYFAIR TRACT No. 2 AMENDED
LAS VEGAS, NEVADA
T 20S., R 61E, M.D.B. & M.
SEC. 35-20-61
055-119
008.7-172
File 5 PAGE 90