

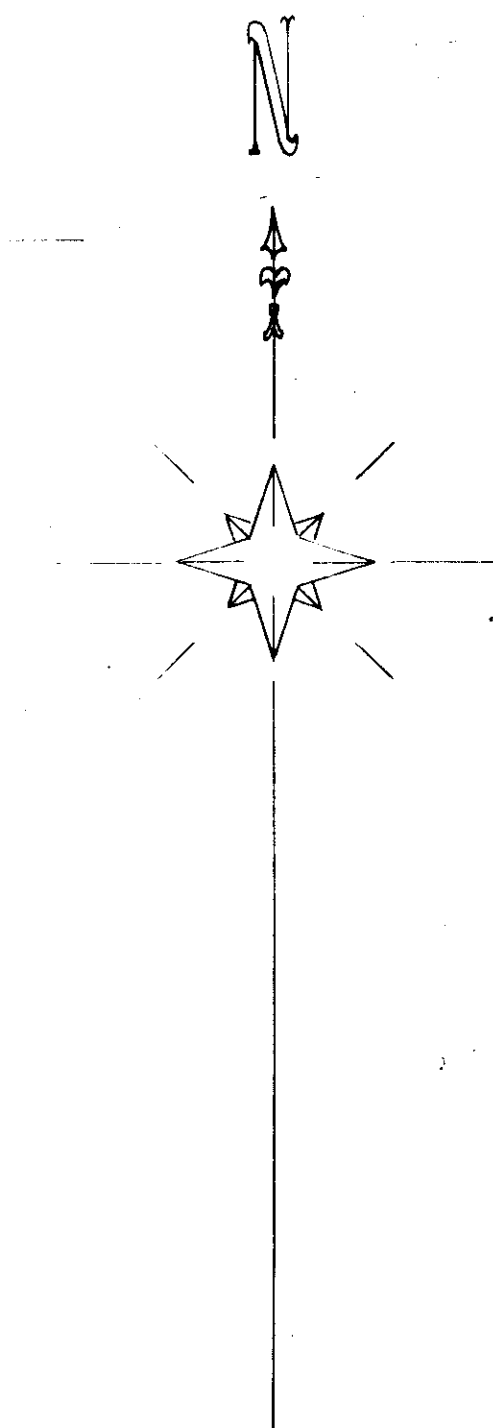


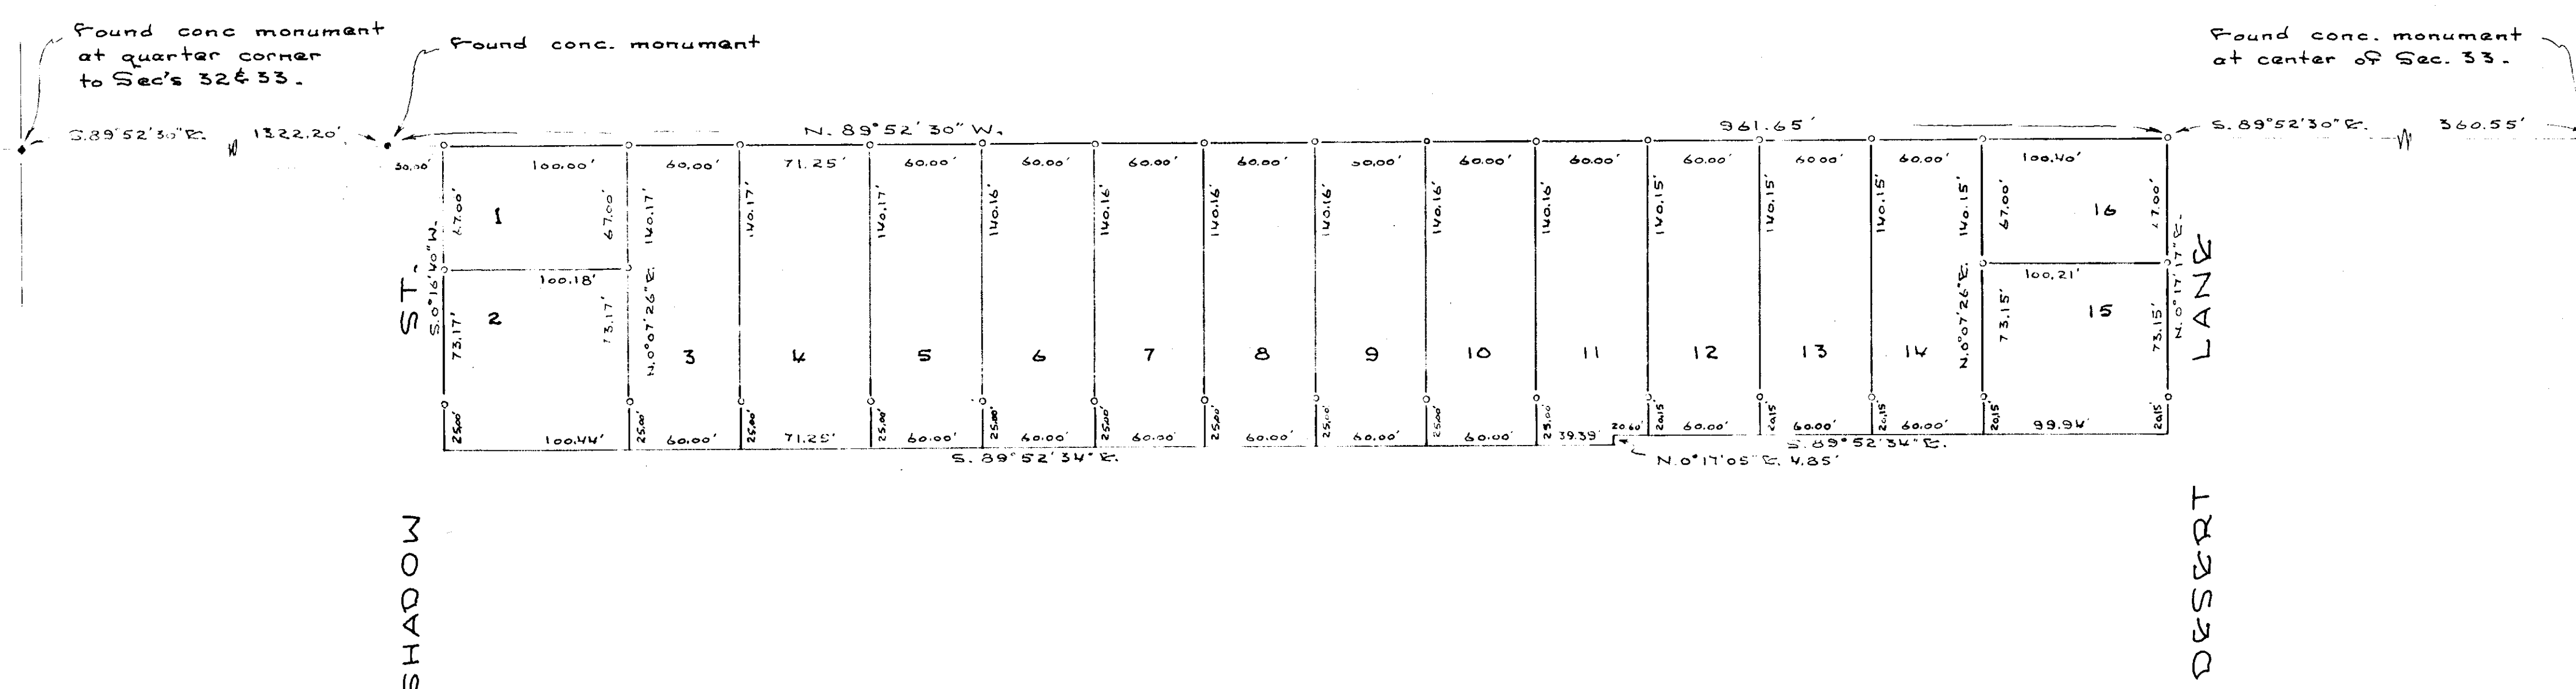

I, Harlan Brown, a registered Civil Engineer and Land Surveyor of the State of Nevada, do hereby certify that the survey of the lands shown hereon was made by me at the instance of W. Roger Barnard; that this is not intended to be a subdivision; that the material evidence revealed by said survey, in whole or in part, does not appear on any map of record sufficiently to identify or corroborate the results shown hereon; that any discrepancies between this survey and parts of other surveys are shown hereon; that the monuments found, set, reset or replaced are shown with their description; that the basis of bearings, ties to witness corners or other permanent ties including U.S. Coast and Geodetic control system, legal descriptions if any, scale of map, and the relation of this survey to adjacent official city, county, state or Federal surveys are properly delineated thereon; and that this survey was completed on the 7th day of April, 1956.

Harlan Brown
Reg. C.E. and Land Surveyor Nev. No. 209

LEGEND
Bearings based on Nevada State Highway Engineer's record of bearing for the south line of SW 1/4 Sec. 33, 20, 61.

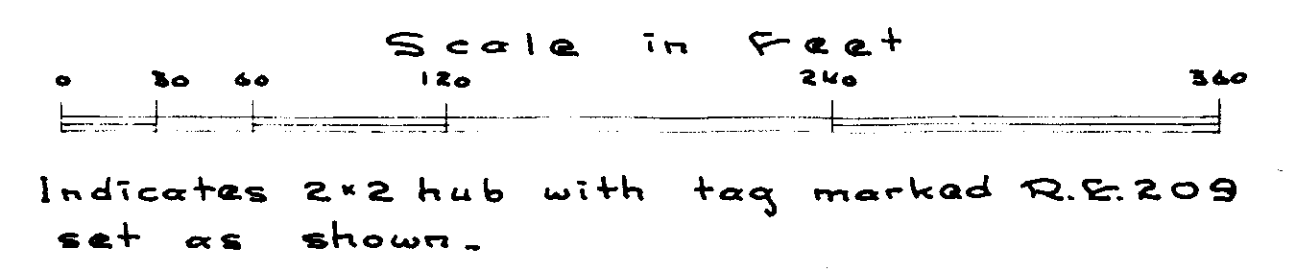

T. 20 S., R. 61 E., Sec. 33 SW 1/4

75791
FILED AT THE REQUEST OF
Harlan Brown
APR 19 1956
CLERK COUNTY CLERK
PAUL C. O'WALLER, RECORDER

75791
Harlan Brown

055-123