


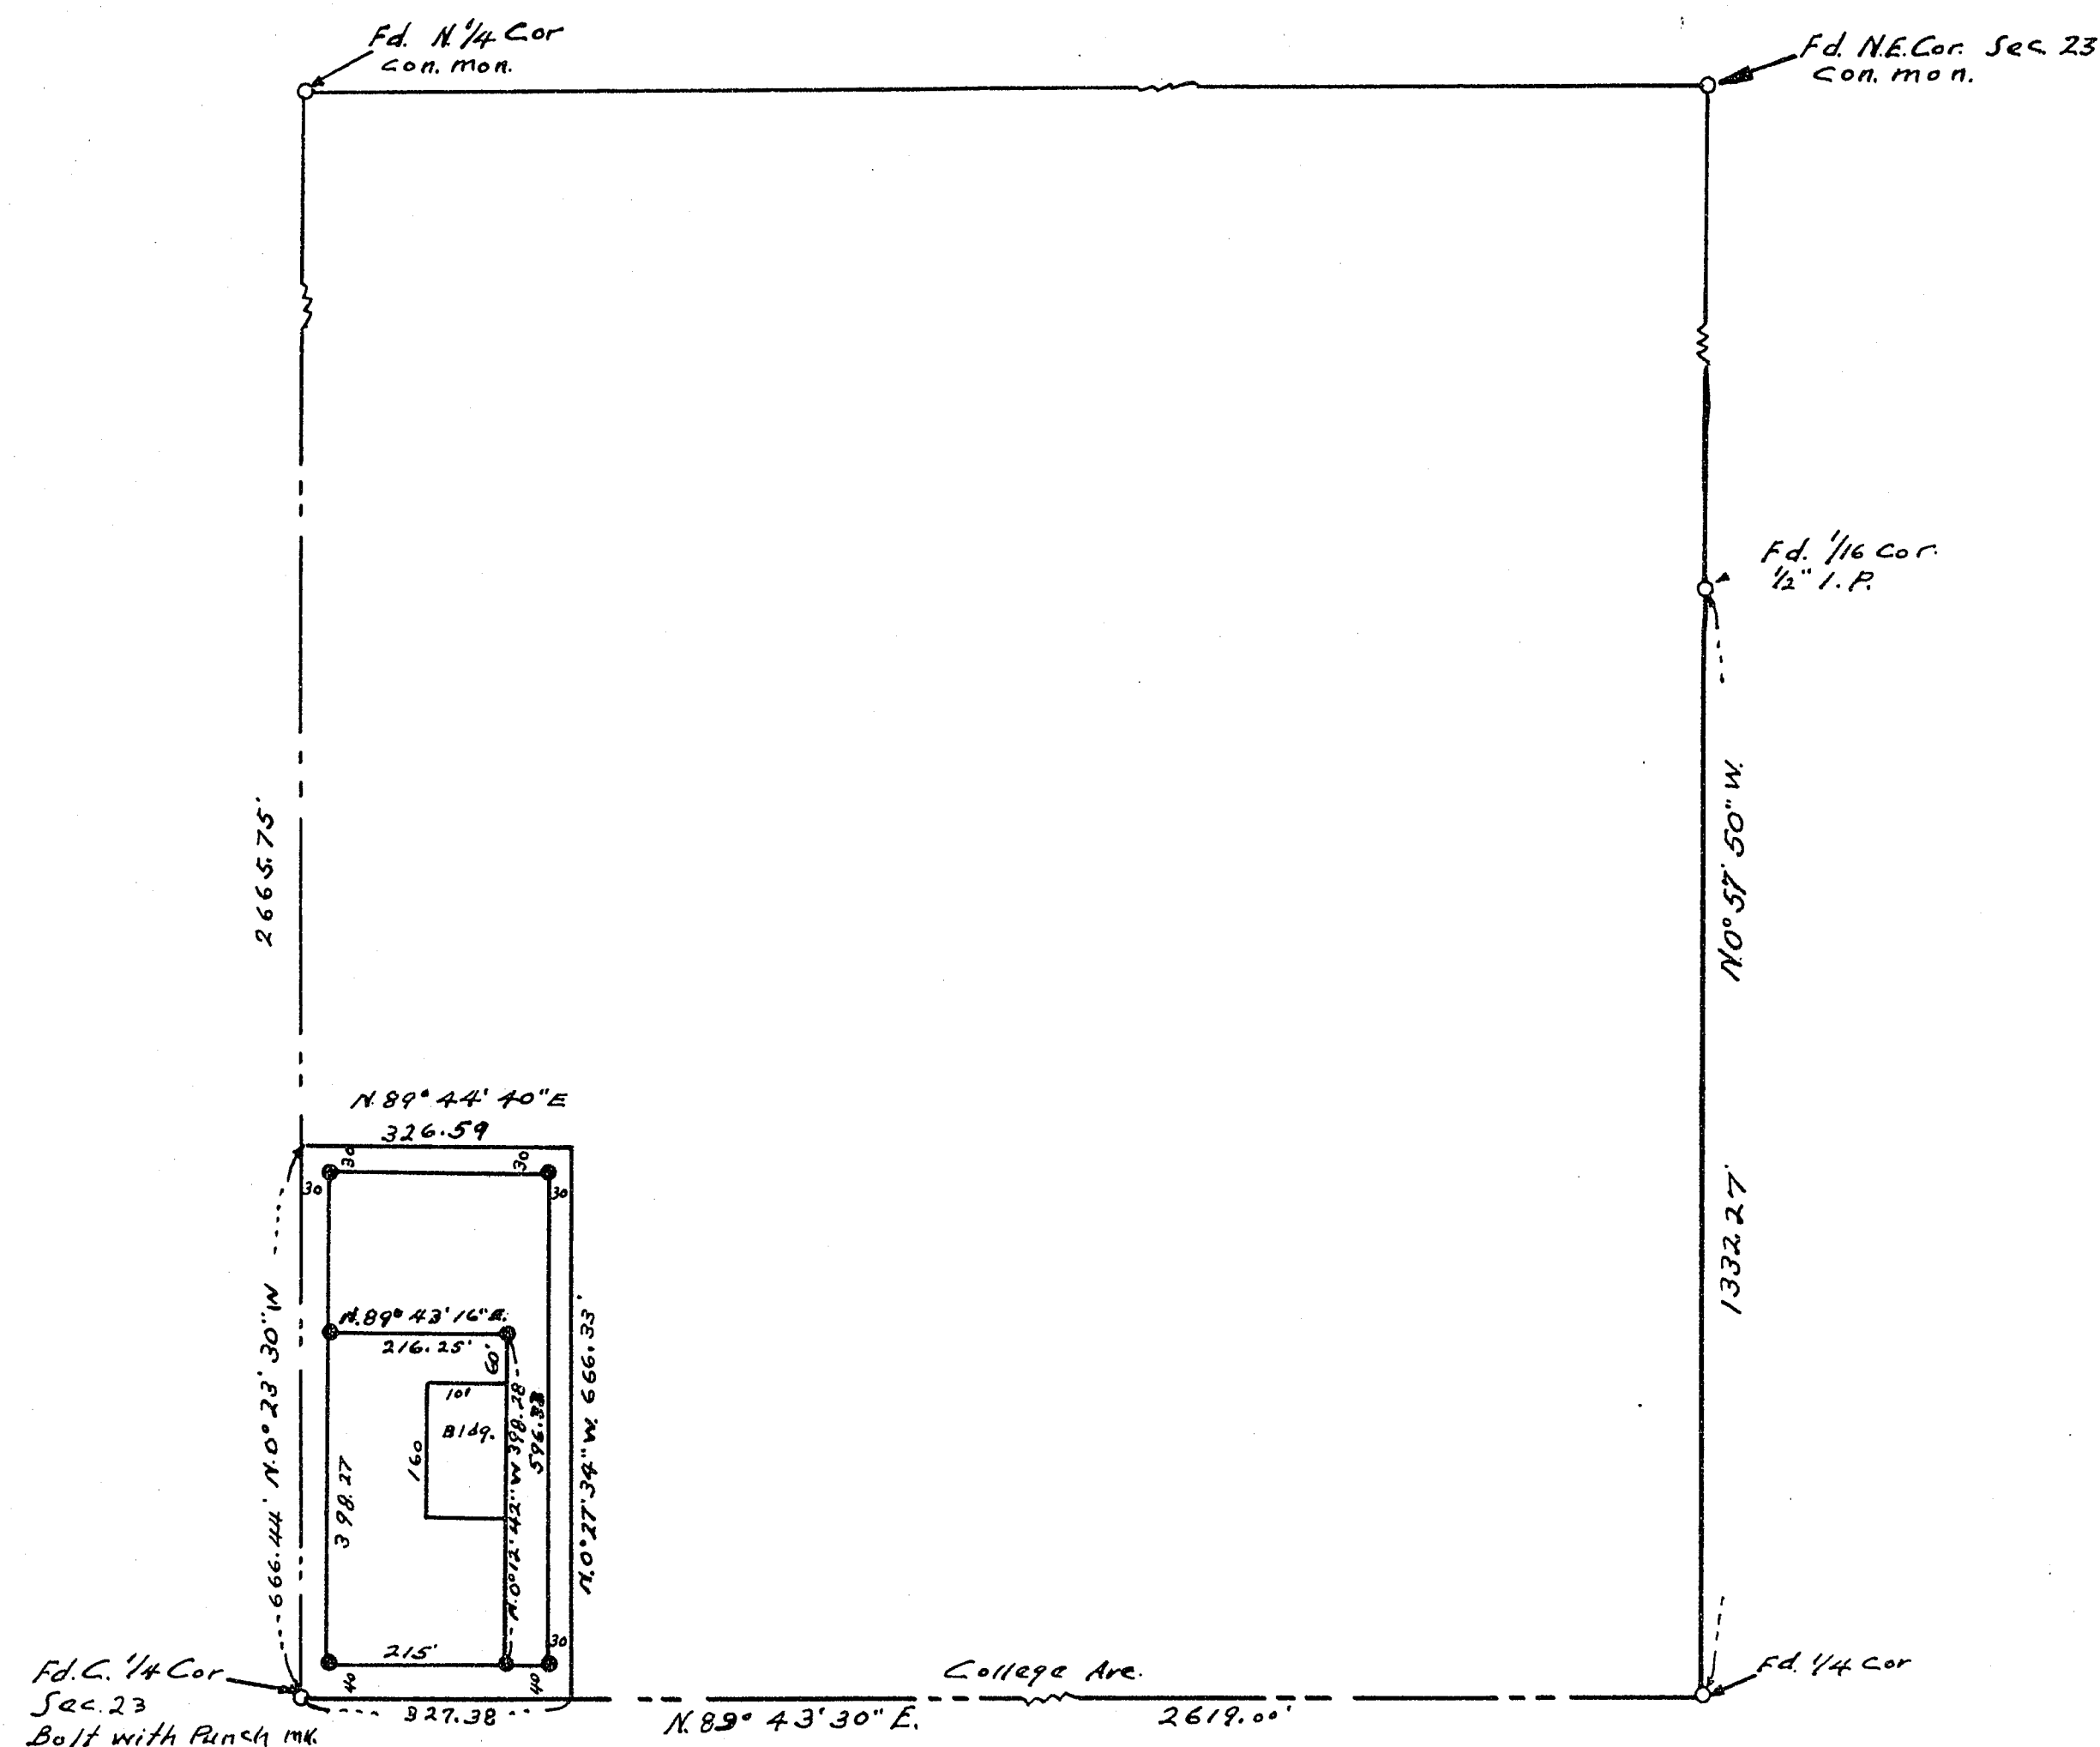

I, L.A. Harris, a duly registered engineer and land surveyor, do hereby certify that this map truly and correctly represents the results of a survey made by me at the request of Yee Cho and completed on the 13th day of October 1956

L. A. Harris

Registered Engineer and Land Surveyor
RE 24

- Indicates Points Found
- Indicates Points Set

Basis of Bearings: North boundary line of Williams Addition Clark County, Nevada, as Recorded in Book 1, of Plats, Page 123, as N 89° 43' 00" E.

SCALE: 1"=200 FT



92566

L. A. Harris
10-29-56 4:18 P.
61

21° 8'

L. A. Harris
10-29-56 4:18 P.
61

112

21° 8'

SURVEY
OF
W 1/2 SW 1/4 SW 1/4 NE 1/4 SEC. 23
T.20S, R.61E, M.D.B. & M.
FOR
YEE CHO, LAS VEGAS, NEV.

717.9-14

FILE 61

41-5-917