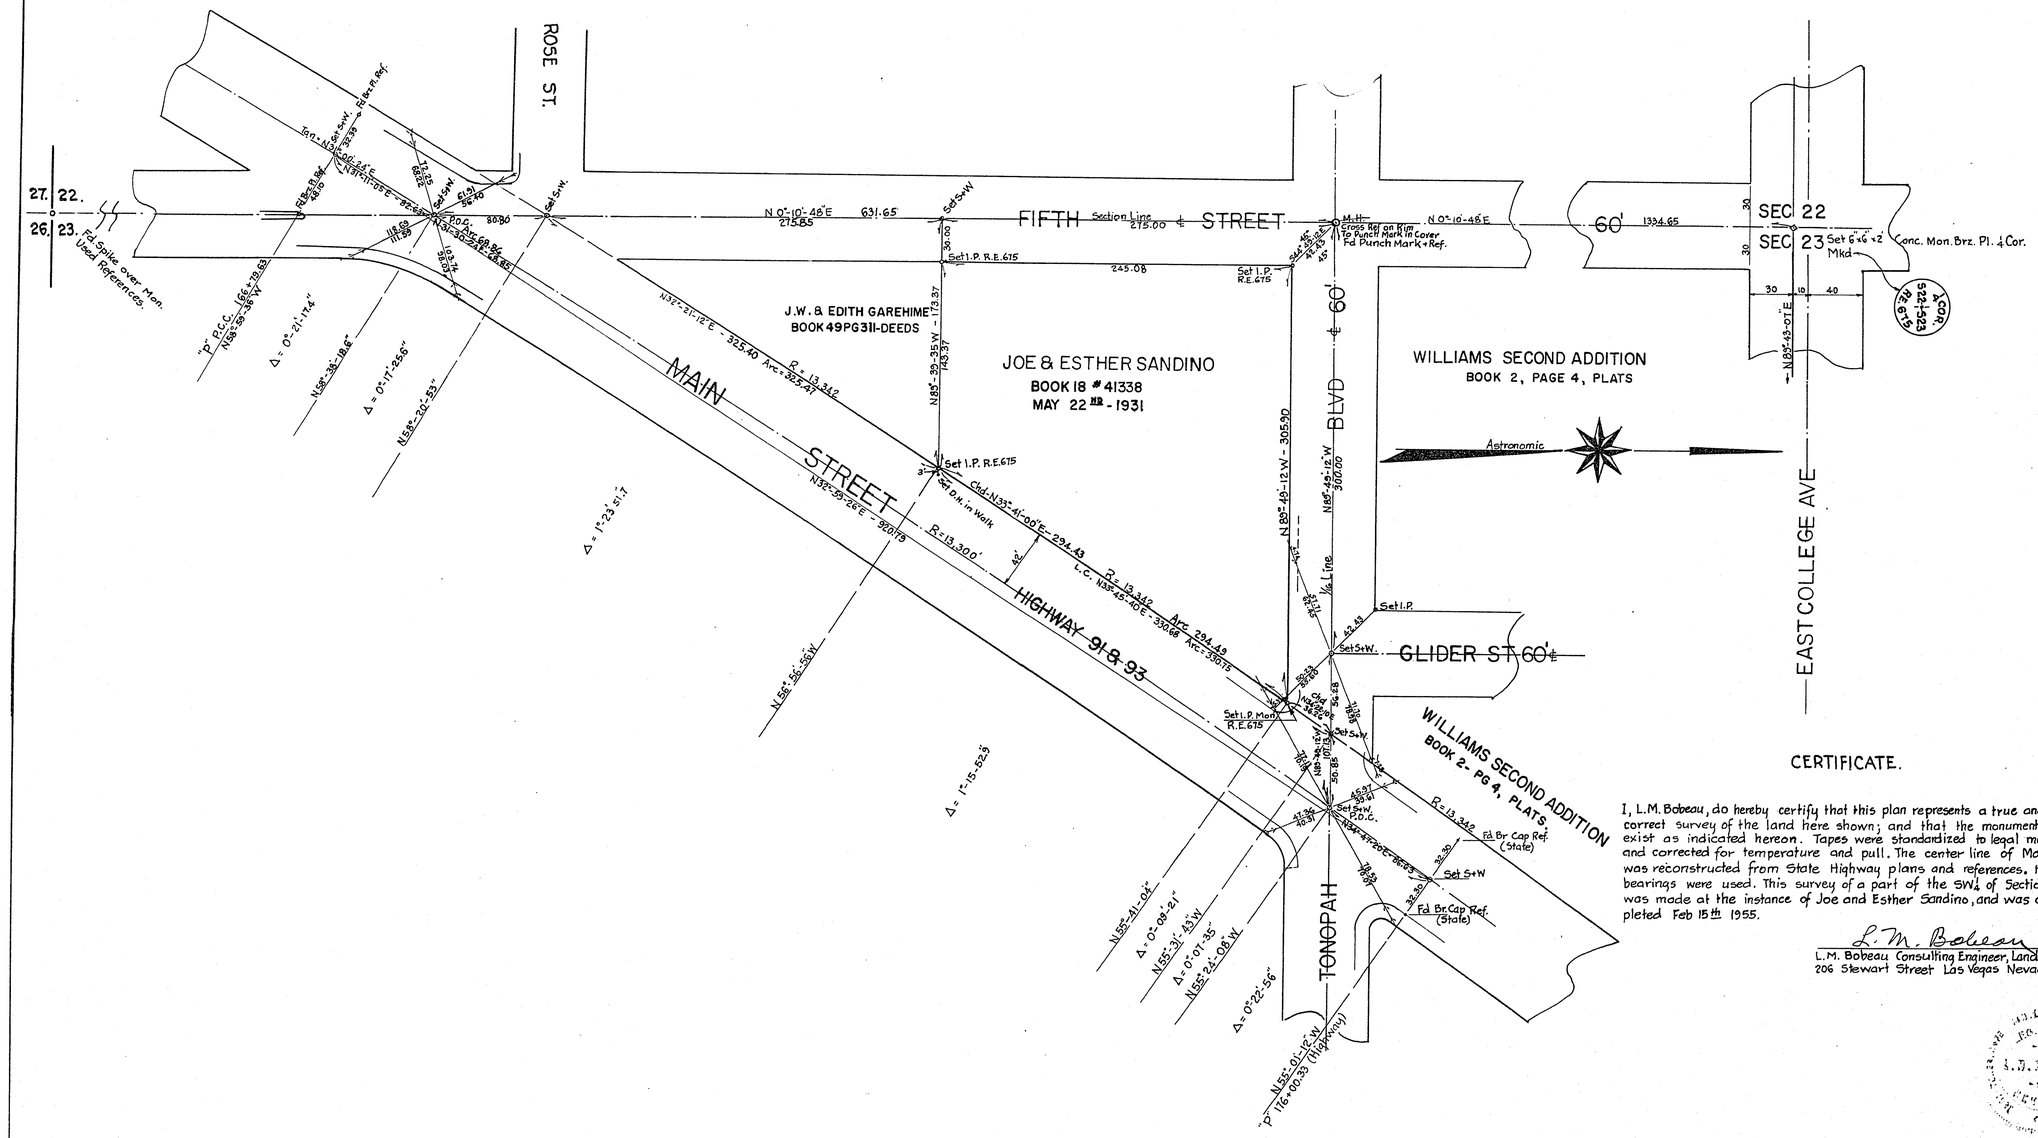

CERTIFICATE.

I, L.M. Bobeau, do hereby certify that this plan represents a true and correct survey of the land here shown; and that the monuments exist as indicated hereon. Tapes were standardized to legal measure and corrected for temperature and pull. The center line of Main St. was reconstructed from State Highway plans and references. Highway bearings were used. This survey of a part of the SW¼ of Section 23 was made at the instance of Joe and Esther Sandino, and was completed Feb 15th 1955.

L. M. Bobeau

L.M. Bobeau Consulting Engineer, Land Surveyor.
206 Stewart Street Las Vegas Nevada.

Scale 1"=50'

37220

L. M. Bobeau
2-28.55 - 2:13 p
4 - 34

L. M. Bobeau

25° 43

SURVEY
OF
PART OF NW¼-SW¼-SW¼-SEC 23-T20S R61E
NORTH LAS VEGAS
FOR
JOE & ESTHER SANDINO LAS VEGAS, NEV.

2-15-1955

File 4 PAGE 34