


RECORD OF SURVEY
FOR
SUNSET MAUSOLEUM, INC.
A portion of the NE 1/4, NE 1/4, Section 27,
T20S, R1E, MDB & M, Clark County, Nevada.
ENGINEERING SERVICE CORPORATION
LAS VEGAS
NEVADA
W.O. 9255-1
No. 651373
FILED AT THE REQUEST OF
ENGINEERING SERVICE CORPORATION
Date 7-24-67 at 12:01 P.M.
OFFICIAL RECORDS BOOK NO. 811
CLARK COUNTY, NEVADA, RECORDER
PAUL E. HORN, RECORDER
Fee \$2.50
F.M. Deputy

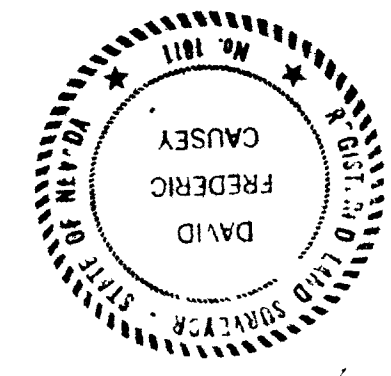

ENGINEER'S CERTIFICATE
I, David F. Causey, registered Civil Engineer and
Land Surveyor, Nevada No. 1811, do hereby certify
that this is a true and correct plat of the land
surveyed by me of the interest of Sunset Maus-
oleum, Inc., and located in the Northeast Quarter
Northeast Quarter, of Section 27, Township 20 South,
Range 61 East, MDB & M, Clark County, Nevada
and this survey was completed on this 18th day of
July, 1967 and does not constitute a subdivision as
defined by Nevada State Law.

LEGEND
o - Indicates Iron Pipe set, tagged RLS 1811
• - Indicates points found, tagged RLS 560, reset
with Iron Pipe tagged RLS 1811
□ - Indicates 2x2 Hub set
BASIS OF BEARING
The East line of Section 27, T.20S, R.1E, MDB & M,
Clark County, Nevada, as shown on Doc No 7264,
Book 5 of Official Records in the office of the
Recorder, Clark County, Nevada, N 00° 05' 00" W

