


PART OF SW 1/4 - SECTION 4, T21S, R61E, M.D.B.&M.
CLARK COUNTY NEVADA

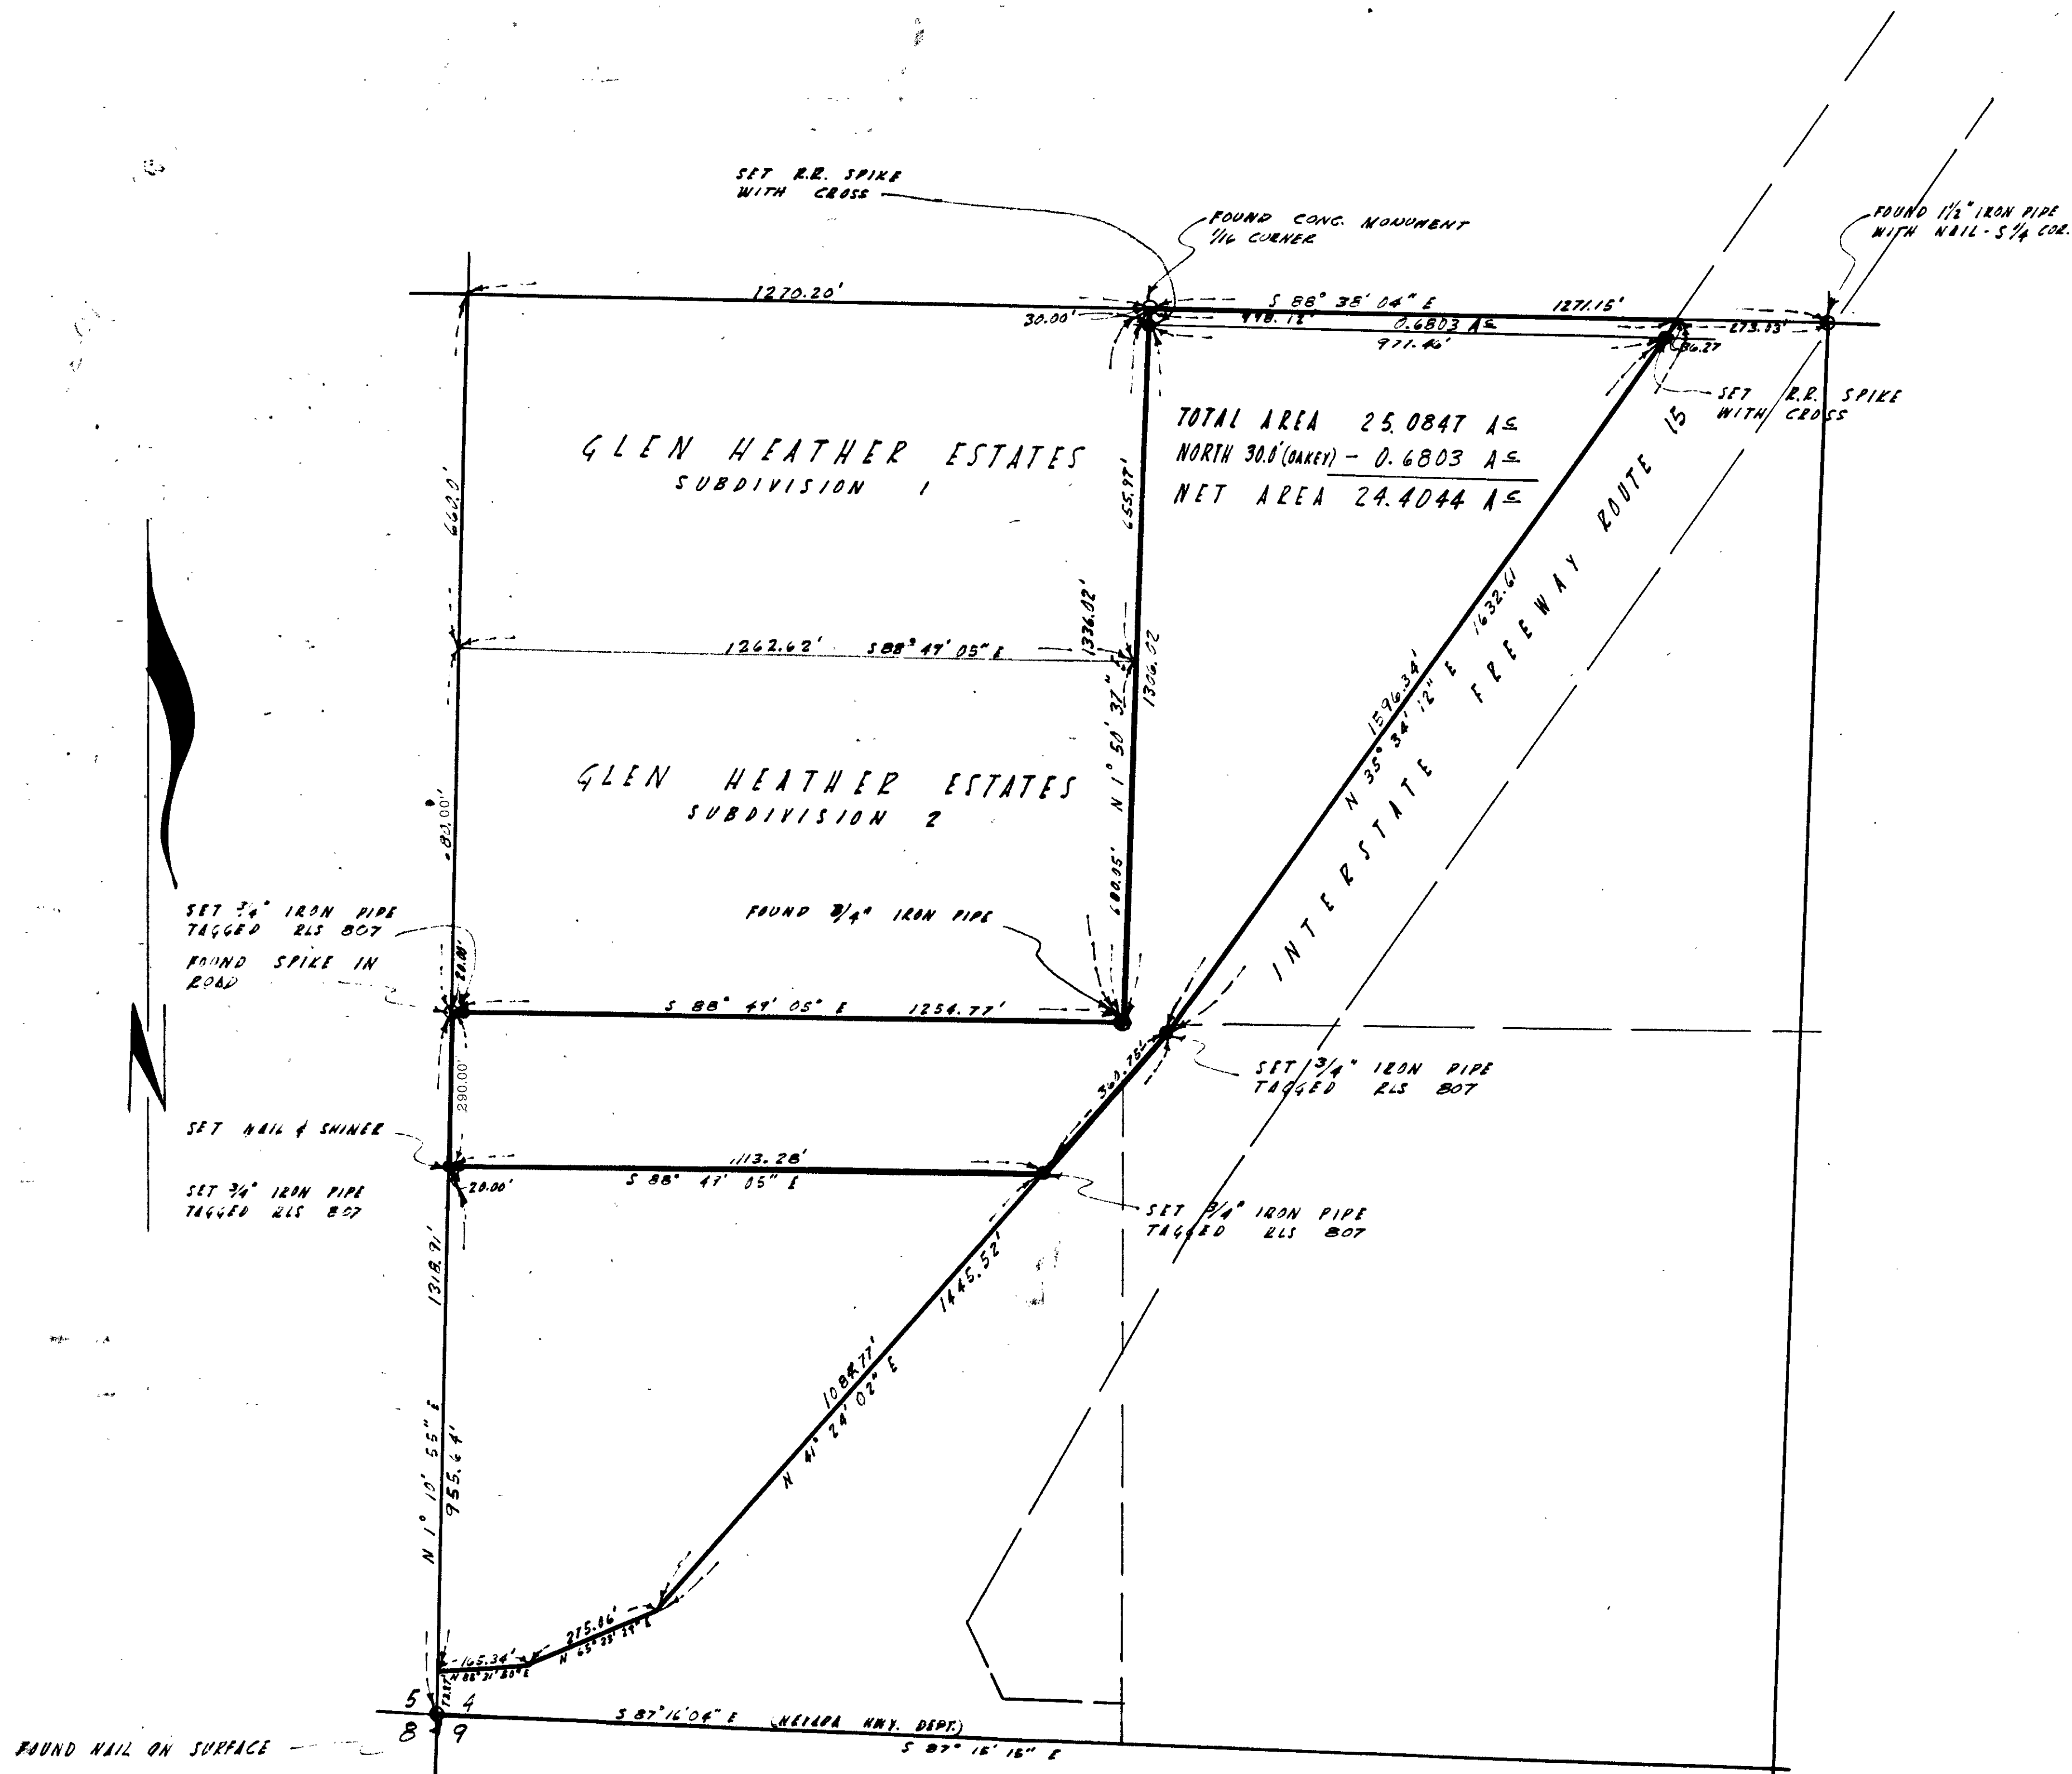

I, JACK W. LEAVITT, A REGISTERED PROFESSIONAL ENGINEER - LAND SURVEYOR OF THE STATE OF NEVADA DO HEREBY CERTIFY THAT THIS MAP IS A TRUE & ACCURATE REPRESENTATION OF THE LANDS SHOWN HEREON. ALL POINTS FOUND OR SET ARE CORRECTLY DESIGNATED. THIS SURVEY WAS COMPLETED ON OCTOBER 20, 1946 AND WAS PERFORMED AT THE INSTANCE OF DAIN PLUNKETT ET AL. THIS SURVEY DOES NOT CONSTITUTE A SUBDIVISION AS DEFINED BY NEVADA STATE LAW.

Jack R. Leavitt
 JACK R. LEAVITT
 REGISTERED PROFESSIONAL ENGINEER
 LAND SURVEYOR RLS 807



● INDICATES POINT SET- 3/4" IRON PIPE TAPPED RLS 807
○ INDICATES POINT FOUND- IS SHOWN
SCALE 1" = 200.00' ,
BASIS OF BEARING: GLEN HEATHER ESTATES SUBDIVISION 2

DATA CONCERNING LOCATION OF WEST LINE OF U.S. INTERSTATE ROUTE 15 WAS OBTAINED FROM STATE OF NEVADA DEPARTMENT OF HIGHWAYS RIGHT OF WAY MAP DATED JUNE 21, 1961.

IN CONVERTING TO BASIS OF BEARINGS OF NEVADA DEPARTMENT OF HIGHWAYS, ESTATE BEARINGS COUNTERCLOCKWISE WITH AN ADDITIVE FACTOR OF 0° 00' 49".

10-32

262087
 JACK K. LEAVITT
 10-24-61 11:47 A
 10 61
 324
 Fee \$ 2⁵⁰ J.S.

SURVEY MAP
PART OF SW $\frac{1}{4}$ SEC. 4, T21S, R41E, W.D.B.&M.
CLARK COUNTY NEVADA

SCALE 1" = 200.00'

JACK W. LEAVITT
REGISTERED PROFESSIONAL ENGINEER
LAND SURVEYOR PLS 617

FILE 10 of 61
055-230