


CERTIFICATE

I, JACK K. LEAVITT, A REGISTERED PROFESSIONAL ENGINEER-
LAND SURVEYOR OF THE STATE OF NEVADA DO HEREBY CERTIFY
THAT THIS MAP IS A TRUE AND ACCURATE REPRESENTATION OF THE
LANDS SHOWN HEREON. ALL POINTS FOUND OR SET ARE
CORRECTLY DESIGNATED. THIS SURVEY WAS COMPLETED ON
MARCH 15, 1962, AND WAS PERFORMED AT THE INSTANCE OF
NEVADA TITLE INSURANCE CO. THIS SURVEY DOES NOT CONSTITUTE A
SUBDIVISION AS DEFINED BY NEVADA STATE LAW.

Jack K. Leavitt
JACK K. LEAVITT
REGISTERED PROFESSIONAL ENGINEER
LAND SURVEYOR RE 807

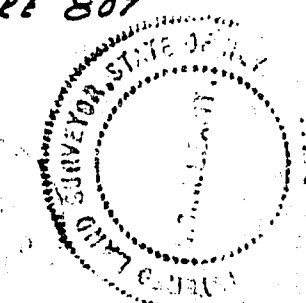

LEGEND —

- INDICATES POINT SET - 3/4" IRON PIPE TAGGED RE 807
○ INDICATES POINT FOUND - TAGGED AS SHOWN.
SCALE 1" = 300.00'
BASIS OF BEARING: U.S. HIGHWAY 95 N 36° 26' W

NOTE -

THE PARCELS INDICATED HEREON ARE NOT DIVIDED FOR THE PURPOSE OF SALE AND DO NOT CONSTITUTE A SUBDIVISION AS DEFINED BY NEVADA STATE LAWS. THEREFORE, NO REFERENCE TO THIS MAP SHOULD BE MADE IN ANY DEED OR CONVEYANCE.

REFERENCE SURVEYS

REGISTERED PROFESSIONAL ENGINEER FILE. CLARK COUNTY, NEVADA RECORDS
FILE 1, PAGE 3
FILE 1, PAGE 41
FILE 1, PAGE 37
FILE 1, PAGE 73
FILE 2, PAGE 23

UNRECORDED DATA

PIONEER TITLE INSURANCE CO. LAS VEGAS MAP 5.13, T205, R60E W&WILLIAMS 1923
PIONEER TITLE INSURANCE CO. LAS VEGAS MAP 5.7, T205, R61E W&WILLIAMS 1926
LAS VEGAS - TONOPAH R.R. E/W & TRUCK MAP 1915
STATE HIGHWAY DEPT. FIELD NOTES "ALIGNMENT" BOOK NO. 1, 1932

283220
FILE AT THE REQUEST OF
JACK LEAVITT
DATE 3-29-62 1:44 P.M.
FILE 11 PAGE 16
of Survivors
PAUL C. O'MALLEY RECORDER
Fee \$ 2.50 B.T.F. Deputy

SURVEY MAP
W 1/2 SECTION 18, T20S, R61E
M. D. B. & M.
CLARK COUNTY NEVADA
SURVEYED BY JACK K. LEAVITT
REGISTERED PROFESSIONAL ENGINEER
LAND SURVEYOR RE 8622

FILE 11 PAGE 16

12-57