


01-51

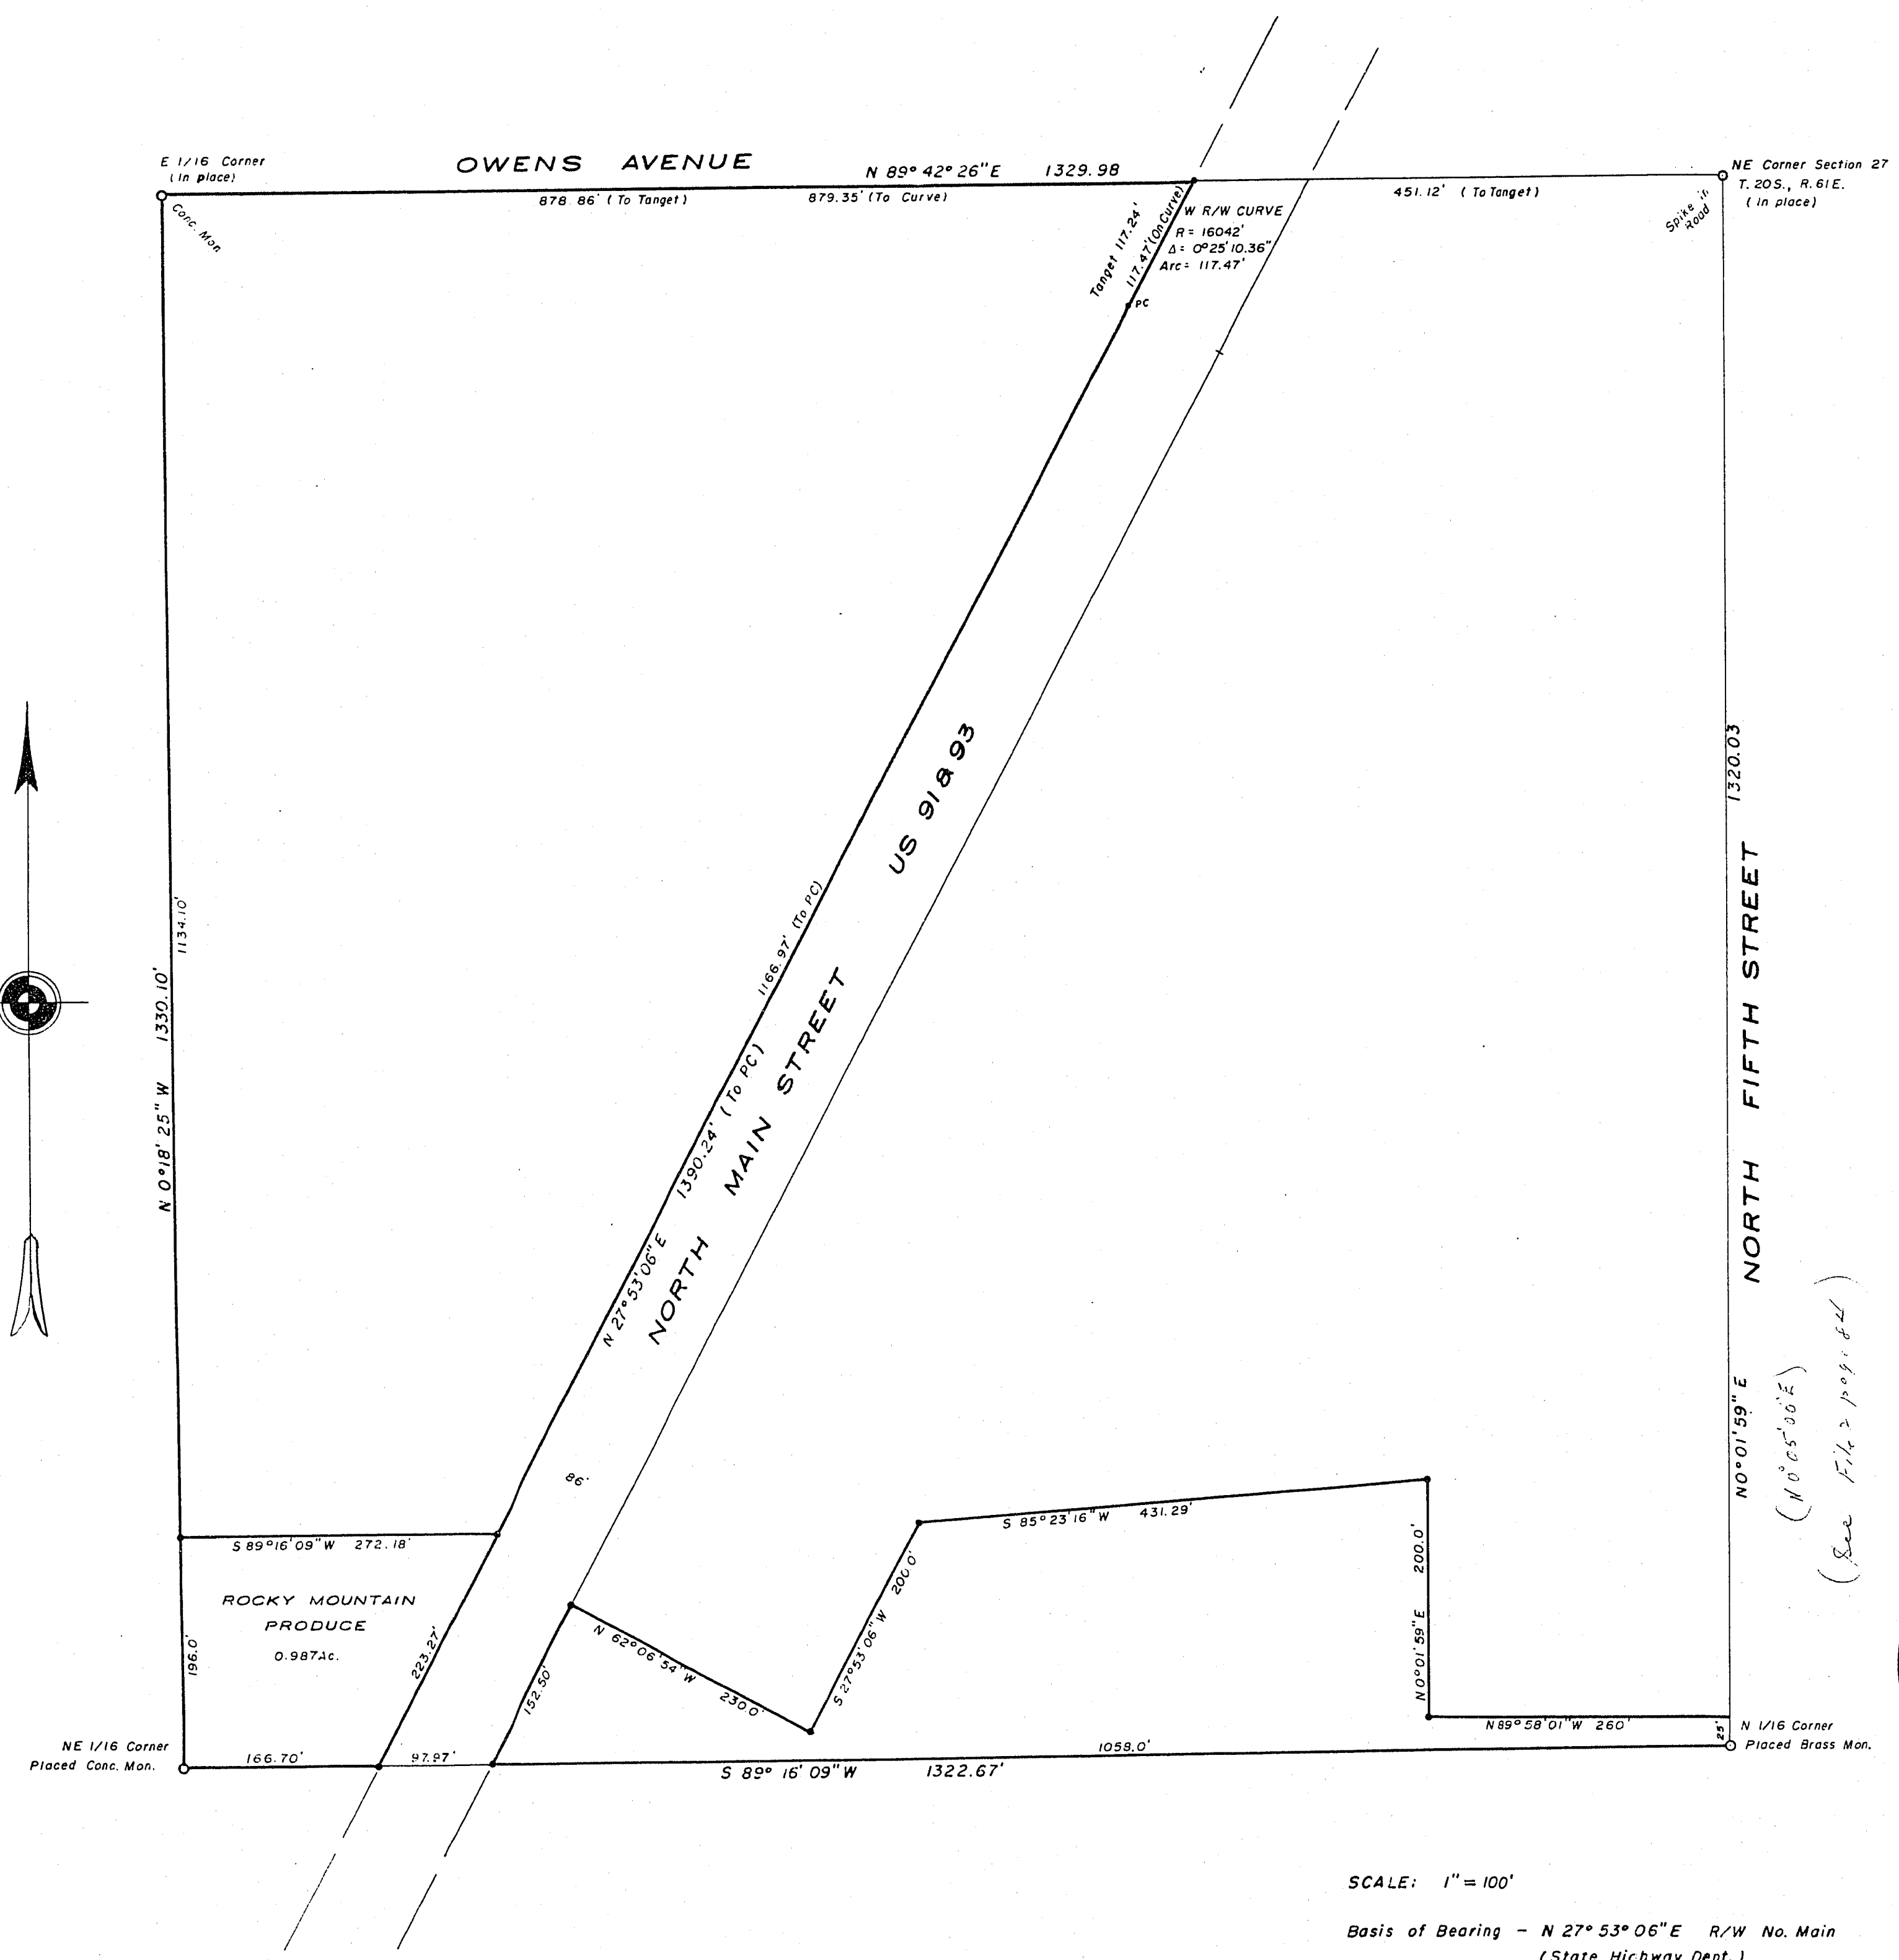

PLAT SHOWING
 SURVEY OF PARCELS IN NE 1/4
 NE 1/4 OF SEC. 27 T.20S. R.61E. M.D.B.&M.
 LAS VEGAS NEVADA

CERTIFICATE OF SURVEY

I, Karsten T. Bronken, a registered professional engineer and land surveyor, do hereby certify that the points plotted on this map accurately represent a survey made under my direct supervision at the instance of Clinton Stay. The survey was completed September 15, 1956.

Karsten T. Bronken
 Reg. Prof. Engr. Nevada R.E. 618

(N 0° 01' 59" E)
 (See File 008-7-16)

(City Survey
 008-7-16)

SCALE: 1" = 100'
 Basis of Bearing - N 27° 53' 06" E R/W No. Main
 (State Highway Dept.)

• Indicate Iron Pipe Corners