


15-35 A-54-13

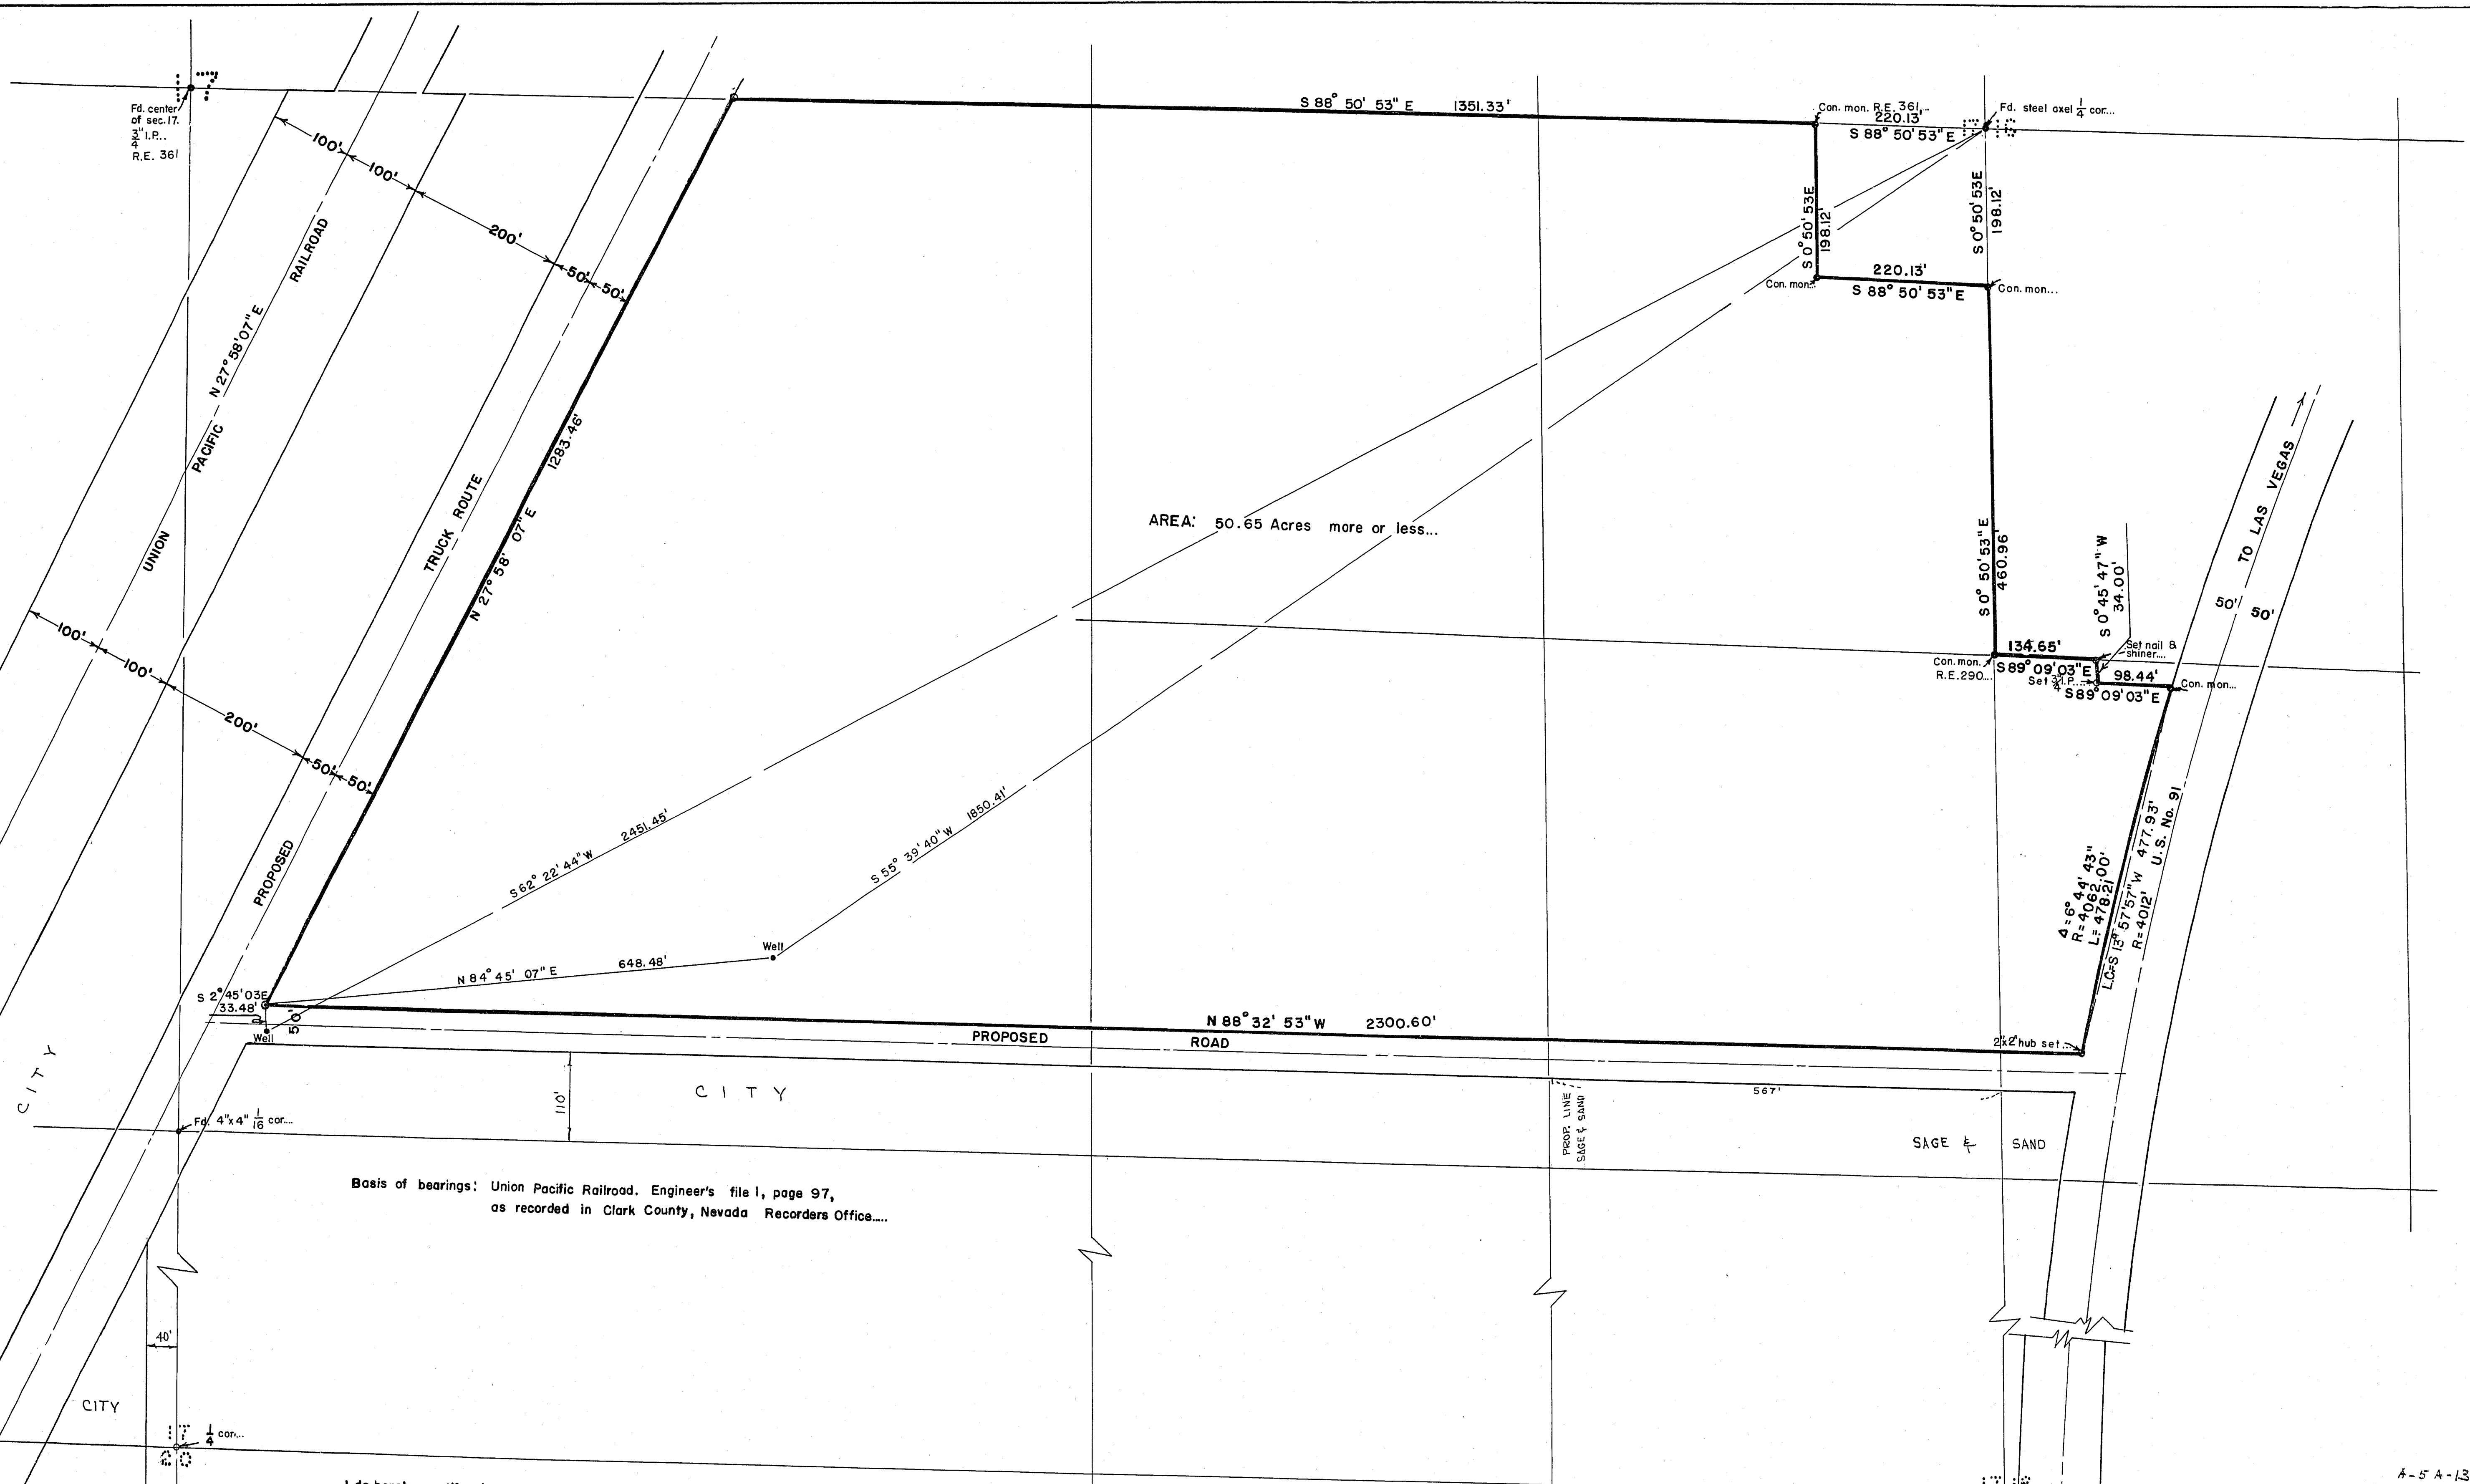

Basis of bearings: Union Pacific Railroad. Engineer's file 1, page 97,
as recorded in Clark County, Nevada Records Office....

I do hereby certify that this is a true
and correct Plat of Land surveyed at the
instance of the City of Las Vegas, Nevada.
Survey completed July 30, 1953.
[Signature]
City Engr. Cert. No. 280

A-5 A-13			
CITY OF LAS VEGAS, NEVADA			
OFFICE OF THE CITY ENGINEER			
A PORTION of the N ² of the SE ⁴ of S.17, T.2S, R.6E & A PORTION of the W ² of the SW ⁴ of S. 16, T.2S, R.6E, M.D.B. & M.			
DATE 7-29-53	SCALE 1"=100'	DRAWN BY <i>[Signature]</i>	APPROVED BY <i>[Signature]</i>

056-31