


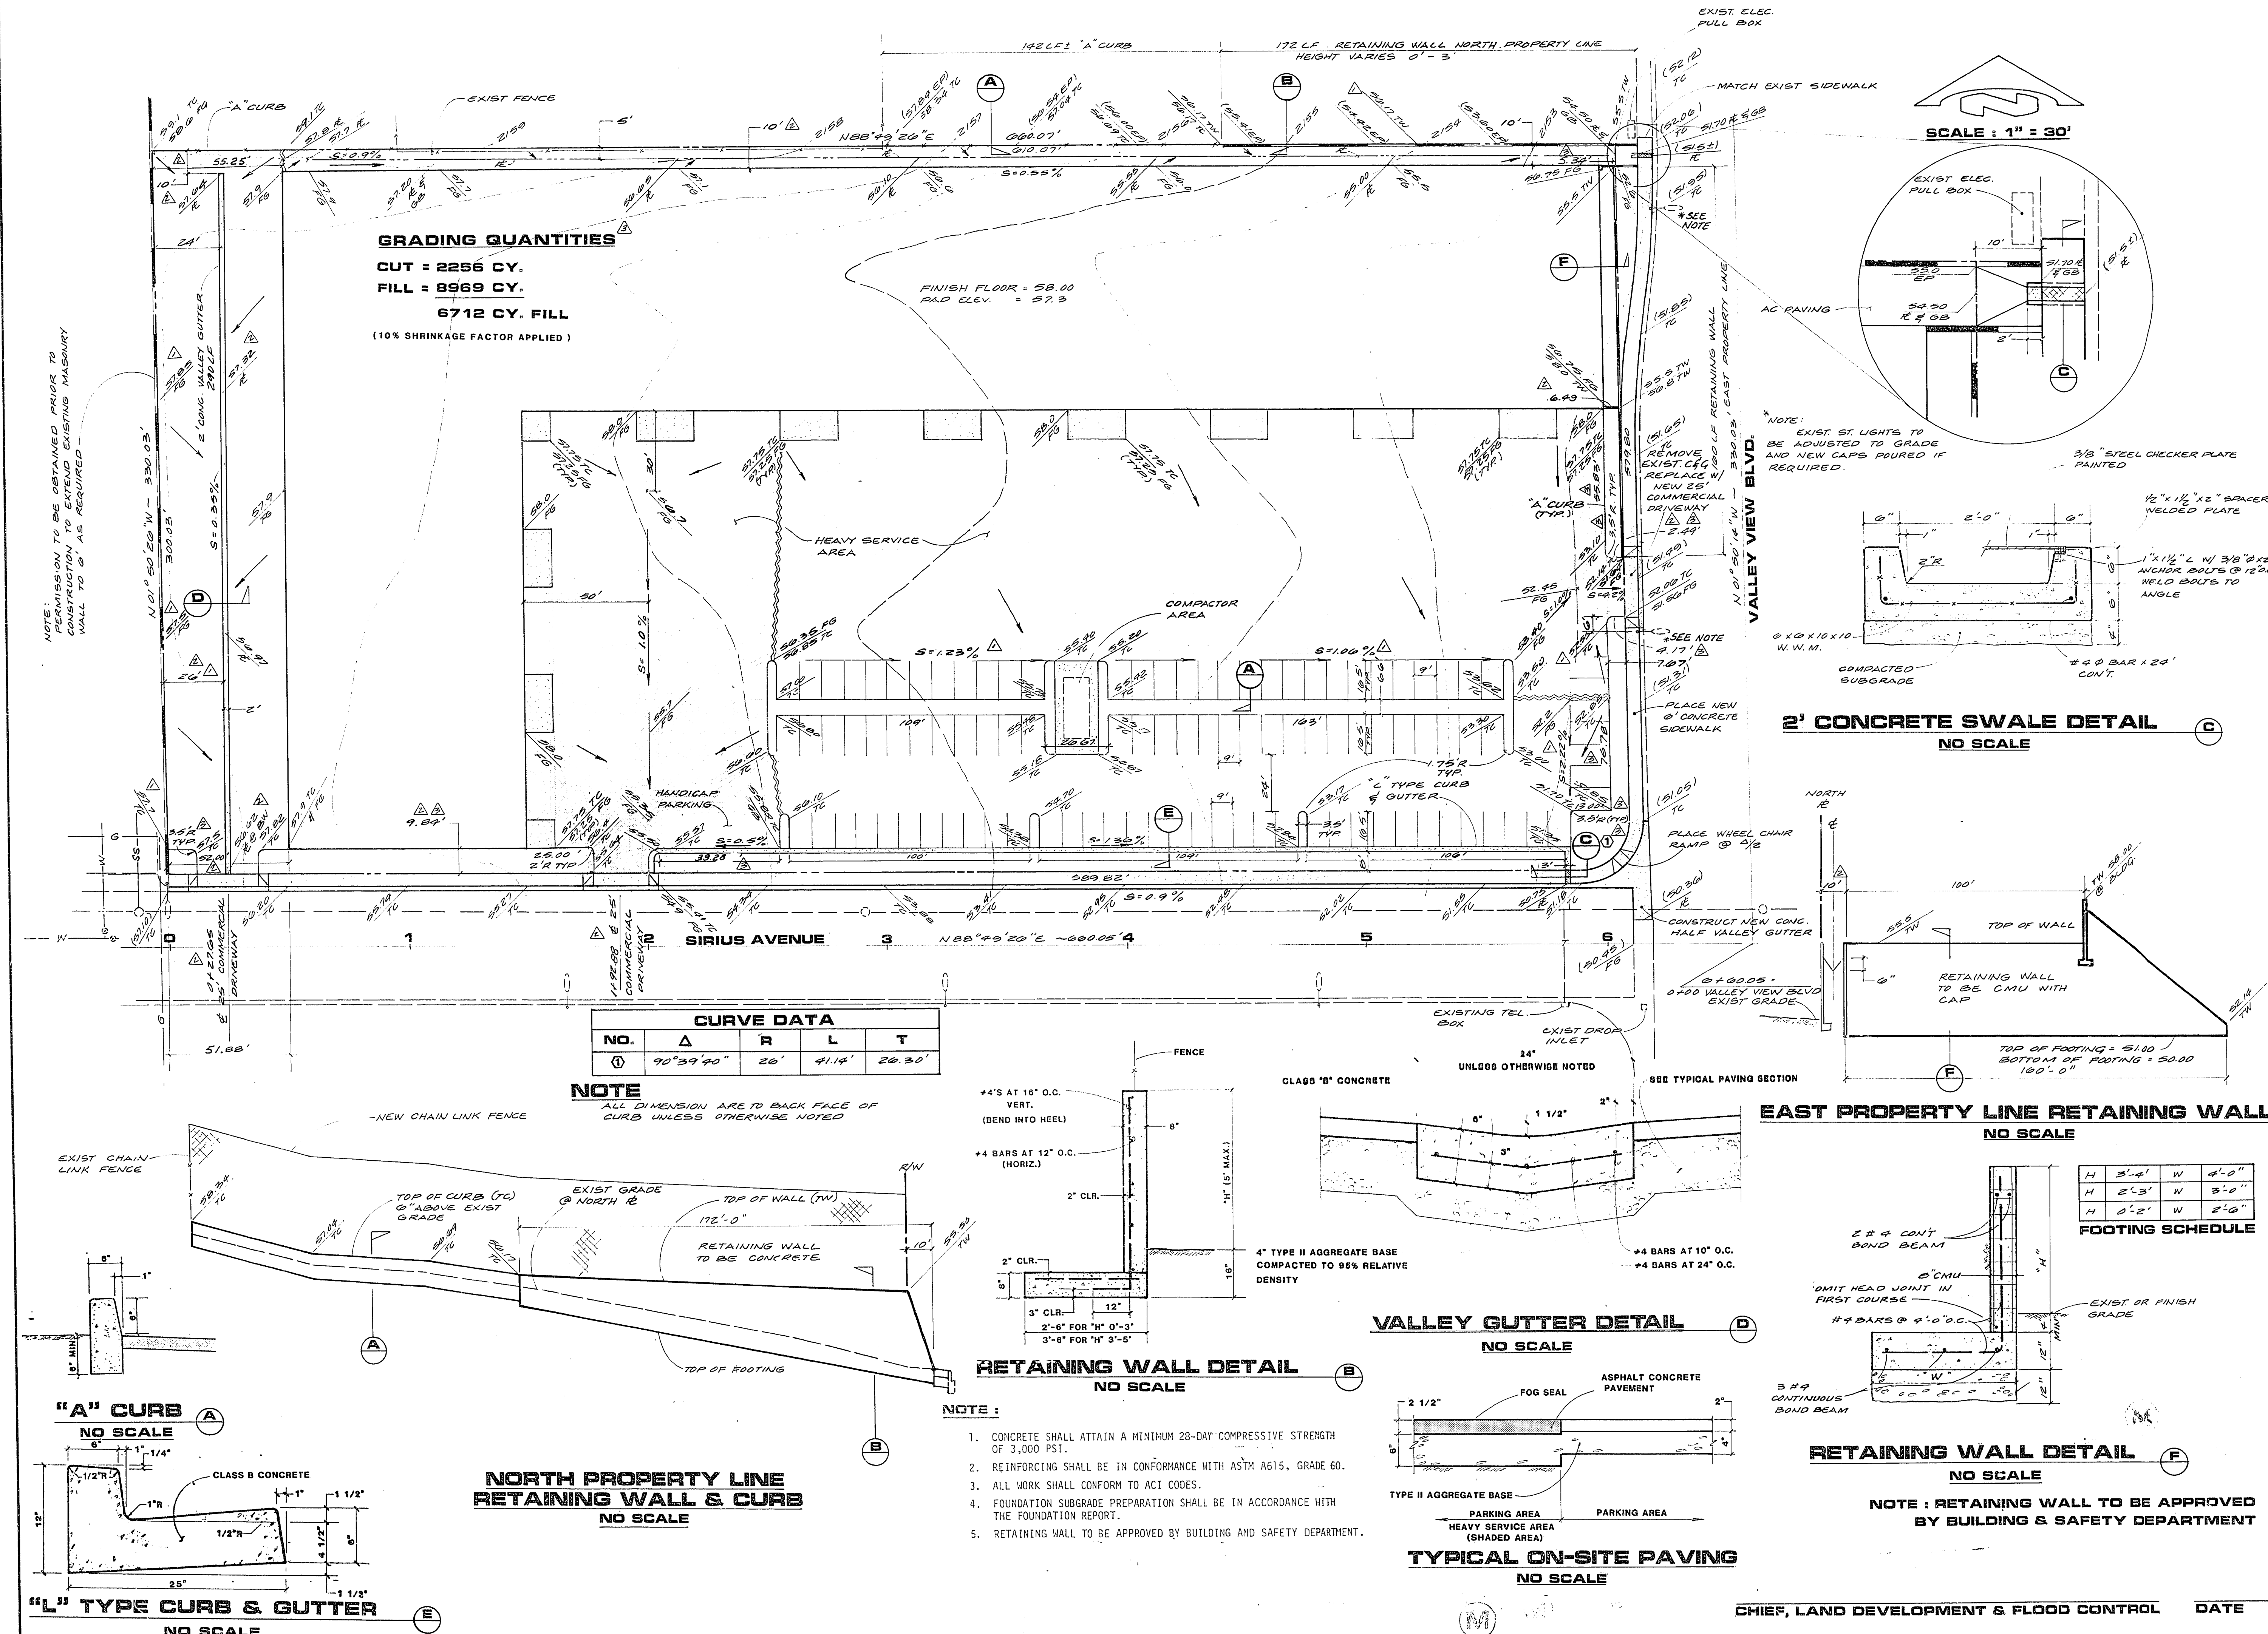

REVISIONS

NO.	DESCRIPTION/DATE	BY
1	ADDED DIMENSIONS	AC
2	CHANGED DIMENSIONS	AC
3	GRADING QUANTITIES	AC
4	ADDED DIMENSIONS	AC

PROFESSIONAL ENGINEER
 David Davis
 CIVIL
 No. 5789, RENEWED 10/10/11

2-21-85

SPARKS, NEVADA
 LAS VEGAS, NEVADA
 SEATTLE, WASHINGTON

incorporated
SEA
 ENGINEERS/PLANNERS

GRADING PLAN
THE GOLDEN SHOWCASE
 GOLDEN SHOWCASE LTD.
 A PORTION OF THE NW 1/4, OF THE SE 1/4, OF SECTION 7, T21S, R61E, MDM
 CLARK COUNTY
 LAS VEGAS

DESIGNED RM
DRAWN AC
COMP.
CHECKED
DATE DECEMBER, 1984

2
 2 OF 4 SHEETS