
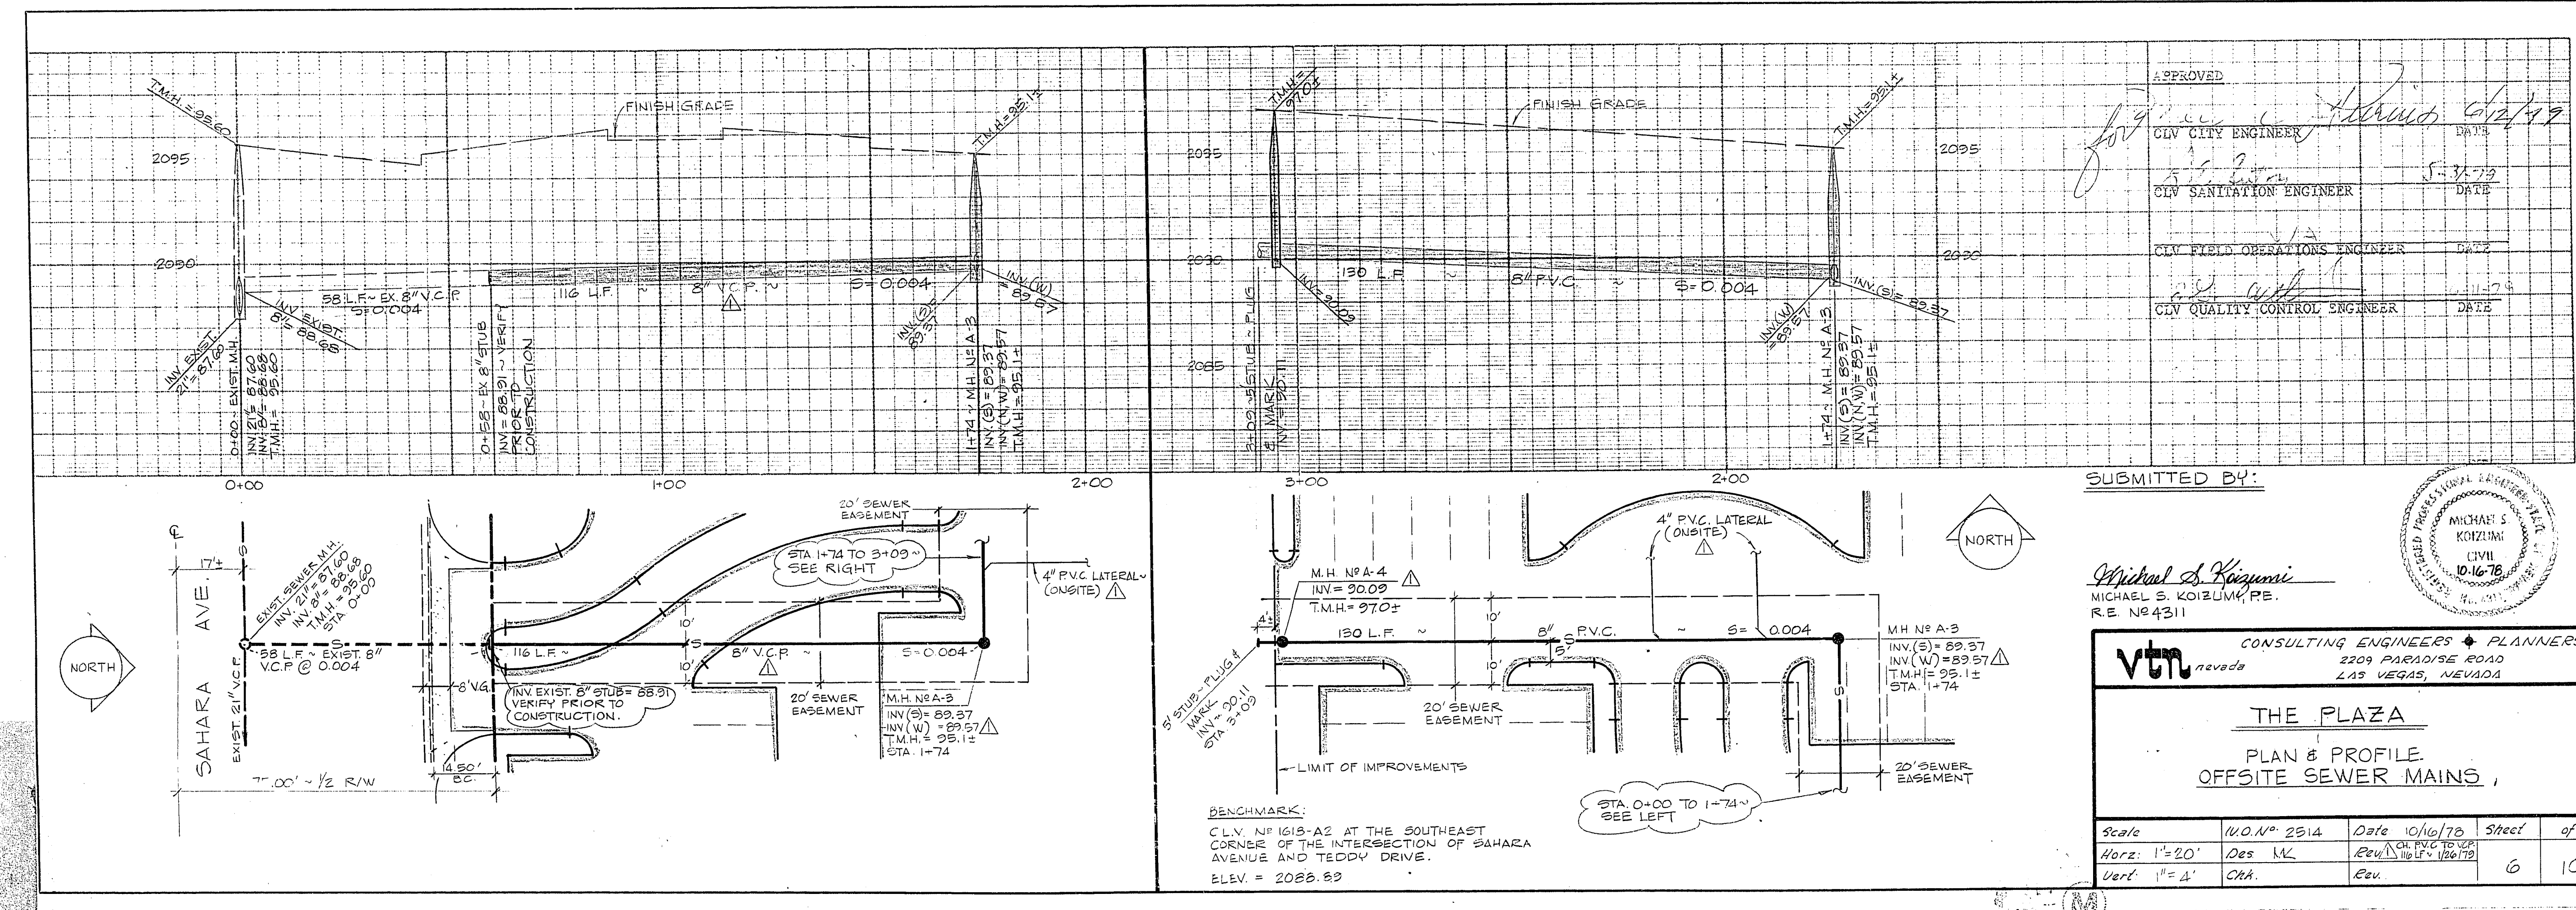


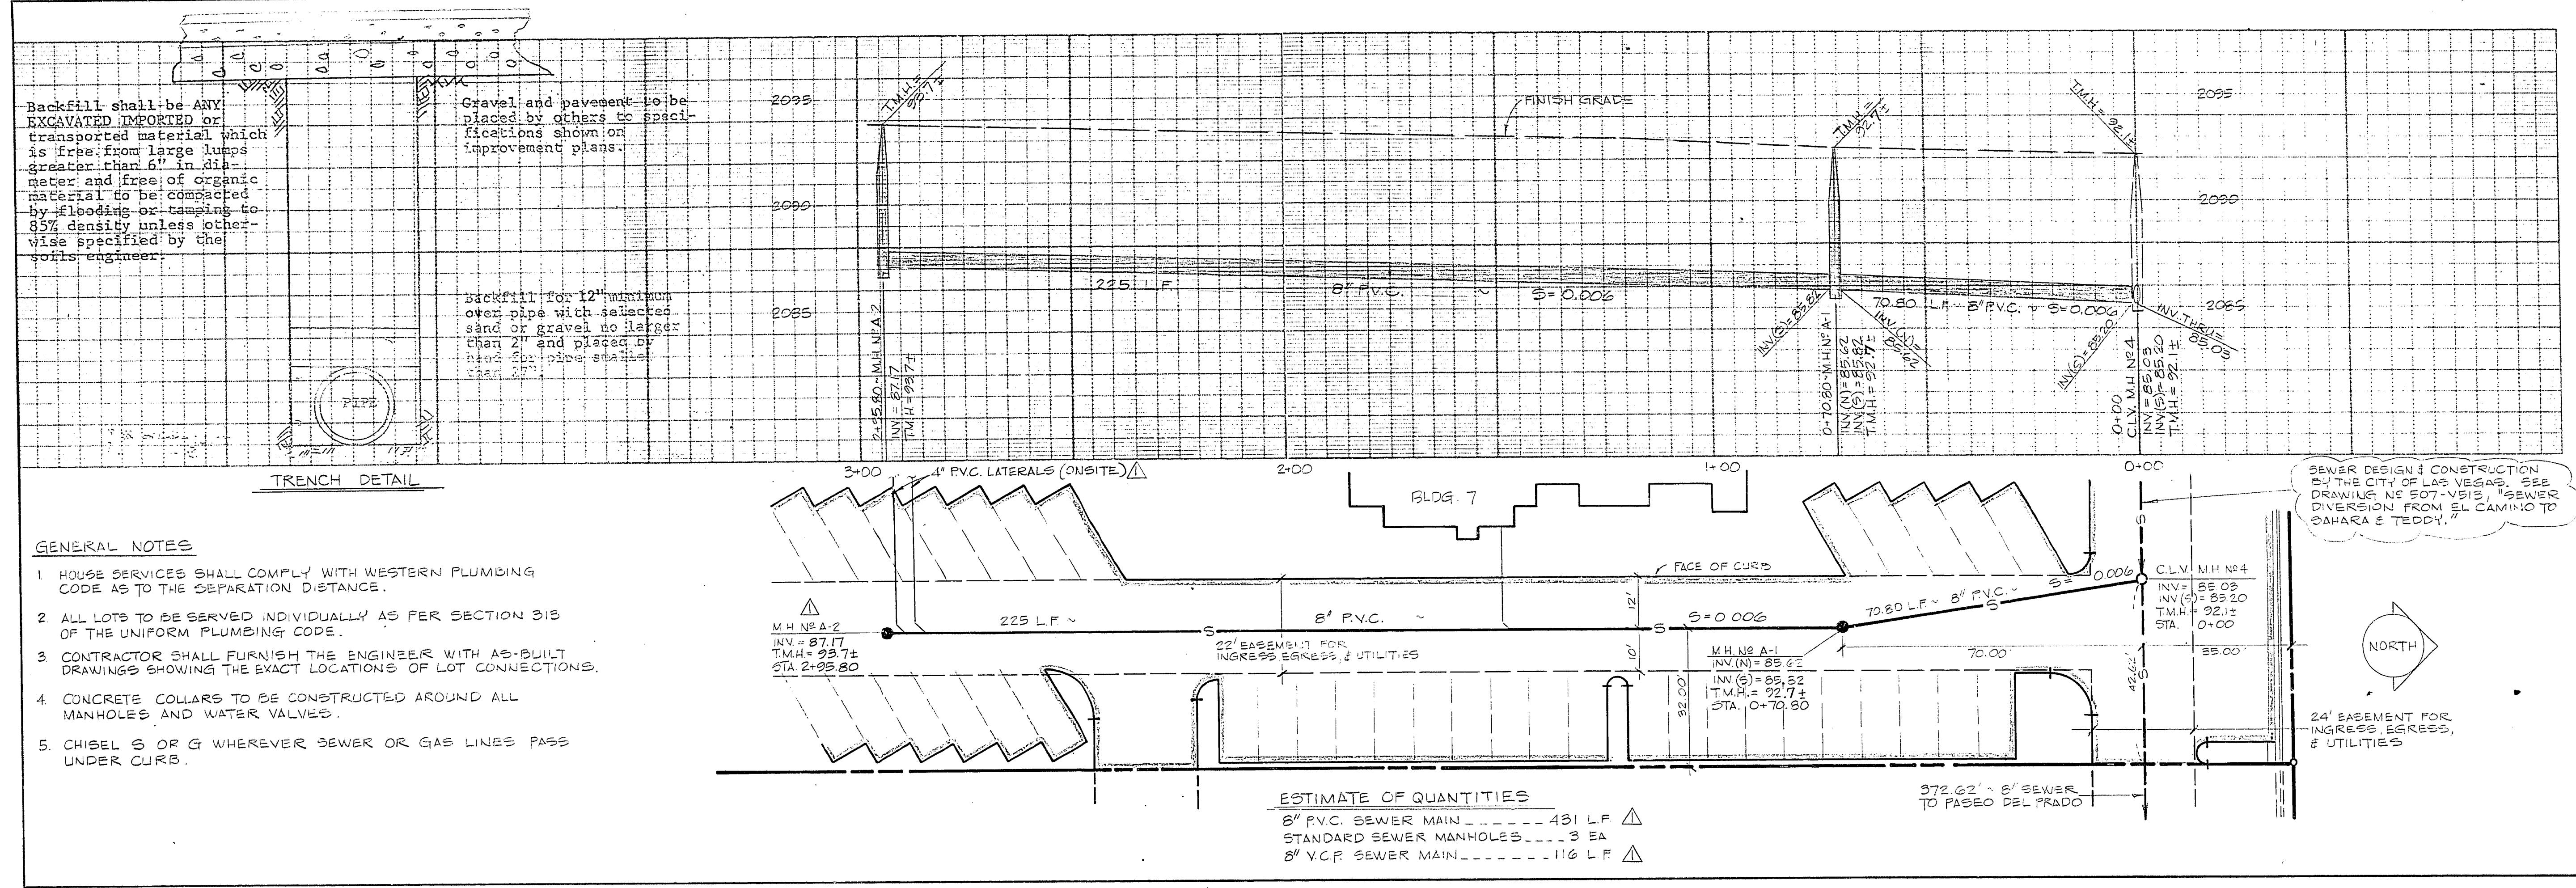

APPROVED

[Signature] CIVIL CITY ENGINEER DATE 5-31-79

[Signature] CIVIL SANITATION ENGINEER DATE

[Signature] CIVIL FIELD OPERATIONS ENGINEER DATE

[Signature] CIVIL QUALITY CONTROL ENGINEER DATE

SUBMITTED BY:

[Signature] Michael S. Koizumi

MICHAEL S. KOIZUMI, P.E.
RE. NO. 4311

THE PLAZA

PLAN & PROFILE
OFFSITE SEWER MAINS

Scale	NO. 2514	Date	10/10/76	Sheet	of
Horizontal	1"=20'	Des	KK	Rev	10/10/79
Vertical	1"=4'	CHK		Rev	