


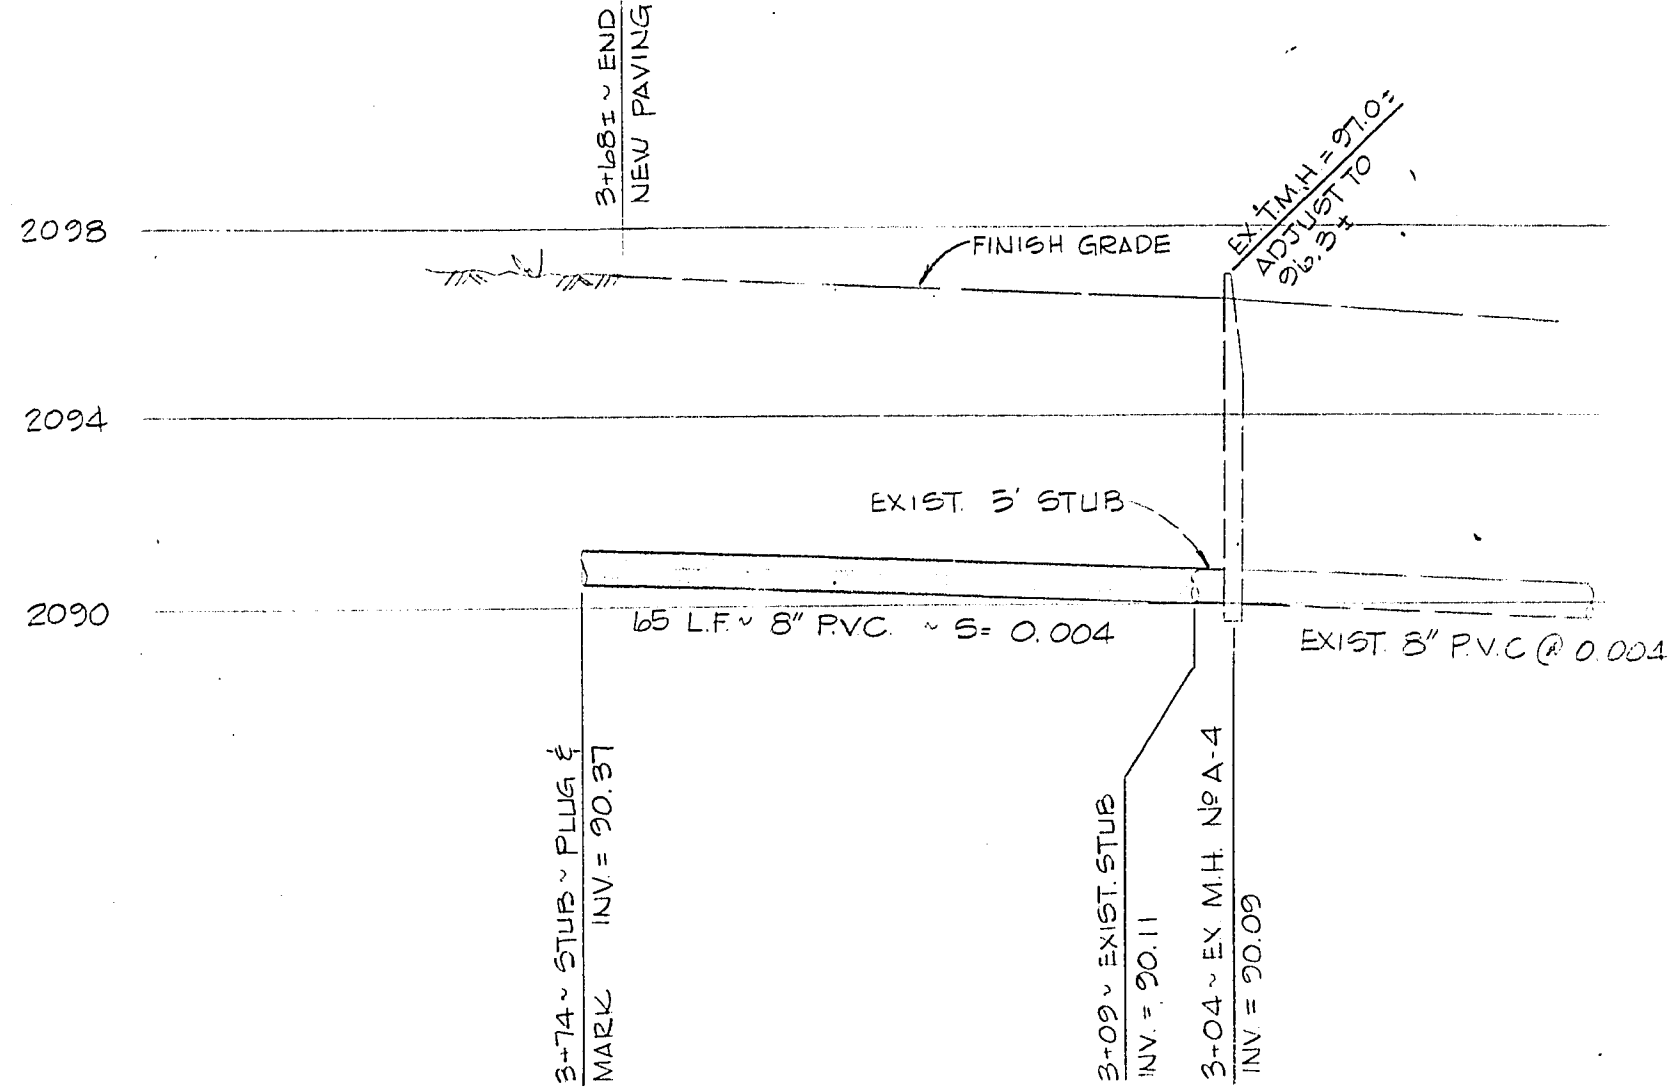


**SEWER PROFILE**  
1"=20' HORIZ., 1"=4' VERT.

**QUANTITY ESTIMATE**


|                                      |        |
|--------------------------------------|--------|
| 8" PVC SEWER MAIN                    | 65 LF  |
| 4" PVC SEWER LATERAL                 | 45 LF  |
| 8" ACP WATER MAIN                    | 104 LF |
| 4" ABS CONDUIT                       | 57 LF  |
| ADJUST TOP OF EXISTING SEWER MANHOLE | 1 EACH |

**BENCH MARK :**


CLV. N° 1618-A2 AT THE SOUTHEAST CORNER OF THE INTERSECTION OF TEDDY DRIVE AND SAHARA AVENUE.  
ELEVATION = 2088.89

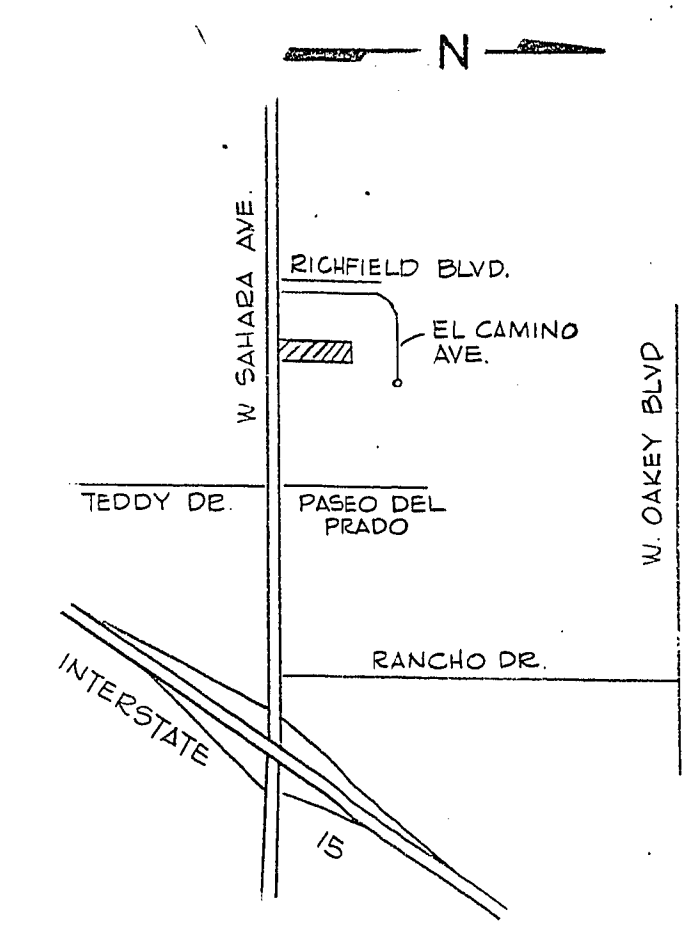

**VICINITY MAP**

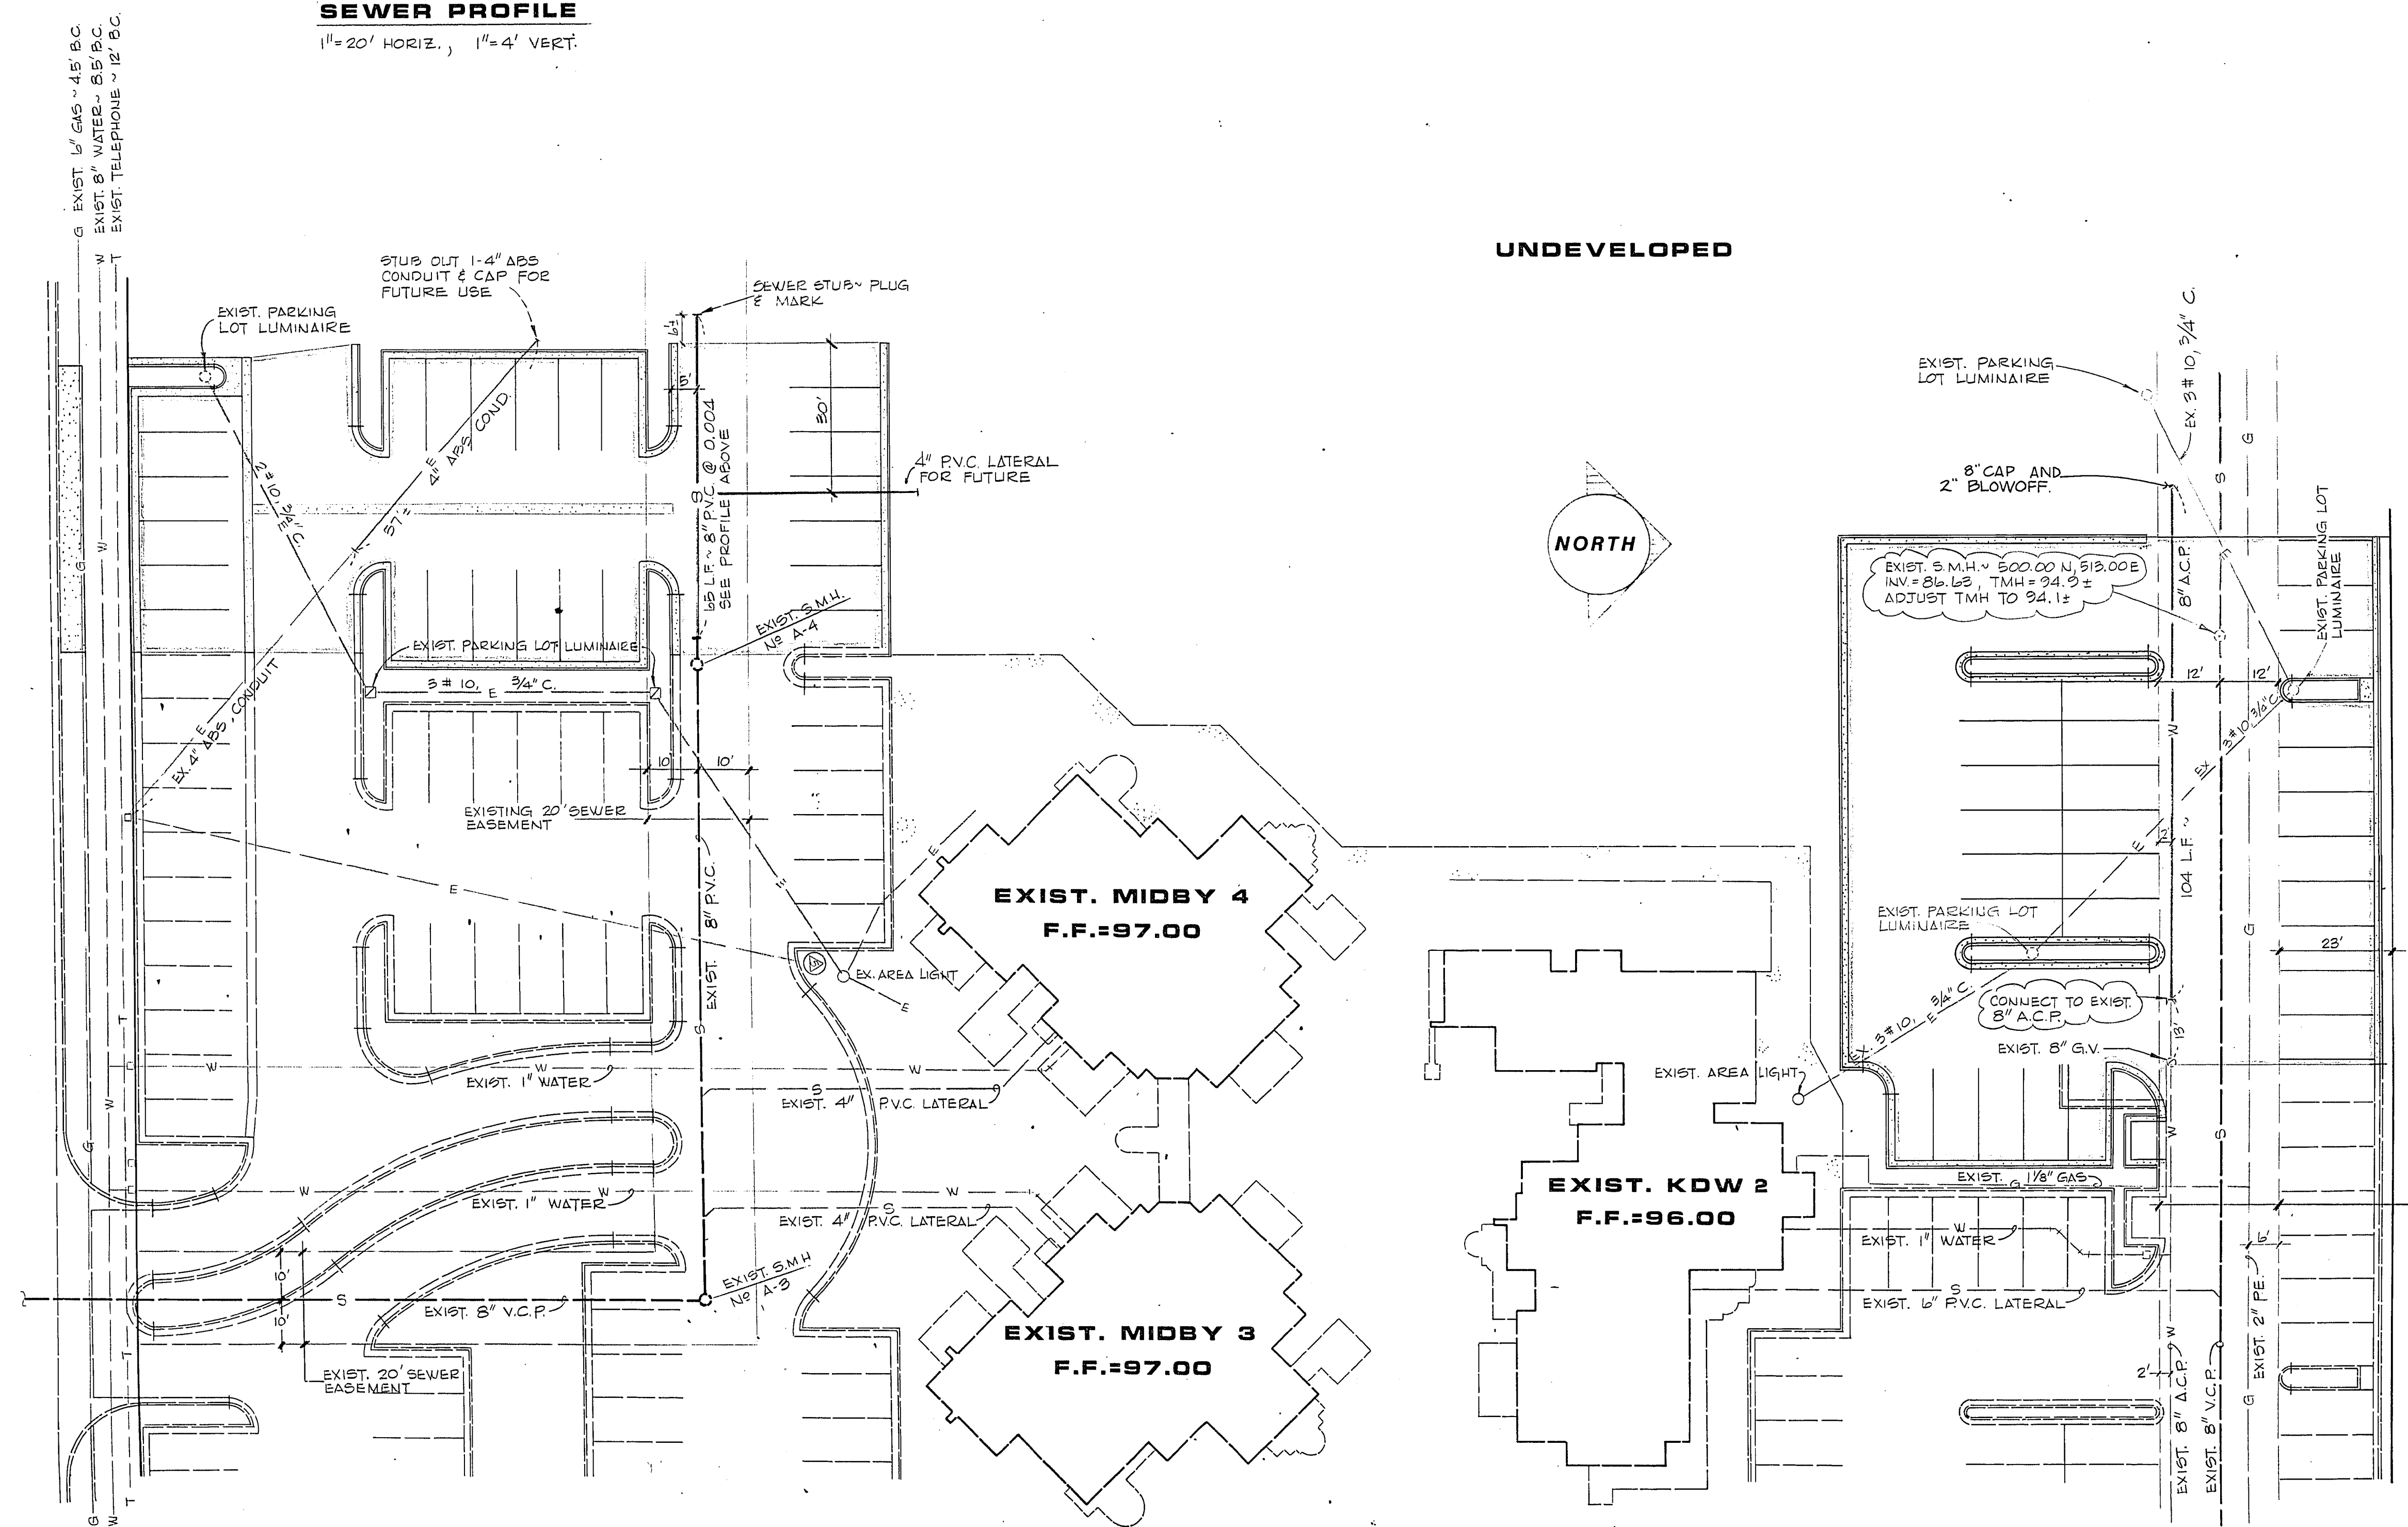

UNDEVELOPED

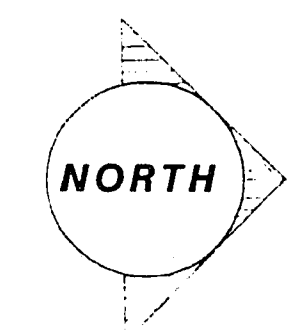

**APPROVALS :**

*Howe Val W.C.* 3-25-81  
LAS VEGAS VALLEY WATER DIST. DATE  
*[Signature]* 3/24/81  
CLV. CITY ENGINEER DATE  
*[Signature]* 3-25-81  
CLV. SANITATION ENGINEER DATE  
*[Signature]* 3-25-81  
CLV. QUALITY CONTROL ENGR. DATE

|                                                            |                                                   |    |        |     |      |      |
|------------------------------------------------------------|---------------------------------------------------|----|--------|-----|------|------|
| TITLE<br><b>MASTER SEWER &amp; WATER<br/>PLAN REVISION</b> | REVISION                                          | BY | DATE   | REV | DATE | DATE |
|                                                            | 1                                                 | ML | 2/4/81 | 1   |      |      |
|                                                            | SUBMITTED BY: <i>[Signature]</i> DATE: 2/4/81     |    |        |     |      |      |
|                                                            | MICHAEL S. KOIZUMI, P.E.<br>NEVADA CERT. NO. 4311 |    |        |     |      |      |
| PROJECT<br><b>THE PLAZAS</b>                               | CONSULTING ENGINEERS • PLANNERS                   |    |        |     |      |      |
|                                                            | 2209 Paradise Road • Las Vegas, Nevada 89104      |    |        |     |      |      |
|                                                            | (702) 735-0227                                    |    |        |     |      |      |
|                                                            | vtn nevada                                        |    |        |     |      |      |
| WO NO                                                      | 2514                                              |    |        |     |      |      |
| BY                                                         | MK                                                |    |        |     |      |      |
| DATE                                                       | 2/4/81                                            |    |        |     |      |      |
| SCALE                                                      | 1"=20'                                            |    |        |     |      |      |
| SHEET                                                      | 8A                                                |    |        |     |      |      |
| OF 10 SHEETS                                               |                                                   |    |        |     |      |      |