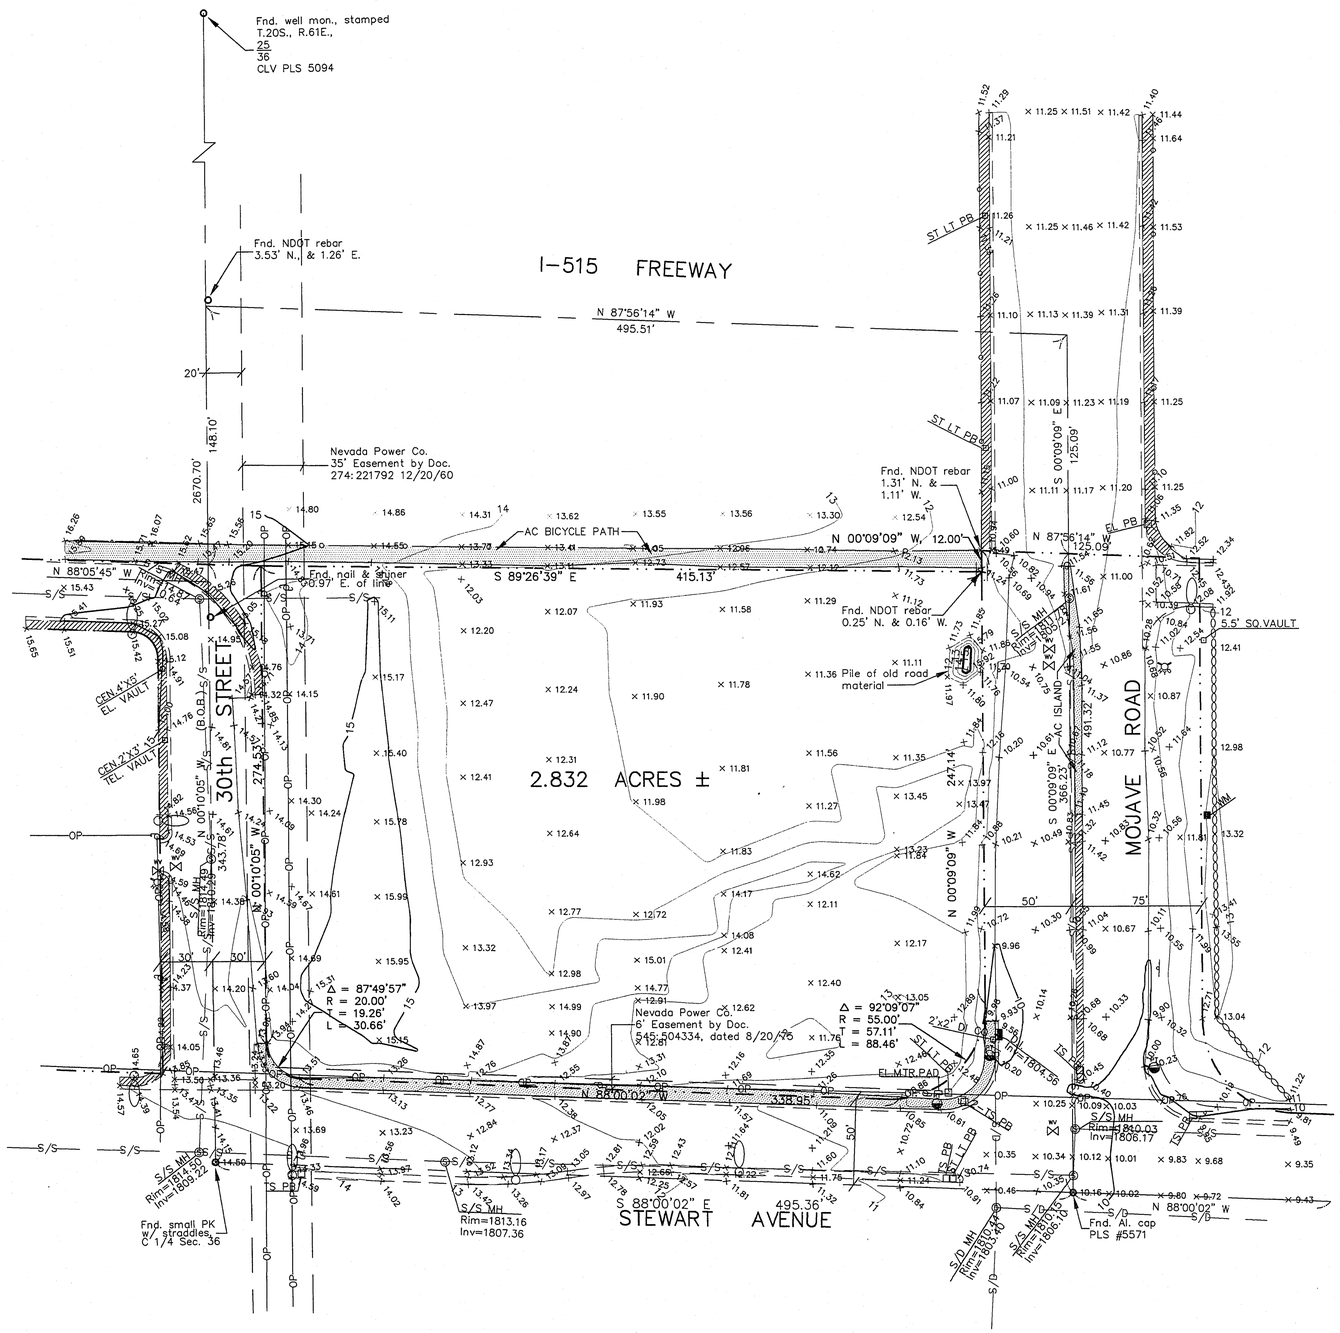

SCALE : 1" = 40'

BASIS OF BEARINGS

The west line of the NE 1/4 of Section 36, T 20 E, R 61 E, M.D.M., being the centerline of 30th Street, bears N 00°10'05" W as shown in Book 8, Page 14 of Plats, Official Records of Clark County, Nevada.

BENCHMARK

BM #2LV0136C4
Rivet & plate in T/C at the SE Return of Stewart & Mojave
Elevation = 1809.84

NOTES:

1.) The boundary as shown hereon was taken from Record of Survey, File 64, Page 66, Official Records of Clark County, Nevada.

2.) The utilities as shown hereon were taken from above ground appurtenances and record information; the contractor is responsible for determining actual locations before any construction is begun.

LEGEND

	Sidewalk
	Right-of-way line
	Block wall
	Chain link fence
	Centerline
TS PB	Traffic signal pullbox
	Traffic Signal pole
S/S MH	Sanitary Sewer manhole
S/D MH	Storm Drain manhole
	Sign
WM	Water Meter
ST LT PB	Street light pullbox
	Street light
OP	Power pole with overhead power lines
EL.MTR.PAD	Electric Meter pad
WV	Water valve
	Fire hydrant
× 10.77	Spot elevation
	AC Sidewalk or curb as shown
	Concrete sidewalk
12	Contour line with elevation

REVISIONS		
NO.	DESCRIPTION/DATE	BY

DEPARTMENT OF PUBLIC WORKS

SURVEY SECTION

TOPOGRAPHIC SURVEY

CITY OF LAS VEGAS PROPERTY / STEWART AVENUE & MOJAVE ROAD

A PORTION OF THE S 1/2 OF THE NE 1/4 OF SECTION 36, T 20 S, R 61 E, M.D.M.

CITY OF LAS VEGAS — CLARK COUNTY — NEVADA

DESIGNED	DRAWN ME
CHECKED	STEWMO.DWG
DATE DECEMBER 1993	FIELD BOOK NO. 93-4X

15-2

CITY OF LAS VEGAS NEVADA

DRAWING NO. 056-79

1/1