


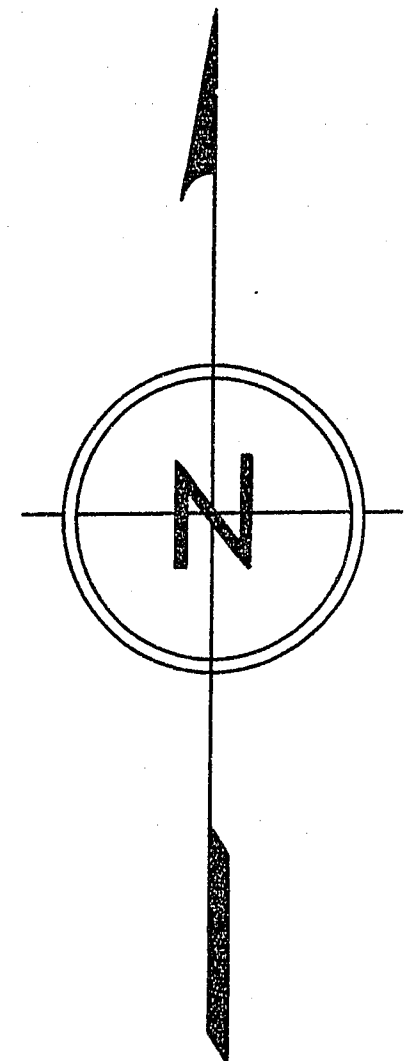

SURVEY OF
TRENTS TRAILER COURT
NORTH LAS VEGAS NEVADA

I, J.V. Caselli, Registered Engineer No. 451, made this Survey at the request of Wm. Trent, manager and part owner of Trents Trailer Court, owned and operated by Wm. Trent, Walter Argyle and Bruce Stanfield, which is in the incorporated City of North Las Vegas, Nevada, County of Clark. A more complete description of which follows.

Beginning at a point which bears N 89° 42' E, ninety five and five tenths feet (95.5) and N 0° 12' E twenty five feet (25) more or less from an iron pin at the intersection of Rose and Ely Streets, thence N 0° 12' E three hundred feet (300) more or less to a point, thence along the south boundary of Beams Amended Addition, N 89° 39' E seven hundred sixty seven and eighteen hundredths feet (767.18) more or less to a point, thence S 0° 12' W fifty feet (50) more or less to a point, thence N 89° 39' E one hundred and ten feet (110) more or less to a point, thence S 0° 12' W two hundred and fifty feet (250) more or less to a point, thence S 89° 39' 02" W eight hundred seventy seven and seventeen hundredths feet (877.17) more or less to the point of beginning. All of which contains five and ninety one hundredths (5.91) acres, laying in the S.E. 1/4 of Sec. 22, T.20S, R.61E, M.D.B.M.

J.V. Caselli
Registered Engineer No. 451

CERTIFICATE

North Las Vegas, Nevada
3-26-47

I hereby certify that the plot hereon delineated is a correct one and that permanent monuments, consisting of 1/2" Iron Pipe have been set at points so marked as thereon shown at all angles on the boundaries of the land plotted.

J.V. Caselli
Registered Engineer No. 451

Las Vegas, Nevada


has appeared before me this date, and requested this plat map of Trents Trailer Court be recorded.

County Recorder

Witness

BASIS OF BEARINGS.
South line of Beams Amended Addition.

SCALE 1"=50 FEET

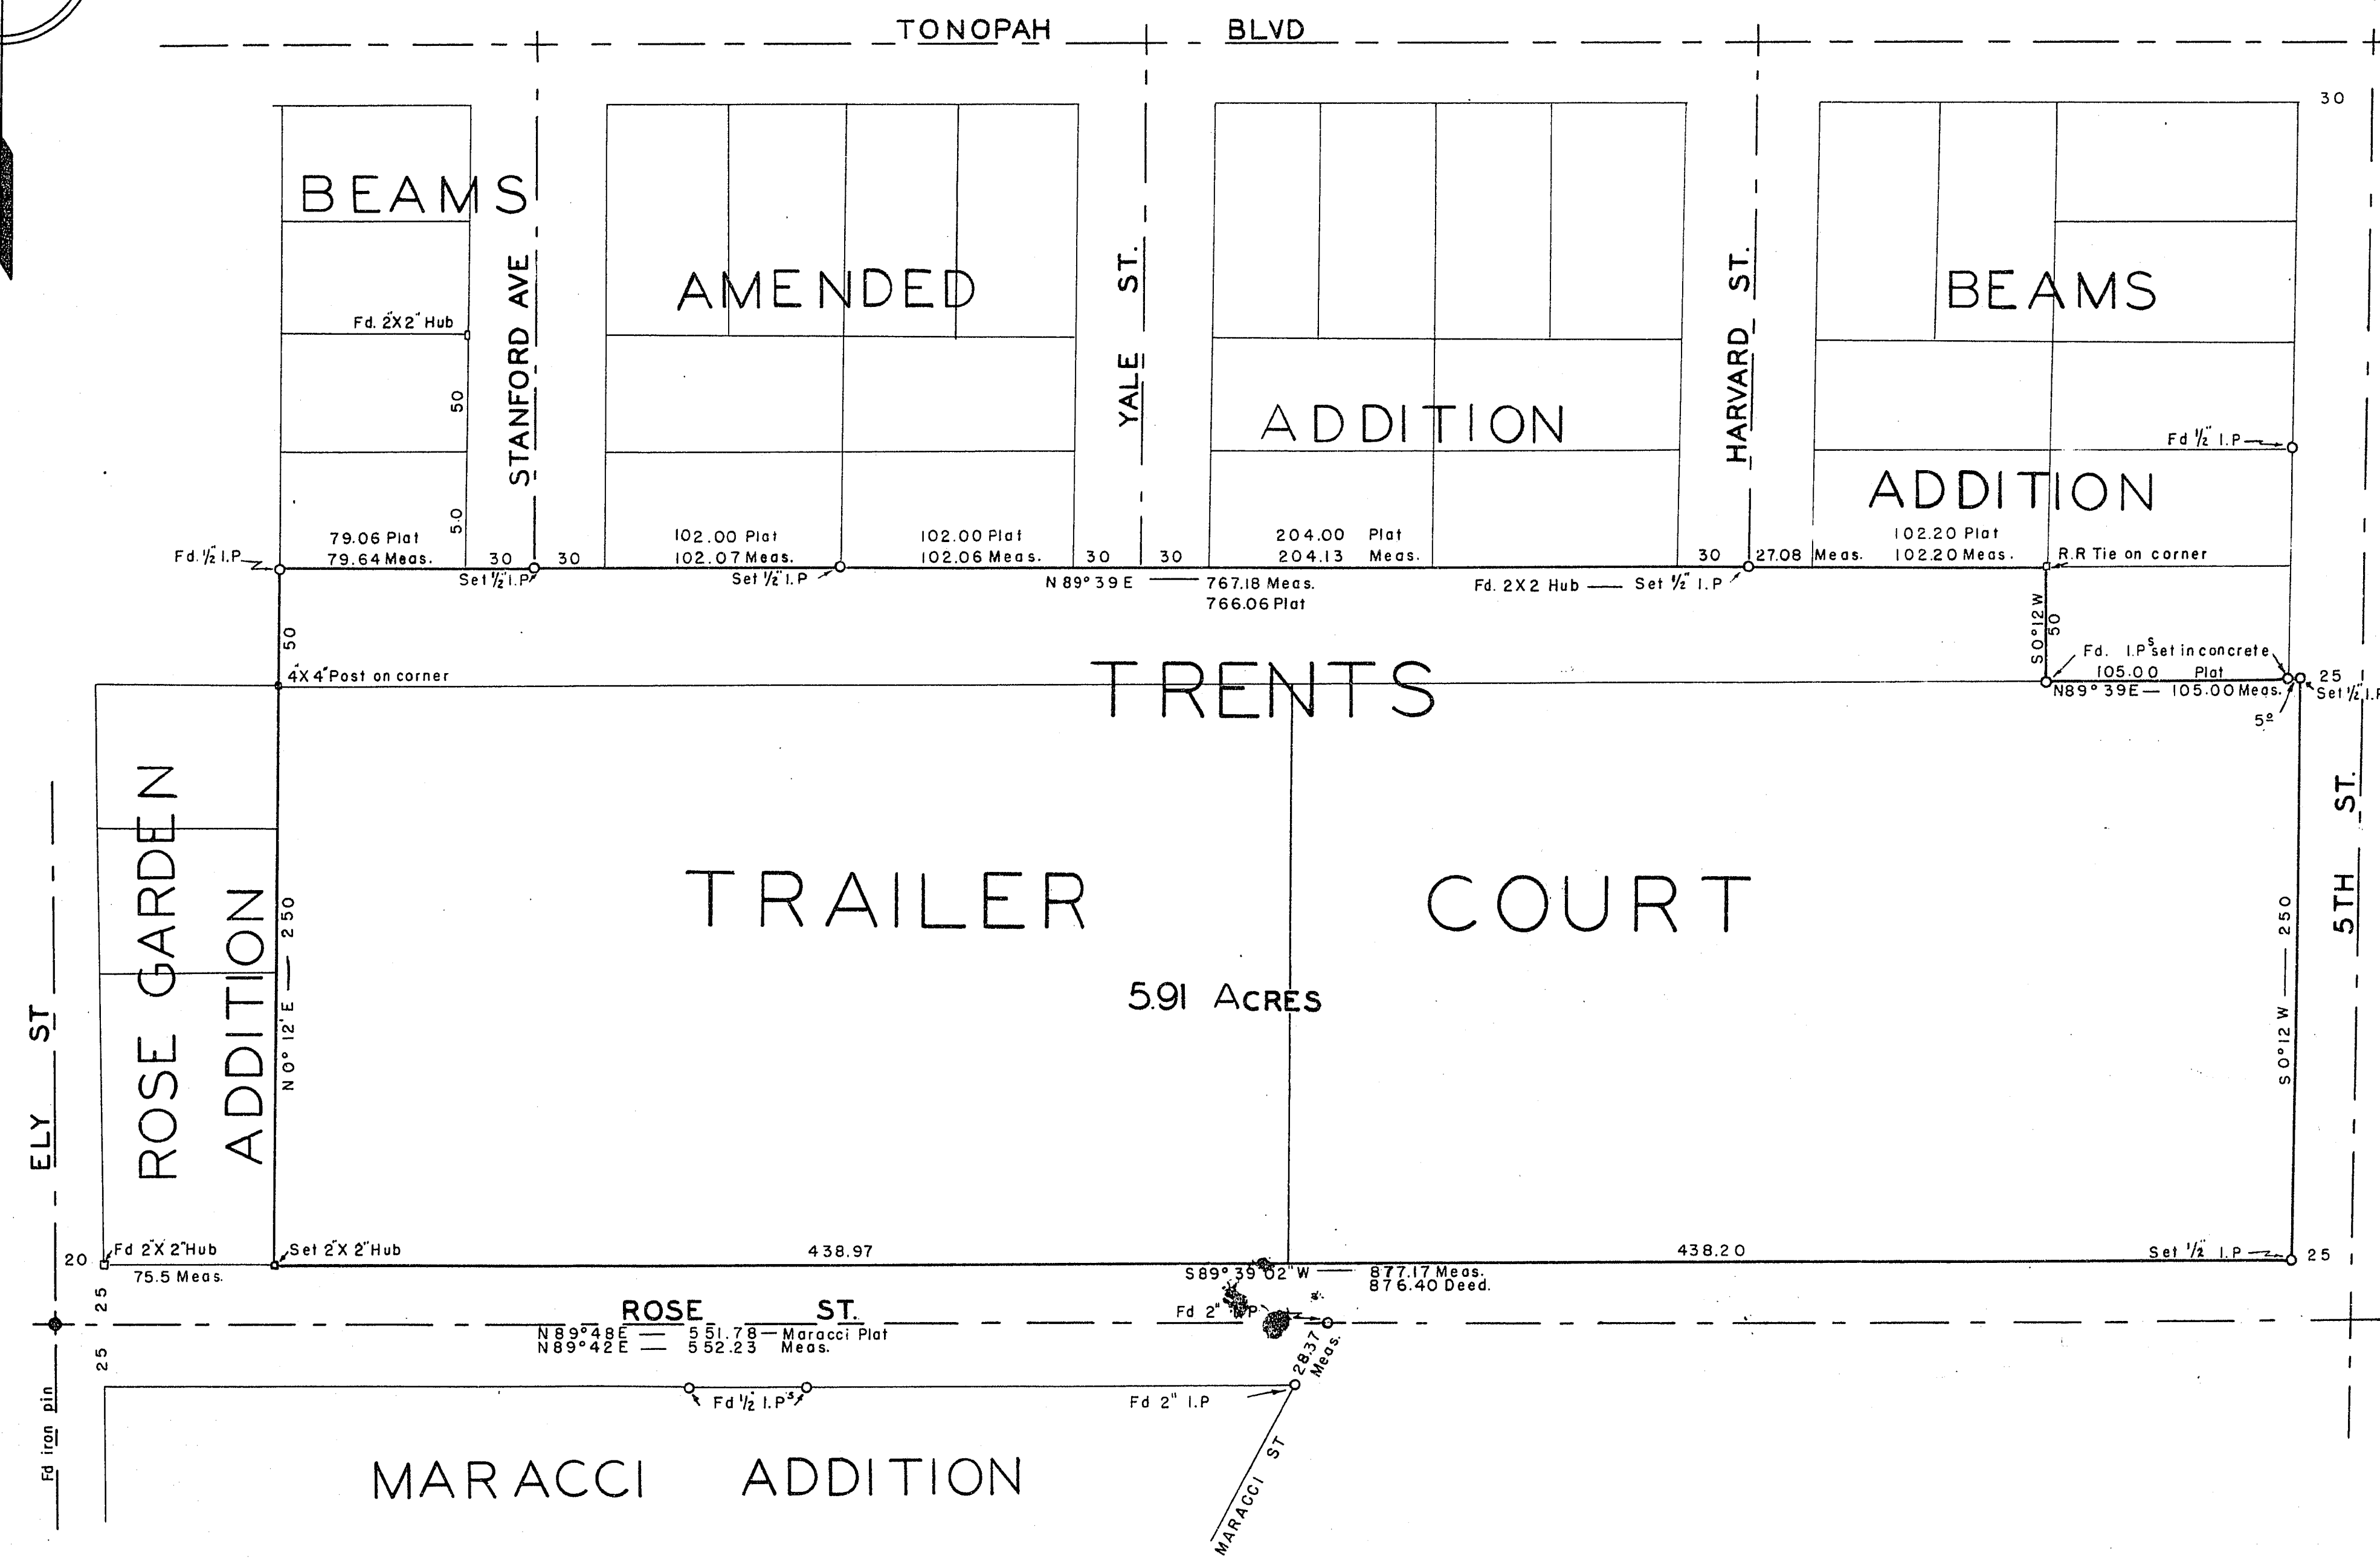

1-2-5-17

354976

Filed at Request of

William Trent

Date 10-10-47

In the presence of

Reg. Prof. King Burroughs

County Clerk, Nevada, Records

Filed for record

100