


PLAN	SURVISED	DATE
	NOTE BOOK	BY
PROFILE	SURVISED	DATE
	NOTE BOOK	BY

PROFILE	SURVISED	DATE
	NOTE BOOK	BY
PLAN	SURVISED	DATE
	NOTE BOOK	BY


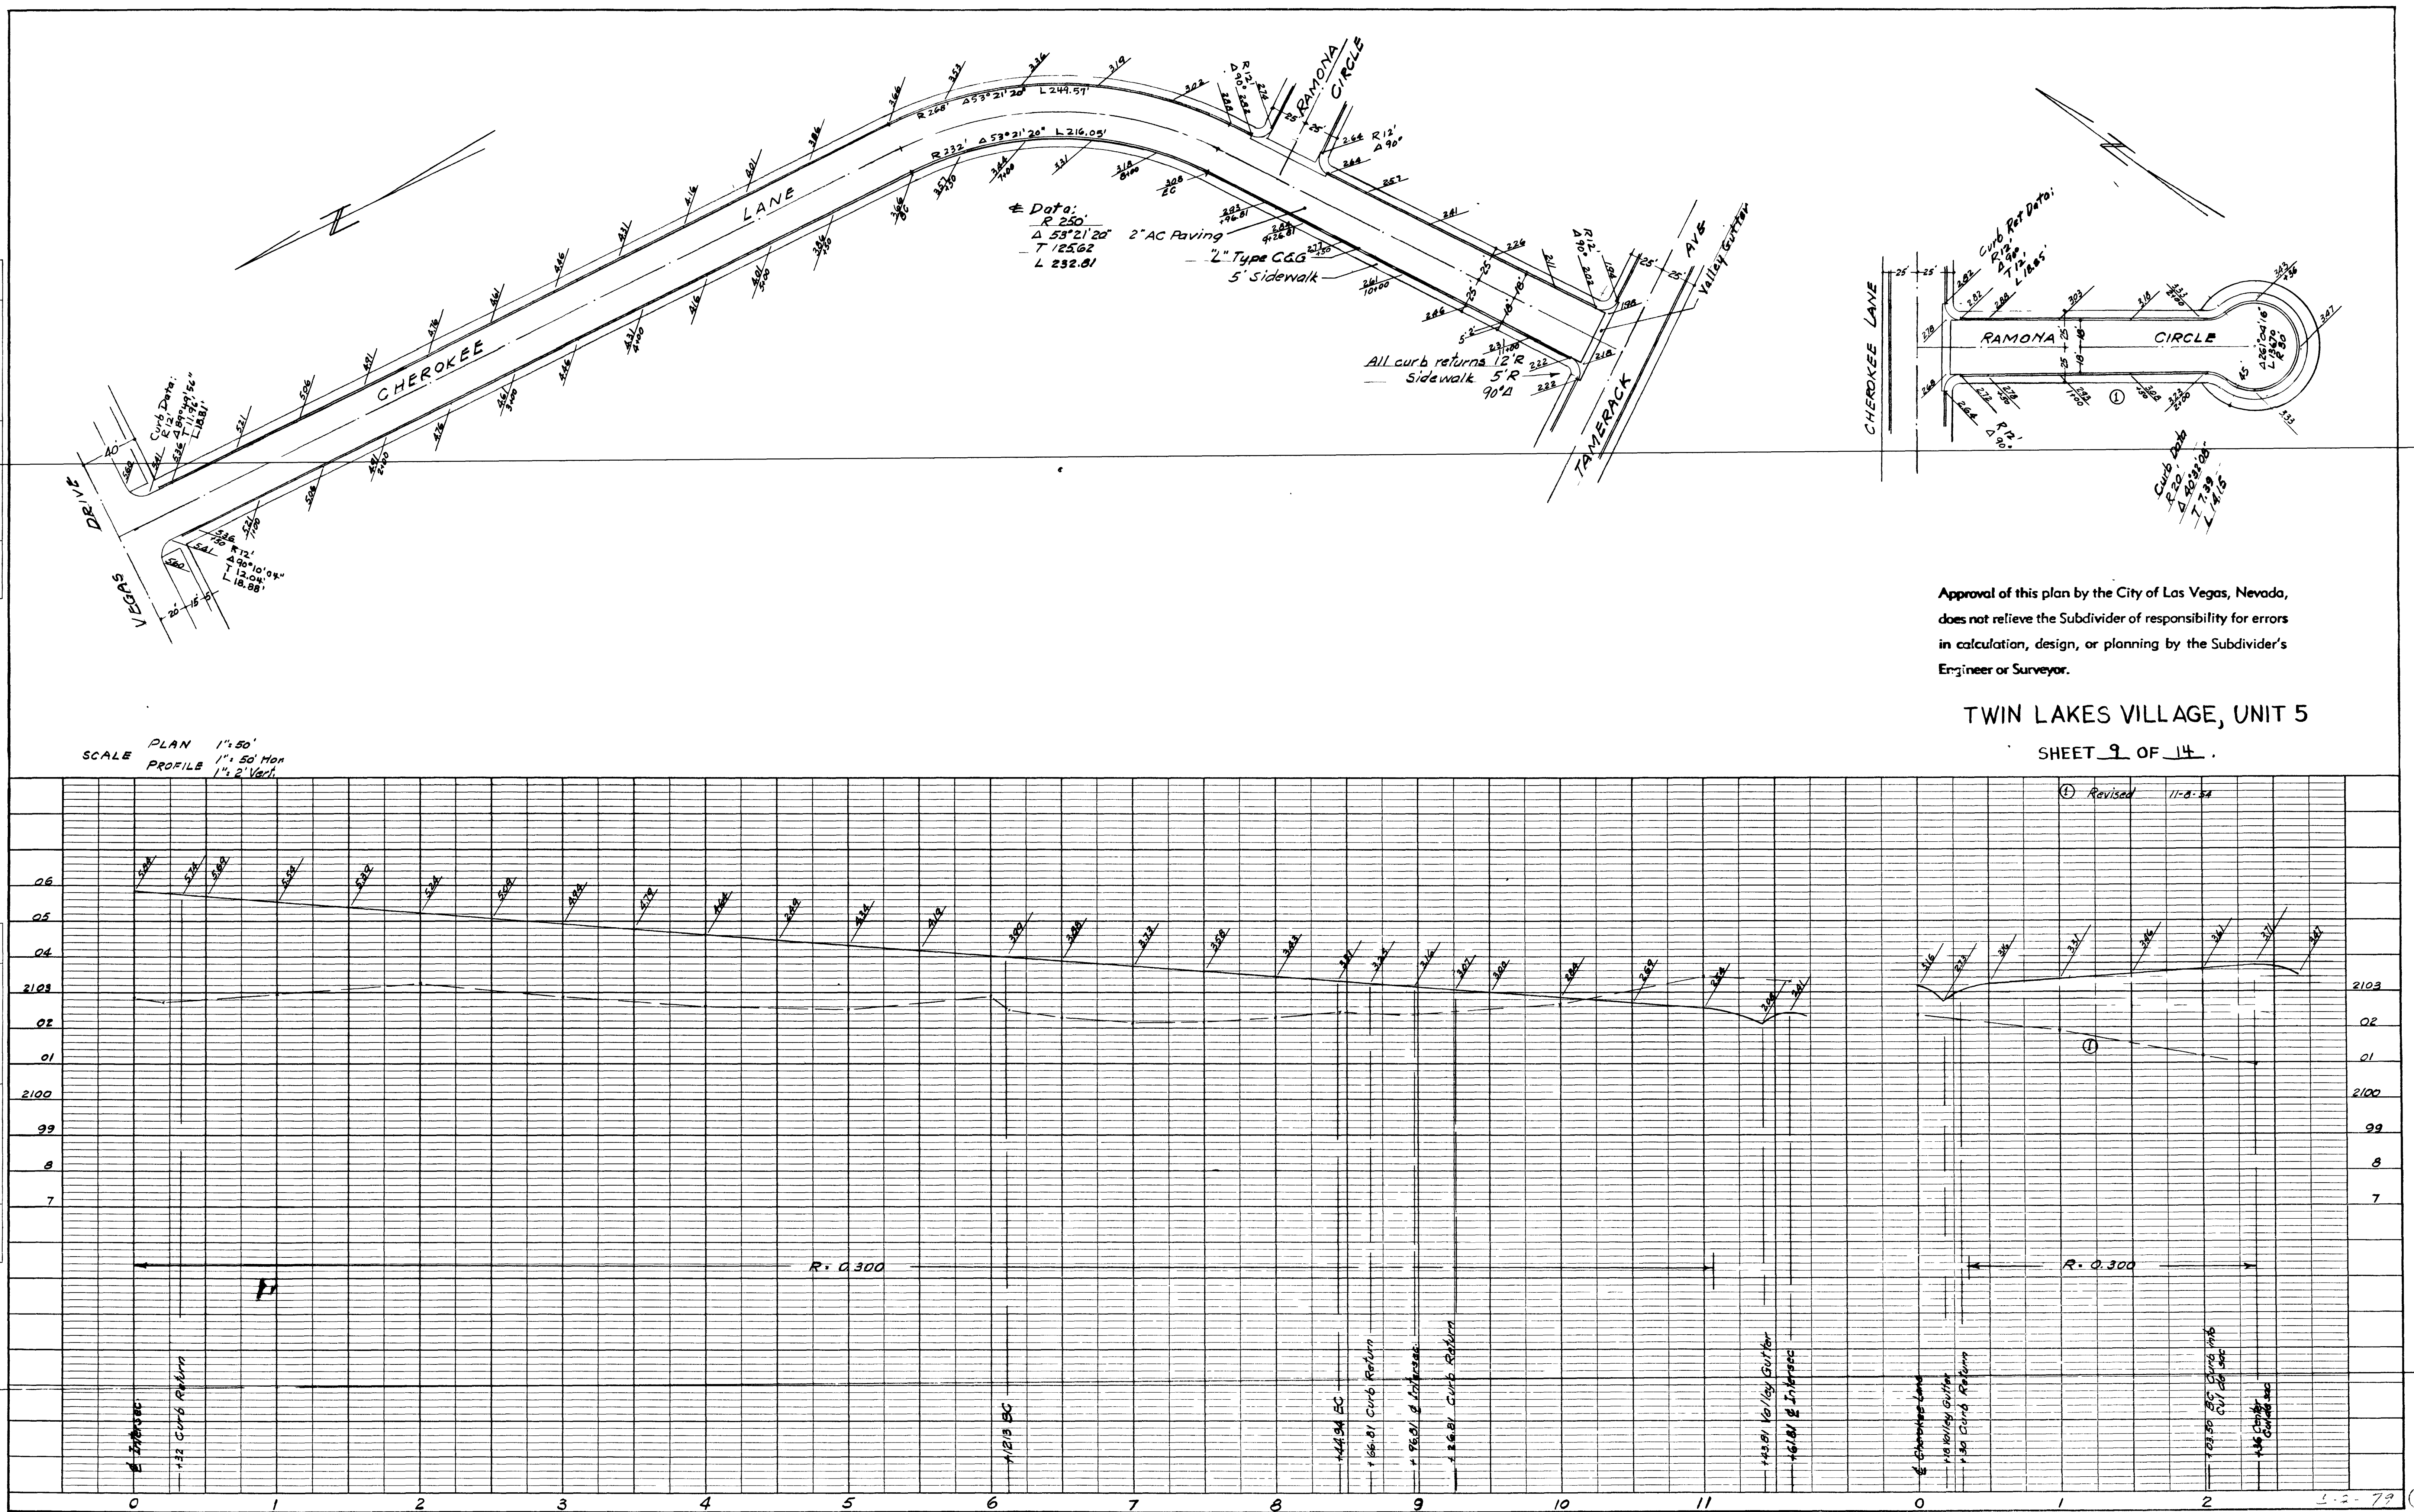


Approval of this plan by the City of Las Vegas, Nevada,
 does not relieve the Subdivider of responsibility for errors
 in calculation, design, or planning by the Subdivider's
 Engineer or Surveyor.

TWIN LAKES VILLAGE, UNIT 5
 SHEET 9 OF 14.

PLATE 1 PLAN PROFILE OF P&R E STANDARD
 KUTZEL & ESSER CO. NEW YORK


MADE IN U.S.A. 347-1 ON ALBANYE NO. 1081 TRACING PAPER
 200 1/2 X 21 1/2 IN.

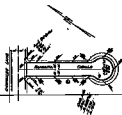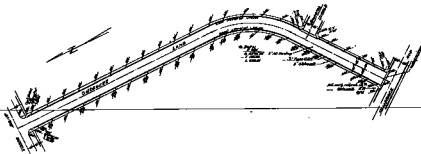




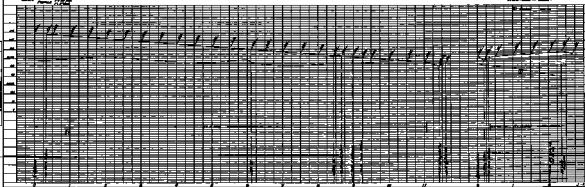



