


LINE TABLE		
LINE	LENGTH	BEARING
L1	124.03	S89°47'28"E
L2	158.19	S89°47'28"E
L3	128.55	S89°38'09"E
L4	34.16	S89°47'28"E
L5	5.00	S89°38'09"E
L6	2.58	S00°21'51"W
L7	27.61	S89°47'28"E
L8	20.74	S89°47'28"E
L9	92.34	S89°44'06"E
L10	26.49	N00°15'54"E
L11	4.00	S00°15'54"W
L12	16.50	S00°08'04"W
L13	0.50	N89°44'06"W
L14	57.00	S89°47'28"E
L15	47.00	S89°47'28"E
L16	4.00	N00°15'54"E
L17	4.00	N00°15'54"E
L18	17.17	S89°44'06"E
L19	7.77	S89°47'28"E
L20	22.41	S00°15'54"W
L21	23.33	S89°44'06"E
L22	64.00	N00°15'54"E
L23	7.00	N89°51'18"W
L24	7.00	N89°51'18"W
L25	8.00	S00°08'42"W
L26	6.38	S89°51'18"E
L27	6.41	S89°51'18"E
L28	8.54	N89°51'18"W
L29	8.22	N89°51'18"W
L30	91.41	N00°08'42"E
L31	91.41	S00°08'42"W
L32	77.43	S89°47'28"E
L33	74.43	S89°47'28"E

CURVE TABLE			
CURVE	LENGTH	RADIUS	TANGENT
C1	31.54	20.00	20.12
C2	39.42	25.00	25.15
C3	7.61	5.00	4.76
C4	15.74	10.00	10.03
C5	15.71	10.00	10.00
C6	23.54	15.00	14.98
C7	15.69	10.00	9.99
C8	7.85	5.00	5.00
C9	7.86	5.00	5.00
C10	7.86	5.00	5.01
C11	7.85	5.00	5.00
C12	7.85	5.00	5.00

LEGEND

DESC.	EXISTING
R/W PROPERTY LINE	---
CENTERLINE	---
CONTOURS	--- 10 ---
CONCRETE CURB	=====
FINISH FLOOR ELEV.	EXIST. FFE = 22.10
PAD ELEVATION	(21.5)
FINISH GRADE ELEVATION	(42.81)
PAVEMENT SLOPE	N/A
GRADE BREAK	N/A
WALL	=====
LUMINAIRE	⊙
UTILITY LINE (AS NOTED)	--- G ---
WATER LINE	--- W ---
SEWER LINE	--- S ---
SEWER MANHOLE	⊙
FIRE HYDRANT	⊙
VALVE	⊙
WATER METER	⊙
PIV	⊙
FDC	⊙
RPPA	RPPA
DCDA	DCDA
REMOVE ASPHALT	=====

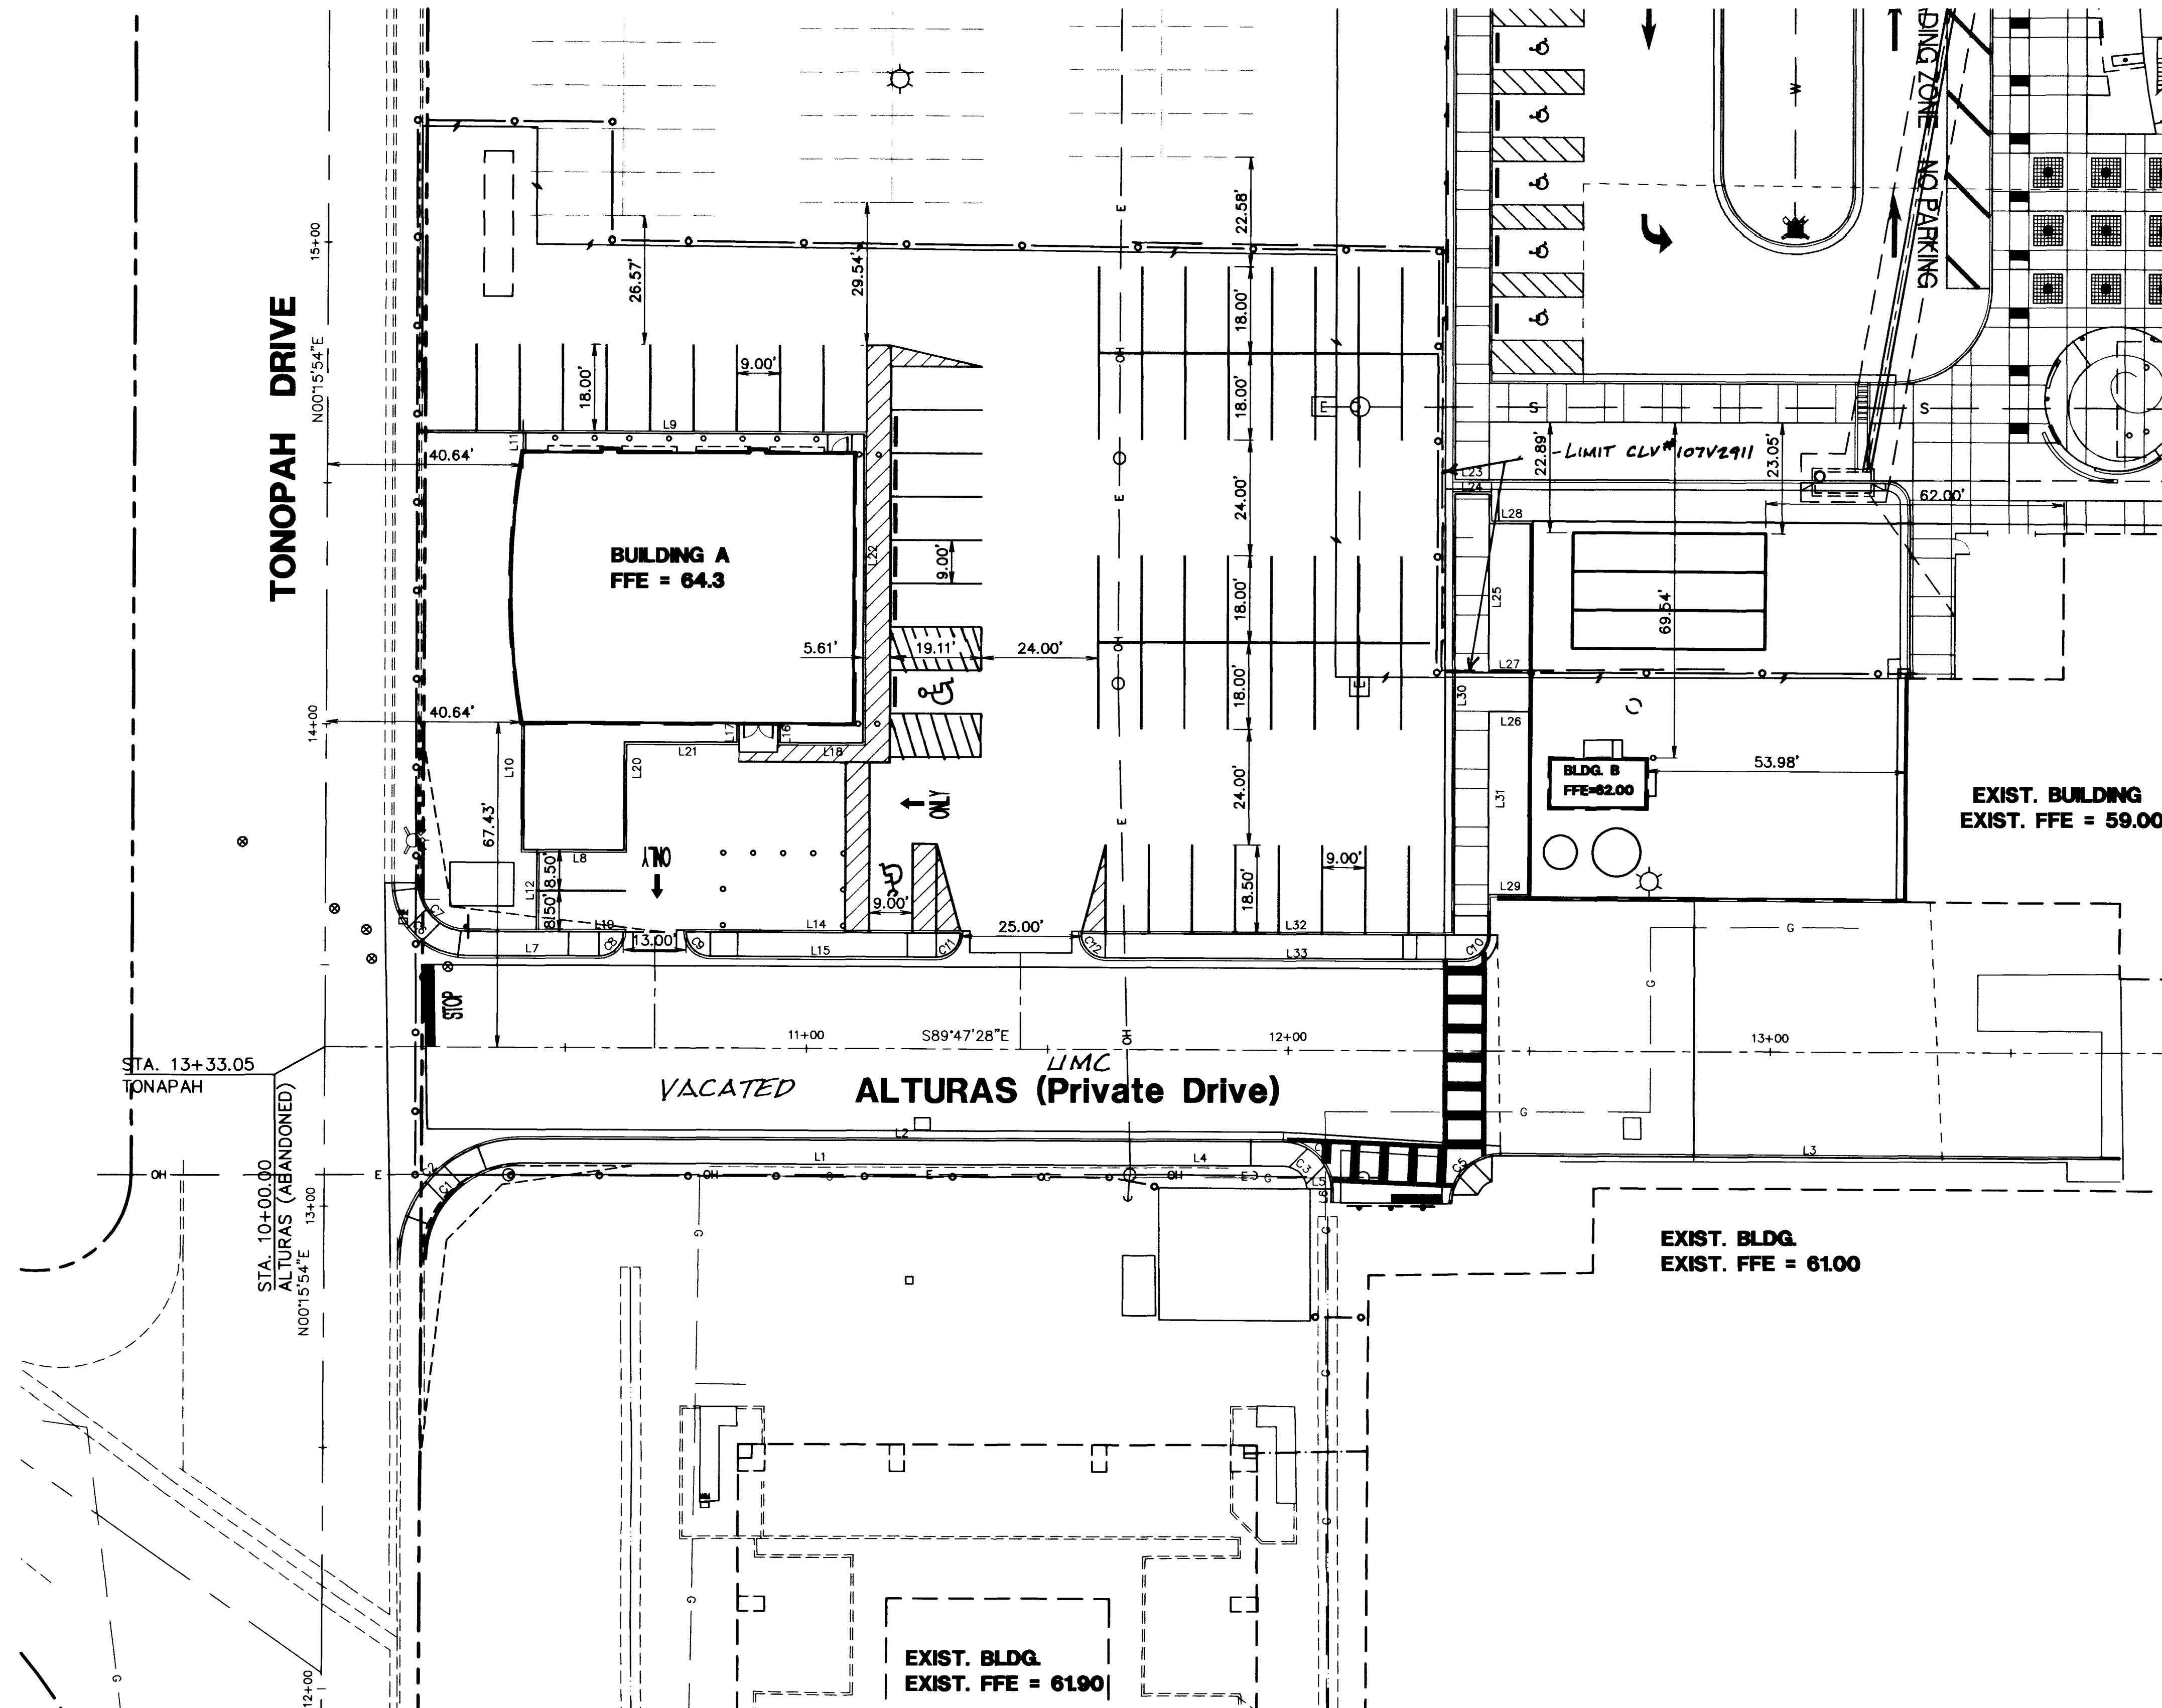

SAFETY ALERT

Call before you Overhead

593-6111

OVERHEAD SERVICE ALERT

Avoid cutting underground utility lines. It's costly.

Call before you Dig.

1-800-227-2600

UNDERGROUND SERVICE ALERT

ARCH: HOLMES SABATINI ASSOCIATES

1 COMMERCE CENTER DRIVE
HENDERSON, NV. 89014

PROJECT: UMC SITE FACILITIES
UNIVERSITY MEDICAL CENTER

SHEET TITLE: HORIZONTAL CONTROL PLAN

Drawn by: AUS 10/9/98

Designed by: TDA

Checked by: THL

Project No.: 495096A001

Scale: 1" = 20' (H)
1" = 2' (V)

REVISION

REV	DATE	BY

Engineering • Landscape Architecture
Planning • Urban Design • Surveying
2551 N. Green Valley Pkwy., Suite A425
HENDERSON, NV. 89014 (702) 436-1008

The WLB Group

PROFESSIONAL ENGINEER STATE OF NV
No. 5476
TED H. LYON
CIVIL
4/18/99

SHEET C5
5 OF 9 SHEETS

DRAWING NO. 107-V3071

