
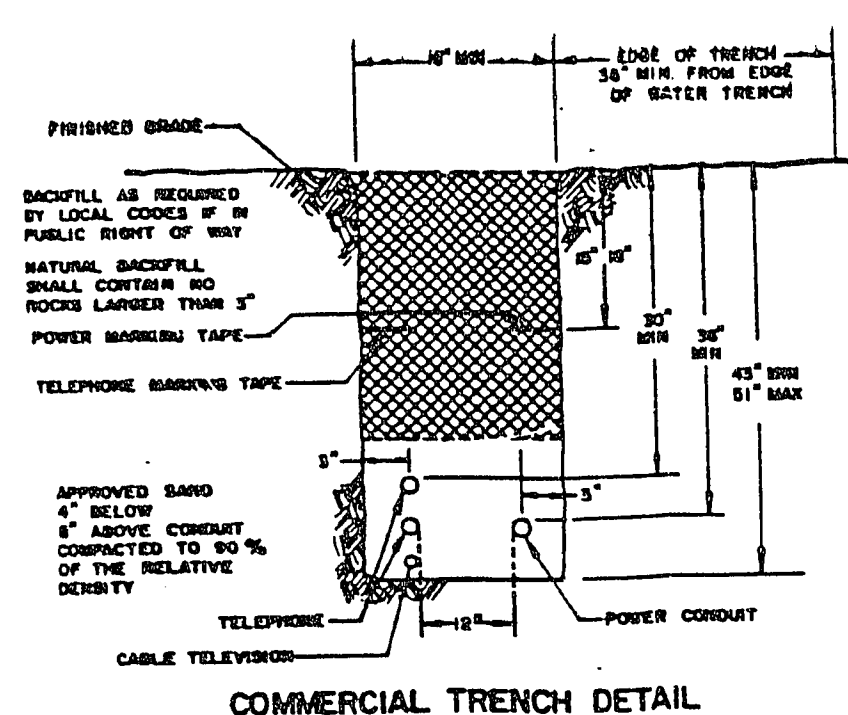


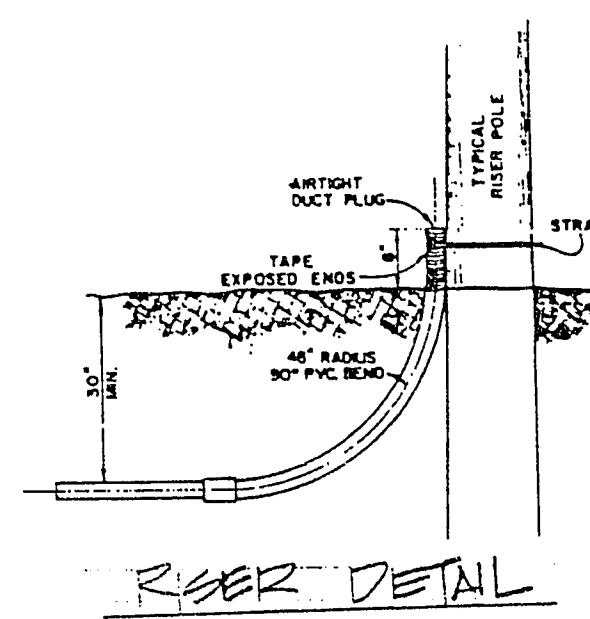

LEGEND

CONCRETE FIVE = DB GRADE.

☐ FILL BOX: 3' x 5' x 4" WITH H₂O LEAVING BUT
DOWN TRAPPING WAREDS BACKED INTO TIE RODS AND
FIVE DB BOLT CABLE BACKED (2 EACH SIDE)

☒ FILL BOX: 8' x 4' x 3" WITH H₂O LEAVING BUT
DOWN TRAPPING WAREDS BACKED

☐ FILL BOX: 17' x 34' x 24" WITH H₂O LEAVING BUT
DOWN TRAPPING WAREDS BACKED

☒ TERMINAL CONCRETE 24' x 24' x 4" - BRIGHT
SILVER COVER TYPE WITH 4" x 4" FILL BOX
BACKWARD (SEE DETAIL "A")

☒ 3/4" x 1/2" x 1/2" BACKLASH = SIZE 20 IMPROVED
TREATED WITH FIRE RETARDANT PAINT OR SEALER

||-|| 3/8" x 3/4" GROUND WIRE TO THE PEN (MULTI-GROUNDED NEUTRAL)

ENGINEER APPROVAL James S. Nolan DATE 7-27-88
James S. Nolan CLV 5/16/89

CALL BEFORE YOU DIG.

1-800-227-2600

REVISION #3 REVISOR: CONDUIT TO ASBEE WITH NPG. TANKH LAYOUT FC. 1-89

REVISION #2 - RELOCATED TERMINAL CABINETS ON BLDG 5: J, L, V REMOVE CABINET ON BLDG 6 PER CUSTOMER 12-80 FC.

REVISION #1 - ADDED TEMPORARY U.G. SERVICE FOR HOME CLUB 1/83 FC.

TITLE	UNDERGROUND CONDUIT	EX. #	212146A
REQUIREMENT	PHONE	EXT.	1222
LOC.	SHOPPING CENTER	DATE	1/27/88
	CHARLESTON GREENHAM	SCALE	1" = 60'
		SHT.	1 OF 1

1074-4024