

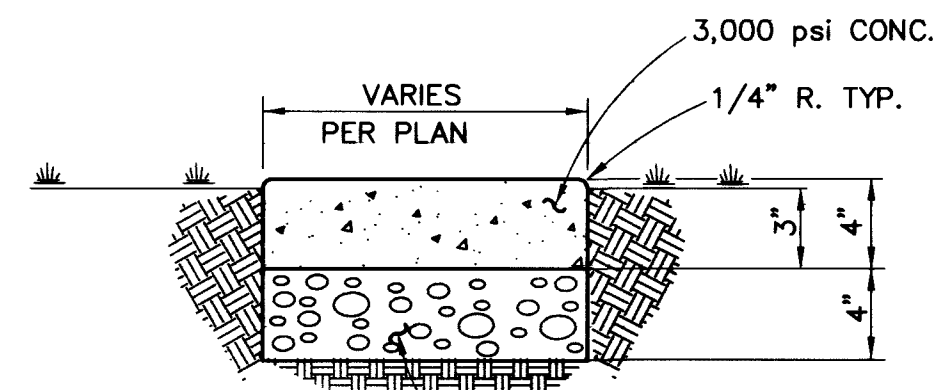


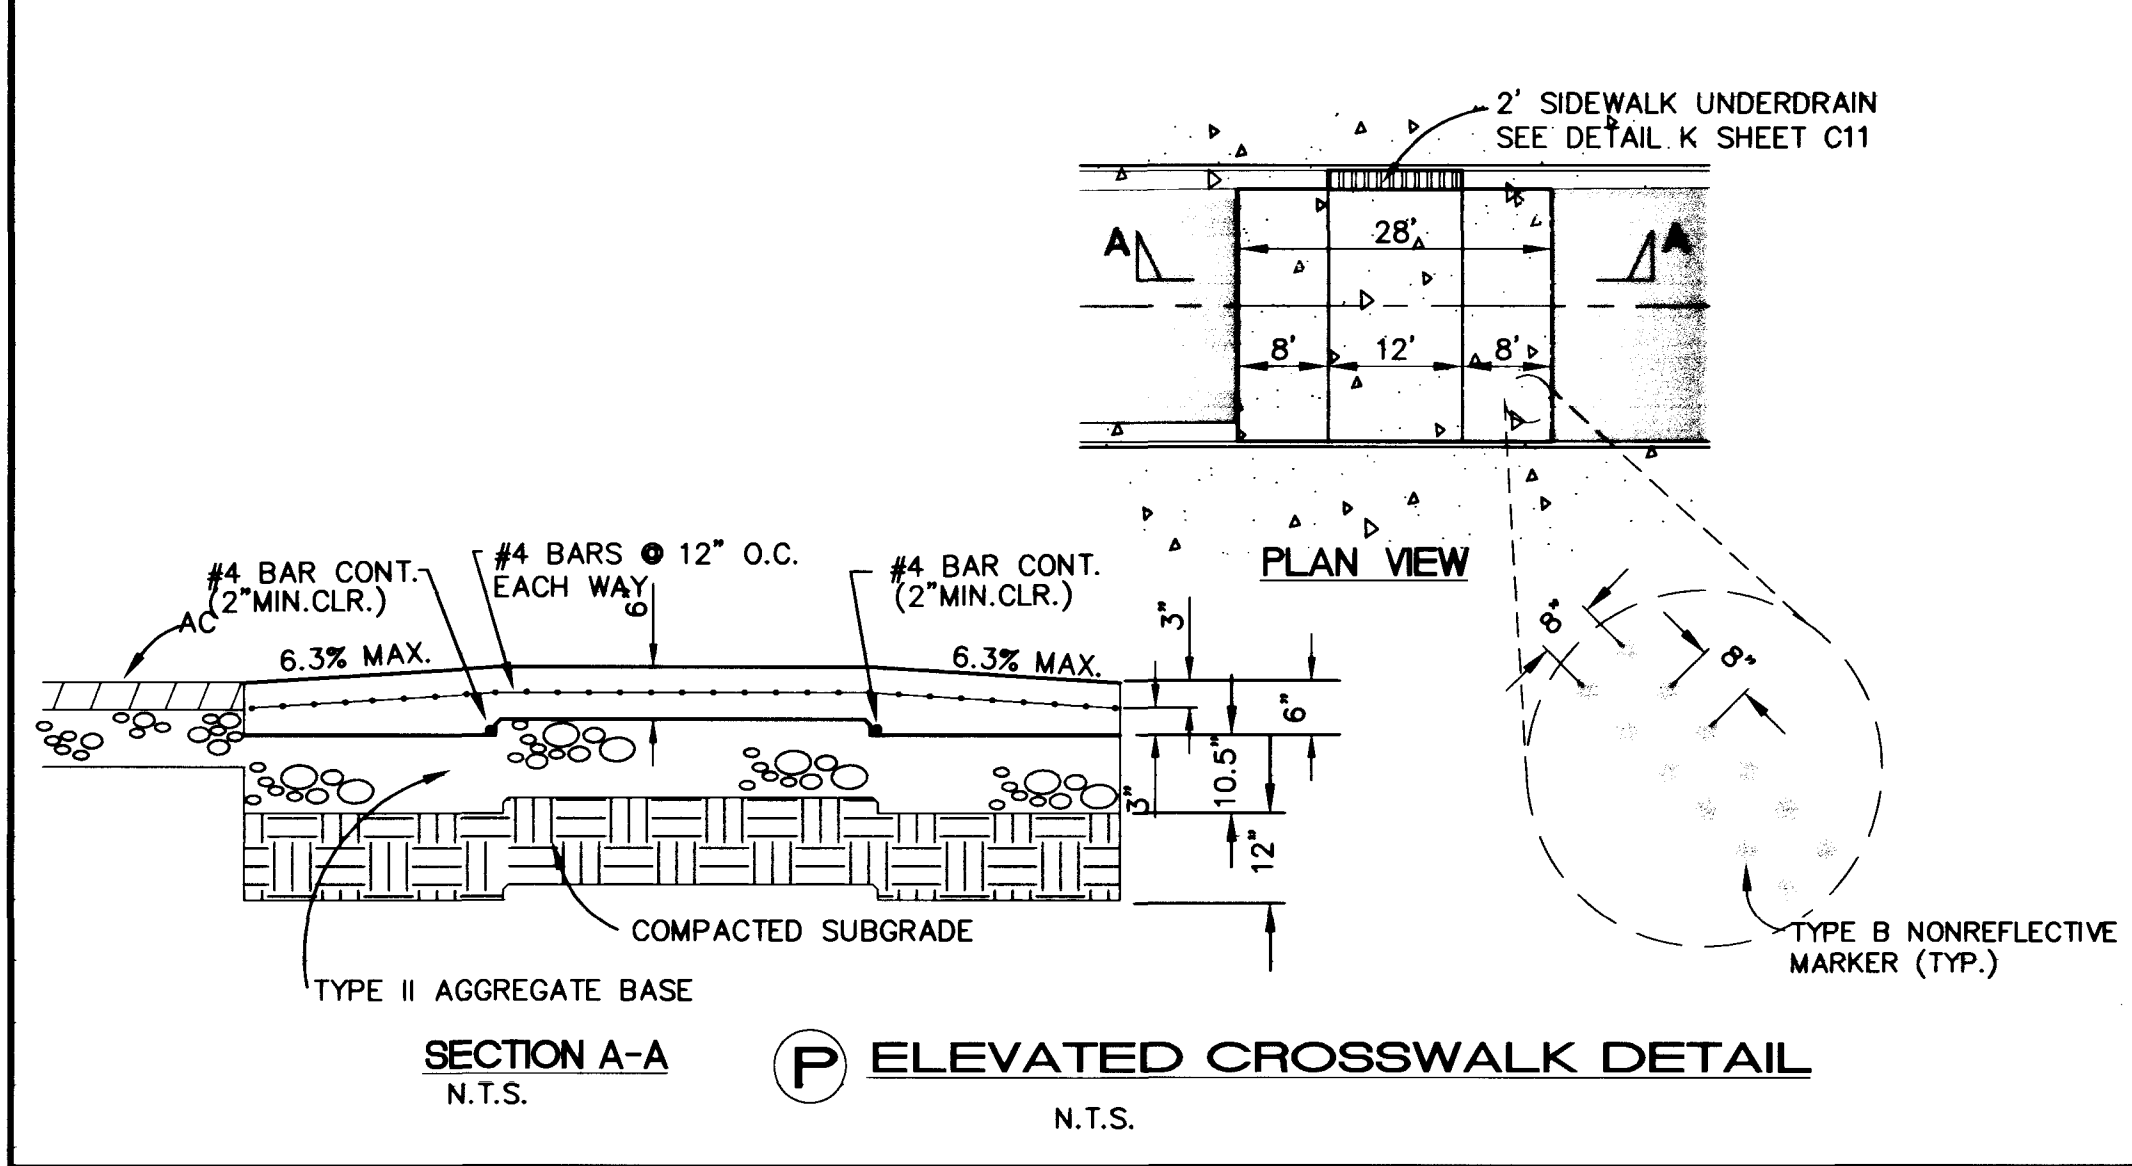


- NOTE:**
- INSTALL WEAKENED PLAN JOINTS @ 4' & 8' O.C. AS SHOWN ON PLANS
 - MEDIUM BROOM FINISH


CONCRETE SIDEWALK
N.T.S.

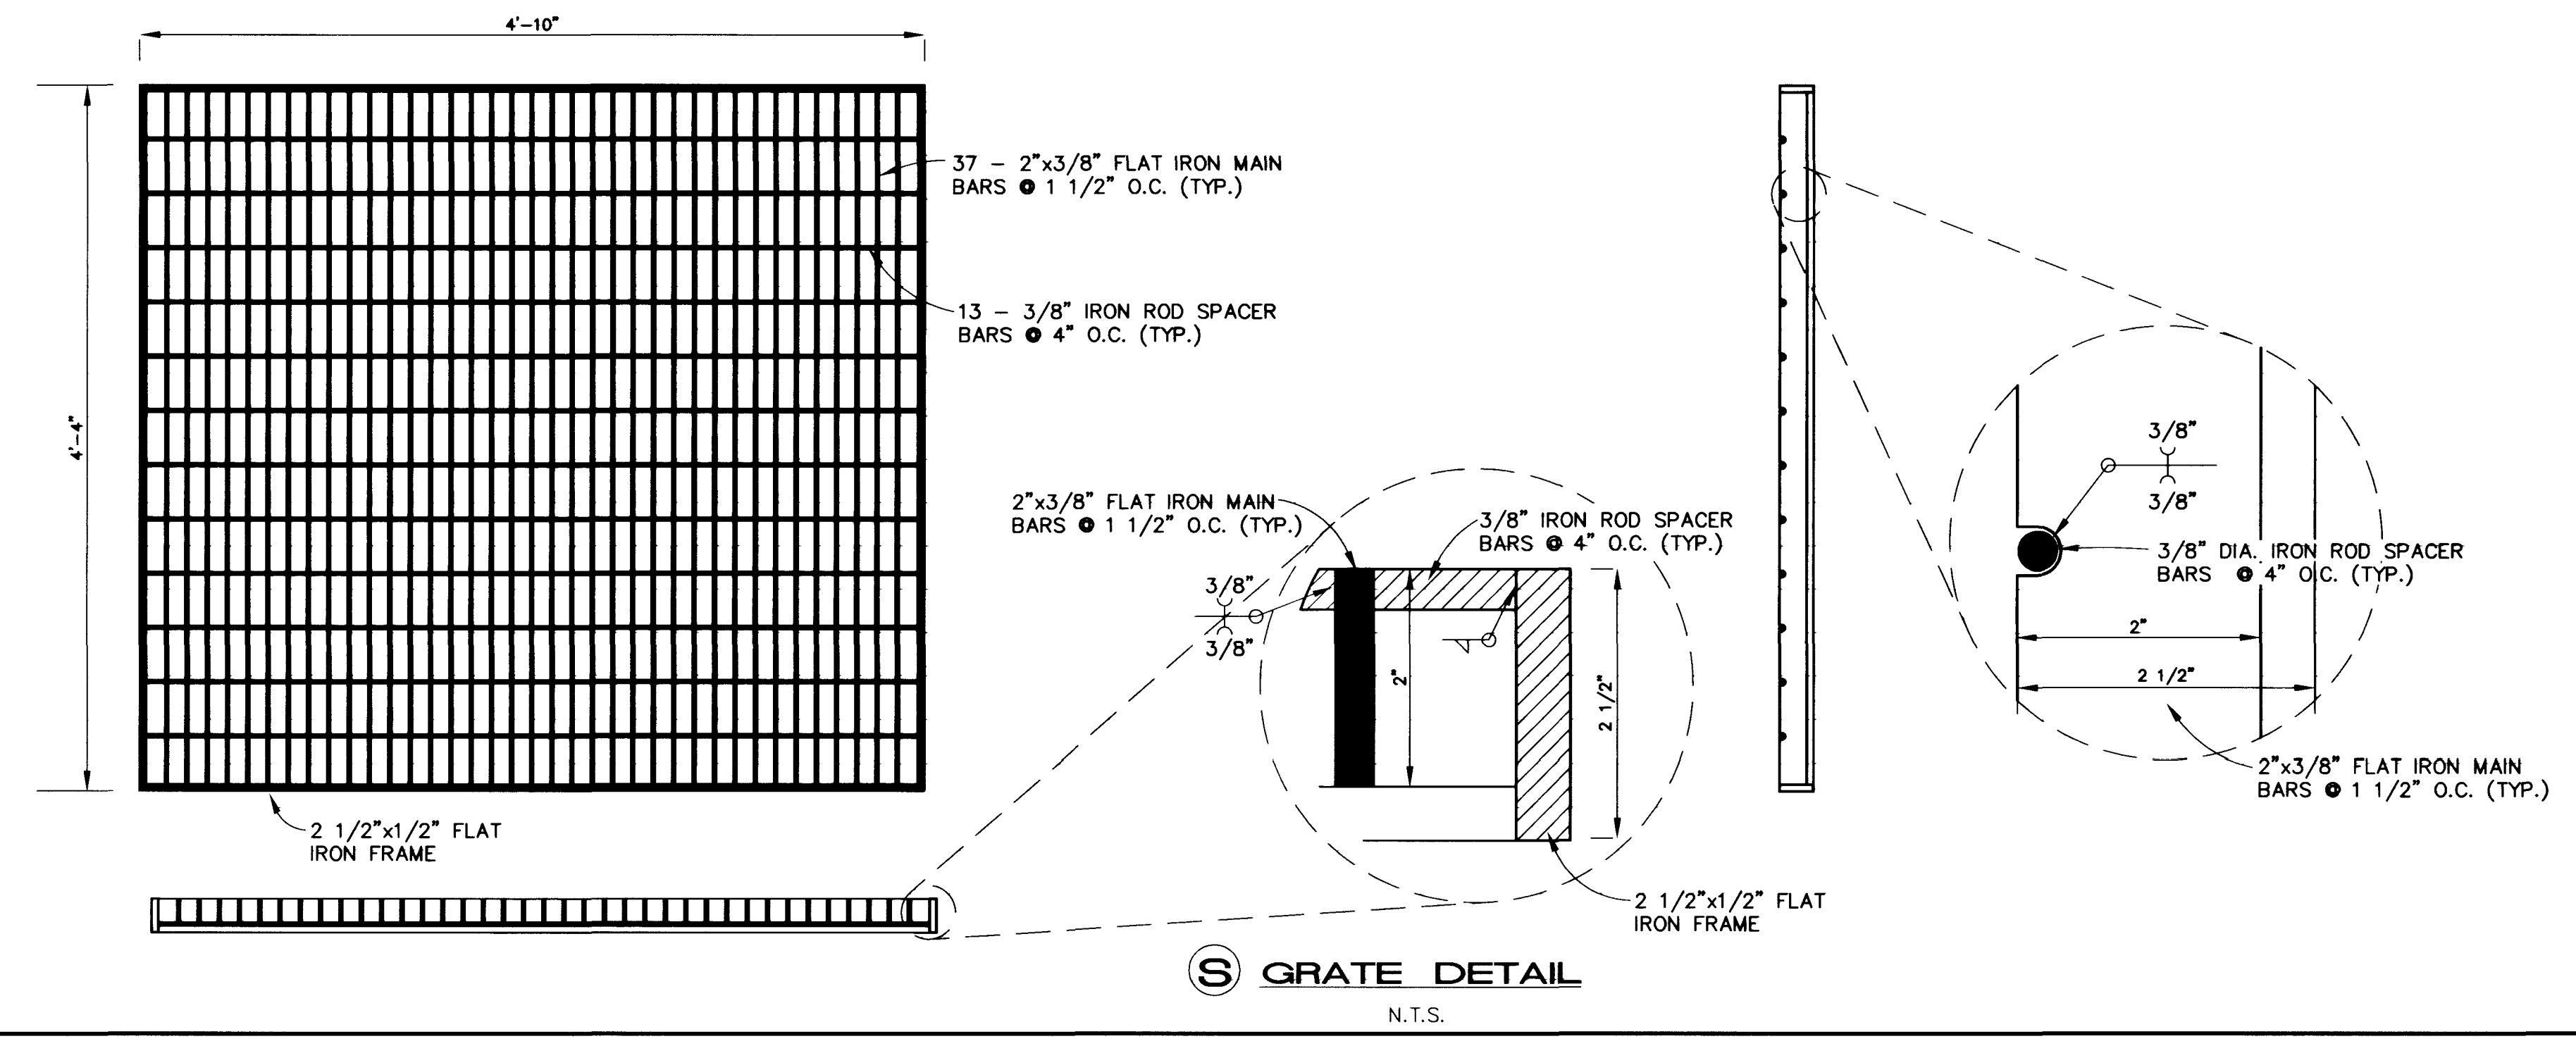

GRATE DETAIL
N.T.S.

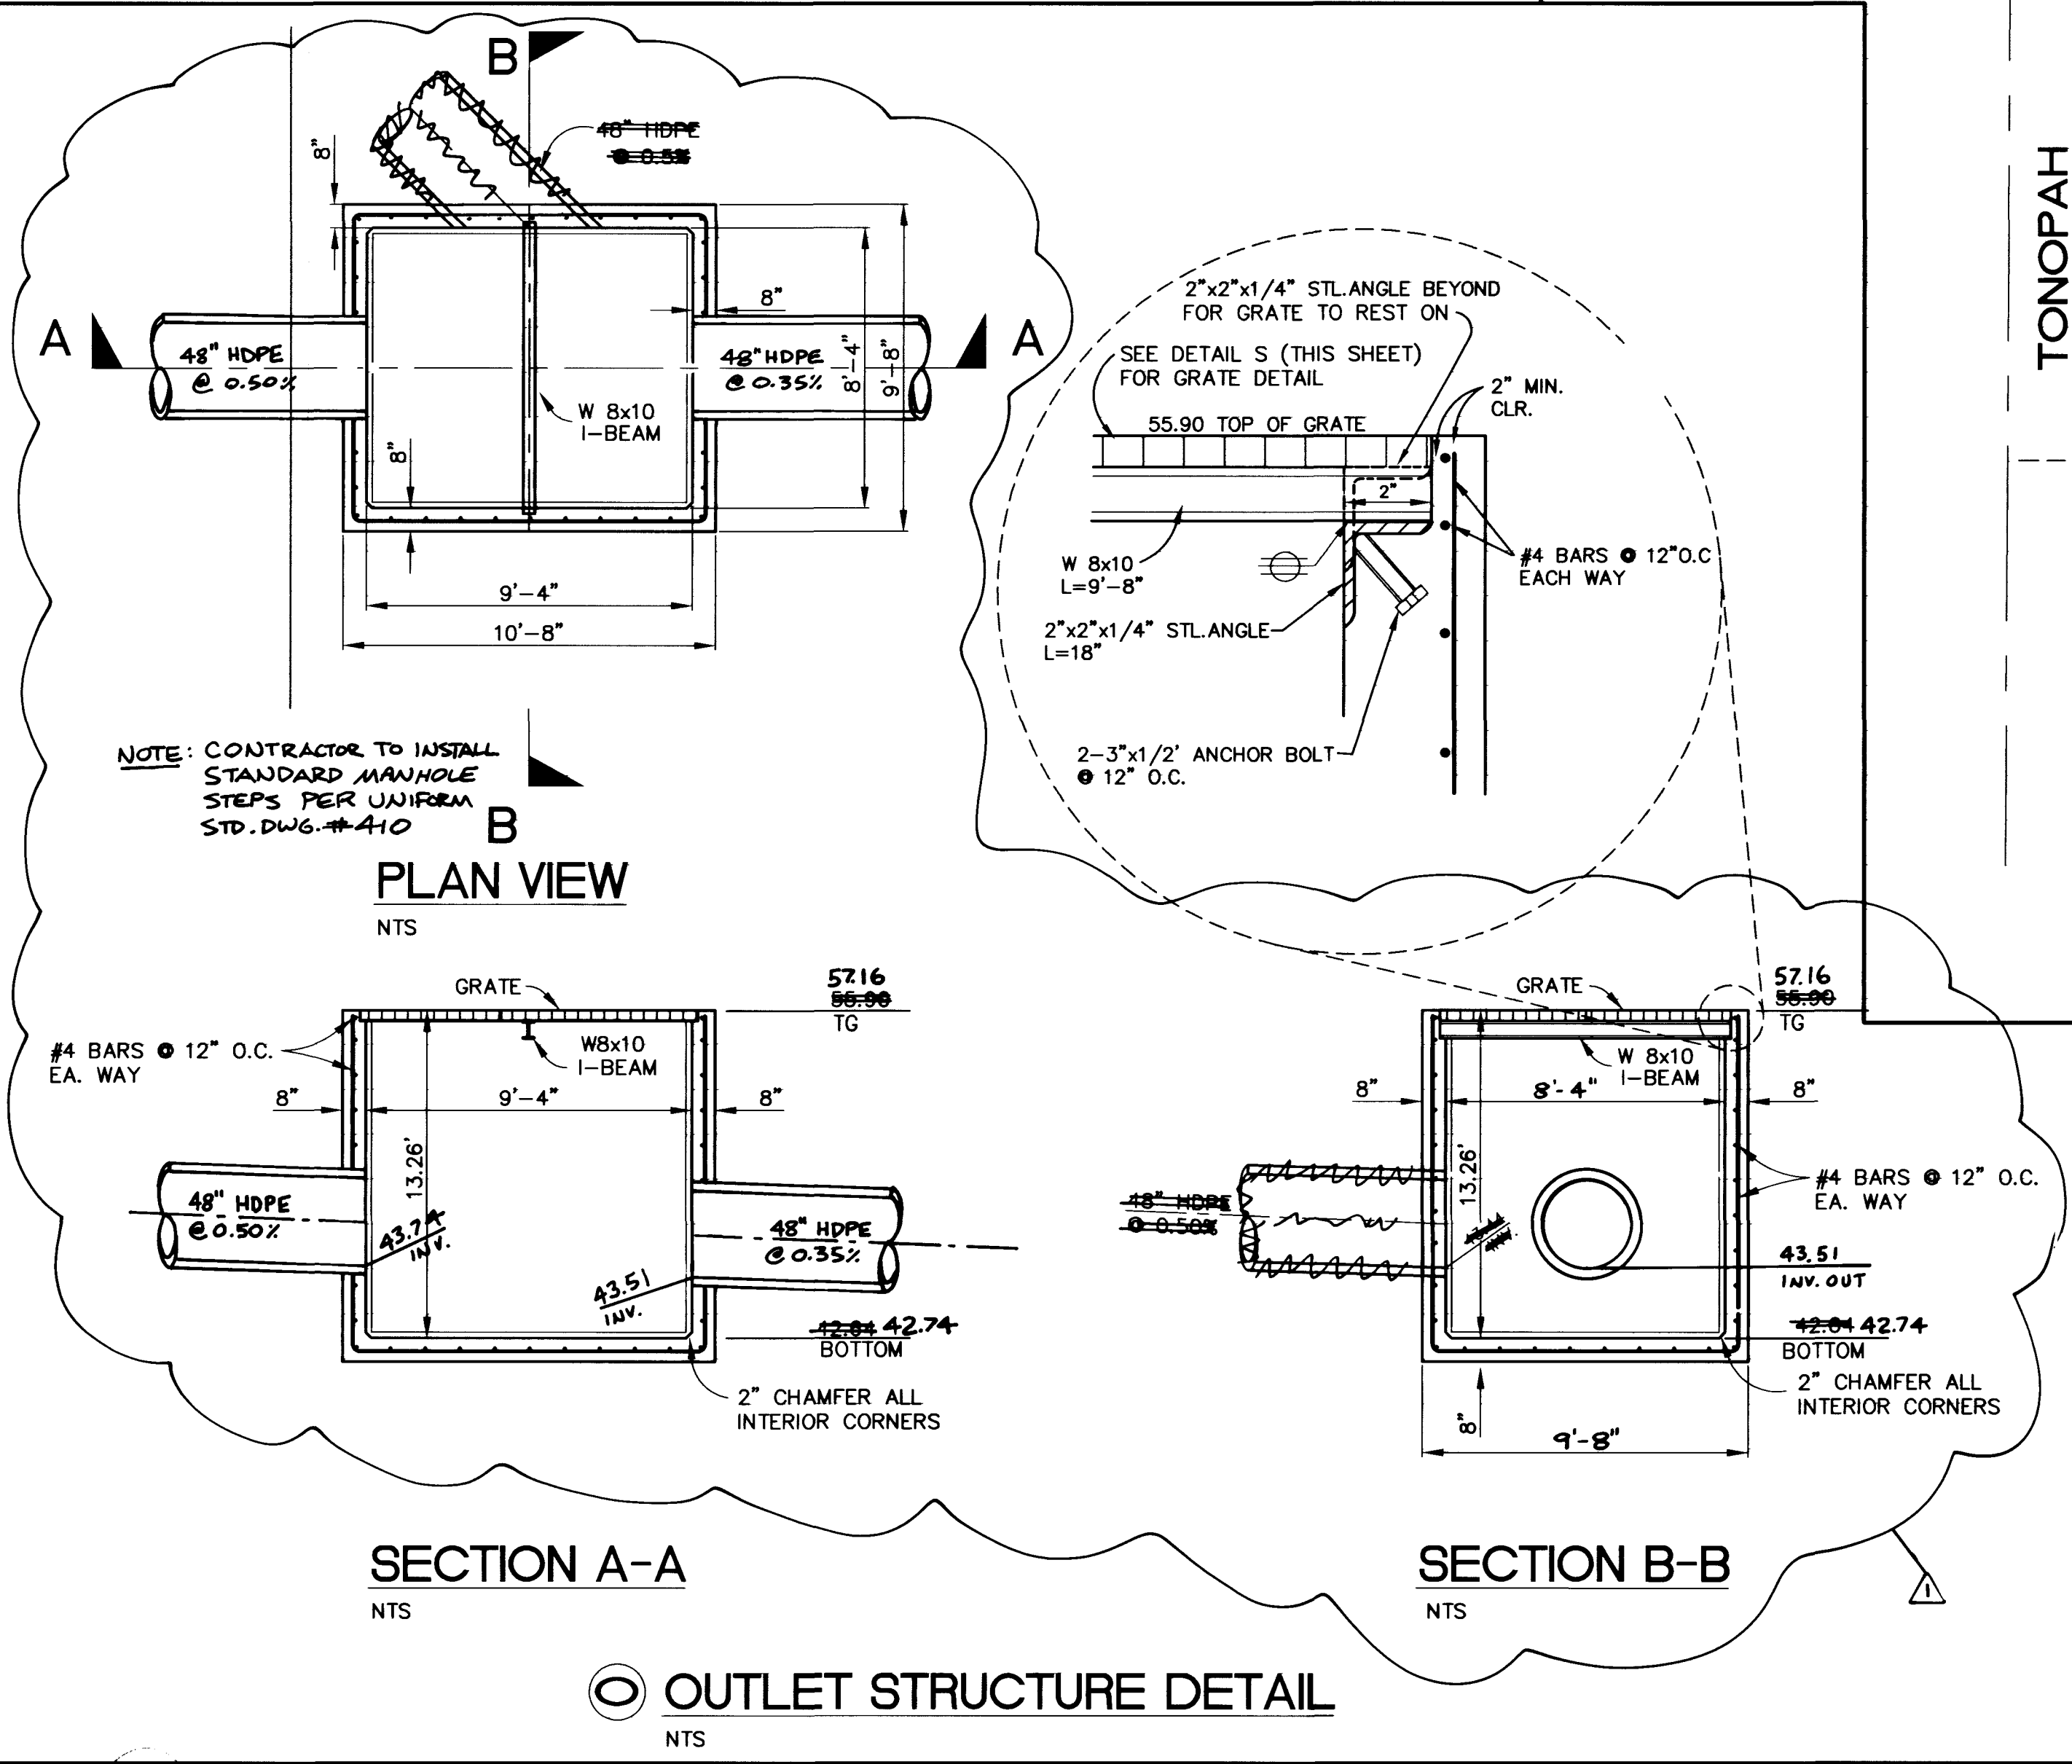

OUTLET STRUCTURE DETAIL
N.T.S.

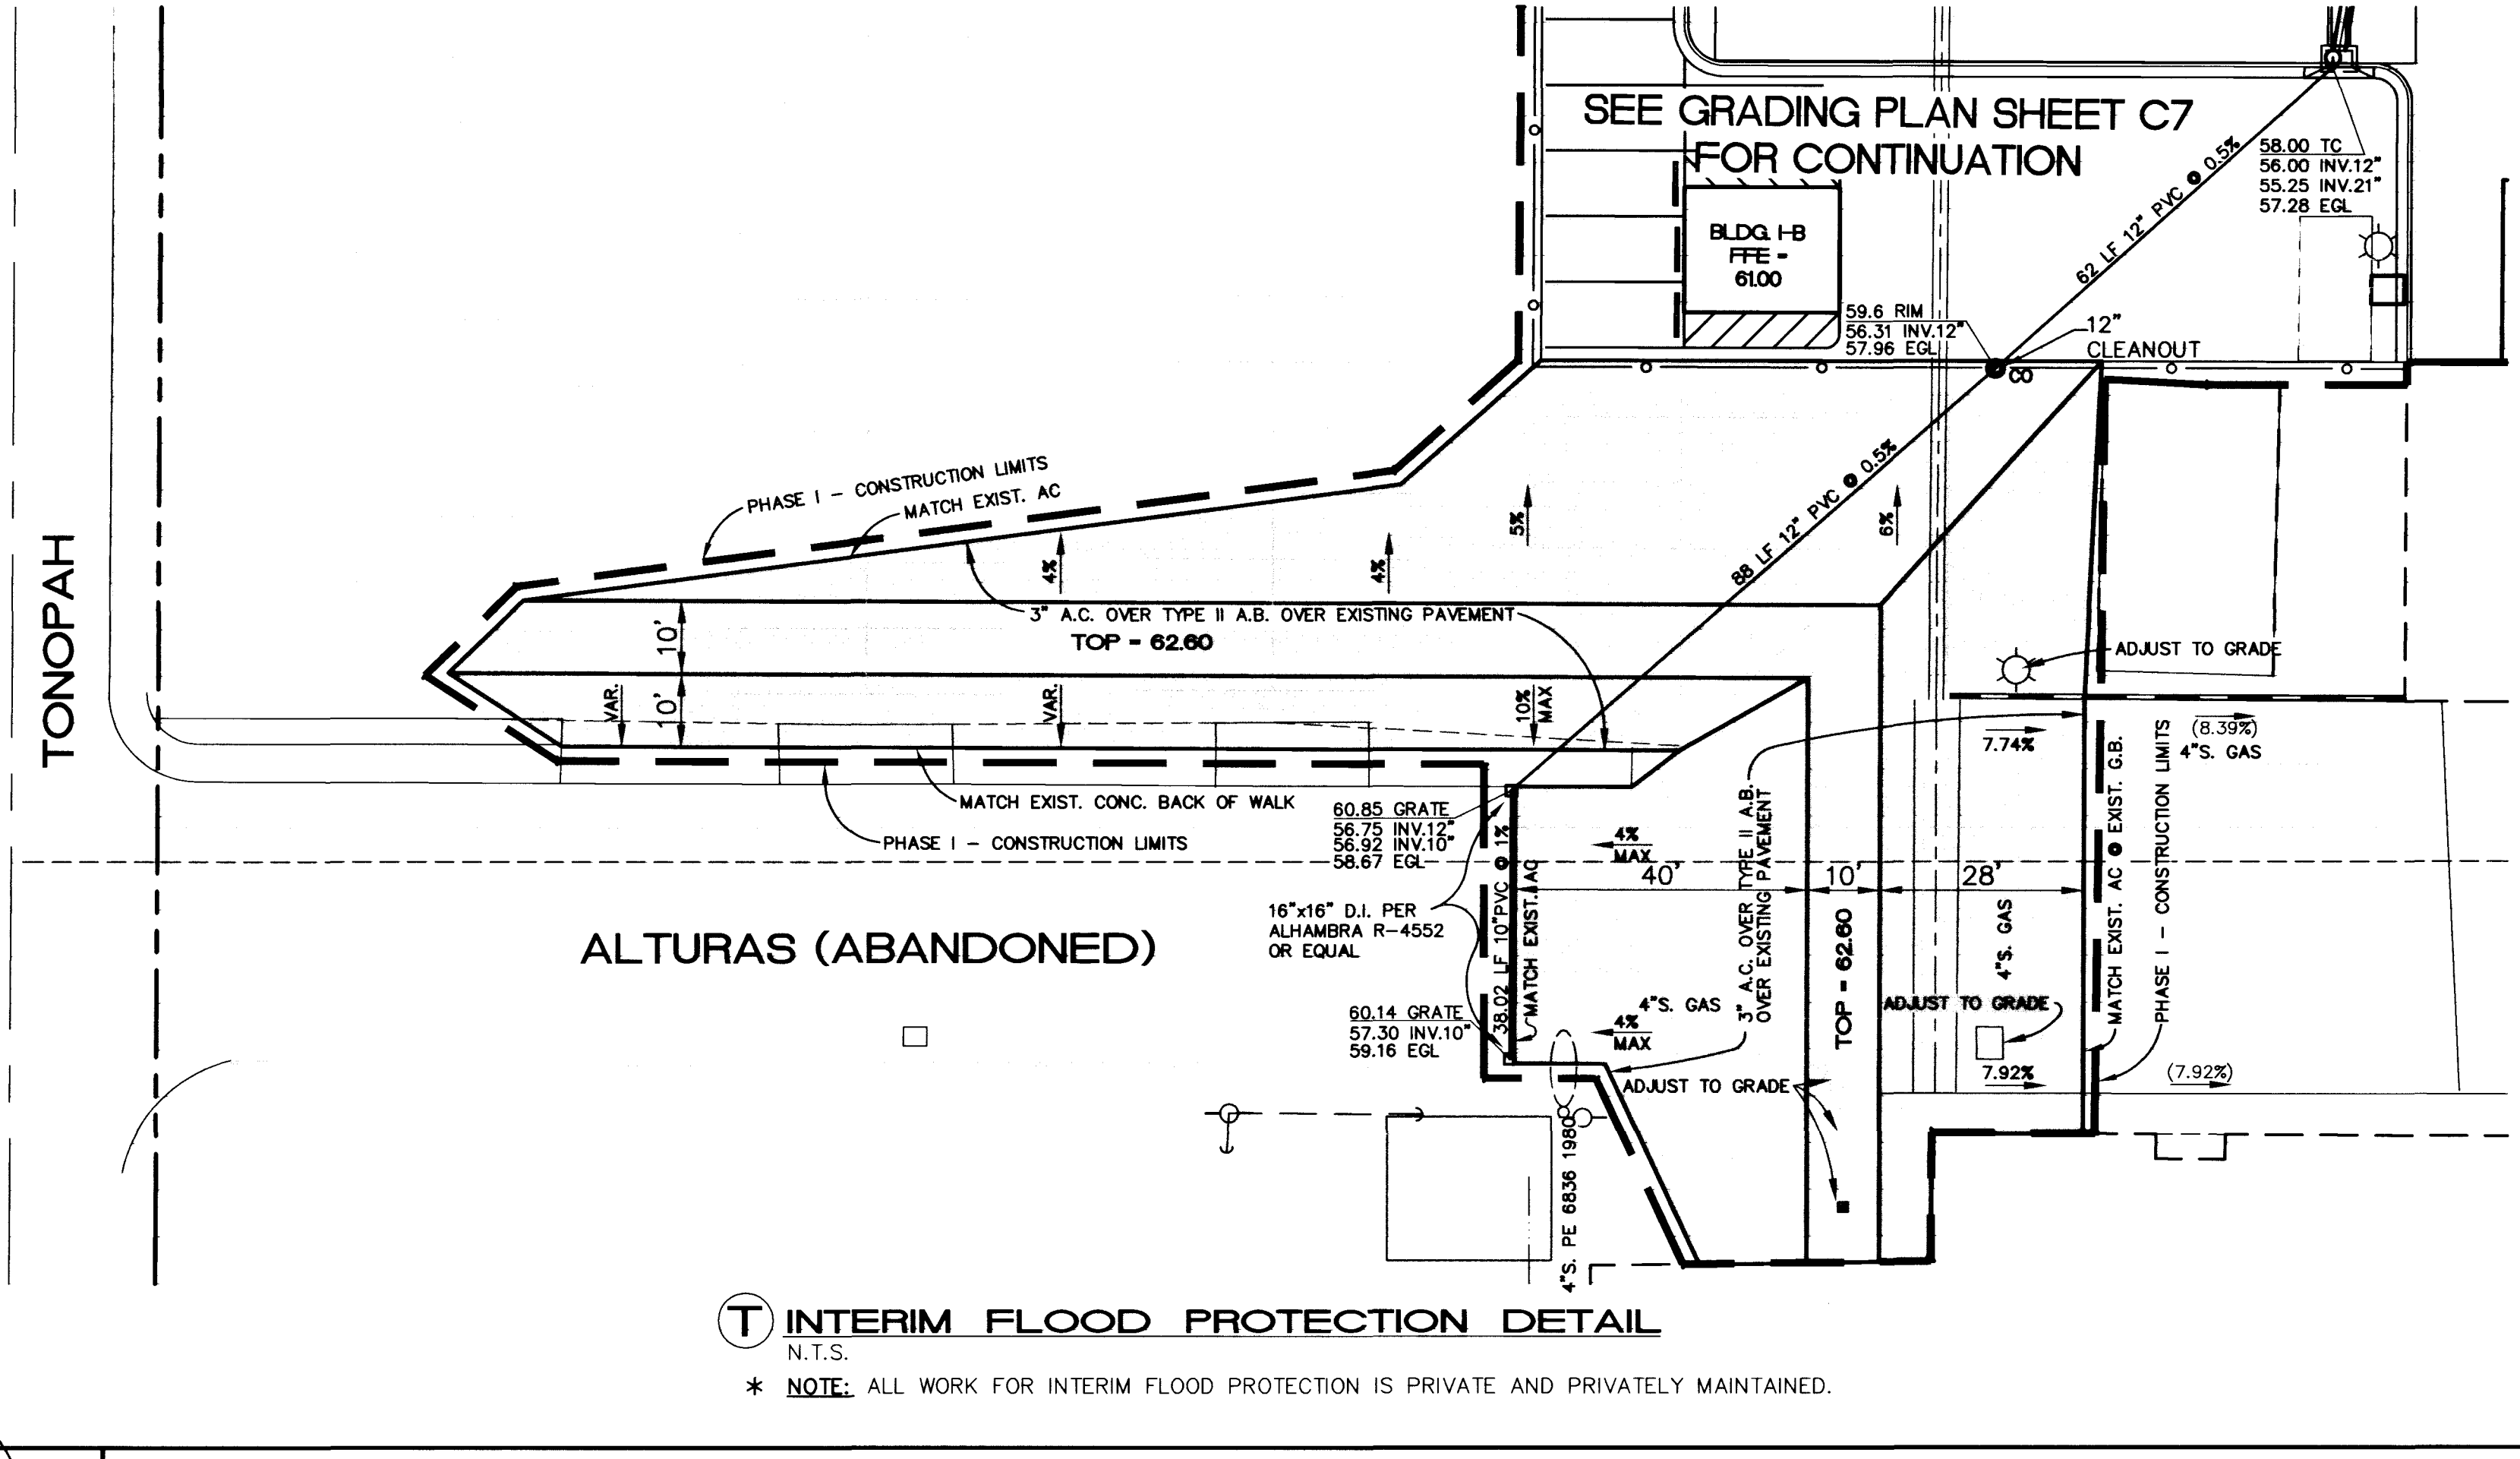

INTERIM FLOOD PROTECTION DETAIL
N.T.S.

* **NOTE:** ALL WORK FOR INTERIM FLOOD PROTECTION IS PRIVATE AND PRIVATELY MAINTAINED.

REV	DATE	BY	REVISION
1	8/17/98	TDA	REVISED SURVEY STATIONING TO ANALYSIS REVISION #1, SHEET C1
2	3/21/99	THL	

ARCH: HOLMES SABATINI ASSOCIATES
1 COMMERCE CENTER DRIVE
HENDERSON, NV 89014
(702) 436-1008

PROJECT: UNIVERSITY MEDICAL CENTER
ER/ICU/CCU ADDITION

DESIGNED BY: TDA
CHECKED BY: THL
PROJECT NO.: 497024A001
SCALE: N/A

PROFESSIONAL ENGINEER - STATE OF NEVADA
TED H. LYON
No. 5425
3/21/99

SHEET C12
12 OF 13 SHEETS
DRAWING NO. 107-V2911

